

Date: June 12, 2026

Owner: City of Flowery Branch

Project: SCADA System Equipment Upgrade for Water System

Project Number: 26-010

Addendum Number One

Submitted Questions with Answers

- 1. Copy of the June 03 mandatory pre-bid attendance list.**
 - Please refer to **Exhibit A**.
- 2. Copies of all available MR Systems SCADA and existing VFD drawings.**
 - Please refer to **Exhibit B** for all available drawings.
- 3. Can we give couple of pricing options? There is no need to replace PLC now. Can we give pricing for with and without PLC replacement?**
 - Yes, please provide both pricing options.
- 4. Is there any union requirement we need to be aware of when we plan our installation work at site?**
 - There are no union labor requirements for this GEFA Drinking Water project. Contractors must comply with all applicable GEFA, State of Georgia, and local licensing and certification requirements.
- 5. Can we propose online work or will there be a planned outage for any replacements?**
 - Planned outages can be arranged, although they are not preferred.
- 6. What SCADA System does the City currently use?**
 - The City uses a Year 2000 MR Systems SCADA platform.
- 7. Are the smaller pumps at the same station?**
 - Yes, they are located at the booster pump station.
- 8. Does the City only maintain pressure with the smaller pumps?**
 - No.
- 9. Do we need to submit itemized pricing?**
 - Yes, itemized pricing is required.
- 10. Is the SCADA system independent from the Wastewater?**
 - Yes, it is independent.
- 11. If so, who won that solicitation? Who was the engineer?**

- ESG Engineering served as the engineer, and Global Control Systems was the integrator.

12. Does the City want to match the software being used in Wastewater?

- Yes, the City prefers to match the existing Wastewater software.

13. Are the same employees going to operate the Wastewater and Water SCADA system?

- Yes, the same staff operate both systems daily and have done so for over 20 years.

14. Will the PC be installed at the Wastewater Treatment Plant?

- Yes, it will be installed in the breakroom adjacent to the Wastewater Plant PC.

15. Does the City have Variable Frequency Drive (VFD)?

- One well pump and all four booster pumps are equipped with VFDs.

16. Do all the Soft Starts need to be replaced?

- Replacement depends on the proposed system. The City prefers to retain existing equipment when feasible.

17. Does access need to be remote?

- Yes, remote access is required.

18. What is the horsepower to all the pumps?

- Well pumps: 20 HP
- Booster pumps: 60 HP and 10 HP

19. What is the Variable Frequency Drive (VFD) running at?

- Well 3 pump: 53.9 Hz
- 60 HP booster pump: 51–52 Hz
- 10 HP booster pump: 58.8 Hz

20. Does the City want a backup?

- The City would like to use the existing PSI gauge at the well buildings as a backup transducer for the Gainesville Street Tank, and tank floats as backup for the ground tank. A full system backup is desirable if budget allows. Manual operation is possible if SCADA is offline.

21. When in auto does the telemetry handle?

- It monitors pump status, tank levels, and power failures.

22. Are the flow meters charting?

- No.

23. Does the City want flow meters charting?

- Yes.

24. Does the City want the individual analog cards incorporated into this system?

- Yes, if required by bidders. Ideally, one analog card should be installed at each site.

25. Is the panel to be upgraded or replaced?

- This depends on budget. In some cases, full replacement is more cost-effective; in others, upgrading internal components while reusing the enclosure is sufficient.

26. Can enclosures be reused?

- Yes, enclosures may be reused, but the company label must be updated.

27. What notifications does the City want?

- Notifications must alarm locally on the SCADA computer and also the on-call phone. Required alarms:
 1. High tank level – Roberts Drive Ground Tank & Gainesville Tank
 2. Low tank level – Roberts Drive Ground Tank & Gainesville Tank
 3. Pump status – all pumps (running, off, fault)
 4. Power failure – each RTU station

28. What PSI do the pumps turn on and off at?

- Currently 103 PSI using the well building gauge. This will change once the pressure transducer is installed at the Gainesville Street Tank; calculations will be completed beforehand.

29. How far of a distance do the booster pumps pump to?

- Booster pumps push water approximately 0.65 miles.

30. Is the City needing a low level and high level alarm?

- Please refer to the answer provided for Question 27.

31. What does the Programmable Logic Controller (PLC) do now?

- The PLC provides updates every 10 seconds from the RTUs, alarms locally, and allows wells to be placed in Auto.

32. Is there a specific Booster pump vendor we would work with?

- Pro Pump & Controls based out of Kentucky.

33. Are there any drawings for the ground tank?

- Please refer to **Exhibit B** for all available drawings.

34. Does the City want to keep RACO in service?

- The City will retain RACO temporarily after startup, then relocate it once the new alarm system proves reliable.

35. Is RACO land based or cell service?

- Land-based.

36. Does the City want remote manual control and automatic?

- Yes, both are required.

37. Is there drawings for the Gainesville Street Tank?

- Please refer to **Exhibit B** for all available drawings.

38. Does the City want directional antennas?

- No. They are prone to lightning damage. A cellular-based system is preferred.

39. What cellular provider does the City use?

- AT&T FirstNet

40. What is the radio model?

- MR Systems MDS TransNET 900 (now outdated).

41. Do the notifications need to be text only or calls as well?

- Please provide pricing for both options.

42. To confirm, we are not required to include a new VFD or a new soft starter. If required, do you have a preferred brand you would like us to include in the proposal?

- The City prefers to retain existing equipment when feasible. If new equipment is required in the process then City must approve.

END OF QUESTIONS AND ANSWERS

Exhibit A

PRE-BID MEETING SIGN-IN SHEET



BID NUMBER: 26-010
BID TITLE SCADA System Equipment Upgrade for Water System
BID DUE / OPEN DATE: Tuesday June 30, 2026 at 2:00 PM
PRE-BID MEETING: Wednesday, June 3, 2026 at 9:30 AM
PRE-BID MEETING LOCATION: City Hall Community Room 5410 Pine Street, Flowery Branch, Georgia 30542

PROPOSERS ATTENDANCE SHEET				
No.	Proposer's Company Name	Attendee Name	Email Address	Phone Number
1	M.C. Dean	Shauna Johnson	Shauna.Johnson@McDean.com	(404) 513-8847
2	Clark Nexsen	Chuck Peterson	cpeterson@clarknexsen.com	478-231-9090
3	Tesco Controls Rich Ercolini	Rich Ercolini	recolini@tescocontrols.com	225-910-4573
4	PRIME CONTROLS	Kathy Pedigo	k.pedigo@primecontrols.com	65-806-1577
5	Lord & Company	Christina Brown	cbrown@lordandcompany.com	704-512-9042
6	Radiant Control Systems	TJ PATWA	tj.patwa@radiantcontrolsystems.com	404-433-9548
7	Rever Control	Greg Grainger CAROLINE MARTIN	ggrainger@revercontrol.com	251-284-3279
8	Civita Instruments Inc	WES WOOD	Wwood@c2iinc.com	6784755145
9	SELVA LLC	Selva Kumar	SELVA.KUMAR@SELVALLC.COM	7703375380
10	Shane Weyner hoistain electric	Shane Weyner	Shane.weyner1@gmail.com	706-6916940

DeAnna Fountain / McDean

Following the meeting at City Hall, Respondents will be required to travel to three (3) additional sites: the Well Building, Booster Pump Building and the Wastewater Treatment Plant.
 DeAnna Fountain / McDean (706) 211-2111

PROPOSERS ATTENDANCE SHEET				
No.	Proposer's Company Name	Attendee Name	Email Address	Phone Number
11	INFRAMARK	William Kelly	William.Kelly@inframark.com	678 325 2817
12				
13				
14				


FOR REFERENCE ONLY

FRONT PANEL BILL OF MATERIALS


ITEM	QTY	TAG	MANUFACTURER	MODEL	DESCRIPTION	ENGRAV_L1	ENGRAV_L2
1	1		B & D Fabricators, Inc.	2420DP	Door Pan, for 24" x 20" Ultrix enclosure		
2	1		B & D Fabricators, Inc.	SS-F-242010ALW	solarshield, front for 24" x 20" x 10" enclosure, aluminum painted white		
3	2		B & D Fabricators, Inc.	SS-S-242010ALW	solarshield, side for 24" x 20" x 10" enclosure, aluminum painted white		
4	1		B & D Fabricators, Inc.	SS-T-242010ALW	solarshield, top for 24" x 20" x 10" enclosure, aluminum painted white		
5	1		Hoffman	U-U605025	Enclosure, wall mount, 24 x 20 x 10, NEMA 4X, fiberglass ULTRX		
6	1		Hoffman	U-UHPL	Padlock Kit for ULTRX Fiberglass Enclosure		
7	1		Hoffman	A-24P20	Subpanel, 21" x 17", fits 24 x 20 enclosure		
8	1		Hoffman	Q-202013PCIQR	QLINE "I" polycarbonate 4x enclosure, 7.87" x 7.87"	15,000GAL ELEVATED TANK	RTU-1
9	1		Hoffman	Q-2020PI	Subpanel, 6.3" x 6.3"		
10			Not Used				
11	1		Micro Switch	BZ-2RW82-A2	Basic Switch, SPST, 15A contact, Roller Arm		
12	1		WD Engraving	1.5" x 3" Lamacoid NP	Black Lamacoid engraved with white letters per attached		
13	1		Best Power Tech	Patriot SMT420VB	UPS, 420VA, 280W, 120VAC IN/OUT 4.0 Min @ Full Load, w/batt		

PANEL FABRICATION DETAILS:


1. RTU ENCLOSURE IS WALL MOUNTED FIBERGLASS NEMA 4X HOFFMAN PART NO. U-U605025.
2. SUBPANEL SHALL BE STEEL AND PAINTED HOFFMAN WHITE. HOFFMAN PART NO. A-24P20.
3. NAMEPLATES SHALL BE BLACK GRAVOPLI WITH WHITE LETTERS, BEVELED EDGES. NAMEPLATE SIZING AND LETTERING SHALL BE AS REQUIRED TO PROVIDE OPTIMAL VIEWING.

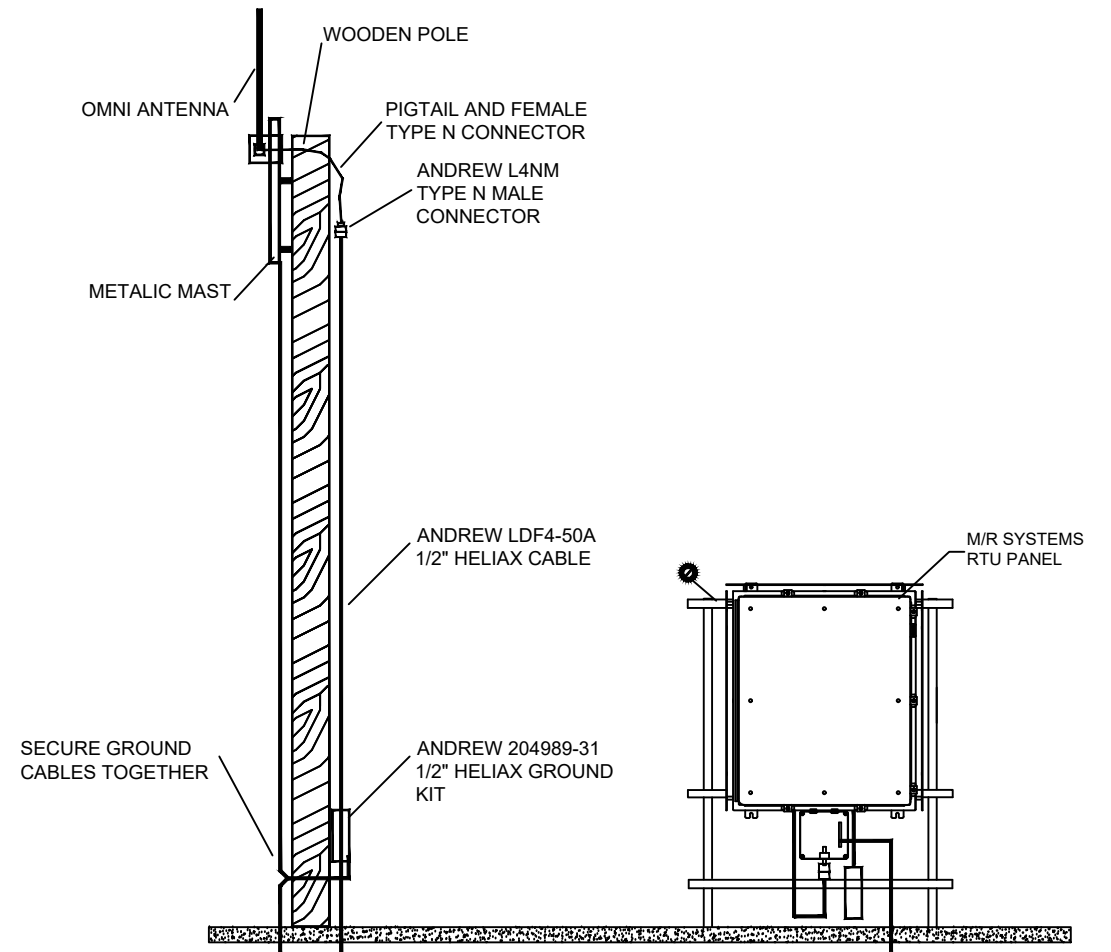


INSTALLATION DETAIL

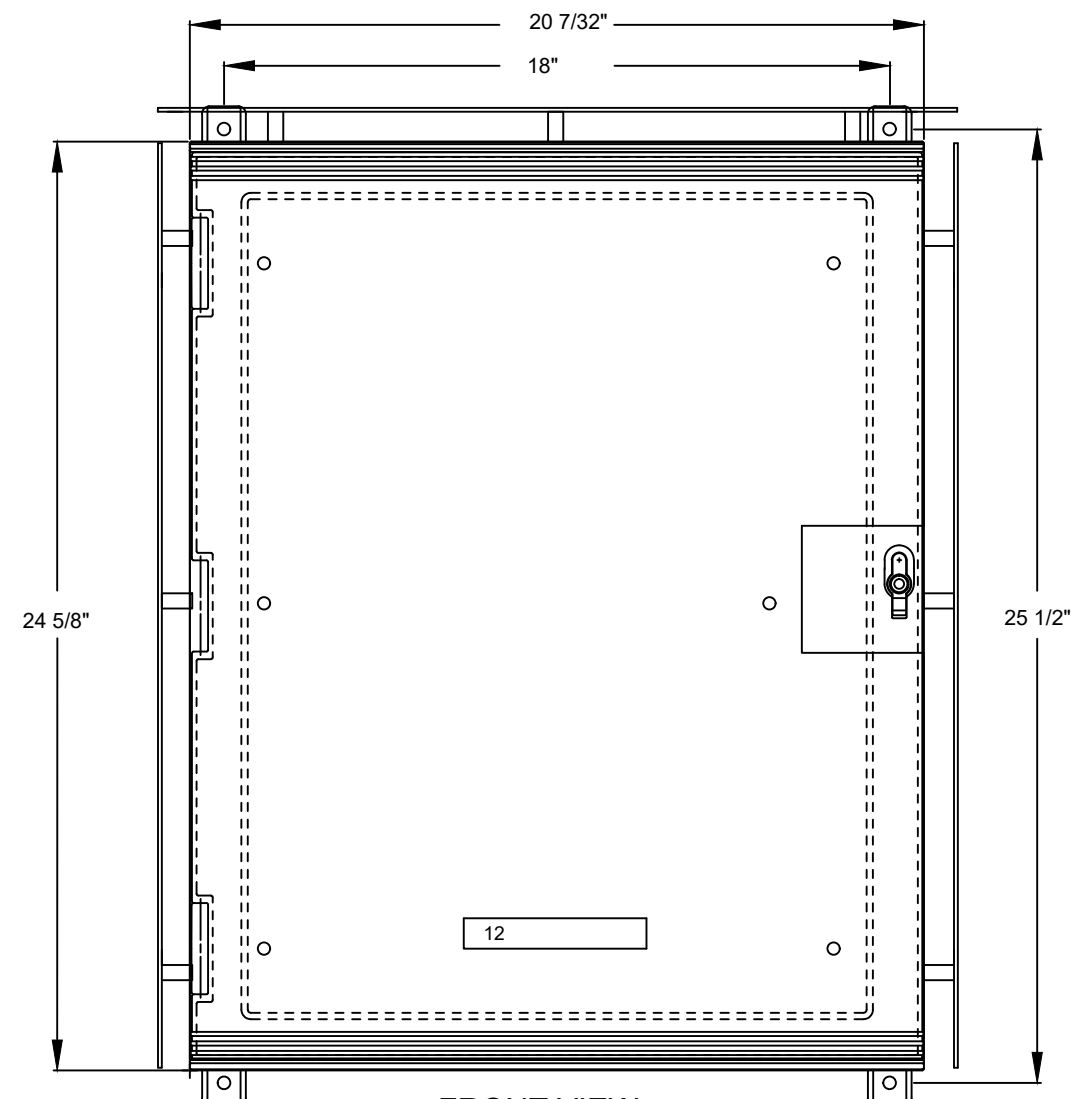


FRONT VIEW

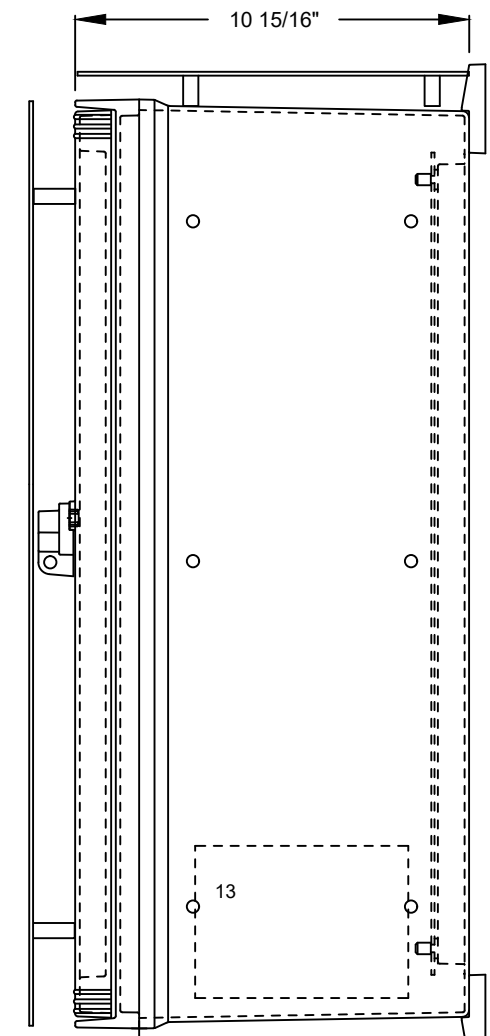

RIGHT SIDE

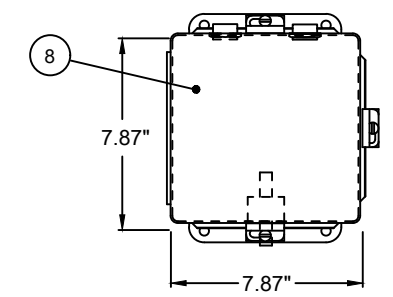

FRONT VIEW

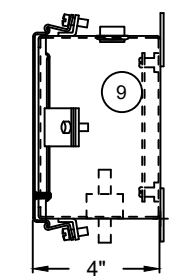

RIGHT SIDE

SUPPLIED BY OTHERS

REV	DATE	DESCRIPTION	REV	DATE	DESCRIPTION
			3	01-28-01	REVD MICRO TO MODMOM
			2	10-08-01	AS SHIPPED
			1	09-21-01	FOR MANUFACTURE
4	04-03-02	AS INSTALLED	0	09-13-01	FOR APPROVAL

SCALE:	NAME	APPROVED	DATE
DO NOT SCALE	DESIGN BY:	W. WOOD	WMW 09-13-01
	DRAFTING:	N.FIELDS	NF 09-13-01
	PROJ ENG:	W. WOOD	WMW 09-13-01
	PROJ MGR:	W. WOOD	WMW 09-13-01



Systems, Inc.
Service & System Integration

NORCROSS, GA - GAINESVILLE, FL

PROJECT - LOCATION	CITY OF FLOWERY BRANCH, GA. RADIO TELEMETRY SYSTEM FLOWERY BRANCH, GA.
PROJECT NO.	201042

TITLE	150,000 GAL ELEVATED TANK RTU-1 REMOTE TELEMETRY UNIT
FILE:	2014201M01
SHT.	1 OF 1
DRAWING NO.	201042-3501-M1

FOR REFERENCE ONLY

SUBPANEL BILL OF MATERIALS

ITEM	QTY	TAG	MANUFACTURER	MODEL	DESCRIPTION
1	1		Allen-Bradley	1492-DR5	terminal track aluminum, 35mm DIN, 3.28 FT
2	2		AMP	5-554739-3	RJ 45 connector for flat 8 cond, stranded cond
3	1		Andrew	L4NF	Female connector, Type N, for 1/2inch Heliax LDF4-50A
4	1		Andrew	204989-31	Grounding kit for Antenna Cable, 1/2 in cable, screw lug
5	1		Andrew	LDF4-50A	Heliax cable, 1/2 in foam filled, 1foot
6	1		Andrew	L4NM	Male connector, Type N, for 1/2 inch Heliax LDF4-50A
7	1		Andrew	241474-4	Weatherproofing kit, 3M Cold Shrink, 1/2 inch coax to 1/2 inch coax covers (2) connectors
8	1		Brady	WML-205-292-75	wire marker, small w/clear wrap (qty 250)
9	1		Bussman	AGC-1	Fuse, 1/4 x 1 1/4 inch, 1 Amp, 250 volt, (box of 5)
10	1		Bussman	AGC-1/2	Fuse, 1/4 x 1 1/4 inch, 1/2 Amp, 250 volt, (box of 5)
11	15		IDEC	RH1B-U-DC24V	Relay, 1PDT pole, 10 amp, 24VDC coil, uses socket SH1B-05
12	1		IDEC	RH1B-U-AC120V	Relay, 1PDT, 10 amp, 120VAC coil, uses socket SH1B-05
13	16		IDEC	SH1B-05	Socket, 1 pole, 10 amp, DIN mount
14	1		McMaster-Carr Supply Co.	7438K11	Extension Cord, indoor/outdoor, three-conductor(16/3), SJTW-A, 13 amps, orange
15	1		Microwave Data Systems	MDS947Y-2-PT	Yagi antenna, 10dB gain, 7 element, 890-960 MHz, 2ft pigtail w/type N Male
16	1		Microwave Data Systems	9810B	Radio Transceiver, 2100 series compatible MAS, 800 - 960 MHz, DSP, 9600bps, master or remote, 5 watt output
17	1		Modicon	172JN21032	Momentum Option Adapter, Modbus(RS232/485)port, TOD clock, battery backup
18	1		Modicon	171CC76010	Momentum M1 Processor Adapter, 512K RAM, 1-RJ45 Modbus RS-232 port, 1DB9Field I/O Bus Port
19	2		MR Systems, Inc	Kamkaze ASA-1	Analog Surge Arrestor
20	1		Polyphaser	ISB-B50LN-C2	Coaxial Protector, Bulkhead Mt, UHF, 125-100MHz, (2) Type N Female
21	1		Power One	HC12-3.4	Power Supply, Single Output, 12VDC, 3.4 amps, C Case 4.87"L x 2.50"W x 5.62"D
22	2		Power-One	HB24-1.2-A	Power Supply, Single Output, 24VDC, 1.2 amps, B Case 4.87"L x 4"W x 2.10"D
23	1		QVS, Inc.	CC342	Modular Serial RS232 Adaptor, RJ45F to DB25M, 8 wire
24	1		RF Industries	RFN-1023	Bulkhead adapter, TYPE N female to TYPE N female
25	1		Sat-Pak	SP58U-72NMNM	Jumper, radio, RG58/U, 72", (2) Type N Male
26	1		Square D	SDSA1175	AC power surge protector, 120 VAC
27	1		Square D	SCDQOU115	Circuit breaker, single pole, 15 Amp, DIN Mount
28	1		Square D	QOSAMK11897	mounting bracket for AC power surge protector
29	1		Taylor	99010	wire duct cap, 1", grey, (6 foot stick)
30	1		Taylor	91020	wire duct, 1"W x 2"H, grey, (6 foot stick)
31	2		Weidmuller	WSI 6/2 #101420	Fused Terminal Block w/ith blow n fuse indicator, 1 1/4" x 1/4" fuse, 15-30VDC / 30-60VAC
32	4		Weidmuller	WSI 6/2 #101430	Fused Terminal Block w/ith blow n fuse indicator, 1 1/4" x 1/4" fuse, 40-60VDC / 80-120VAC
33	30		Weidmuller	WDU 4 #102010	Terminal 6mm, 600 volt, 35 amp, beige
34	3		Weidmuller	WDU 6 #102020	Terminal 8mm, 600 volt, 45 amp, beige
35	6		Weidmuller	WEW 35/2 #106120	Terminal End Bracket
36	1		Modicon	170AMM09000	Momentum, IO Base, 4 Chnl AI / 2 Chnl AO, 24V DC - 4 R DI / 2 R DO
37	1		Modicon	170INT11000	Momentum, Communications Adapter, Interbus (I/O Bus), 2-port, Port 2 9-pin
38	1		Modicon	170ADM5010	Momentum, IO Base, 24V DC - 16 R Input / 16 R output
39	1		Modicon	170MCO0700	Cable, interbus I/O, momentum side-by-side mounting, low profile, 4.5 in. long

REV 5

REV 5


20 3/4"

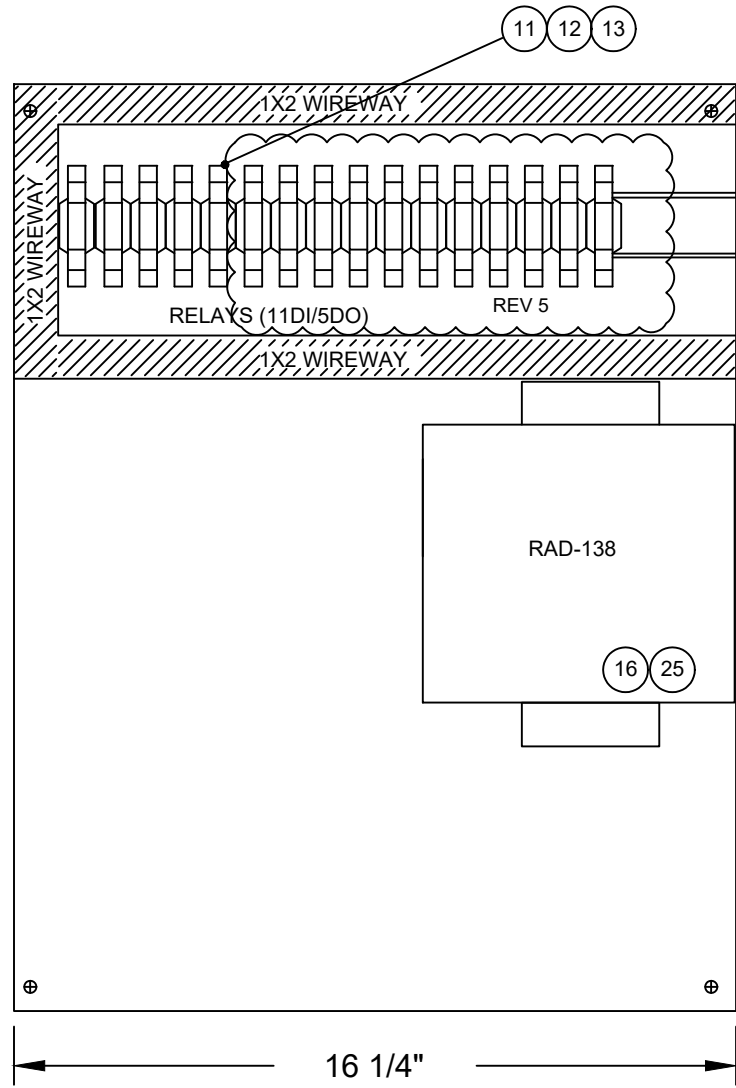

DOORPANEL LAYOUT

TS-1	TS-2	TS-3	ARRESTORS	RELAYS	REV 5	
L	L1	303	ASA205	CR306	CR402	IR606
N	N1	TO	ASA210	CR308	CR405	IR608
G	L1A	314				IR611
	N1A			PR103	CR705	IR614
	113	426			CR708	IR616
	TO	TO			CR711	IR618
	121	437	REV 5			IR621
						IR623

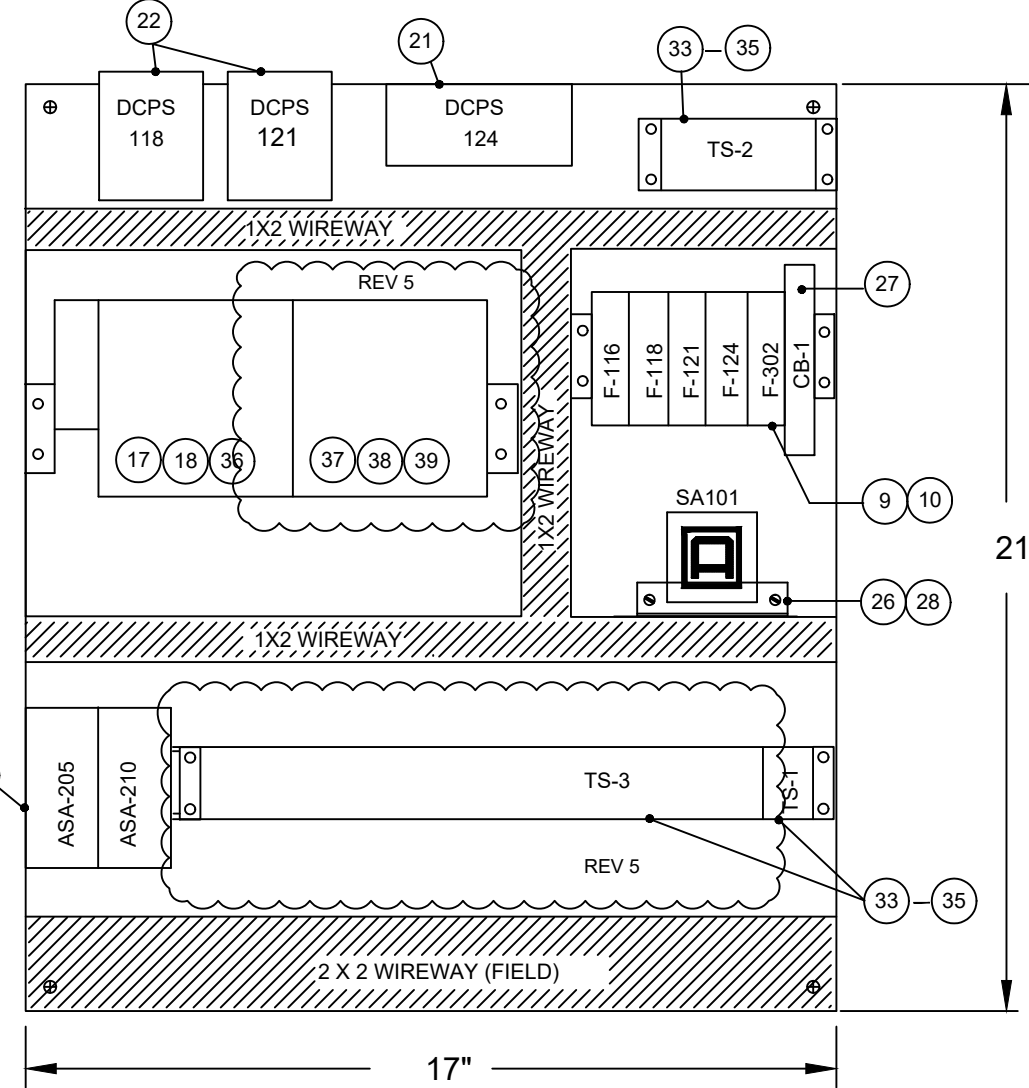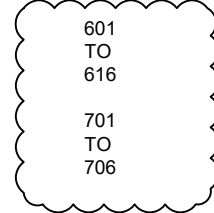

SUBPANEL LAYOUT

NOTE: -ALL PANEL WIRING SHALL CONFORM TO THE FOLLOWING:

BUS OR OTHER USE	COLOR	WIRE GAUGE	ABBREVIATION
120VAC LINE SIDE	BLACK	14AWG	BK
120VAC NEUTRAL SIDE	WHITE	14AWG	W
120VAC ISOLATED LINE	BLACK	14AWG	BK-ZA
120VAC ISOLATED NEUTRAL	WHITE	14AWG	W-XA
24VDC(+)	PURPLE	16AWG	PUR
24VDC(-)	ORANGE	16AWG	ORN
ANALOG CIRCUITS	RED	18AWG	PUR
TWISTED JACKETED	WHITE	18AWG	ORN
DC CONTROL	BLUE	16AWG	N/A
AC CONTROL	RED	16AWG	N/A
CIRCUITS POWERED FROM SOURCES EXTERNAL TO PANEL	YELLOW	14AWG	N/A
	GREEN	14AWG	N/A
GROUND COMMON TO PANEL			N/A

*ALL PANEL DC SUPPLY VOLTAGES USE PURPLE(+) AND ORANGE REFER TO DRAWING E1 FOR IDENTIFICATION OF POWER SUPPLY VOLTAGE.

REV	DATE	DESCRIPTION	REV	DATE	DESCRIPTION
			3	01-28-01	REVD MICRO TO MODMOM
			2	10-08-01	AS SHIPPED
5	02-06-08	REVISED PER 208005	1	09-21-01	FOR MANUFACTURE
4	04-03-02	AS INSTALLED	0	09-13-01	FOR APPROVAL


SCALE:	NAME	APPROVED	DATE
DO NOT SCALE	DESIGN BY:	W. WOOD	WMW 09-13-01
	DRAFTING:	N.FIELDS	NF 09-13-01
	PROJ ENG:	W. WOOD	WMW 09-13-01
	PROJ MGR:	W. WOOD	WMW 09-13-01

Systems, Inc.
Service & System Integration

NORCROSS, GA - GAINESVILLE, FL


PROJECT - LOCATION	TITLE
CITY OF FLOWERY BRANCH, GA. RADIO TELEMETRY SYSTEM FLOWERY BRANCH, GA.	150,000 GAL ELEVATED TANK RTU-1 REMOTE TELEMETRY UNIT
PROJECT NO. 201042	FILE: 2014201MA1 SHT. 1 OF 1
	DRAWING NO. 201042-3501-MA1

FOR REFERENCE ONLY

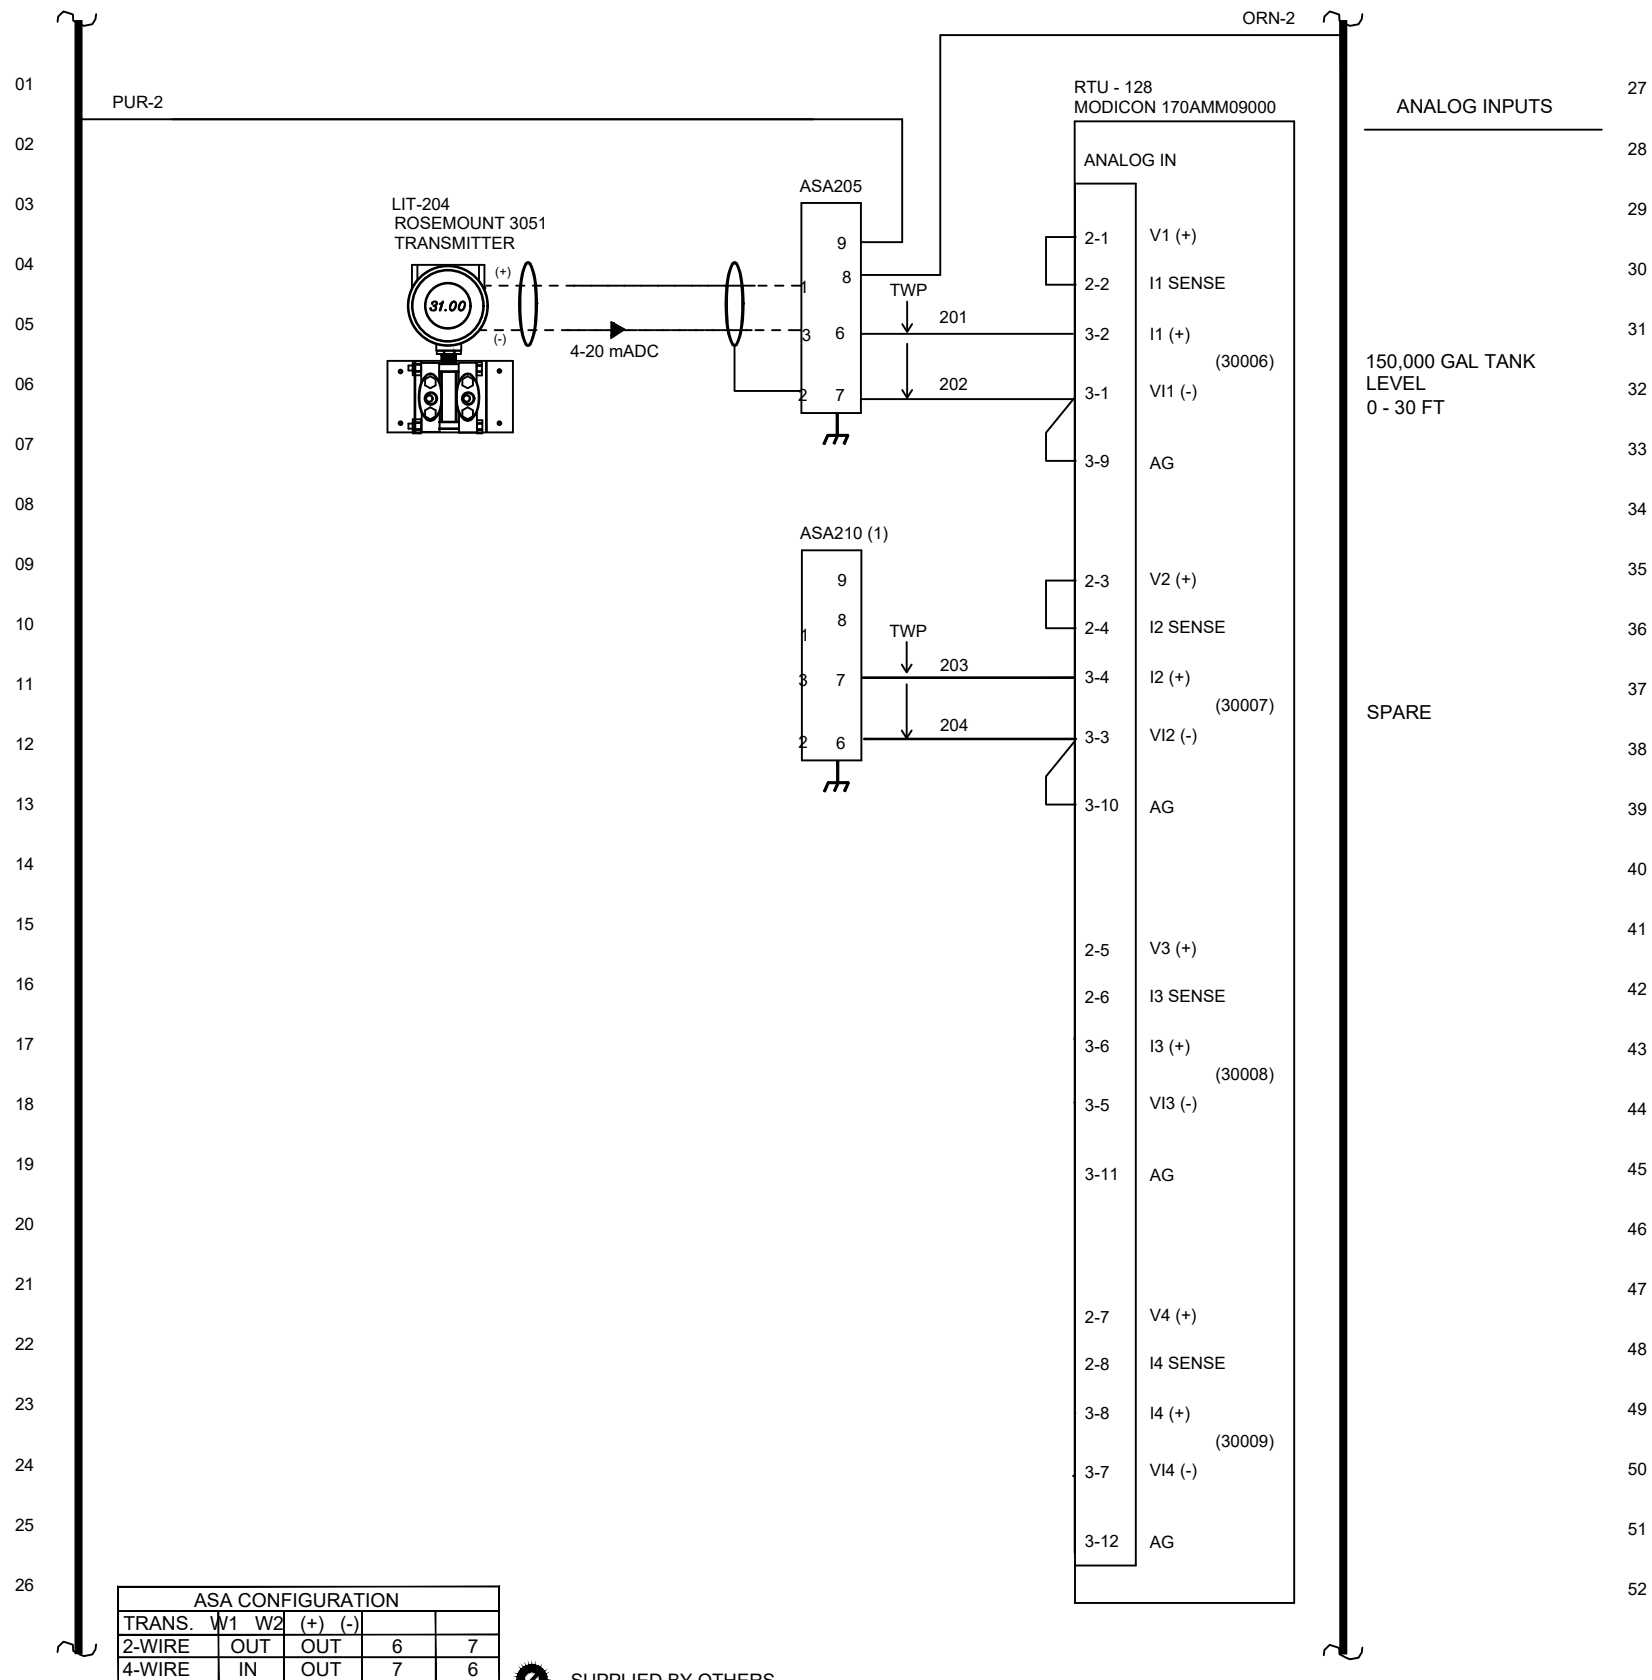

ASA CONFIGURATION				
TRANS.	W1	W2	(+)	(-)
2-WIRE	OUT	OUT	6	7
4-WIRE	IN	OUT	7	6

SUPPLIED BY OTHERS

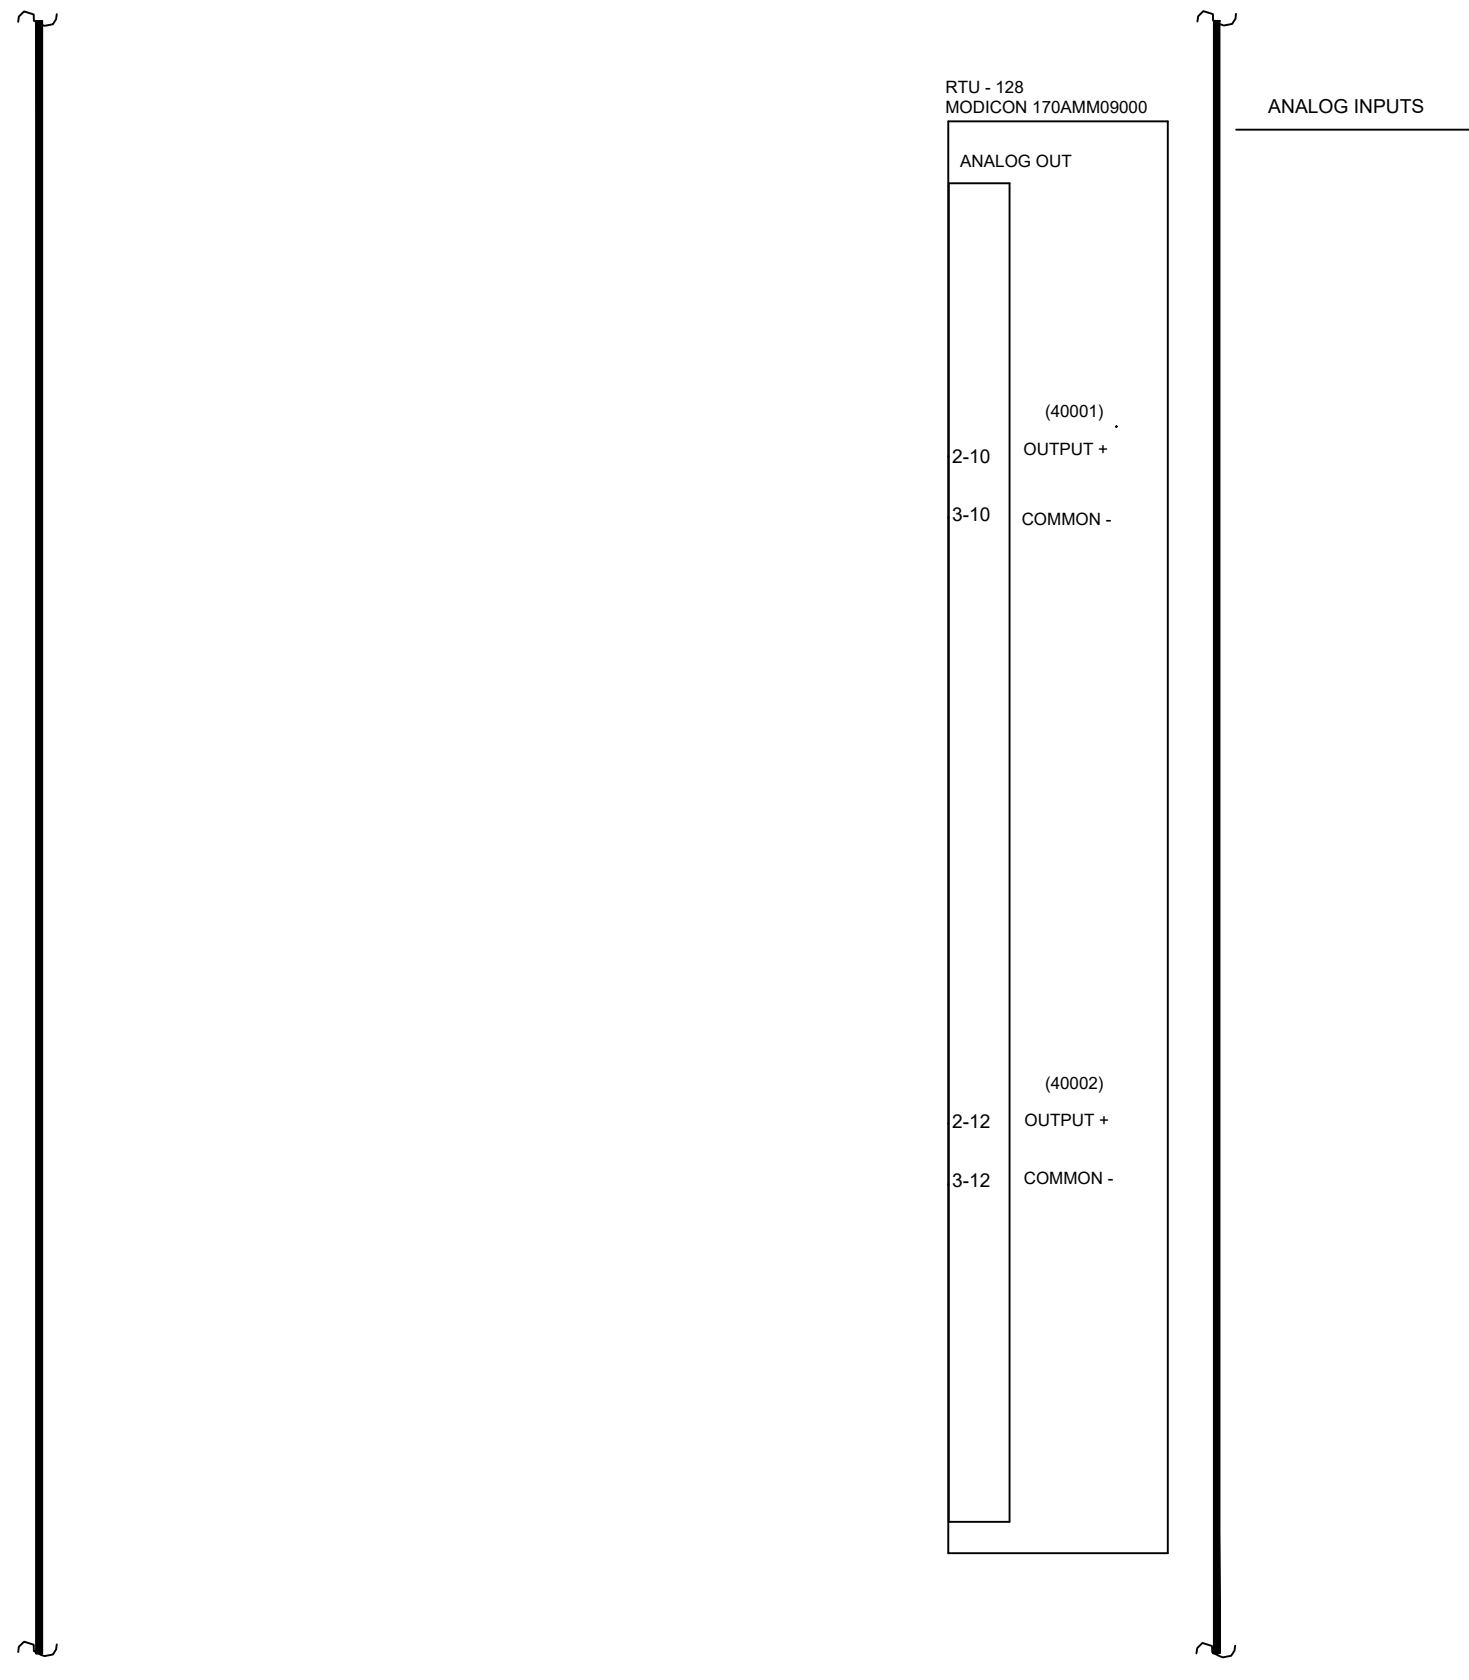

REV	DATE	DESCRIPTION	REV	DATE	DESCRIPTION
			3	01-28-01	ADDED MODICON MOMTM
			2	10-08-01	AS SHIPPED
			1	09-21-01	FOR MANUFACTURE
3	04-03-02	AS INSTALLED	0	09-13-01	FOR APPROVAL

SCALE:	NAME	APPROVED	DATE
DO NOT SCALE	DESIGN BY:	W. WOOD	09-13-01
	DRAFTING:	N.FIELDS	09-13-01
	PROJ ENG:	W. WOOD	09-13-01
	PROJ MGR:	W. WOOD	09-13-01




Systems, Inc.
Service & System Integration

NORCROSS, GA - GAINESVILLE, FL

PROJECT - LOCATION	TITLE
CITY OF FLOWERY BRANCH, GA. RADIO TELEMETRY SYSTEM FLOWERY BRANCH, GA.	150,000 GAL ELEVATED TANK RTU-1 REMOTE TELEMETRY UNIT
PROJECT NO. 201042	FILE: 2014201E02 SHT. 1 OF 1
	DRAWING NO. 201042-3501-E2

FOR REFERENCE ONLY

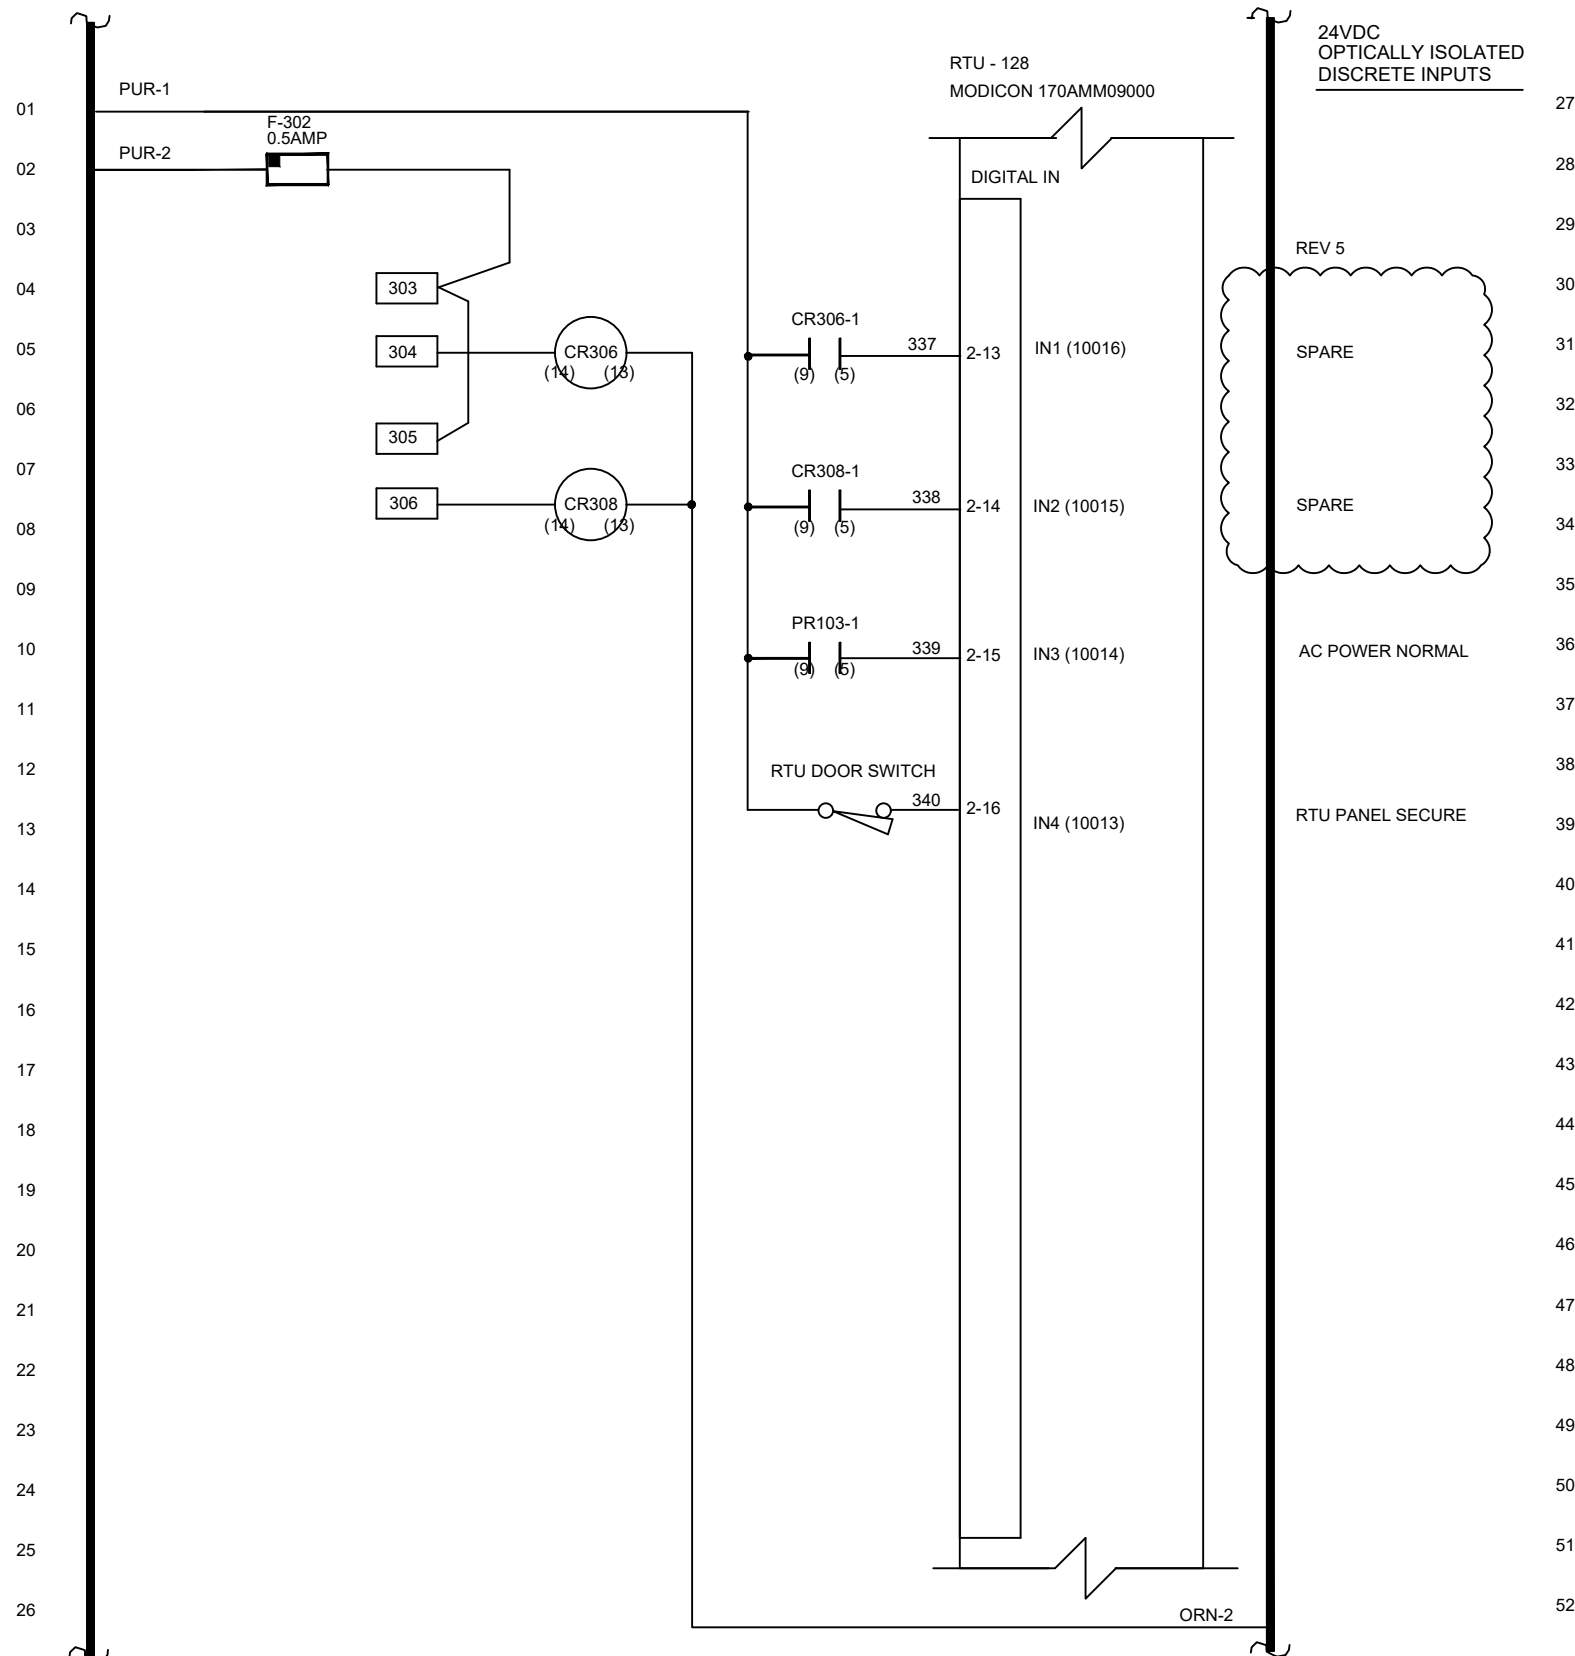

24VDC
OPTICALLY ISOLATED
DISCRETE INPUTS

REV 5

SPARE

SPARE

AC POWER NORMAL

RTU PANEL SECURE

SUPPLIED BY OTHERS

REV	DATE	DESCRIPTION	REV	DATE	DESCRIPTION
			3	01-28-01	ADDED MODICON MOMTM
			2	10-08-01	AS SHIPPED
5	02-06-08	REVISED PER 208005	1	09-21-01	FOR MANUFACTURE
4	04-03-02	AS INSTALLED	0	09-13-01	FOR APPROVAL

SCALE:	NAME	APPROVED	DATE
DO NOT SCALE	DESIGN BY:	W. WOOD	WMW 09-13-01
	DRAFTING:	N.FIELDS	NF 09-13-01
	PROJ ENG:	W. WOOD	WMW 09-13-01
	PROJ MGR:	W. WOOD	WMW 09-13-01




Systems, Inc.
Service & System Integration
NORCROSS, GA - GAINESVILLE, FL

PROJECT - LOCATION	TITLE
CITY OF FLOWERY BRANCH, GA. RADIO TELEMTRY SYSTEM FLOWERY BRANCH, GA.	150,000 GAL ELEVATED TANK RTU-1 REMOTE TELEMTRY UNIT
PROJECT NO. 201042	FILE: 2014201E03 SHT. 1 OF 1
DRAWING NO. 201042-3501-E3	

PRINTED 4/3/02 1:14 PM 2014201E03.dwg

FOR REFERENCE ONLY

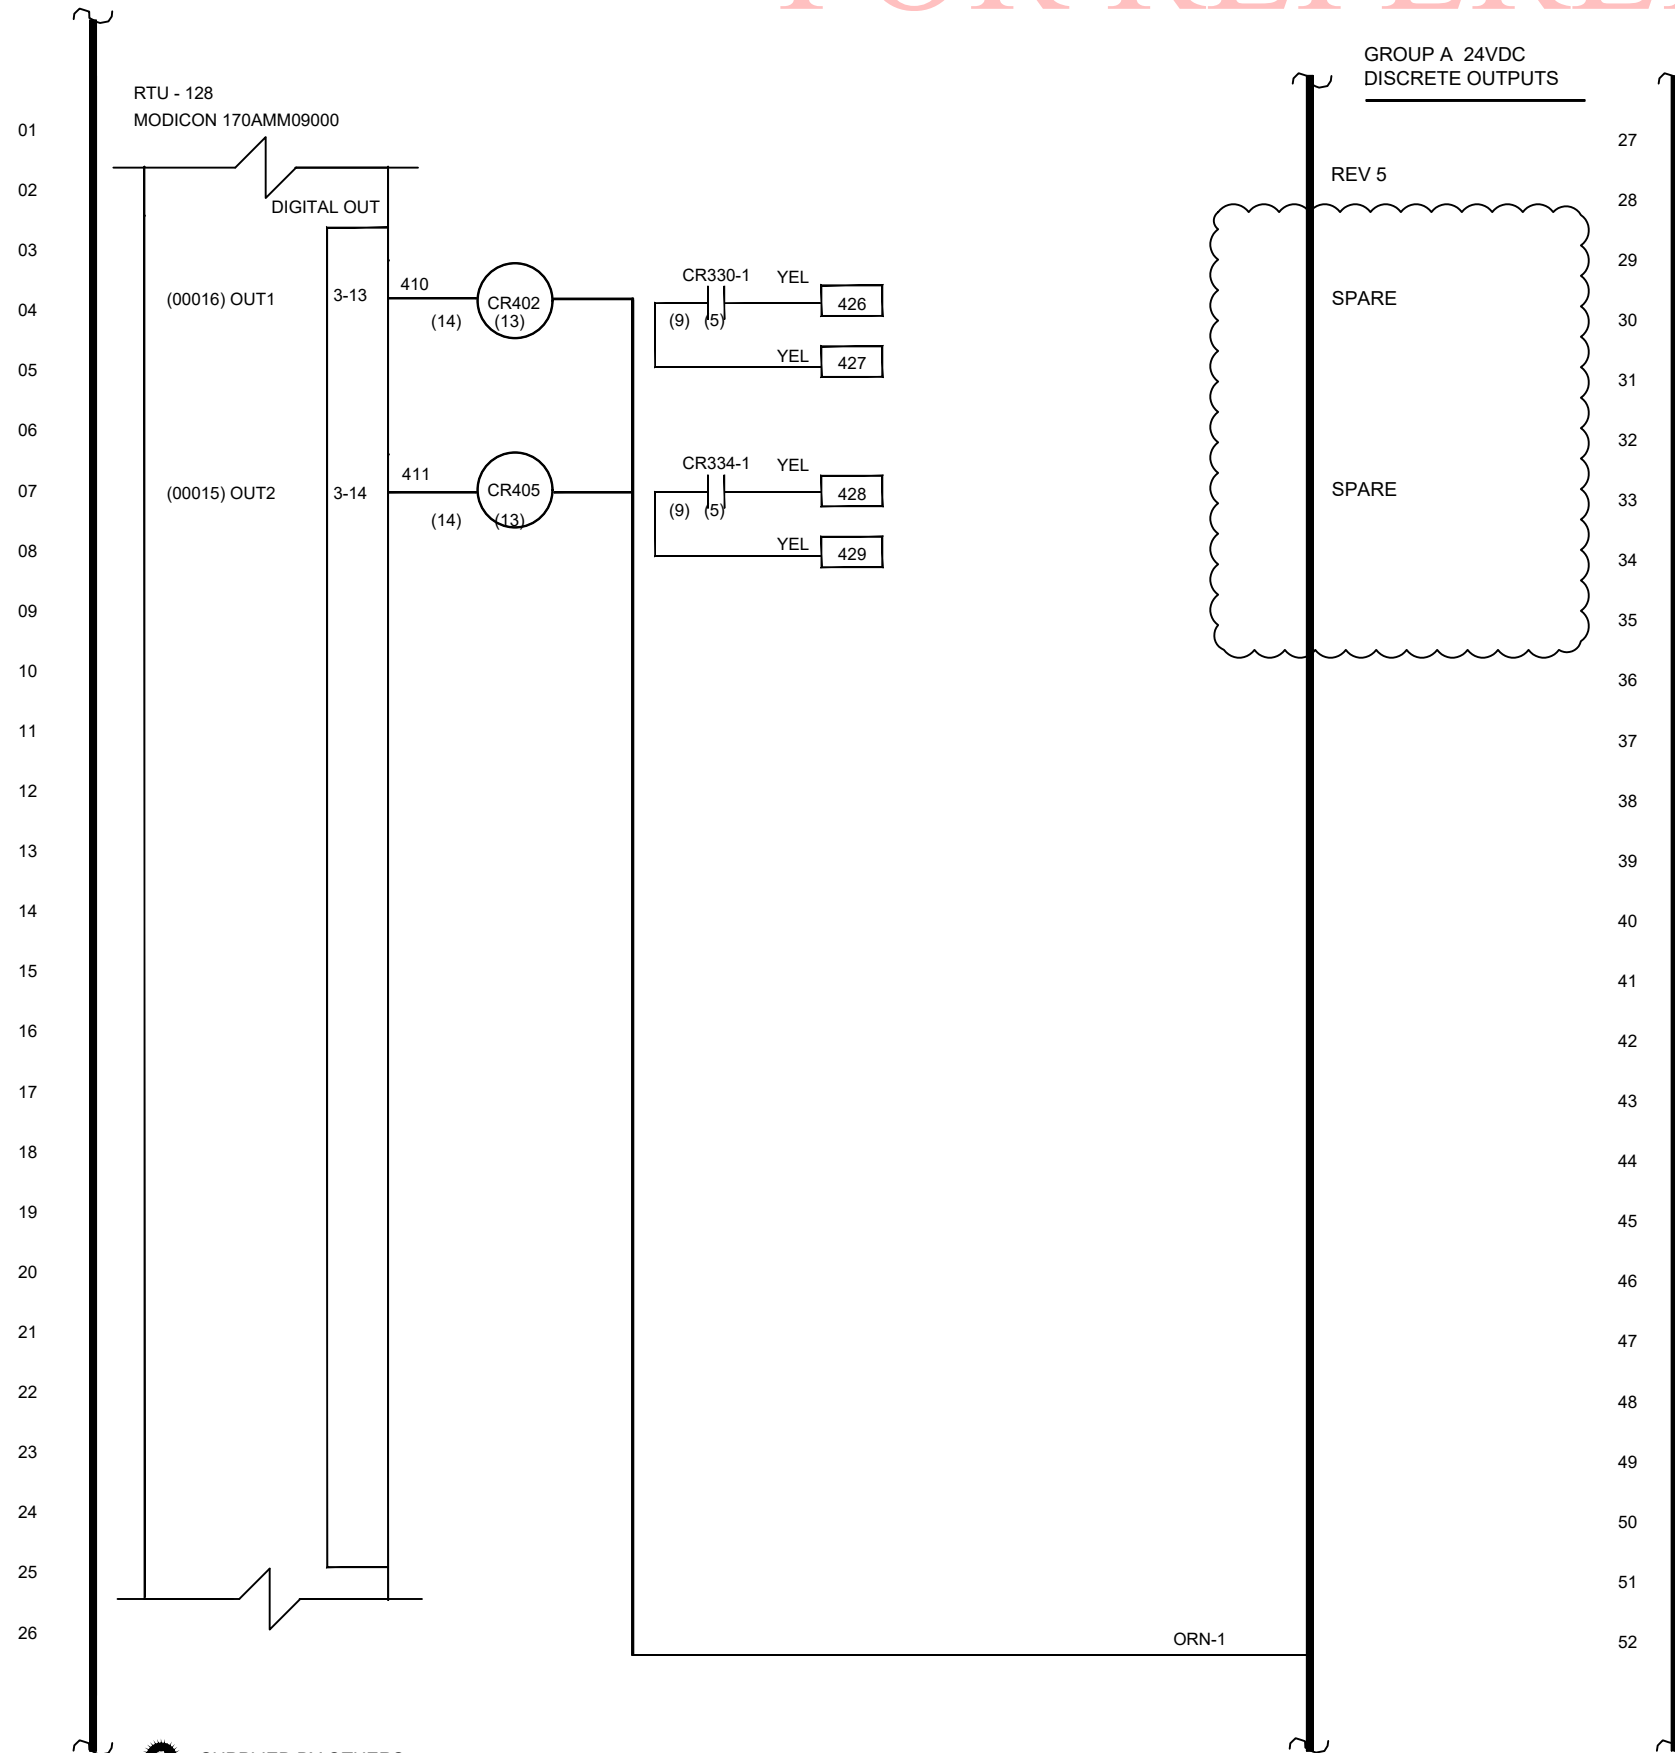

RTU - 128
MODICON 170AMM09000

DIGITAL OUT

GROUP A 24VDC
DISCRETE OUTPUTS

REV 5

SPARE

SPARE

ORN-1

SUPPLIED BY OTHERS

REV	DATE	DESCRIPTION	REV	DATE	DESCRIPTION
			3	01-28-01	ADDED MODICON MOMTM
			2	10-08-01	AS SHIPPED
5	02-06-08	REVISED PER 208005	1	09-21-01	FOR MANUFACTURE
4	04-03-02	AS INSTALLED	0	09-13-01	FOR APPROVAL

SCALE:	NAME	APPROVED	DATE
DO NOT SCALE	DESIGN BY:	W. WOOD	WMW 09-13-01
	DRAFTING:	N.FIELDS	NF 09-13-01
	PROJ ENG:	W. WOOD	WMW 09-13-01
	PROJ MGR:	W. WOOD	WMW 09-13-01





Systems, Inc.
Service & System Integration

NORCROSS, GA - GAINESVILLE, FL

PROJECT - LOCATION	TITLE
CITY OF FLOWERY BRANCH, GA. RADIO TELEMETRY SYSTEM FLOWERY BRANCH, GA.	150,000 GAL ELEVATED TANK RTU-1 REMOTE TELEMETRY UNIT
PROJECT NO. 201042	FILE: 2014201E04 SHT. 1 OF 1
DRAWING NO. 201042-3501-E4	

2014201E04.dwg PRINTED 4/3/02 1:30 PM

FOR REFERENCE ONLY

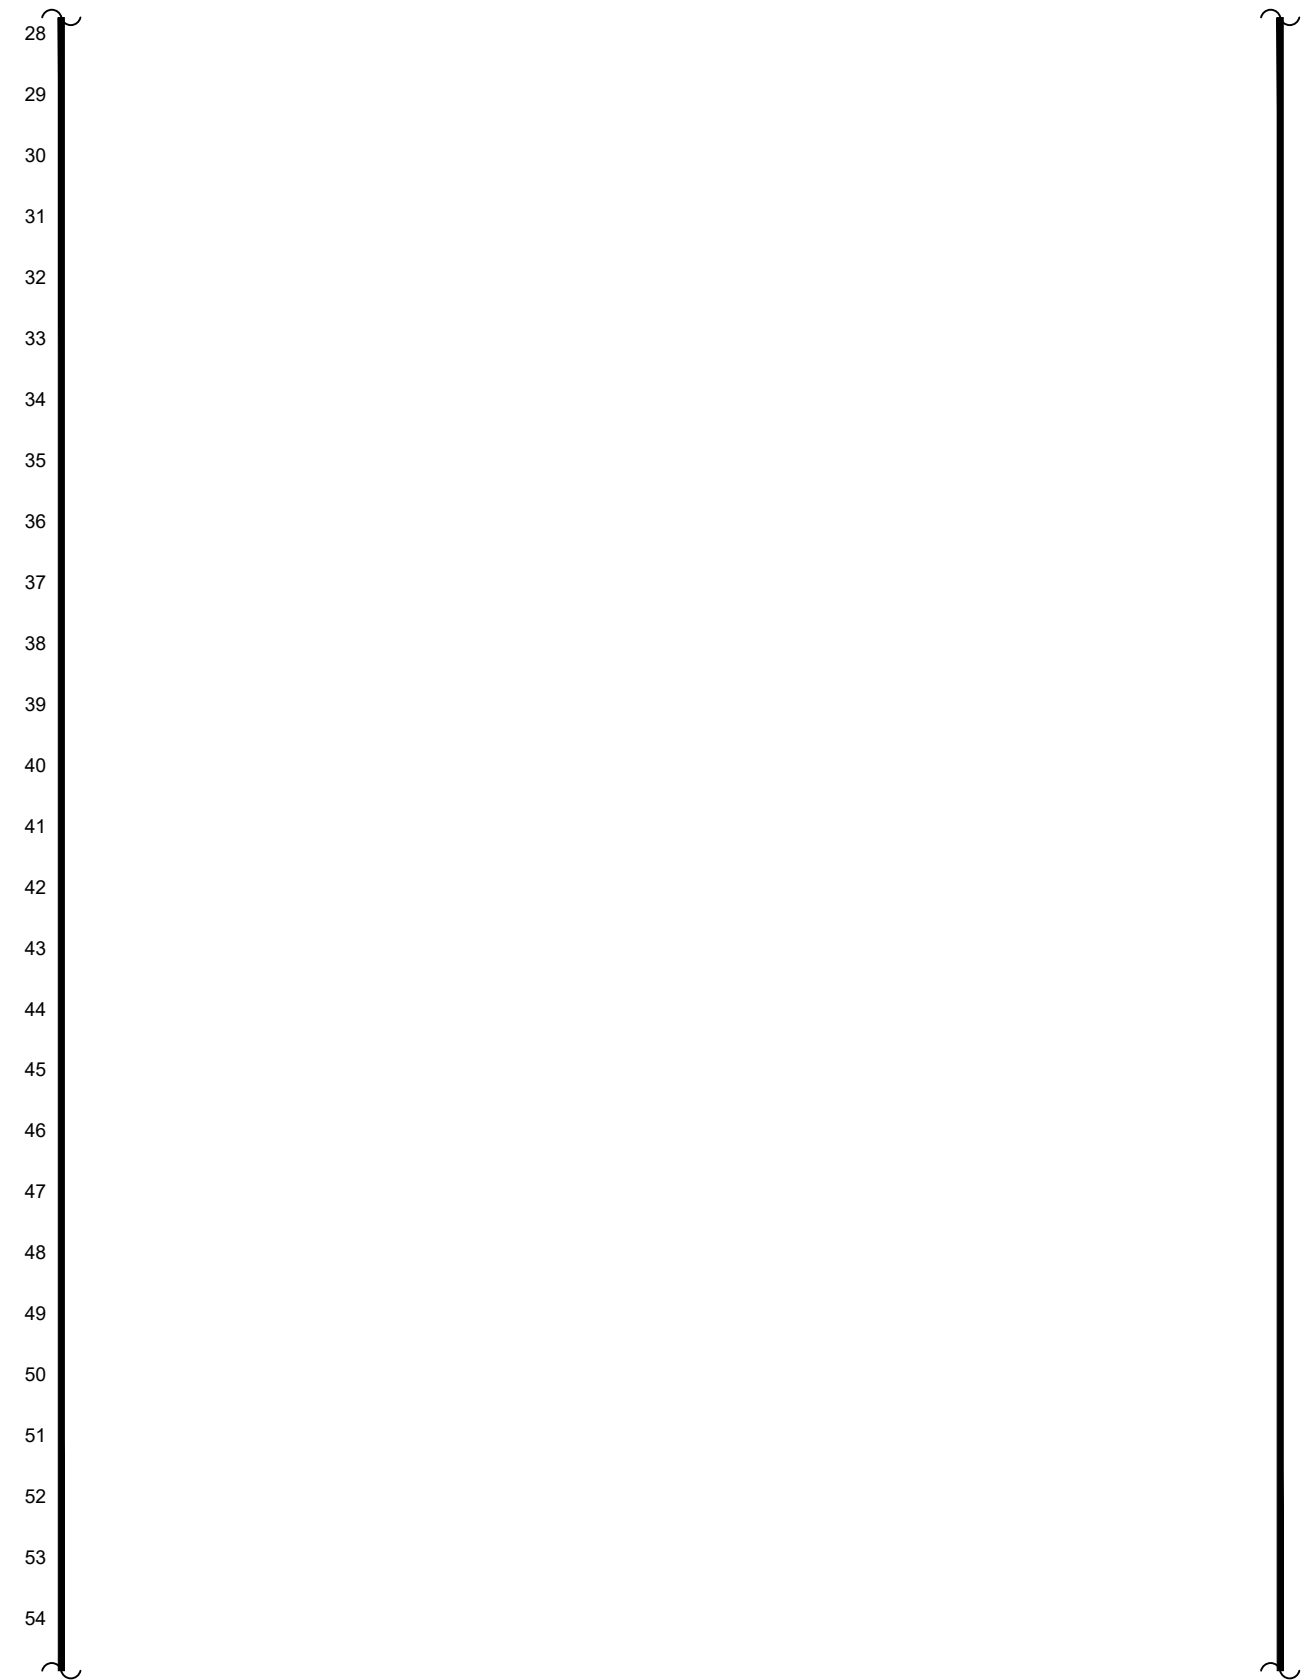
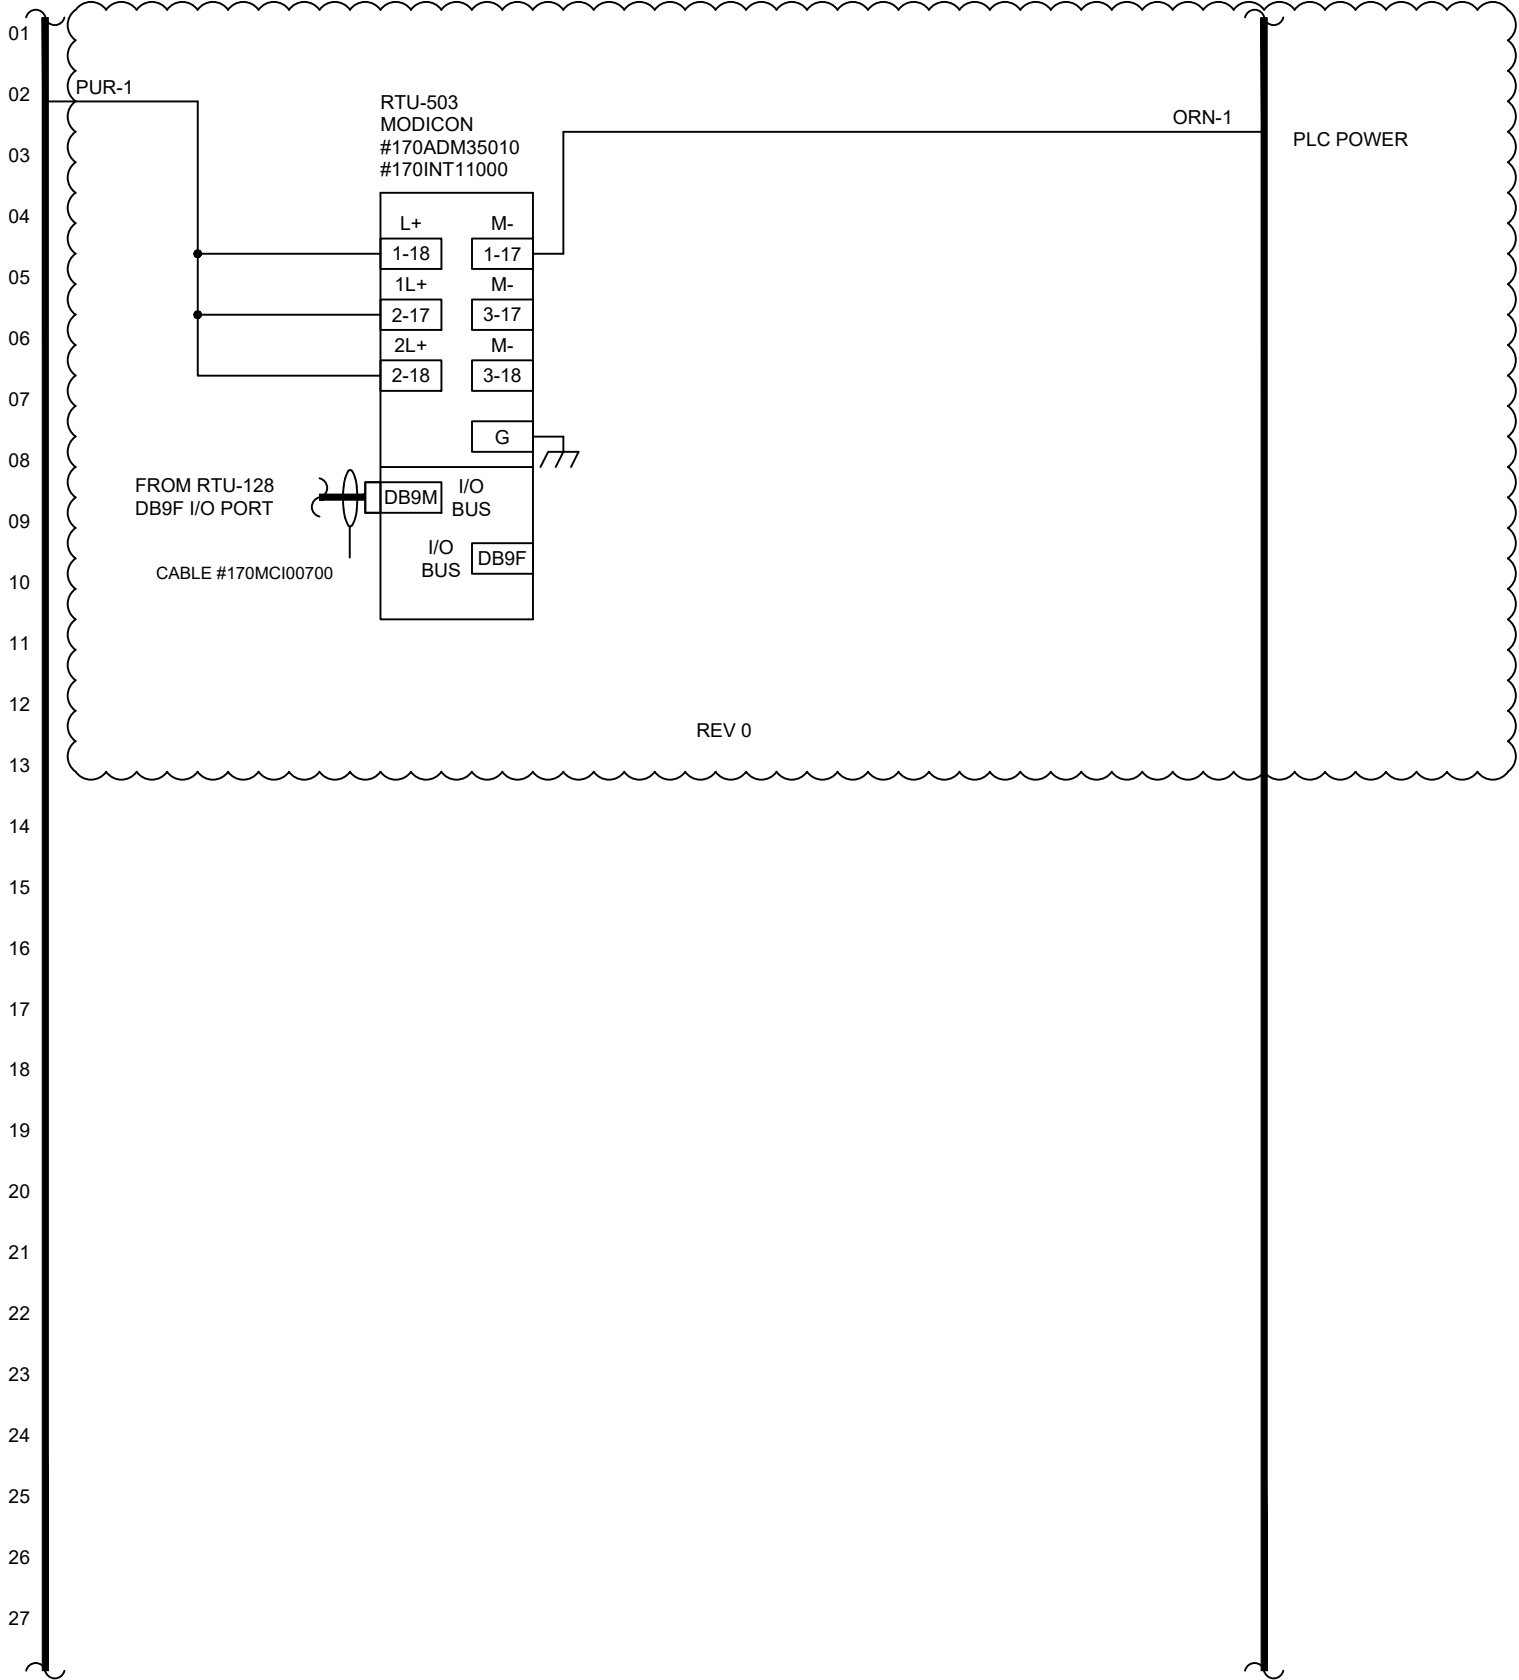


REV	DATE	DESCRIPTION	REV	DATE	DESCRIPTION	SCALE:	NAME	APPROVED	DATE	PROJECT - LOCATION	TITLE	
			3	00-00-00	AS INSTALLED	DO NOT SCALE	DESIGN BY:	N. FIELDS	NF	02-06-08	CITY OF FLOWERY BRANCH, GA. RADIO TELEMETRY SYSTEMS FLOWERY BRANCH, GA.	150,000 GAL ELEVATED TANK RTU-1 REMOTE TELEMETRY UNIT
			2	00-00-00	AS SHIPPED		DRAFTING:	N. FIELDS	NF	02-06-08		
			1	00-00-00	FOR MANUFACTURING		PROJ MGR:	L. PONN			PROJECT NO. 208005	DRAWING NO. 208005-3503-E05
			0	02-06-08	FOR APPROVAL		CHKD BY:	D. FOSTER				



Systems, Inc.
Service & System Integration
NORCROSS, GA GAINESVILLE, FL
COPYRIGHT ©1994-2008, M/R SYSTEMS, INC.

FOR REFERENCE ONLY

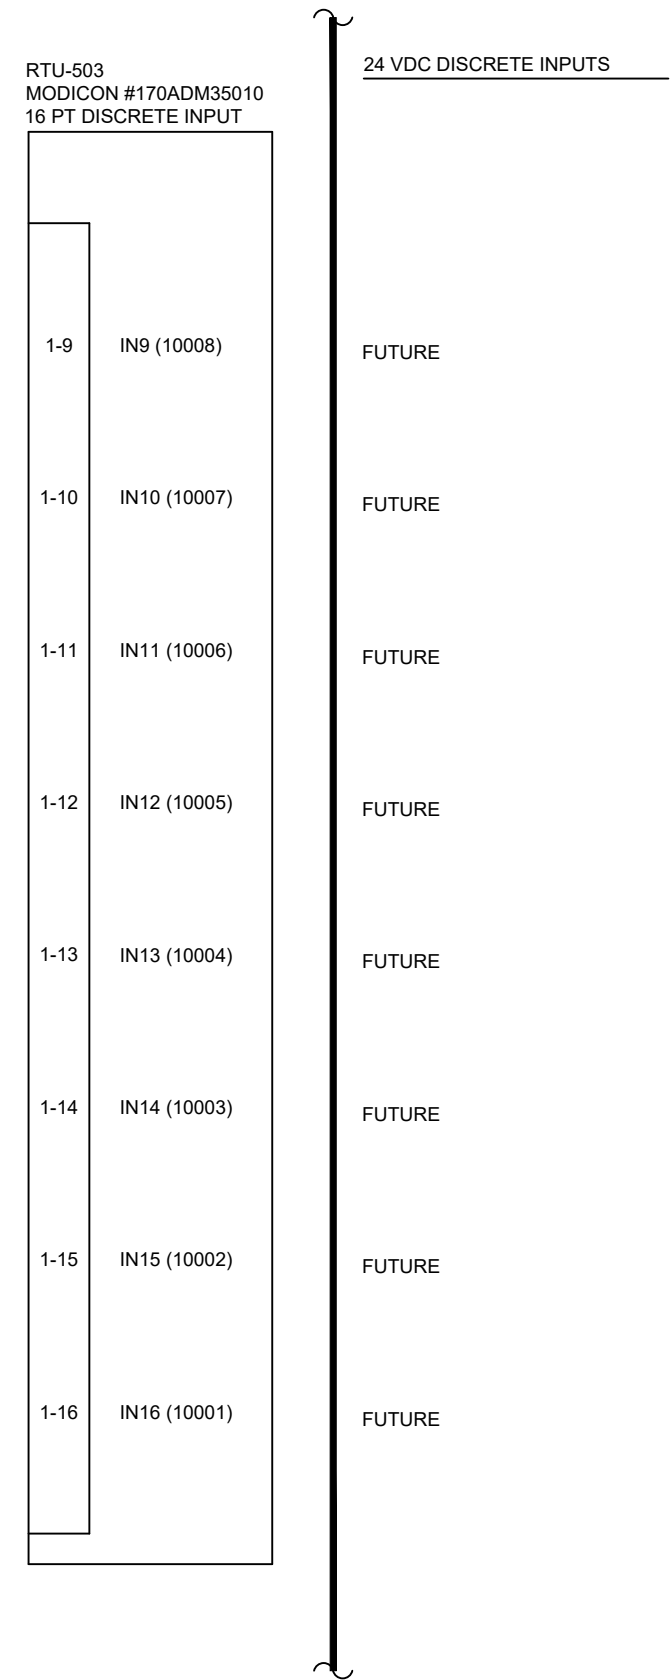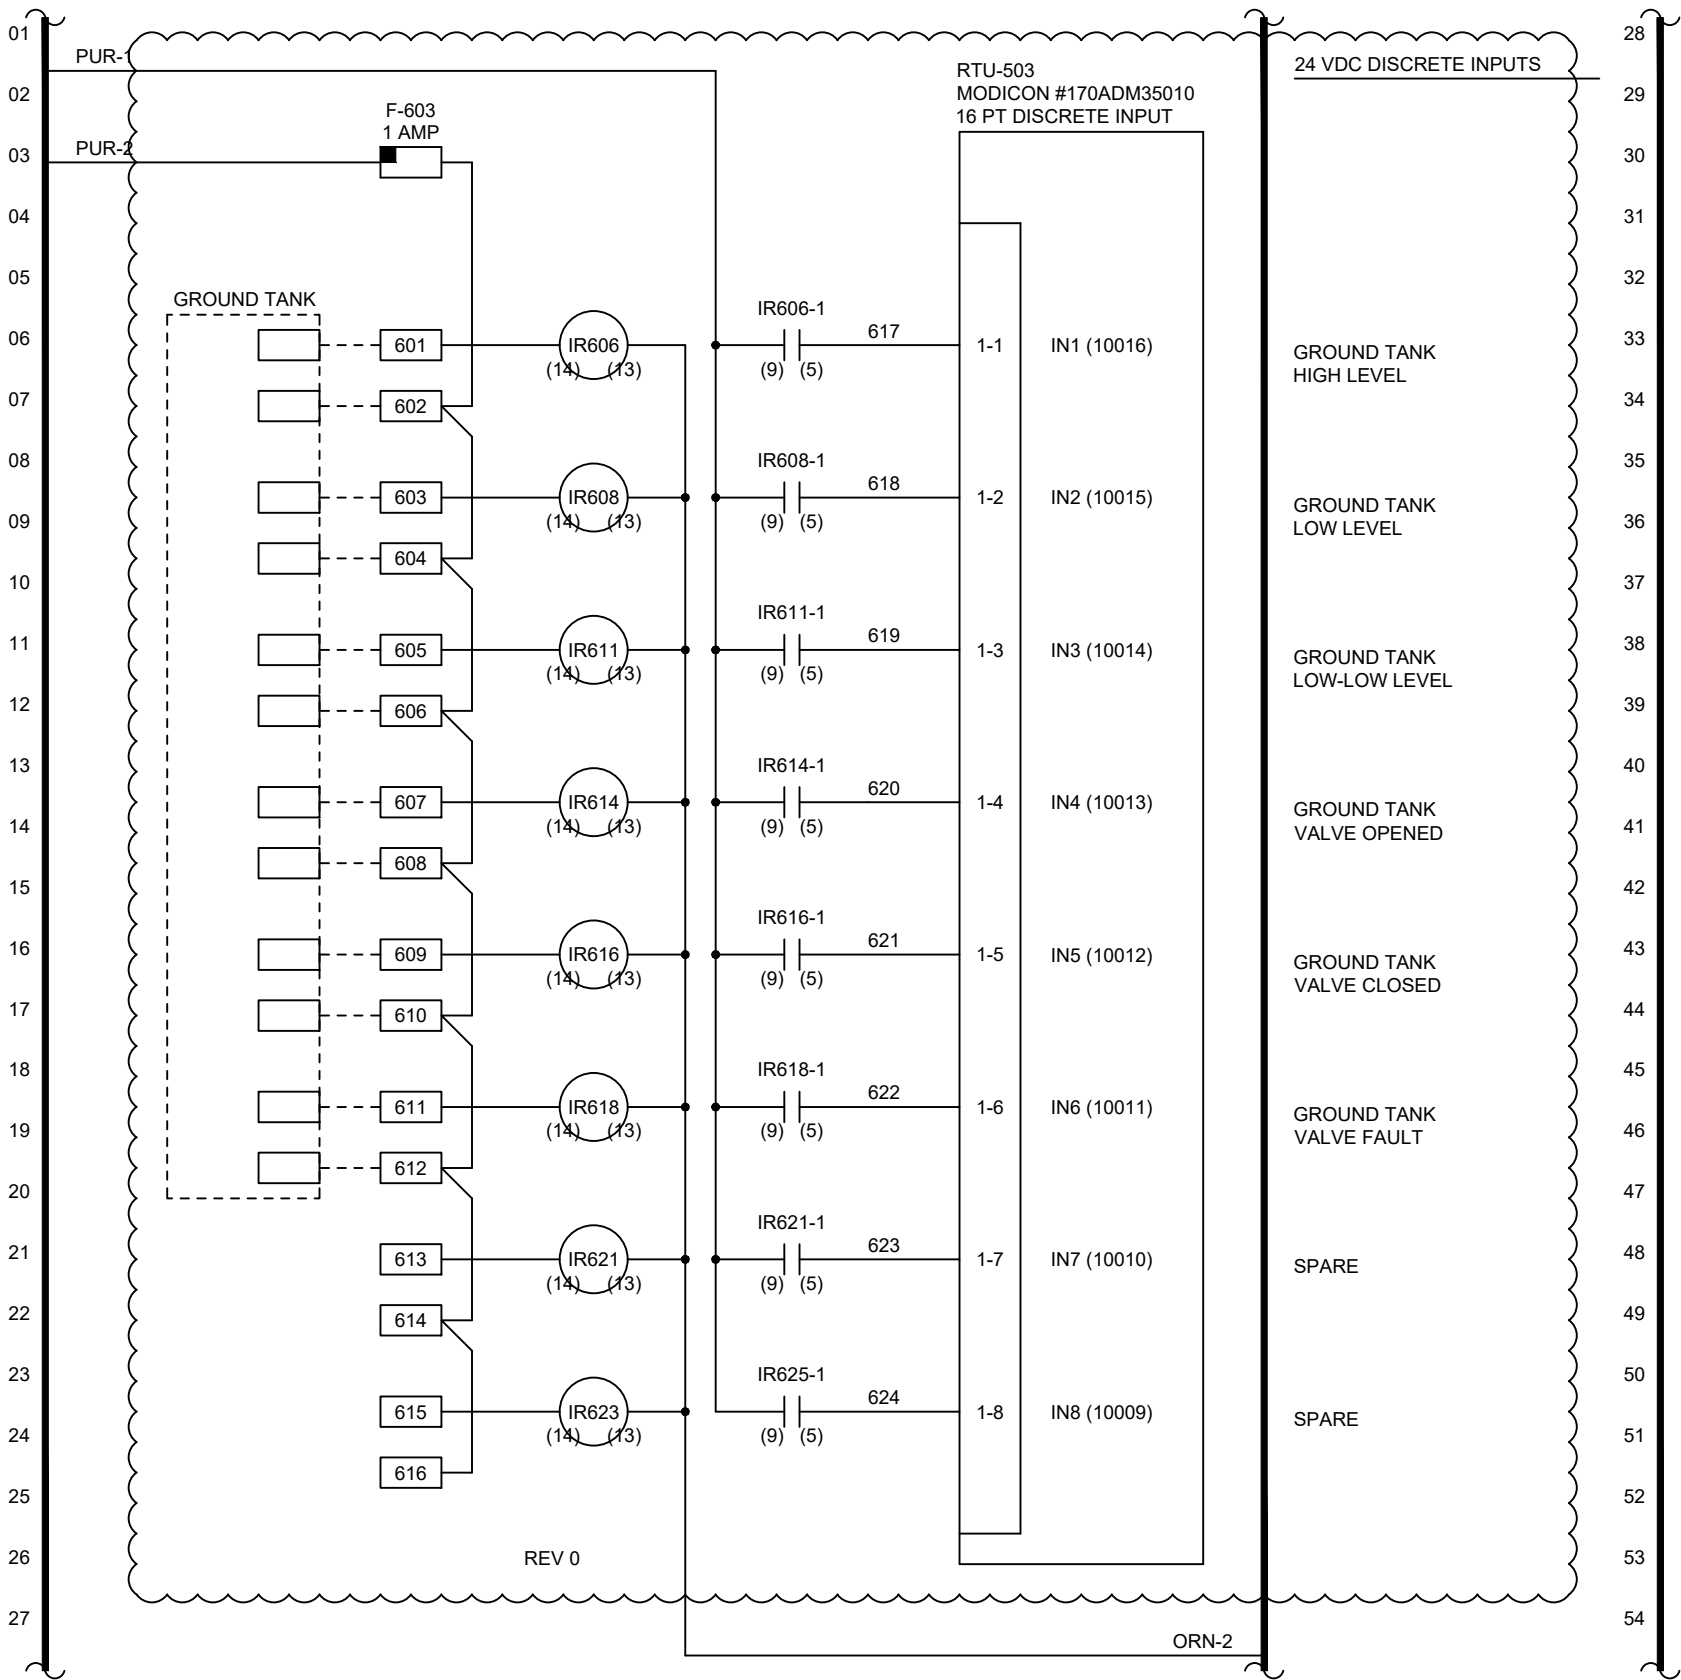

REV	DATE	DESCRIPTION	REV	DATE	DESCRIPTION
			3	00-00-00	AS INSTALLED
			2	00-00-00	AS SHIPPED
			1	00-00-00	FOR MANUFACTURING
			0	02-06-08	FOR APPROVAL


SCALE:	NAME	APPROVED	DATE
DO NOT SCALE	DESIGN BY:	N. FIELDS	NF
	DRAFTING:	N. FIELDS	NF
	PROJ MGR:	L. PONN	
	CHKD BY:	D. FOSTER	



Systems, Inc.
Service & System Integration

NORCROSS, GA GAINESVILLE, FL
COPYRIGHT ©1994-2008, M/R SYSTEMS, INC.



PROJECT - LOCATION	TITLE
CITY OF FLOWERY BRANCH, GA. RADIO TELEMETRY SYSTEMS FLOWERY BRANCH, GA.	150,000 GAL ELEVATED TANK RTU-1 REMOTE TELEMETRY UNIT
PROJECT NO. 208005	FILE: 2080503E06DWG SHT. 1 OF 1
DRAWING NO. 208005-3503-E06	

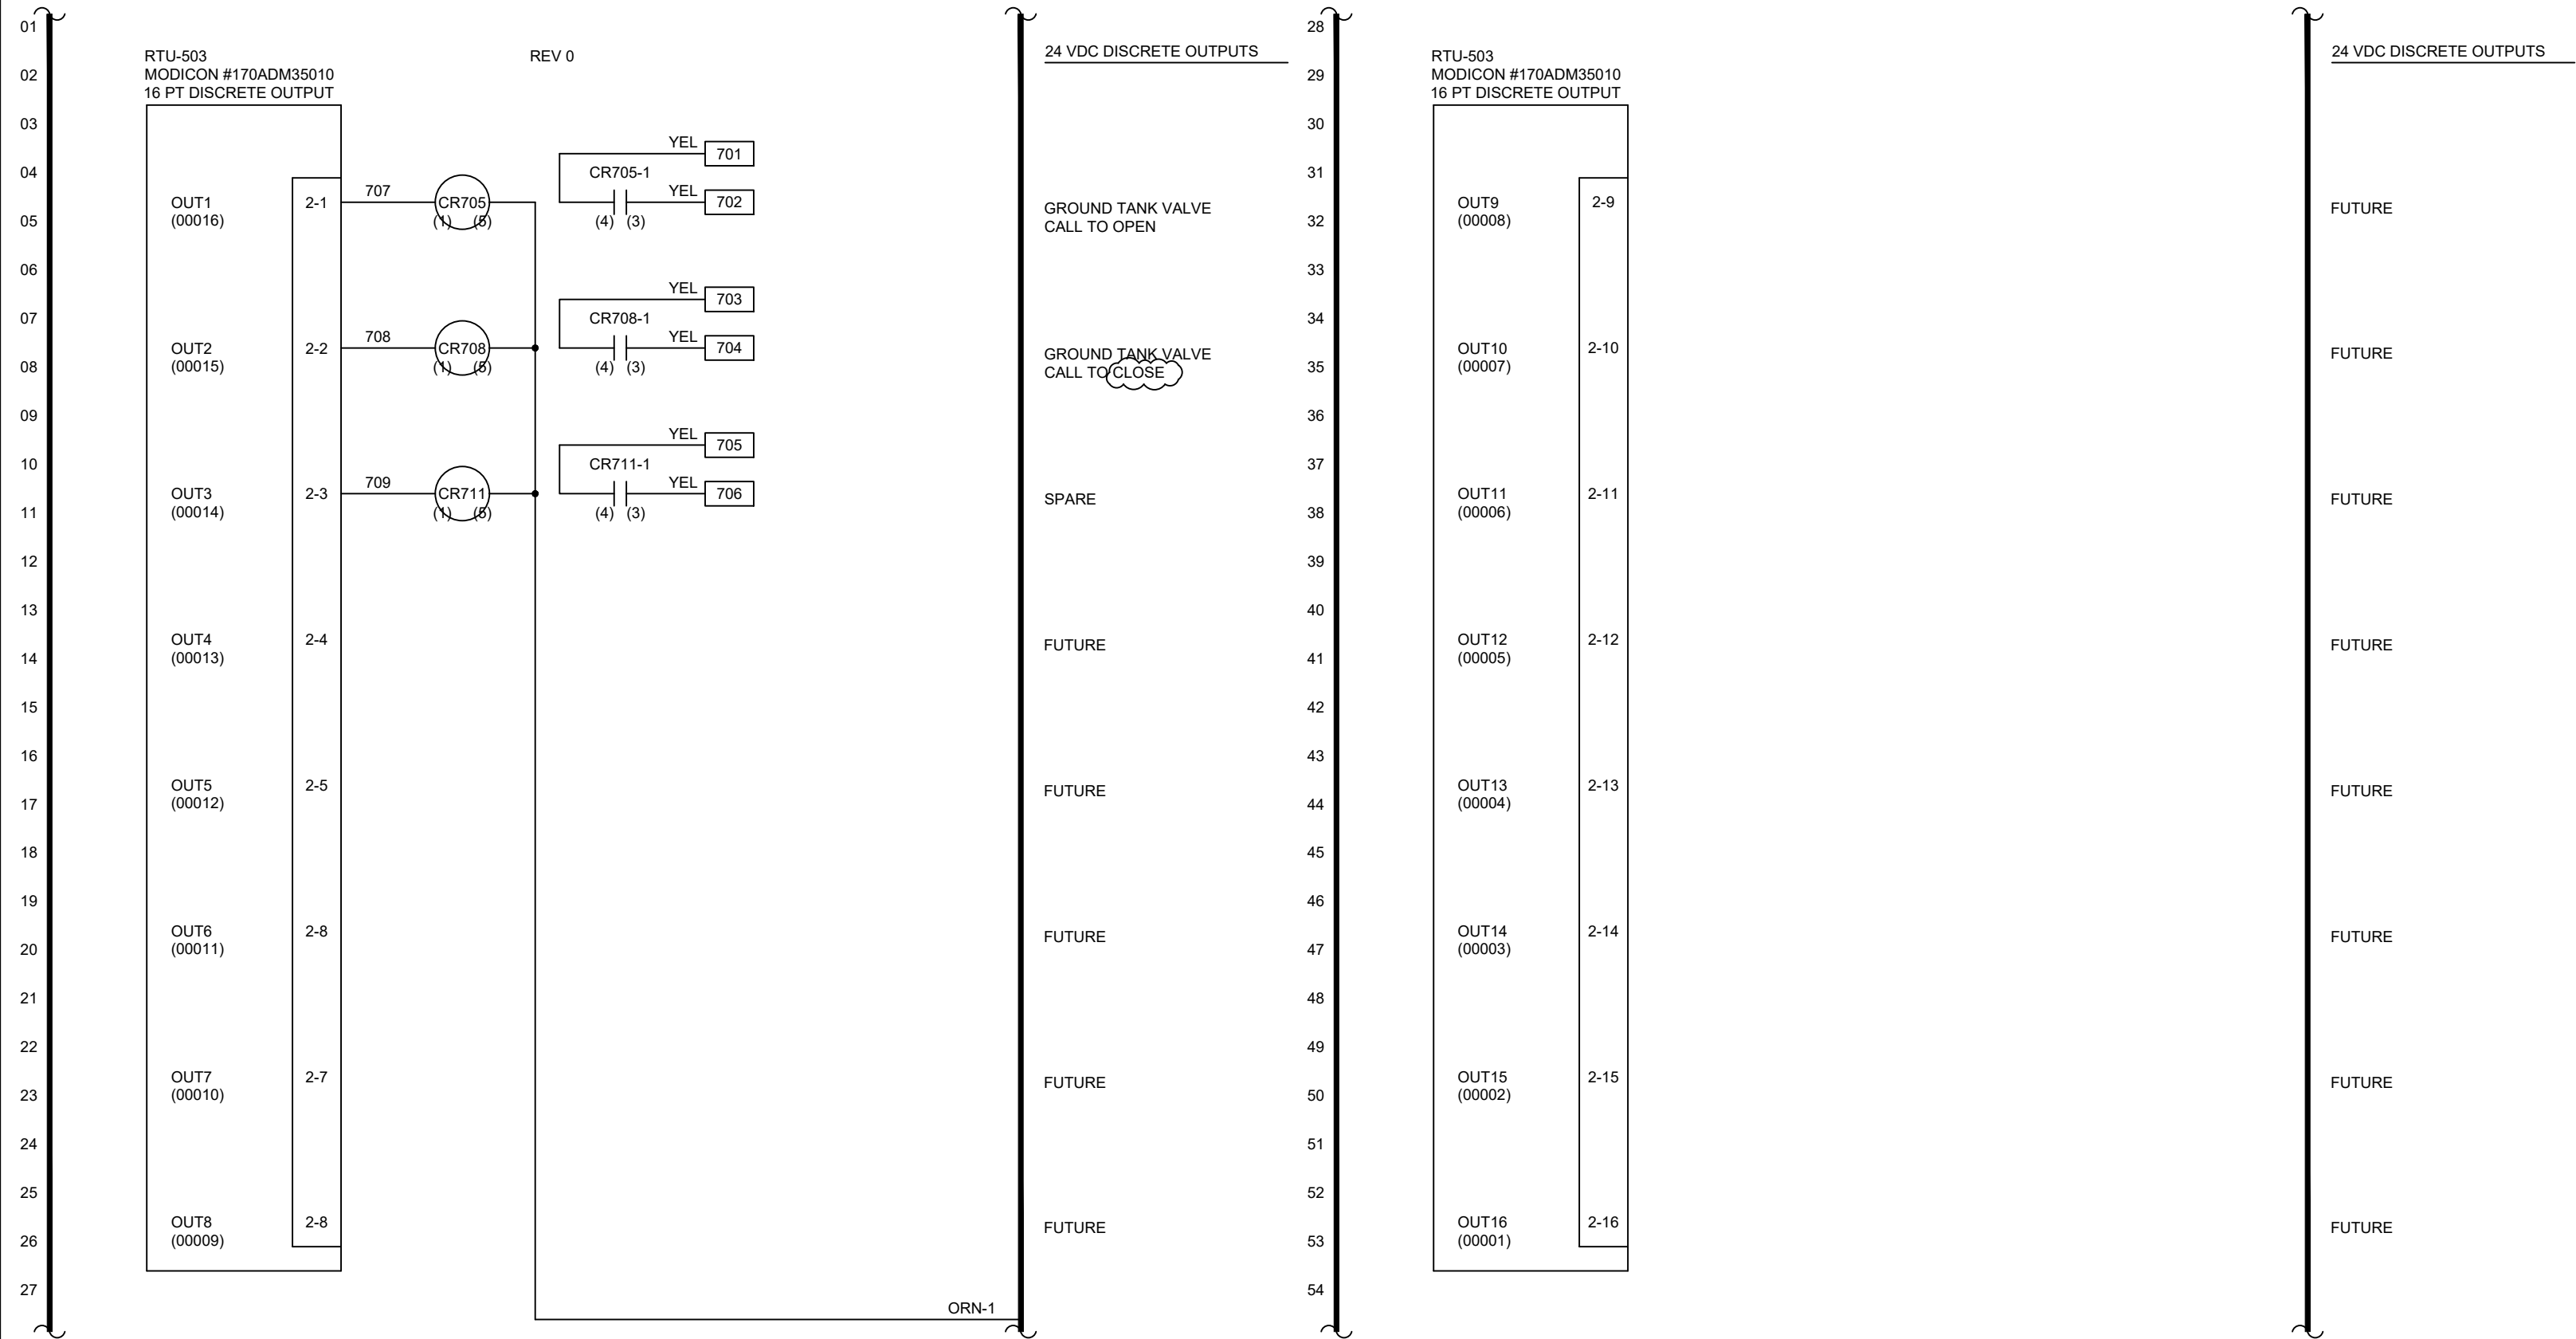

REV	DATE	DESCRIPTION	REV	DATE	DESCRIPTION	SCALE:	NAME	APPROVED	DATE	PROJECT - LOCATION	TITLE		
						DO NOT SCALE	DESIGN BY:	N. FIELDS	NF	02-06-08	 Systems, Inc. Service & System Integration NORCROSS, GA GAINESVILLE, FL COPYRIGHT © 1994-2008, M/R SYSTEMS, INC.	CITY OF FLOWERY BRANCH, GA. RADIO TELEMETRY SYSTEMS FLOWERY BRANCH, GA.	150,000 GAL ELEVATED TANK RTU-1 REMOTE TELEMETRY UNIT
					DRAFTING:		N. FIELDS	NF	02-06-08	FILE: 2080503E07DWG SHT. 1 OF 1			
			1	06-28-23	GENERAL REVISION		PROJ MGR:	L. PONN					
			0	02-06-08	FOR APPROVAL		CHKD BY:	D. FOSTER			PROJECT NO. 208005	DRAWING NO. 208005-3503-E07	

TABLE OF CONTENTS

1. TITLE SHEET
2. PLAN, SECTION-ELEVATION & NOTES
3. TYPICAL WALL DETAILS & PRESTRESSING SCHEDULE
4. TYPICAL PIPING ENCASEMENT AT WALL, 8" DIP OUTLET & 8"-14" DIP INLET
5. 8" YARD PIPING DETAIL & 8" DOME PROBE CURB
6. 650 GPM AERATOR
7. ACCESSORIES

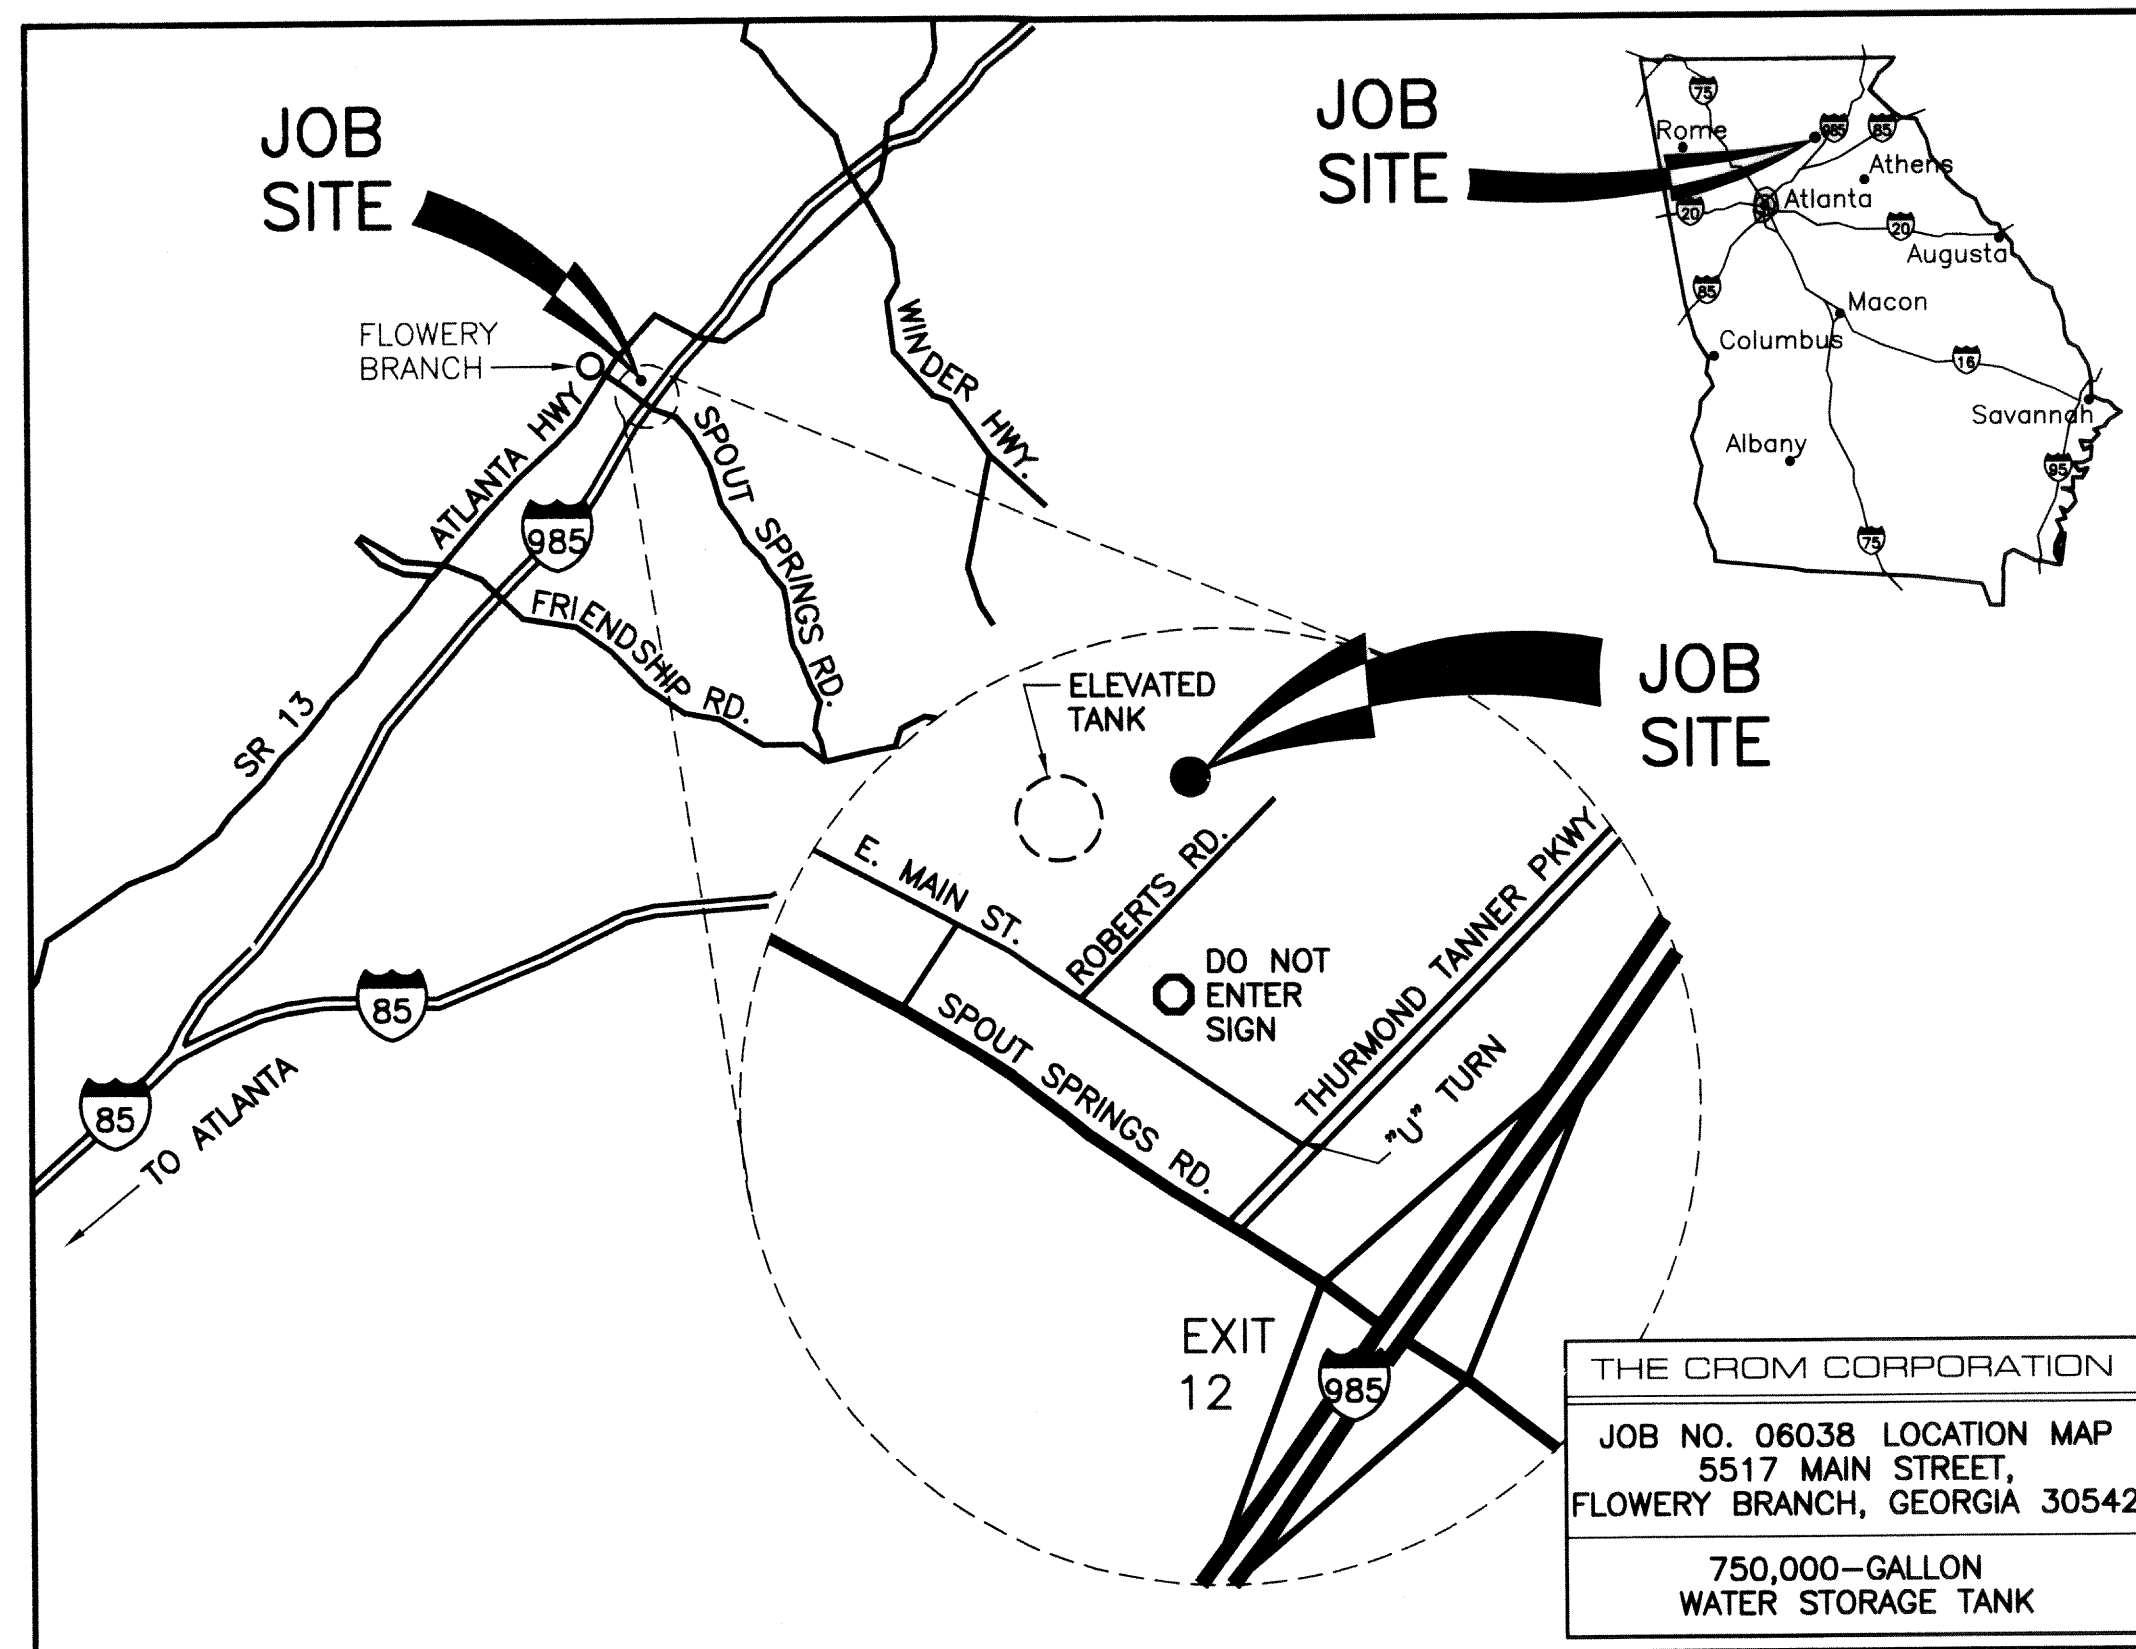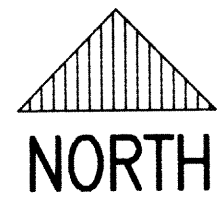

THE CROM CORPORATION
 JOB NO. 06038 LOCATION MAP
 5517 MAIN STREET,
 FLOWERY BRANCH, GEORGIA 30542
 750,000-GALLON
 WATER STORAGE TANK

750,000-GALLON WATER STORAGE TANK

PROJECT: ROBERTS DRIVE WATER STORAGE TANK
 FLOWERY BRANCH, GEORGIA

OWNER: CITY OF FLOWERY BRANCH
 FLOWERY BRANCH, GEORGIA

CONSULTING ENGINEER: RINDT-McDUFF ASSOCIATES, INC.
 MARIETTA, GEORGIA

AS BUILT
 THE CROM CORPORATION
 DATE: 3/13/07 BY: MAB




THE CROM CORPORATION
 Prestressed Composite Tanks



REV	COMMENTS	DATE

Revisions are designated by a letter following the FILE NUMBER.
 UPPER CASE letters indicate APPROVED distribution.

DATE:	FILE NUMBER:	SHEET
DRAWN: DM	06038	1 OF 7
CHECKED: Daw		
APPROVED: [Signature]		
DESIGNED:		

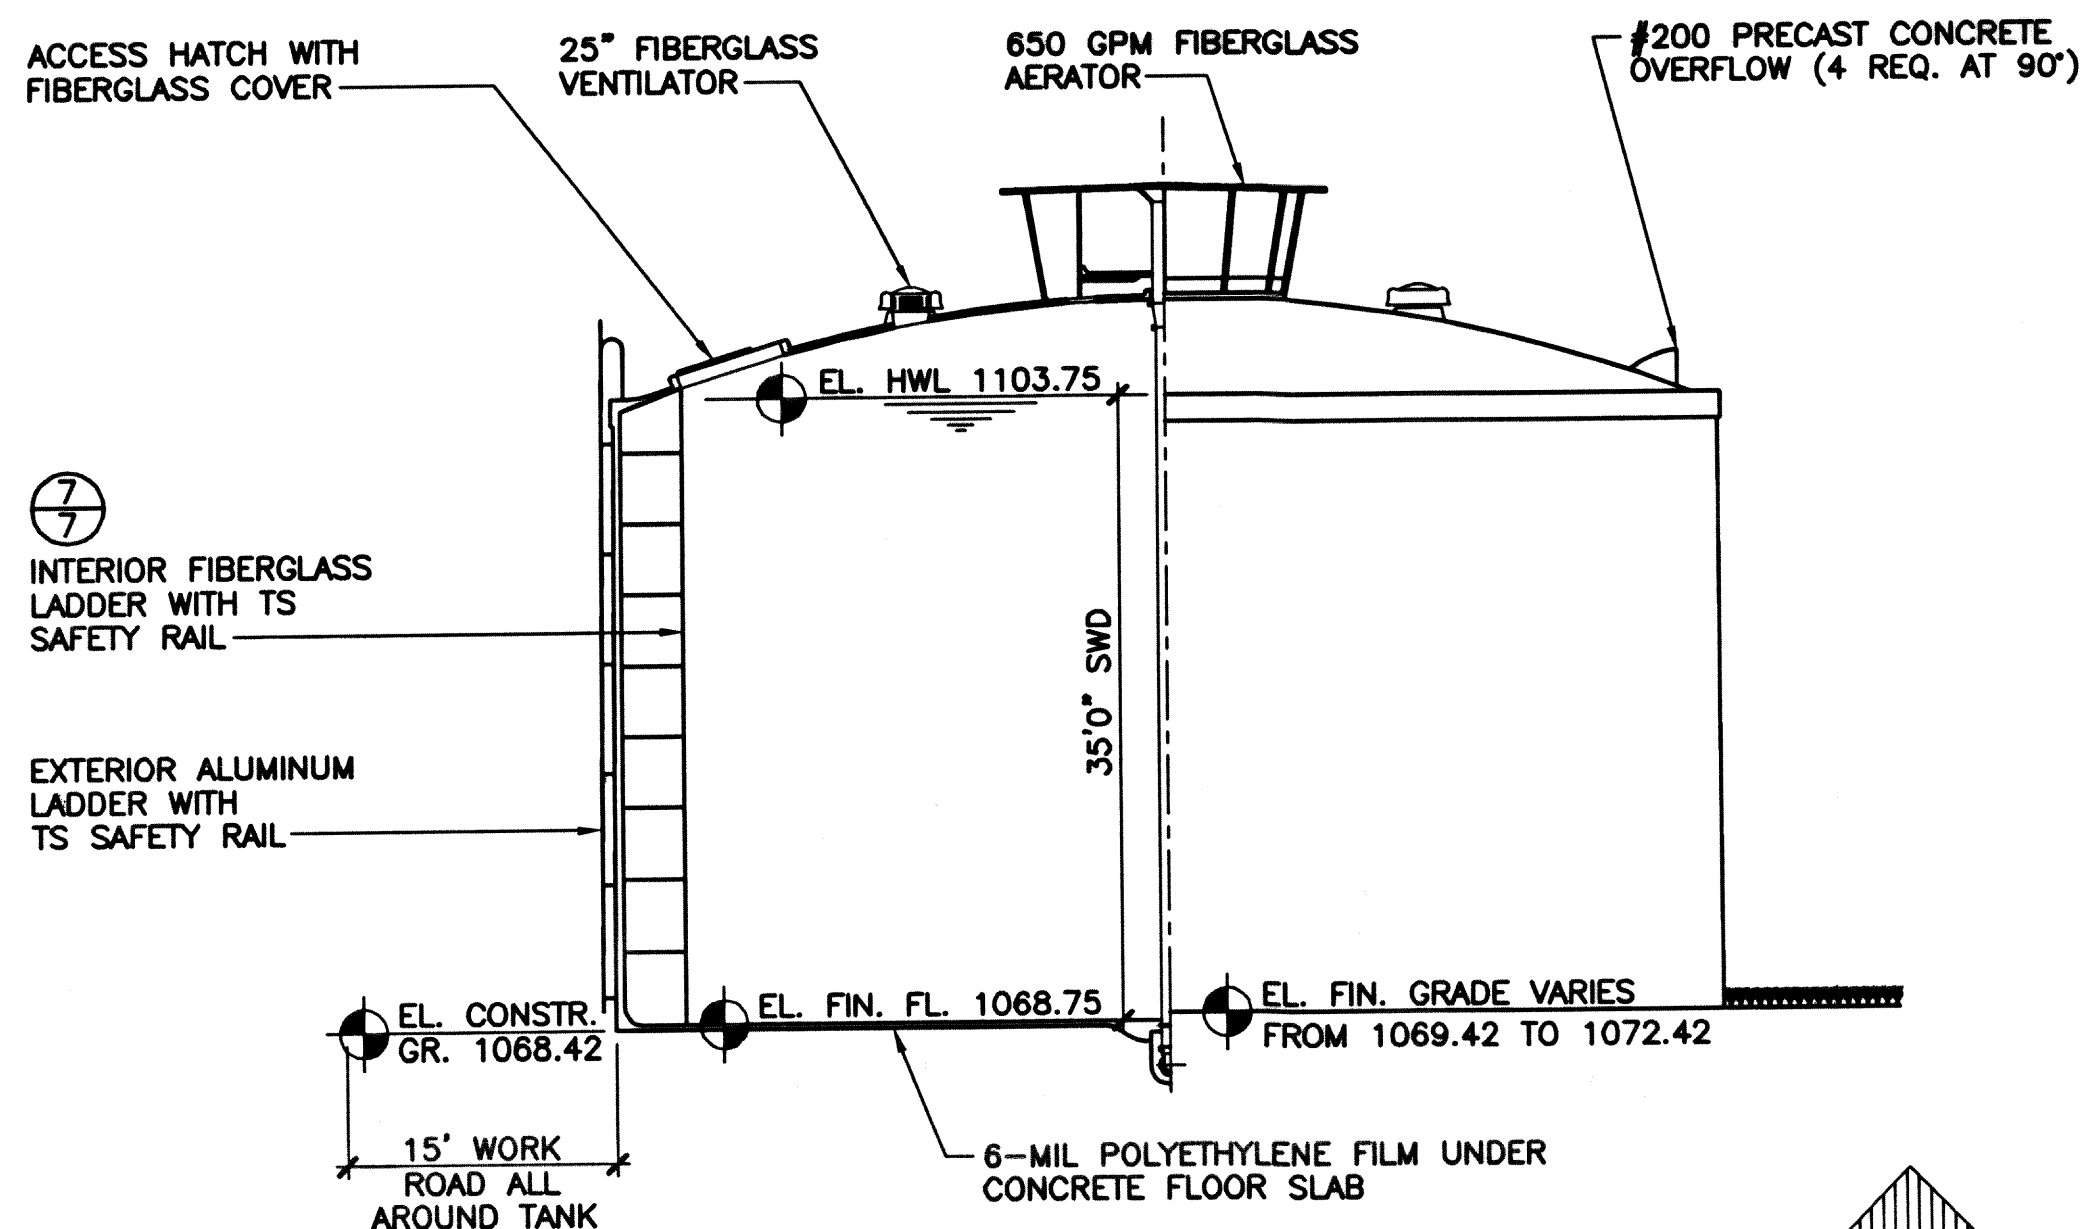

SECTION-ELEVATION

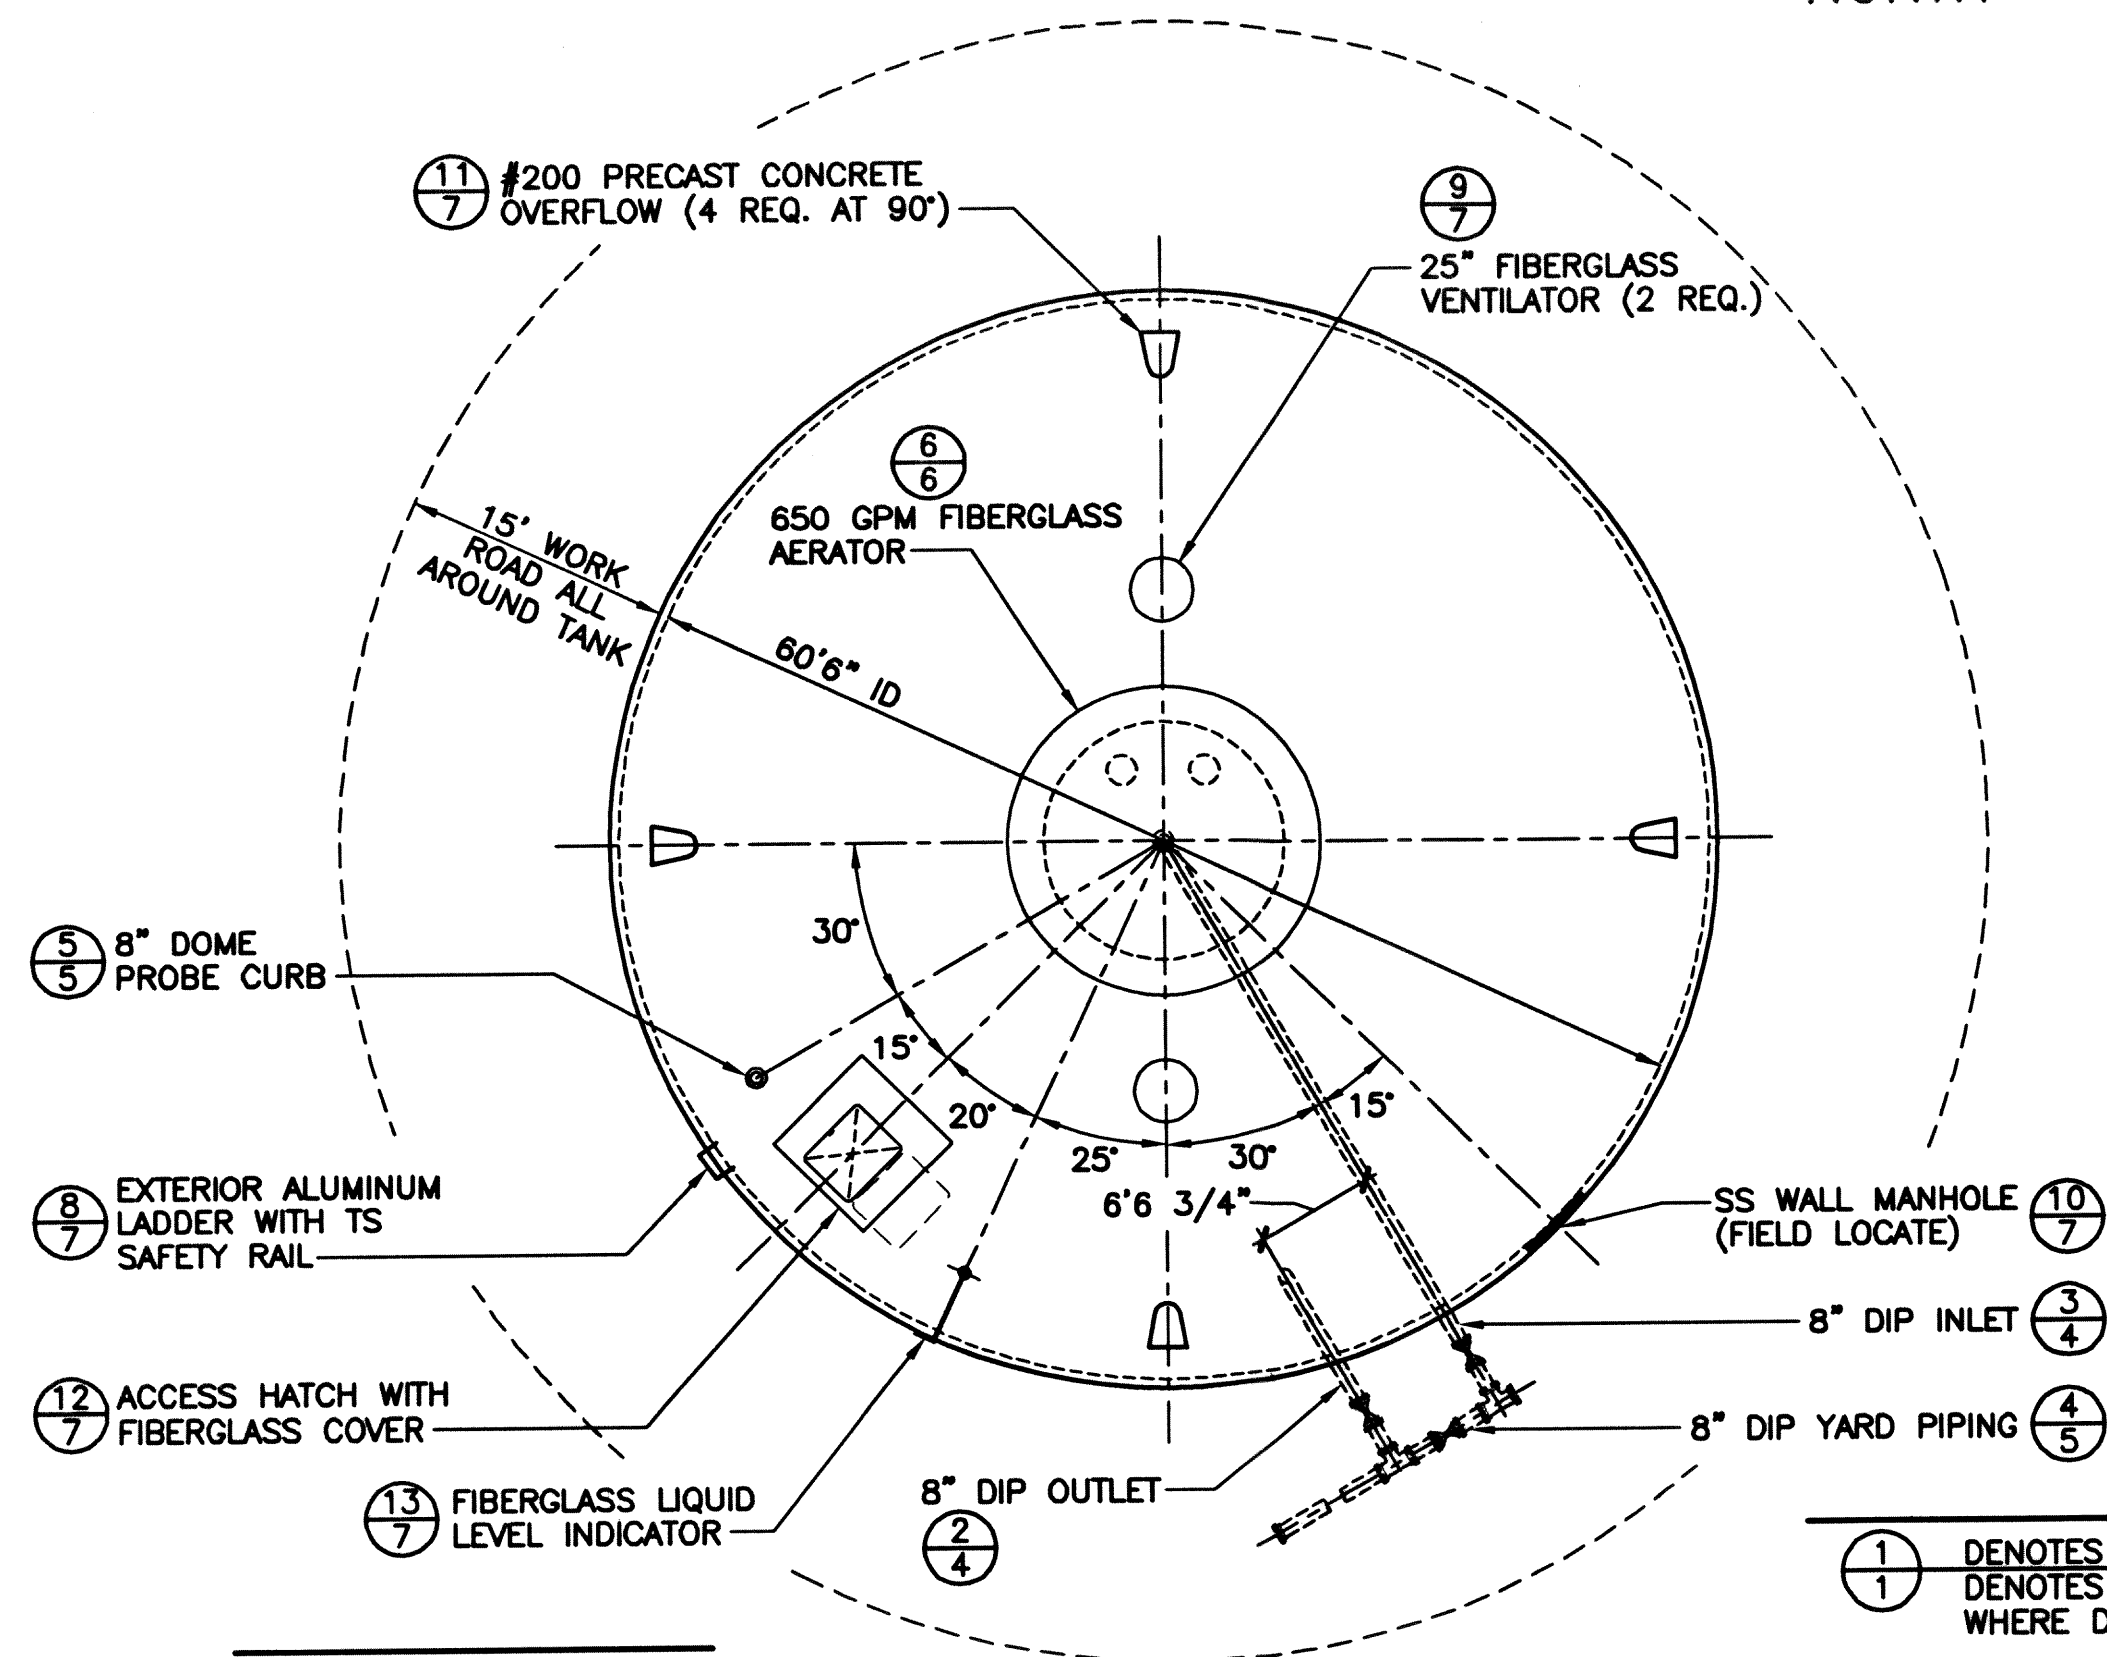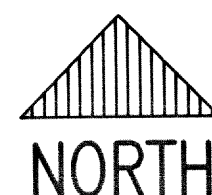

NOTE: FIELD VERIFY ALL ACCESSORY & PIPE LOCATIONS WITH ENGINEER PRIOR TO PLACEMENT.

- ①
1 DENOTES DETAIL NUMBER
DENOTES PAGE NUMBER
WHERE DETAIL APPEARS
- Ⓐ
1 DENOTES SECTION LETTER
DENOTES PAGE NUMBER
WHERE SECTION APPEARS

NOTES

Materials & Services Furnished by Others:

A. Miscellaneous:

1. Water and Electricity for construction.

Materials & Services Furnished By The Crom Corporation:

A. Sitework and Miscellaneous:

1. Clearing of the site, excavation, pipe placement, fill and compaction to an elevation 4" below floor slab on an 90'6" diameter circle.
2. Final grading and seeding.

B. Concrete: Use Type II Cement.

1. 4000 psi with 3/4" aggregate for floor.
2. 4000 psi with 3/8" aggregate pump mix for dome.

**C. Shotcrete Mixes: Use Type II Cement. f'g = 4000 psi
f'gi = 1800 psi**

1. Corewall and covercoat: Pump mix with 7 1/2 bags of cement minimum.

D. Material Testing:

1. Concrete: (4 cylinders per set) Test one cylinder at 7 days, two at 28 days and hold one.
 - a. 2 sets for floor.
 - b. 2 sets for dome.
2. Shotcrete: (4 cylinders per set) Test one cylinder at 7 days, two at 28 days and hold one.
 - a. 3 sets for outside core wall.
 - b. 2 sets for inside core wall.
 - c. 2 sets for covercoat.

E. Curing:

1. Floor and walls to be water-cured during tank construction in accordance with ACI-308.
2. Dome to be water-cured in accordance with ACI-308.

F. Reinforcing Steel:

1. ASTM A-615 grade 60, lap 38 diameters.
2. Use 2" slab bolsters with plate to support floor resteel.

G. Prestressing Wire: Meets ASTM Spec. A821-93 Type B

1. Aw : 0.0206 square inch (8 gauge)
2. Dia : 0.1620"
3. Ultimate strength: 231,000 psi
4. Initial stress: 145,600 psi
5. Working stress: wall: 115,000 psi
dome ring: 120,000 psi

H. Paint Schedule:

1. Exterior exposed surfaces: One coat "Thoroseal" and two coats Sherwin-Williams DTM acrylic latex paint.
2. Interior surfaces: Paint underside of the dome and top two feet of the tank wall with two coats of an NSF approved epoxy paint.
3. Tank lettering.

I. Standard Accessories:

1. Stainless steel wall manhole
2. Exterior aluminum ladder with Aluminum TS Safety Rail
3. Interior fiberglass ladder with SS TS Safety Rail and removable extension
4. 7' square fiberglass access hatch cover
5. 200 square inch precast overflow, 4 req.
6. 25" fiberglass ventilator, 2 req.
7. Fiberglass liquid level indicator

J. Special Accessories:

1. 8" dome probe curb
5. 650 GPM natural draft fiberglass Aerator

TANK BUILDER:

THE CROM CORPORATION
GAINESVILLE, FLORIDA

OWNER:

CITY OF FLOWER BRANCH
FLOWER BRANCH,
GEORGIA

CONSULTING ENGINEER:

RINDT-McDUFF
ASSOCIATES, INC.,
MARIETTA,
GEORGIA

TANK DESCRIPTION:

0.75-MG WATER
STORAGE TANK

TANK DIMENSIONS:

60'6" ID x 35'0" SWD

DATE: 7/13/06

DRAWN: DM

CHECKED: DSW

APPROVED: TBM

DESIGNED: KRJ

REV.	DESCRIPTION	DATE CK BY



WHERE STANDARD SPECIFICATIONS ARE IN CONFLICT WITH CROM CORPORATION SPECIFICATIONS OR WITH GOOD PRESTRESSING OR SHOTCRETE PRACTICES THE STANDARD SPECIFICATIONS SHALL BE SUBORDINATED. THIS DESIGN AND DRAWING ORIGINATED BY AND THE EXCLUSIVE PROPERTY OF THE CROM CORPORATION.

BAR IS ONE INCH ON ORIGINAL DRAWINGS 0 1"

SCALE: 2' 0 5' 10'
3/32"=1'0"

FILE NO.
06038

SHEET **2** OF **7**

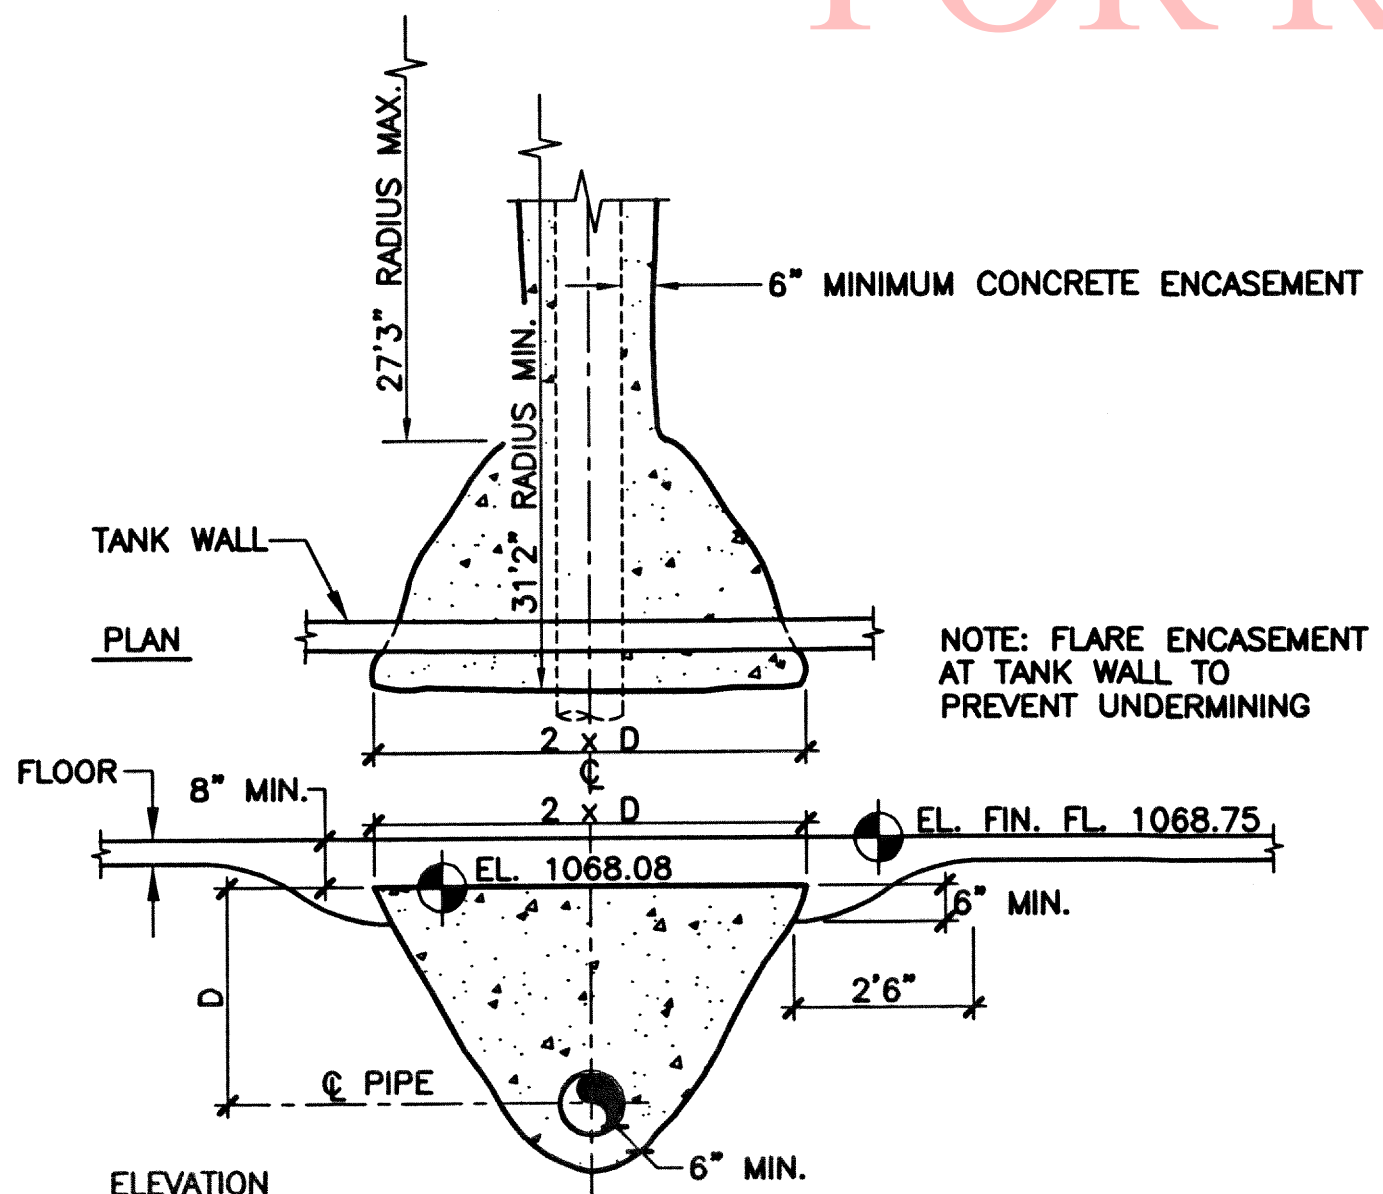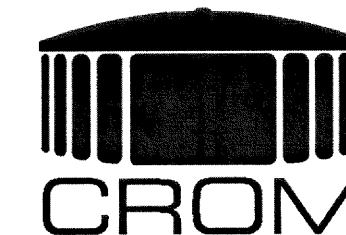

1 TYPICAL PIPE ENCASEMENT AT WALL
NTS

PIPE SCHEDULE FOR 14" DIP INLET



- * ① 14" DIP 9'6 1/2" PE-FL
- * ② 14" x 8" REDUCER FL-FL
- 1-14" FLG ACCESSORY SET

PIPE SCHEDULE FOR 8" DIP INLET


- * ③ 8" DIP x 17'6" LONG FL-FL
- * ④ 8" DIP x 17'6" LONG FL-FL
- * ⑤ 8" DIP x 3'5 1/2" LONG FL-PE
- ⑥ 8" DIP CLASS 350 (COMPACT) MJ 90° BEND
- ⑦ 8" DIP x 17'6" LONG PE-MJ
- ⑧ 8" DIP x 15'11" LONG PE-PE
- 3-8" FLANGE ACCESSORY SETS
- 3-8" MJ ACCESSORY SETS
- * SHOP PRIME

PIPE SCHEDULE FOR 8" DIP OUTLET

- ① 8" DIP x 2'8 1/2" LONG PE-PE WITH WATERSTOP RING 4" FROM END
- ② 8" DIP CLASS 350 (COMPACT) MJ 90° BEND
- ③ 8" DIP x 8'1" LONG PE-PE
- 2-8" MJ ACCESSORY SETS

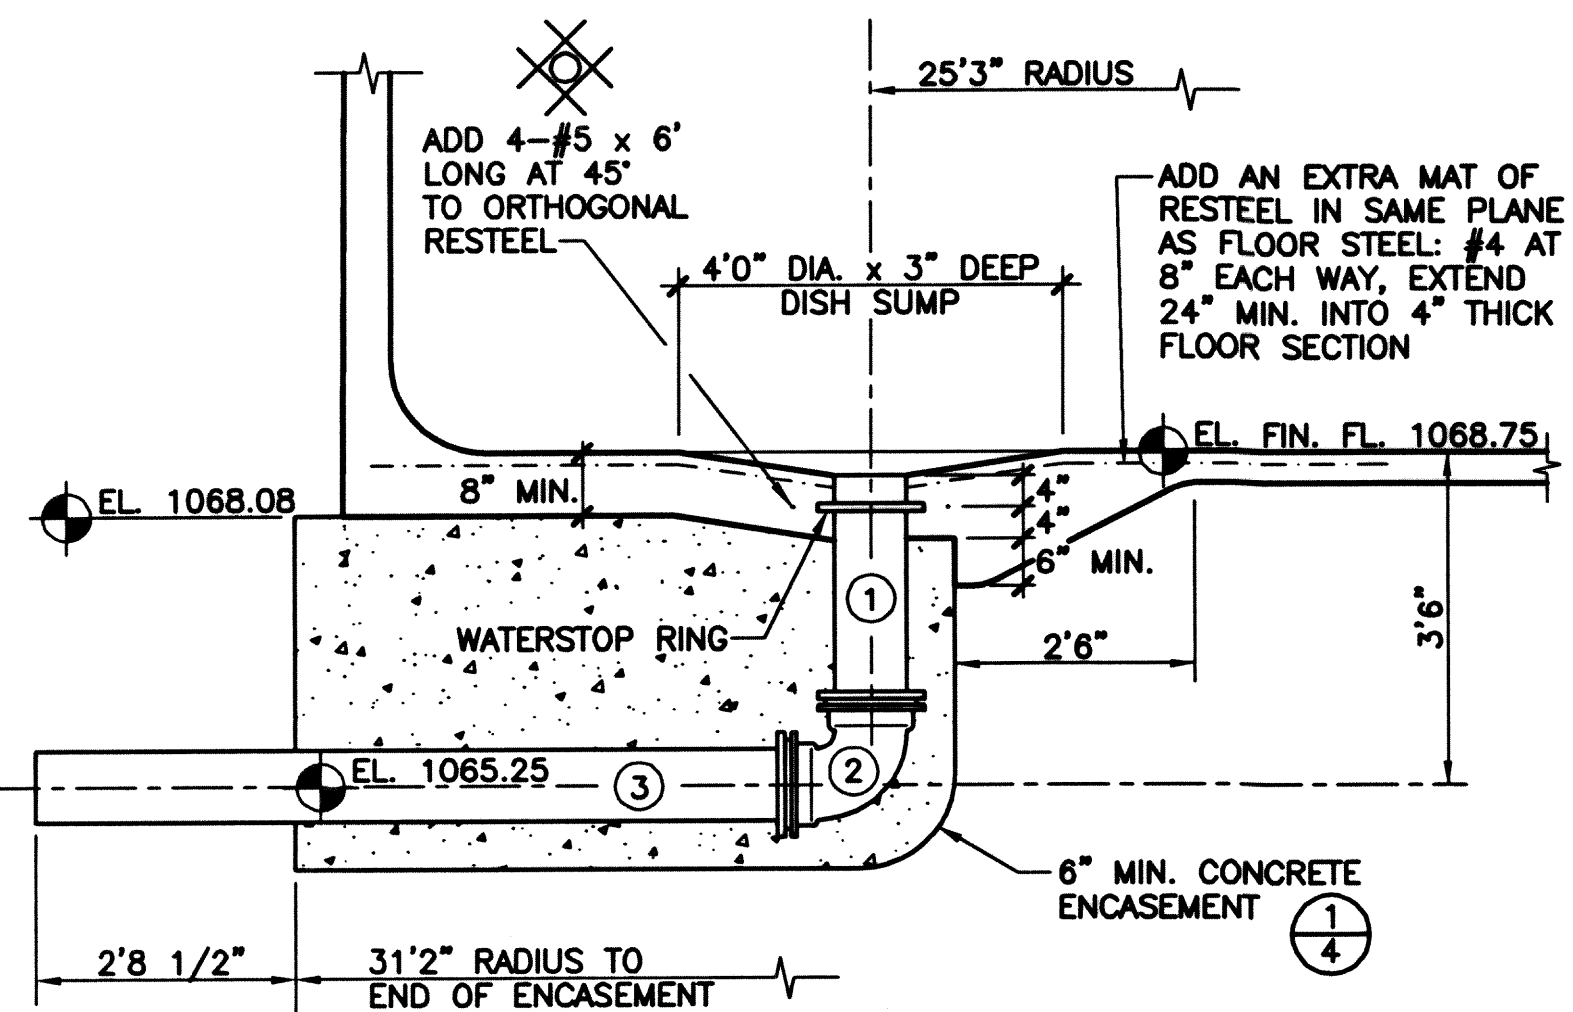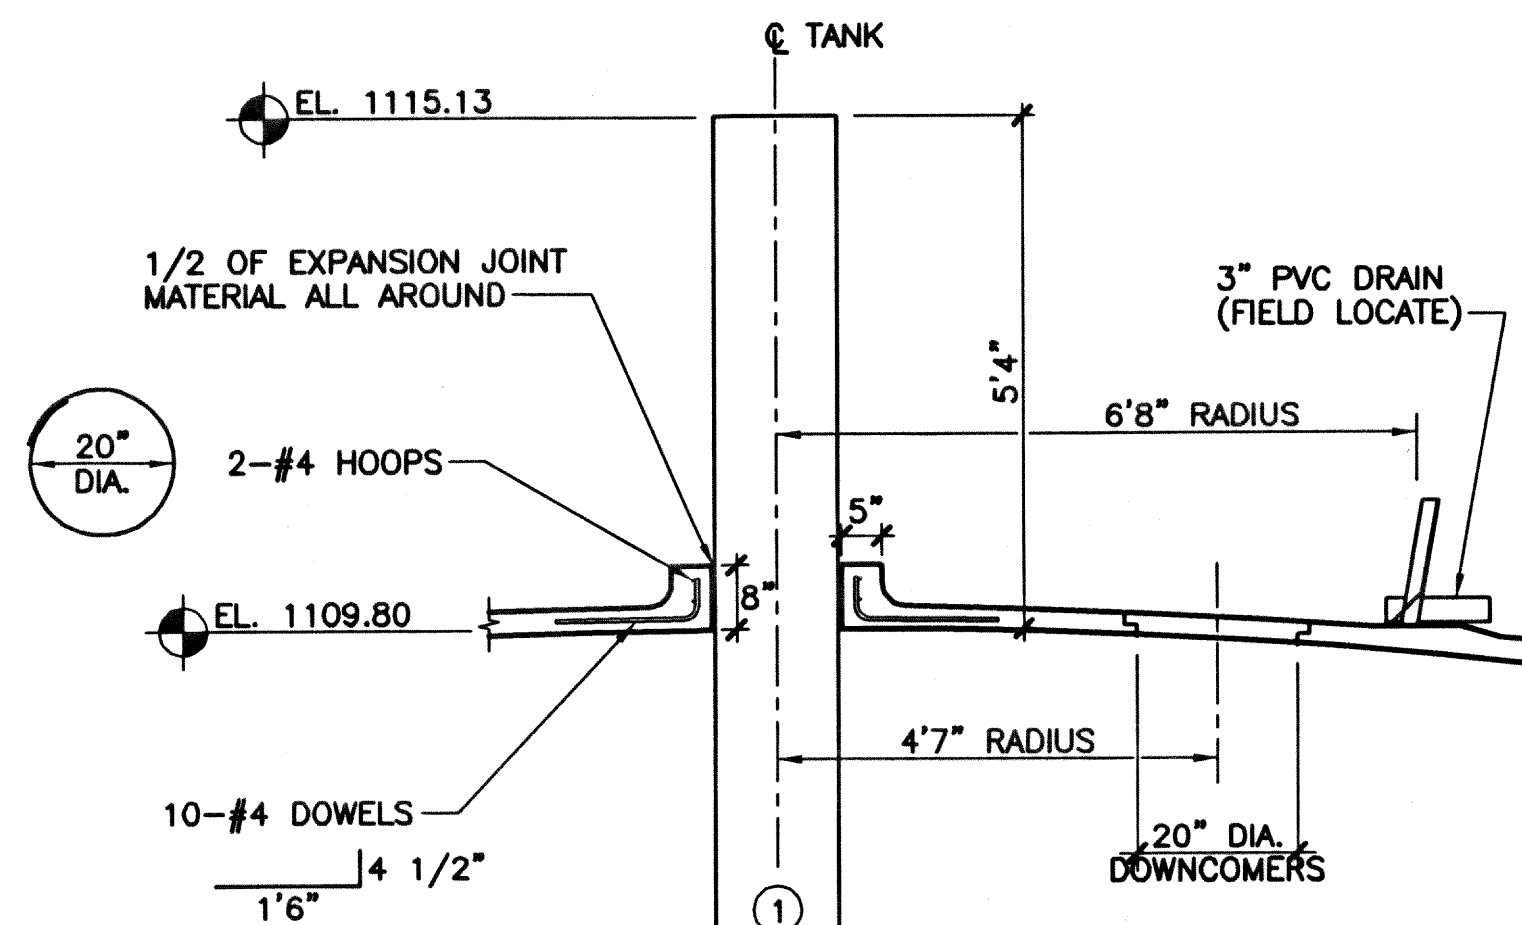

2 8" DIP OUTLET
1/2" = 1'0"

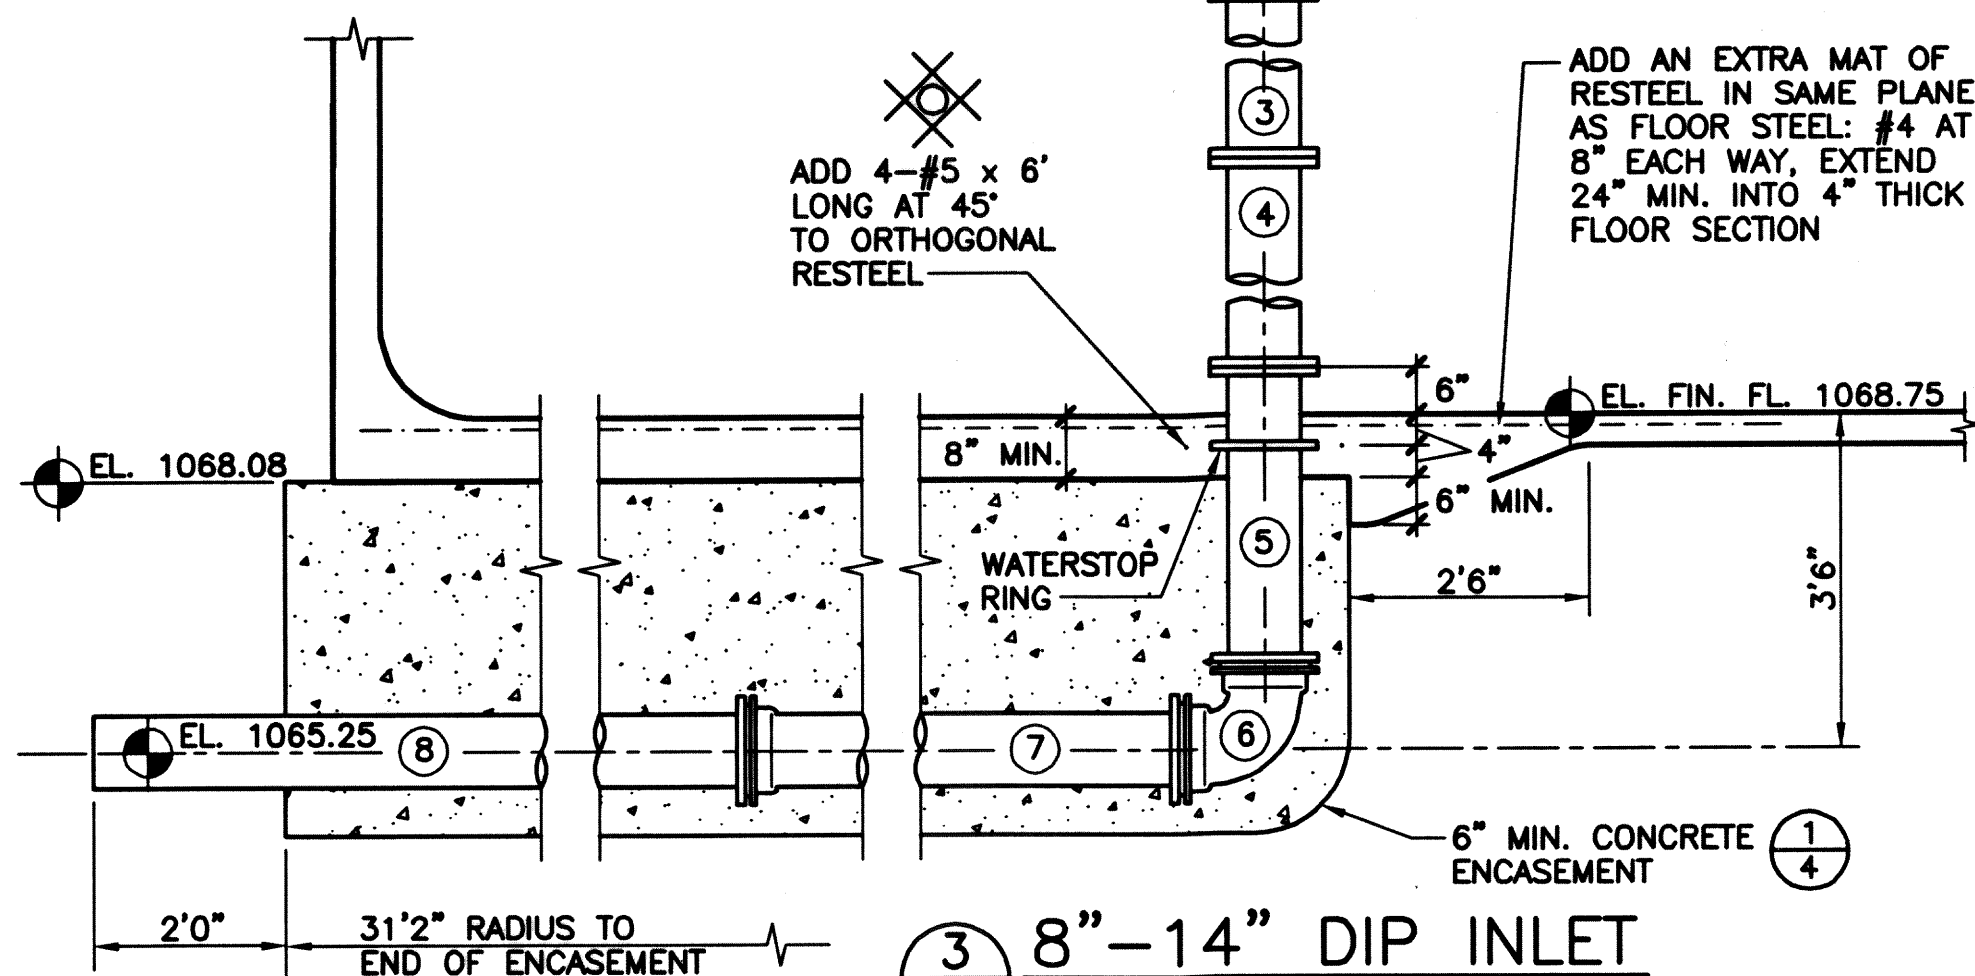

3 8"-14" DIP INLET
1/2" = 1'0"

TANK BUILDER:
THE CROM CORPORATION
GAINESVILLE, FLORIDA

OWNER:
CITY OF FLOWER BRANCH
FLOWER BRANCH,
GEORGIA

CONSULTING ENGINEER:
RINDT-McDUFF
ASSOCIATES, INC.,
MARIETTA,
GEORGIA

TANK DESCRIPTION:
0.75-MG WATER
STORAGE TANK

TANK DIMENSIONS:
60'6" ID x 35'0" SWD

DATE: 7/13/06

DRAWN: DM

CHECKED: JGW

APPROVED: TBM

DESIGNED: KPL

REV.	DESCRIPTION	DATE CK. BY

WHERE STANDARD SPECIFICATIONS ARE IN CONFLICT WITH CROM CORPORATION SPECIFICATIONS OR WITH GOOD PRE-STRESSING OR SHOTCRETE PRACTICES THE STANDARD SPECIFICATIONS SHALL BE SUBORDINATED.
THIS DESIGN AND DRAWING ORIGINATED BY AND THE EXCLUSIVE PROPERTY OF THE CROM CORPORATION.

BAR IS ONE INCH ON ORIGINAL DRAWINGS 0 1"

SCALE:



FILE NO.
06038

SHEET **4** OF **7**




PIPE SCHEDULE FOR 8" YARD PIPING

- * ① 8" DIP RUN CONNECT TO EXISTING VALVE (3 STICKS)
- ② 8" DIP GATE VALVE MJ-MJ W/BOX (3 REQ.)
- ③ 8" DIP TEE MJ-MJ-MJ (2 REQ.)
- ④ 8" DIP x 2'0" PE-PE (4 REQ.)
- ⑤ 8" MJ PLUG (1 REQ.)
- 12 MJ ACCESSORY SETS
- * PROVIDE MEGALUGS AT ALL JOINTS

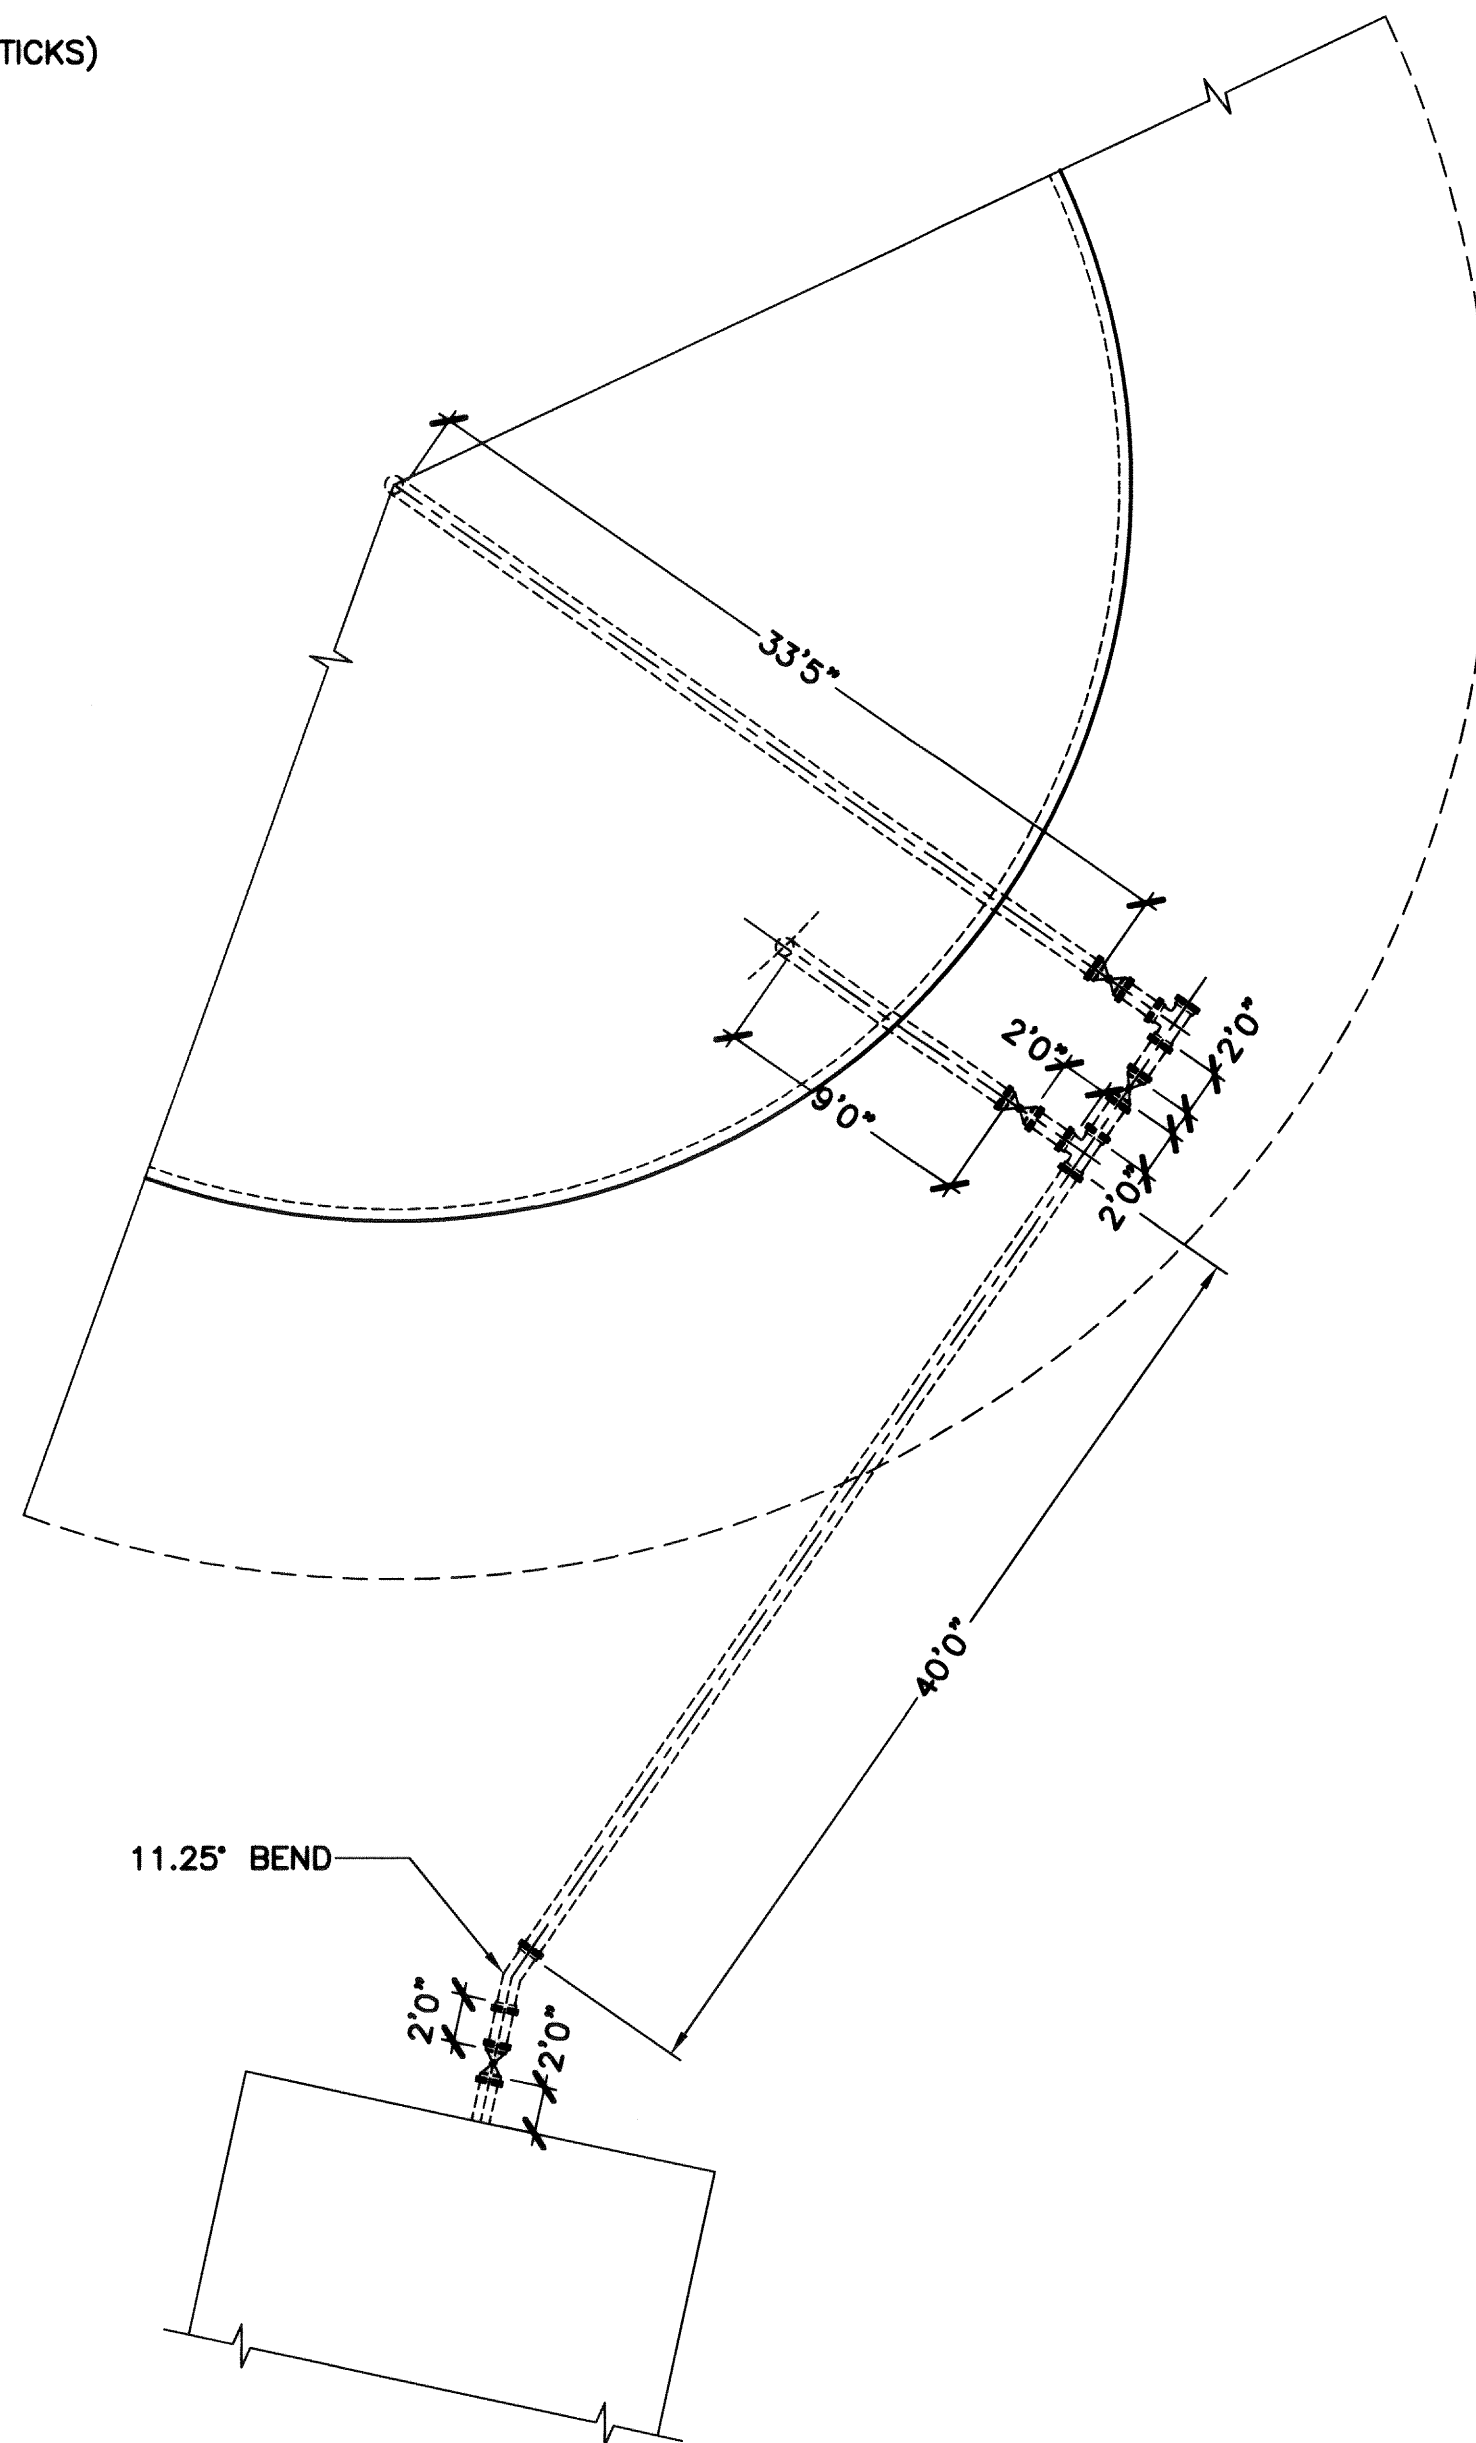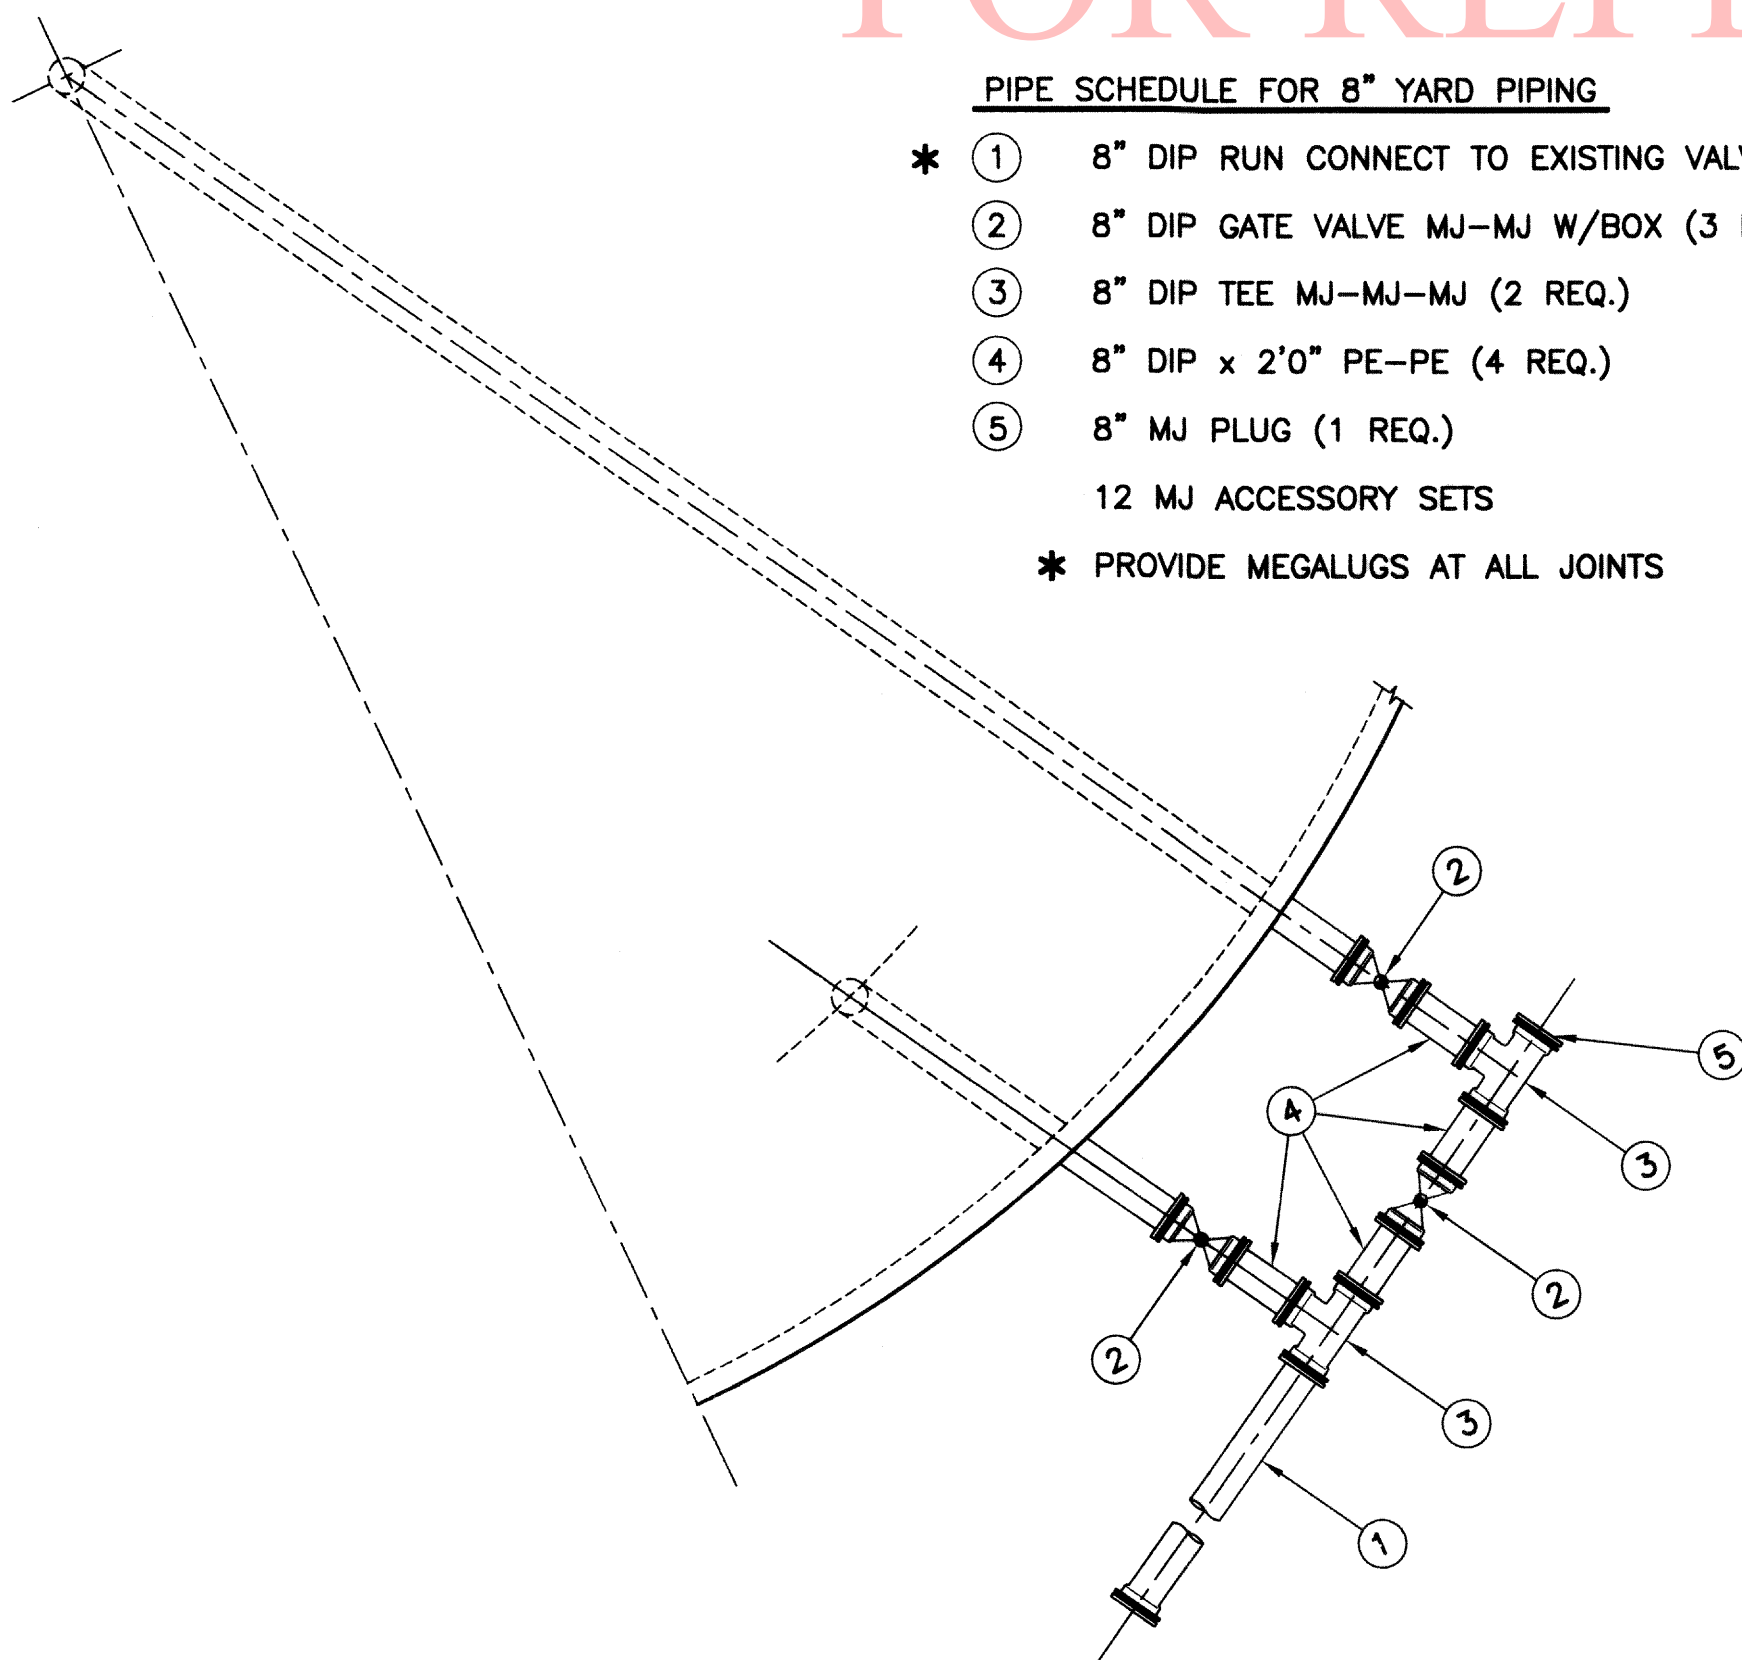

④ 8" YARD PIPING DETAIL
 1/4" = 1'0"
 2' 0 2' 4'

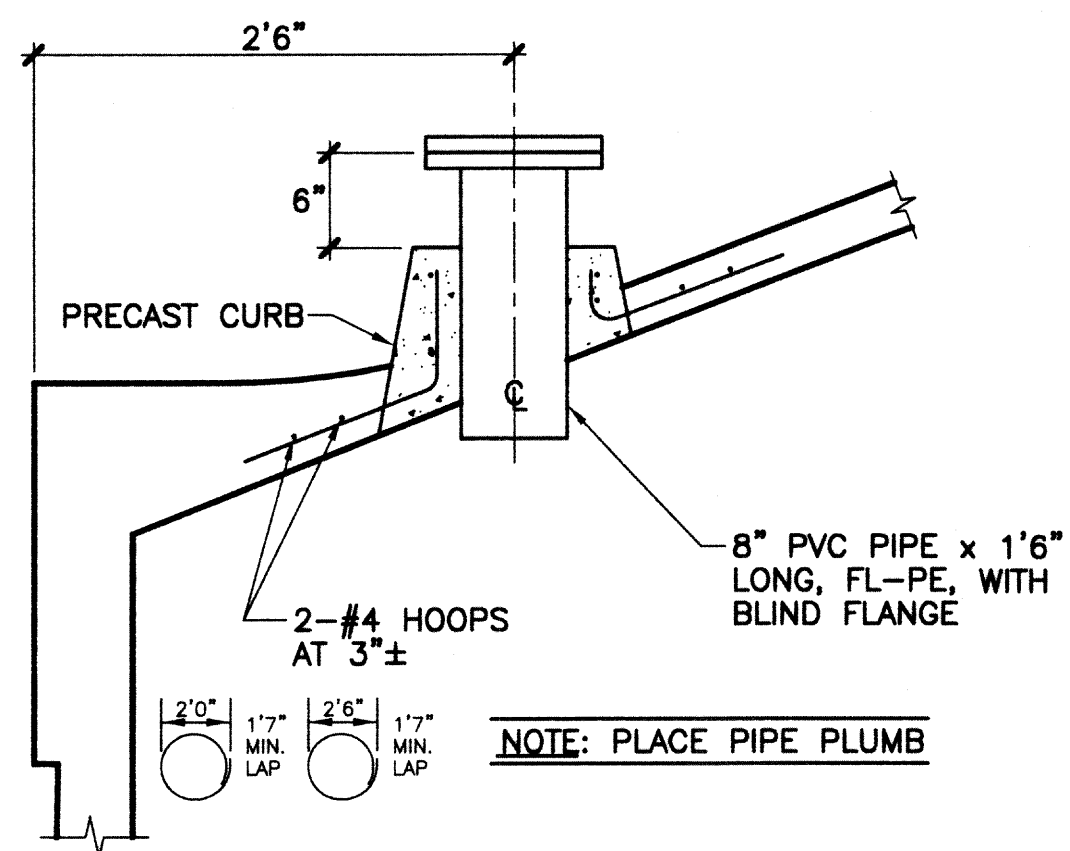

⑤ 8" DOME PROBE CURB
 NTS

8" YARD PIPING AS BUILT
 NTS

TANK BUILDER:
 THE CROM CORPORATION
 GAINESVILLE, FLORIDA

OWNER:
 CITY OF FLOWER BRANCH
 FLOWER BRANCH,
 GEORGIA

CONSULTING ENGINEER:
 RINDT-McDUFF
 ASSOCIATES, INC.,
 MARIETTA,
 GEORGIA

TANK DESCRIPTION:
 0.75-MG WATER
 STORAGE TANK

TANK DIMENSIONS:
 60'6" ID x 35'0" SWD

DATE: 7/13/06
 DRAWN: DM
 CHECKED: *Daw*
 APPROVED: *[Signature]*
 DESIGNED:

REV.	DESCRIPTION	DATE CHK. BY
------	-------------	-----------------

AS BUILT: 8" YARD PIPING
 LAYOUT WITH
 DIMENSION WAS
 ADDED TO SHEET
 5 OF 7

3/13/07



WHERE STANDARD SPECIFICATIONS ARE
 IN CONFLICT WITH CROM CORPORATION
 SPECIFICATIONS OR WITH GOOD PRE-
 STRESSING OR SHOTCRETE PRACTICES
 THE STANDARD SPECIFICATIONS SHALL
 BE SUBORDINATED.
 THIS DESIGN AND DRAWING ORIGINATED
 BY AND THE EXCLUSIVE PROPERTY OF
 THE CROM CORPORATION.

BAR IS ONE INCH ON ORIGINAL
 DRAWINGS 0 1"


SCALE:
 AS NOTED

FILE NO.
 06038

SHEET 5 OF 7

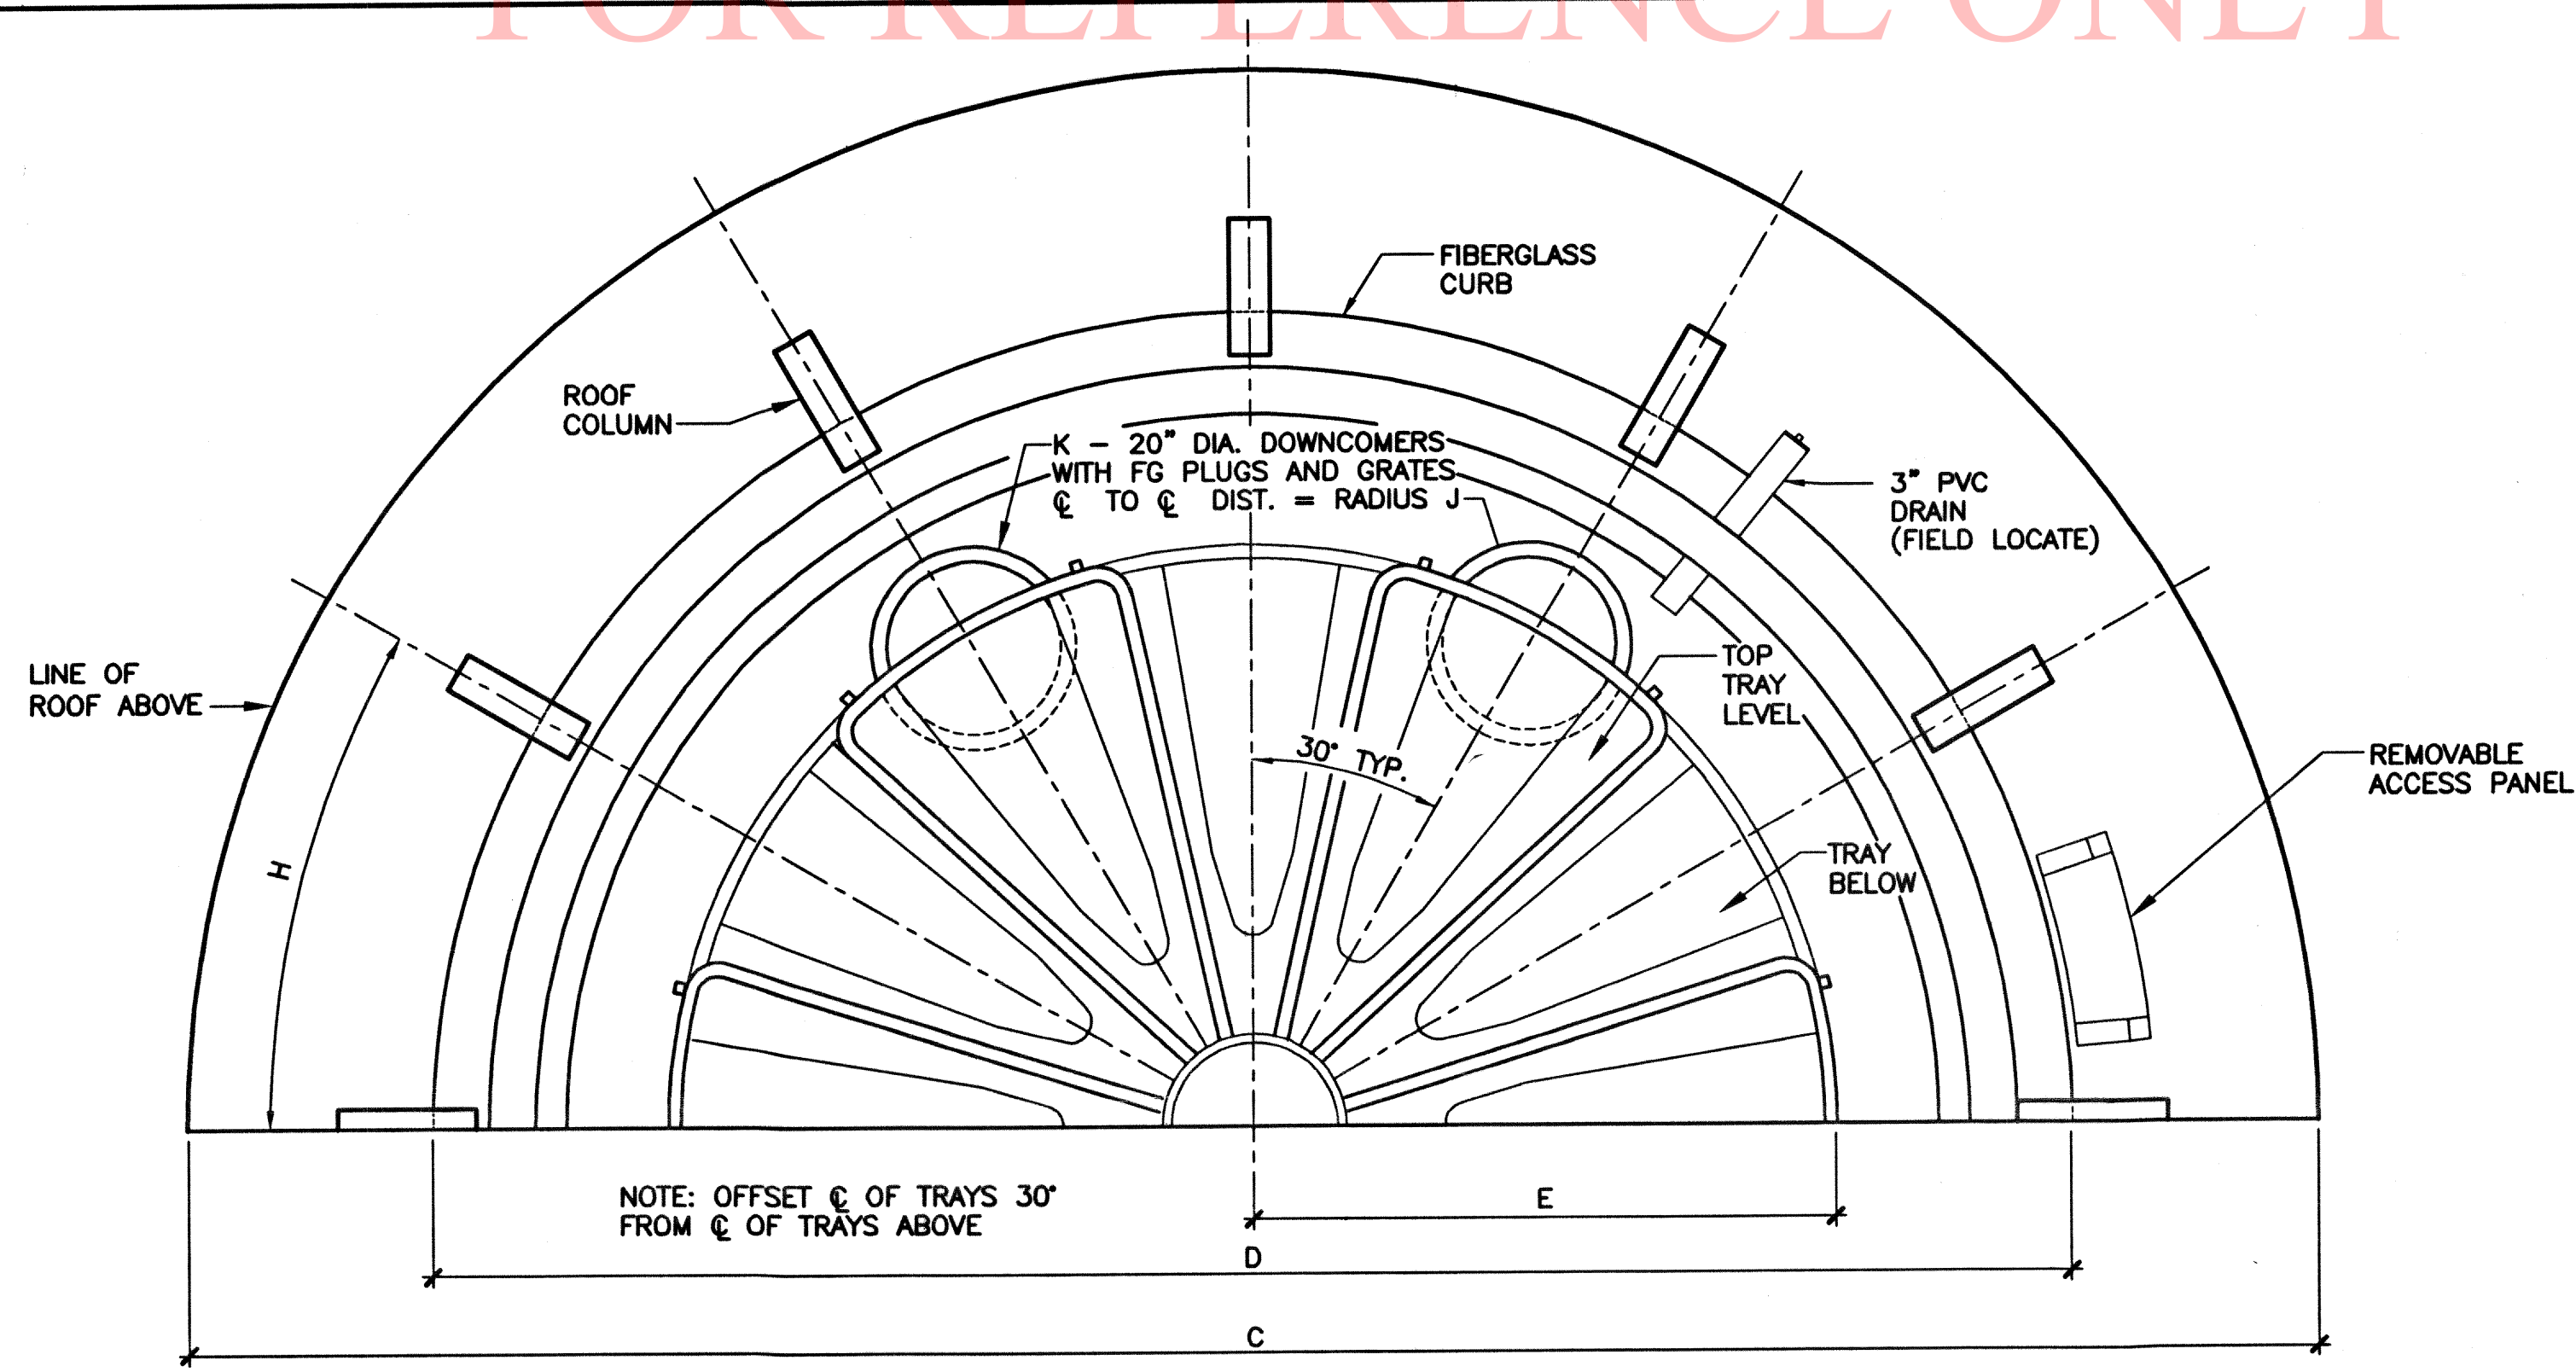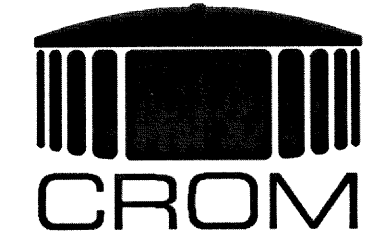

AERATOR ONE-HALF PLAN

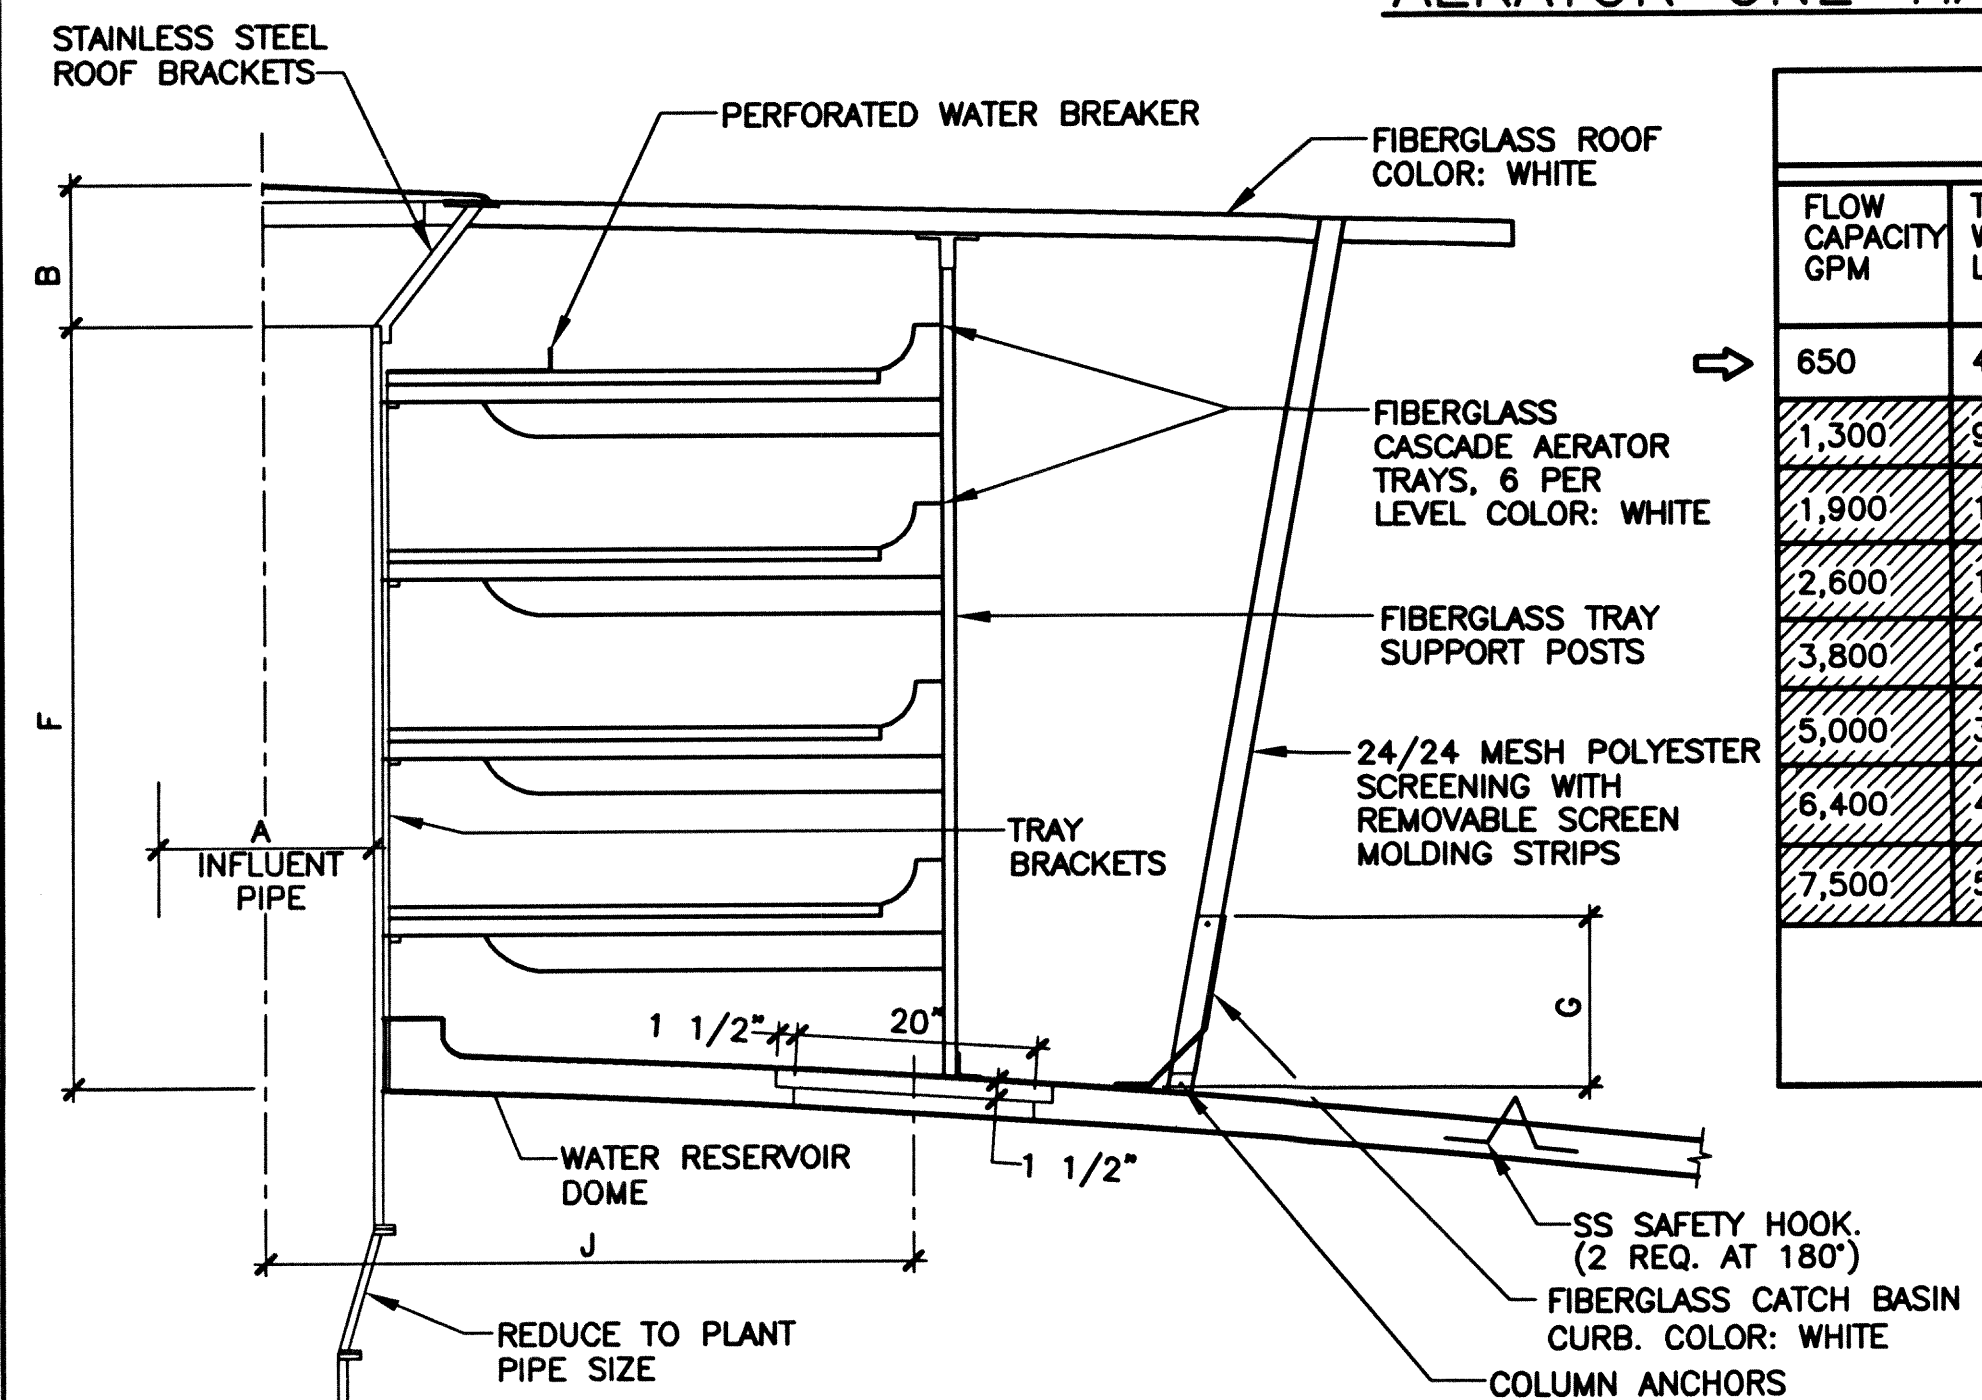

FLOW CAPACITY AND DIMENSION TABLE												
FLOW CAPACITY GPM	TOTAL WEIR LENGTH	A PIPE SIZE	B CLEAR	C ROOF DIA.	D CURB DIA.	E TRAY RADIUS	F PIPE HEIGHT	G CURB HEIGHT	H ROOF COLUMN SPACING	I TOTAL TRAYS (LEVELS)	J DOWN-COMERS RADIUS	K NUMBER DOWN-COMERS
650	47'0"	14"	1'0"	17'4"	13'4"	4'9"	5'4"	1'4"	30"	6 (1)	4'7"	2
1,300	94'0"	14"	1'0"	17'4"	13'4"	4'9"	5'4"	1'4"	30"	12 (2)	4'7"	2
1,900	141'0"	14"	1'0"	17'4"	13'4"	4'9"	5'4"	1'4"	30"	18 (3)	4'7"	2
2,600	188'0"	18"	1'0"	17'4"	13'4"	4'9"	5'4"	1'4"	30"	24 (4)	4'7"	2
3,800	276'0"	20"	1'6"	28'0"	23'4"	9'0"	5'4"	1'6"	15'	18 (3)	9'7"	3
5,000	368'0"	24"	1'6"	28'0"	23'4"	9'0"	5'4"	1'6"	15'	24 (4)	9'7"	3
6,400	460'0"	24"	1'6"	28'0"	23'4"	9'0"	7'2"	1'6"	15'	30 (5)	9'7"	3
7,500	552'0"	30"	1'6"	28'0"	23'4"	9'0"	8'4"	1'6"	15'	36 (6)	9'7"	4

CASCADE TRAY NATURAL DRAFT AERATORS

ALL FIBERGLASS CONSTRUCTION WITH STAINLESS STEEL HARDWARE

6 650 GPM AERATOR NTS

ONE-HALF SECTION THRU AERATOR CENTER LINE

TANK BUILDER:
THE CROM CORPORATION
GAINESVILLE, FLORIDA

OWNER:
CITY OF FLOWER BRANCH
FLOWER BRANCH,
GEORGIA

CONSULTING ENGINEER:
RINDT-McDUFF
ASSOCIATES, INC.,
MARIETTA,
GEORGIA

TANK DESCRIPTION:
0.75-MG WATER
STORAGE TANK

TANK DIMENSIONS:
60'6" ID x 35'0" SWD

DATE: 7/13/06
DRAWN: DM
CHECKED: DLW
APPROVED: TBM
DESIGNED: KZH

REV.	DESCRIPTION	DATE CK. BY

WHERE STANDARD SPECIFICATIONS ARE IN CONFLICT WITH CROM CORPORATION SPECIFICATIONS OR WITH GOOD PRE-STRESSING OR SHOTCRETE PRACTICES THE STANDARD SPECIFICATIONS SHALL BE SUBORDINATED. THIS DESIGN AND DRAWING ORIGINATED BY AND THE EXCLUSIVE PROPERTY OF THE CROM CORPORATION.

BAR IS ONE INCH ON ORIGINAL DRAWINGS 0 1"

SCALE:
NTS

FILE NO.
06038

SHEET 6 OF 7

FOR REFERENCE ONLY



Avon, Indiana - Sebree, Kentucky
 250,000 GALLON WATER STORAGE TANK
 FOR
 CITY OF FLOWERY BRANCH
 FLOWERY BRANCH, GA

DRAWING INDEX

SHEET	TITLE	REVISION
T-00	TITLE SHEET	A
T-01	GENERAL ELEVATION	0
T-02	BASE CONE DETAILS	0
T-03	DOORWAY DETAILS	0
T-04	SUPPORT DETAILS	0
T-05	UPPER TRANSITION DETAILS	0
T-06	PLATFORM & RING DETAILS	0
▲ T-07	UPPER CONE DETAILS	0
▲ T-08	GORE DETAILS	0
▲ T-09	PIPE DETAILS	A
▲ T-10	LADDER DETAILS	0
F-01	FOUNDATION DETAILS	A
F-02	FOUNDATION ELEVATION DETAILS	0
F-03	FOUNDATION DESIGN SUMMARY	0
F-04	SPLASH BLOCK DETAILS	0
D-01	PAINTING INSTRUCTIONS	0
D-02	SIGN LAYOUT	0
D-03	TANK VENT	0
D-04	30"Ø ROOF HATCH	0
D-05	30"Ø HATCH - PLATFORM #1	0
D-06	30"Ø HATCH - PLATFORM #2	0
D-07	24"Ø STEM HATCH	0
D-08	OVERFLOW SCREEN	0
D-09	PLATFORM DRAIN ASSEMBLY	0
D-10	BOWL DRAIN	0
D-11	GROUT PROCEDURE	0
D-12	NAME PLATE	0
D-13	ELECTRICAL BRACKETS	0
D-14	ROOF FLANGE	0
D-15	BASE CONE HANDRAIL	0
D-16	ROOF HANDRAIL	0
D-17	PAINTER'S RINGS	0
D-18	PROTECTIVE DISCHARGE CAP	0

TANK CRITERIA

WELDED STEEL TANK
 TYPE: SPHEROIDAL
 CAPACITY = 200,000 GALLON
 HIGH WATER LEVEL = 152'-0"
 TANK DIA = 44'-0"
 HEAD RANGE = 30'-0"


BASE CONE DIA = 26'-0"
 STEM DIA = 8'-0"
 ACCESS TUBE DIA = 42"
 INLET DIA = 12"
 OVERFLOW DIA = 8"
 DOOR SIZE = 36" X 80"

TANK NOTES

1. GROUT UNDER BASE PLATE MINIMUM 1".
2. WELDING TO BE IN ACCORDANCE WITH AWWA D100-21 AND NACE D.
3. SEE SHEET T-08 FOR LOCATING PAINTER'S LUGS.
4. SEAL WELD CONTAINER.

DESIGN CRITERIA

SPECIFICATIONS: AWWA D100-21
 ACI 318-11
 WIND: 117 MPH - AWWA
 SNOW: 25 PSF - AWWA
 SEISMIC: SITE CLASS C
 Ss = 0.207
 S1 = 0.089

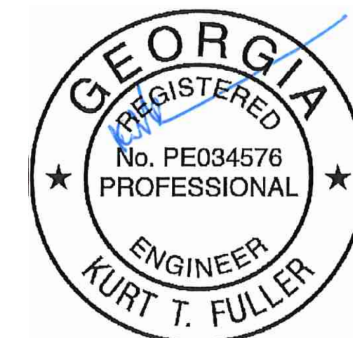


12.06.22

OWNER'S ENGINEER
 INFRATEC CONSULTANTS, INC.



250,000 GALLON ELEVATED SPHEROIDAL TANK	AB/KI	11/28/22	Revised Sheets & Items Noted
TITLE SHEET	Rev. By	Rev. Date	Revision Description
CITY OF FLOWERY BRANCH	AB	10/22	
FLOWERY BRANCH, GA	Checked By: KI	Date: 10/22	
Engineer: KI	Drawn By: AB	Checked By: KI	Date: 10/22
Avon, Indiana - Sebree, Kentucky JOB. No. 3907 SHEET T-00			

Copyright © 2017 by Phoenix Fabricators & Erectors, LLC. All rights reserved.

FOR REFERENCE ONLY

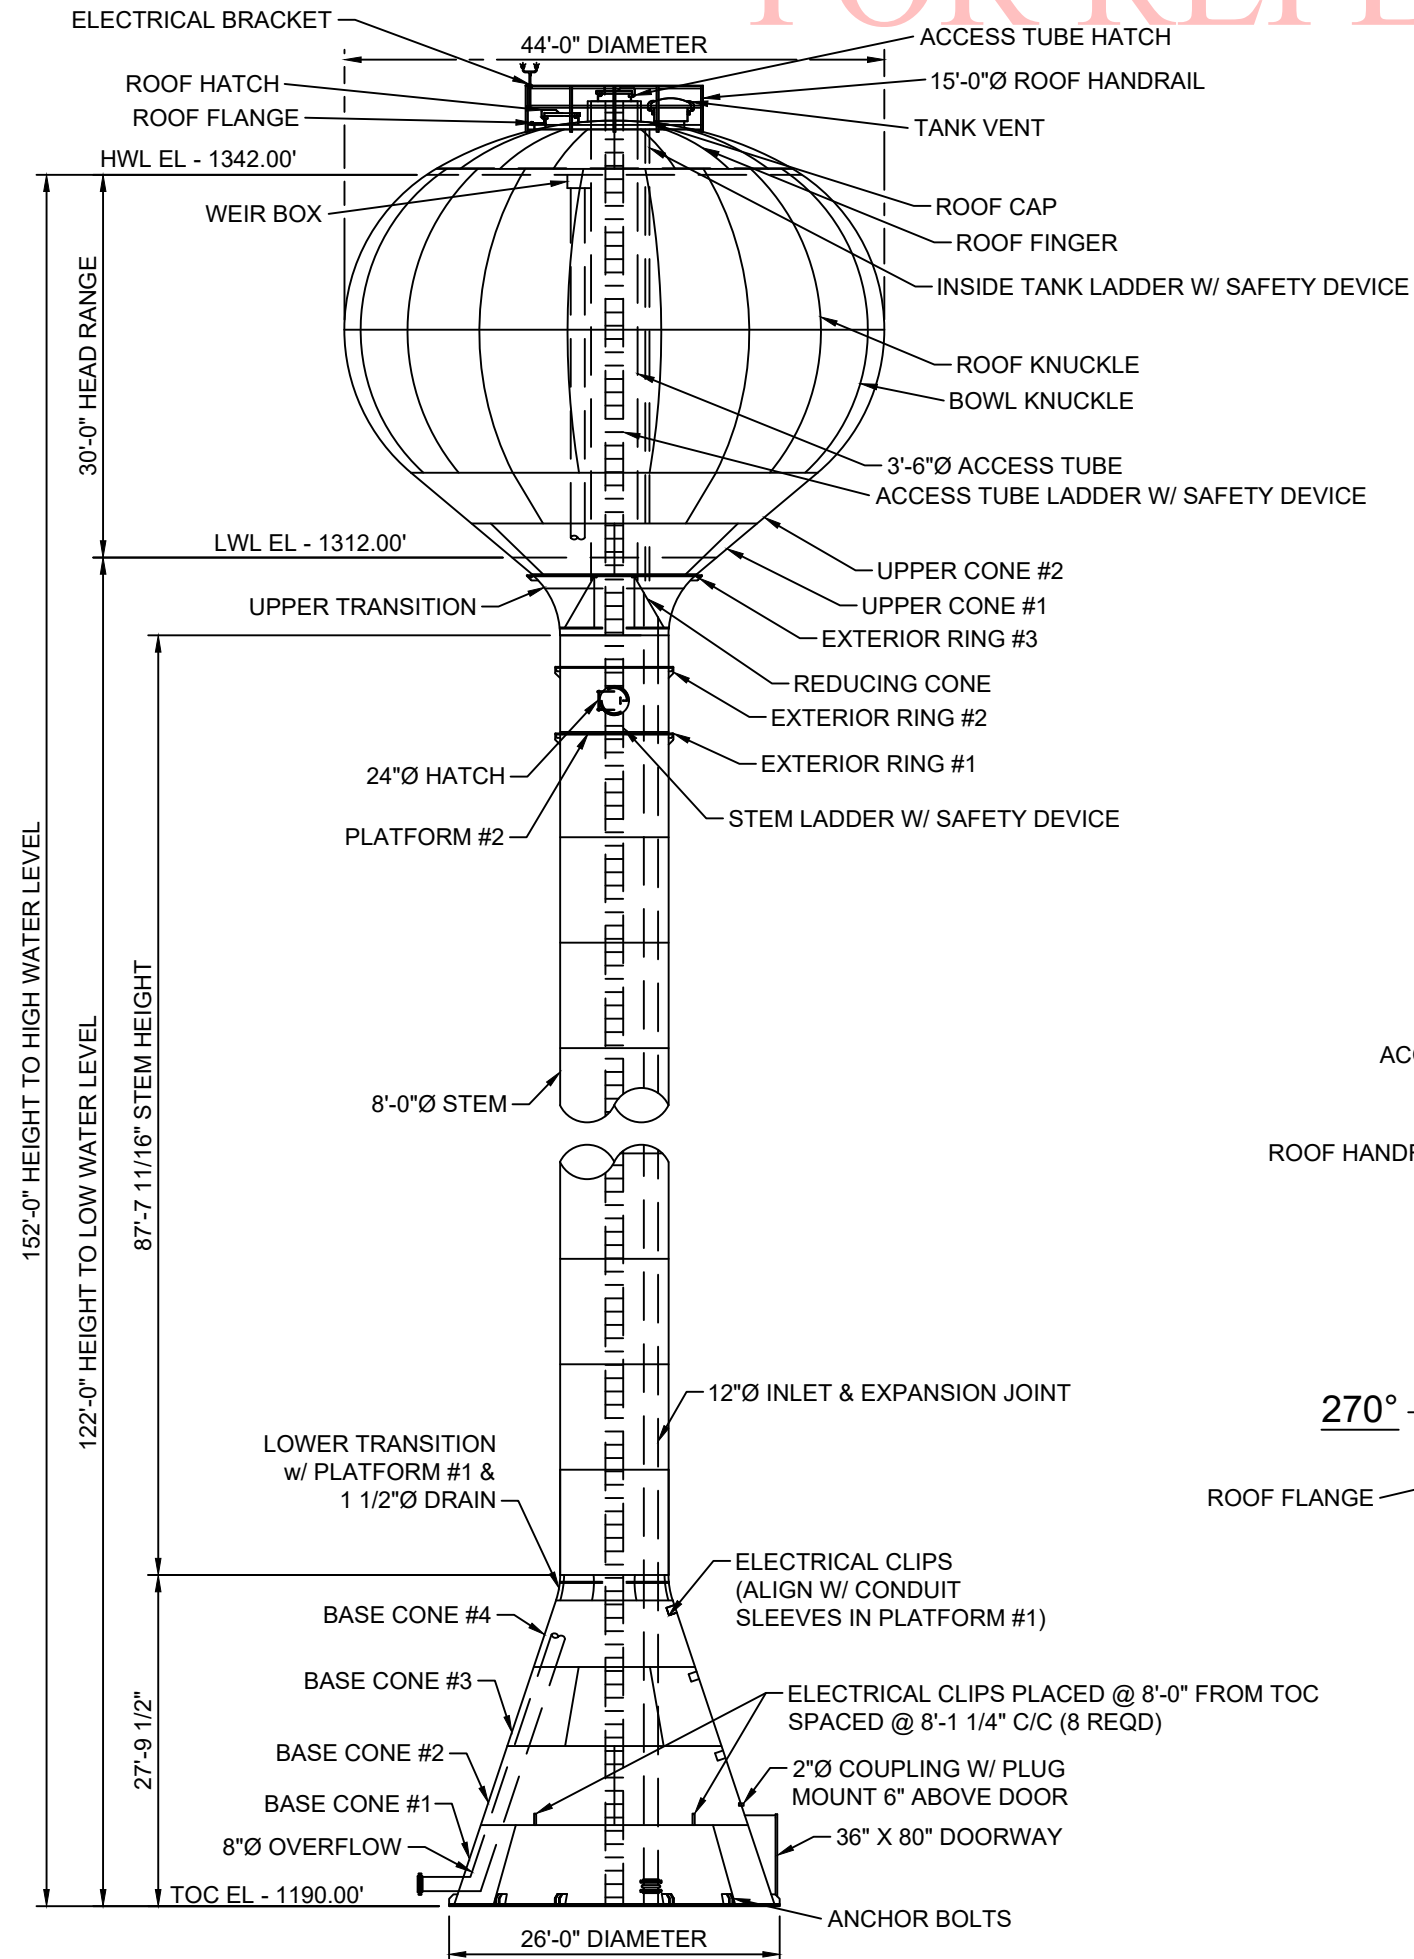

NOTE: ROOF FINGER VERTS TO BE LAPPED 1", & HORIZONTAL LAPS TO BE 2".

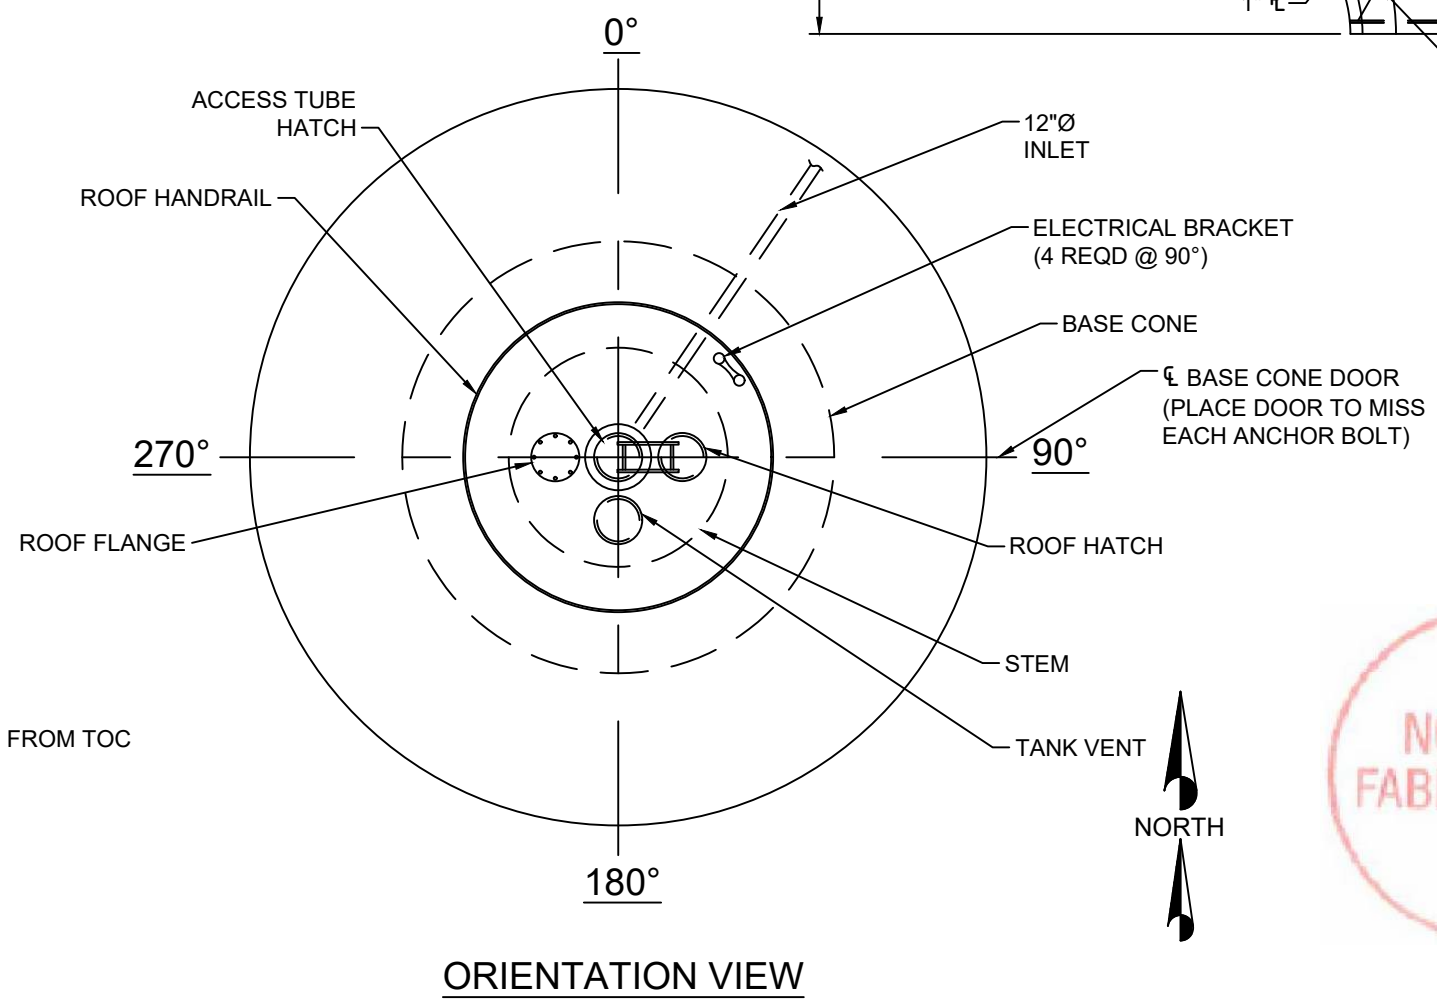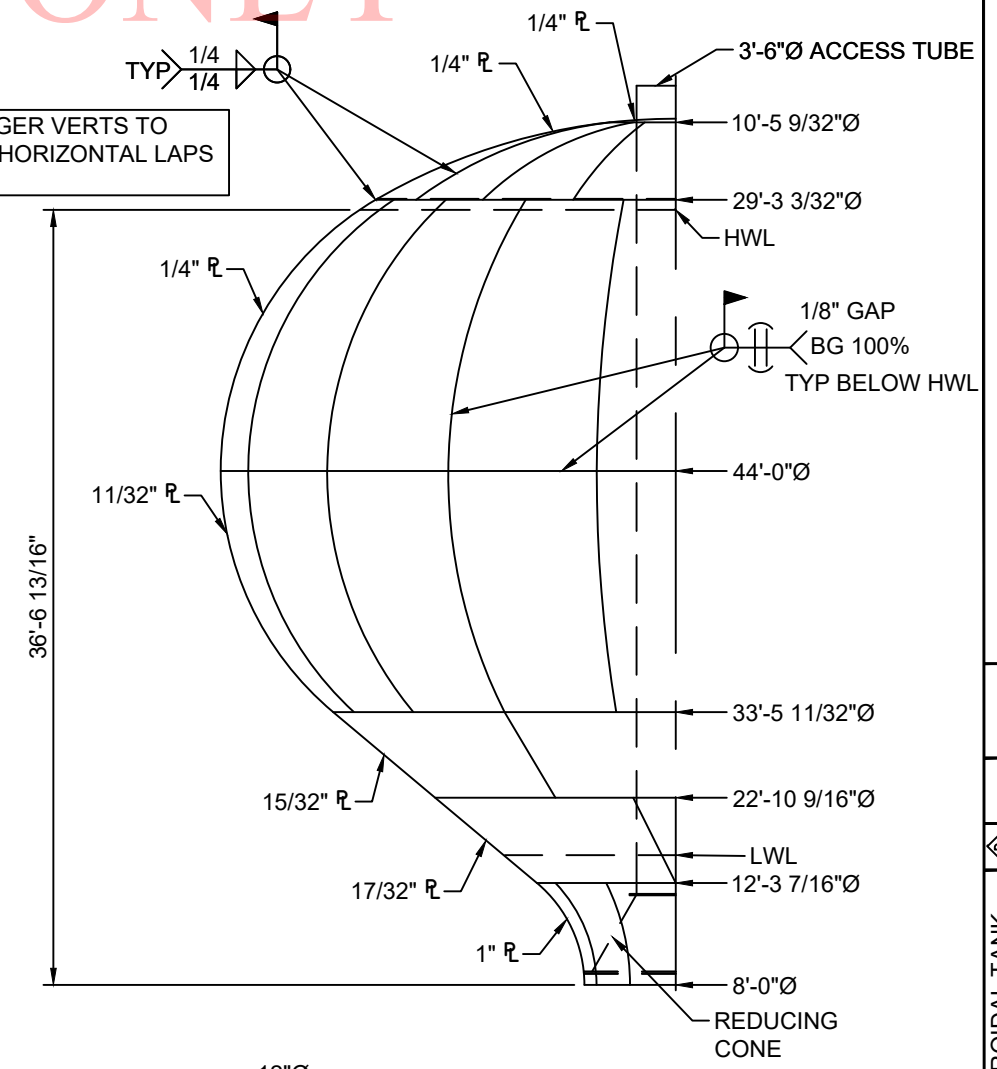

NOT FOR FABRICATION











250,000 GALLON ELEVATED SPHEROIDAL TANK	
GENERAL ELEVATION	
CITY OF FLOWERY BRANCH FLOWERY BRANCH, GA	
Engineer: KI	Drawn By: AB
Checked By: KI	Date: 10/22
Rev. By:	Rev. Date
Rev. Description	Revision Description
JOB. No. 3907	
SHEET T-01	
Avon, Indiana - Sebree, Kentucky Copyright © 2017 by Phoenix Fabricators & Erectors, LLC. All rights reserved.	

CHORDS AFTER ROLLING		
	CH (1) PC	CH (2) PCS
LARGE END	18'-3 7/8"	25'-11 3/32"
SMALL END	15'-2 1/16"	21'-5 5/8"

CHORDS AFTER ROLLING		
	CH (1) PC	CH (2) PCS
LARGE END	15'-2 1/32"	21'-5 17/32"
SMALL END	12'-0 1/4"	17'-0 1/8"

CHORDS AFTER ROLLING		
	CH (1) PC	CH (2) PCS
LARGE END	12'-0 5/32"	17'-0"
SMALL END	8'-10 3/8"	12'-6 19/32"

CHORDS AFTER ROLLING		
	CH (1) PC	CH (2) PC
LARGE END	8'-10 7/32"	12'-6 11/32"
SMALL END	6'-1 3/8"	8'-7 7/8"

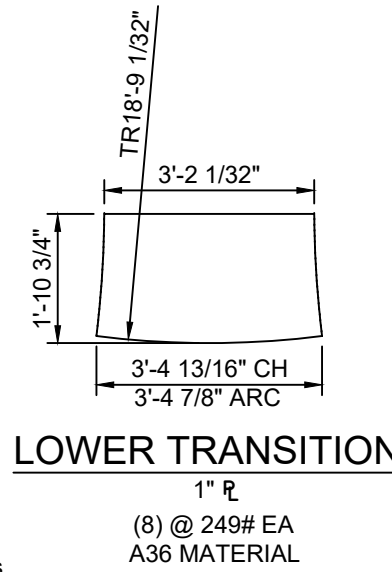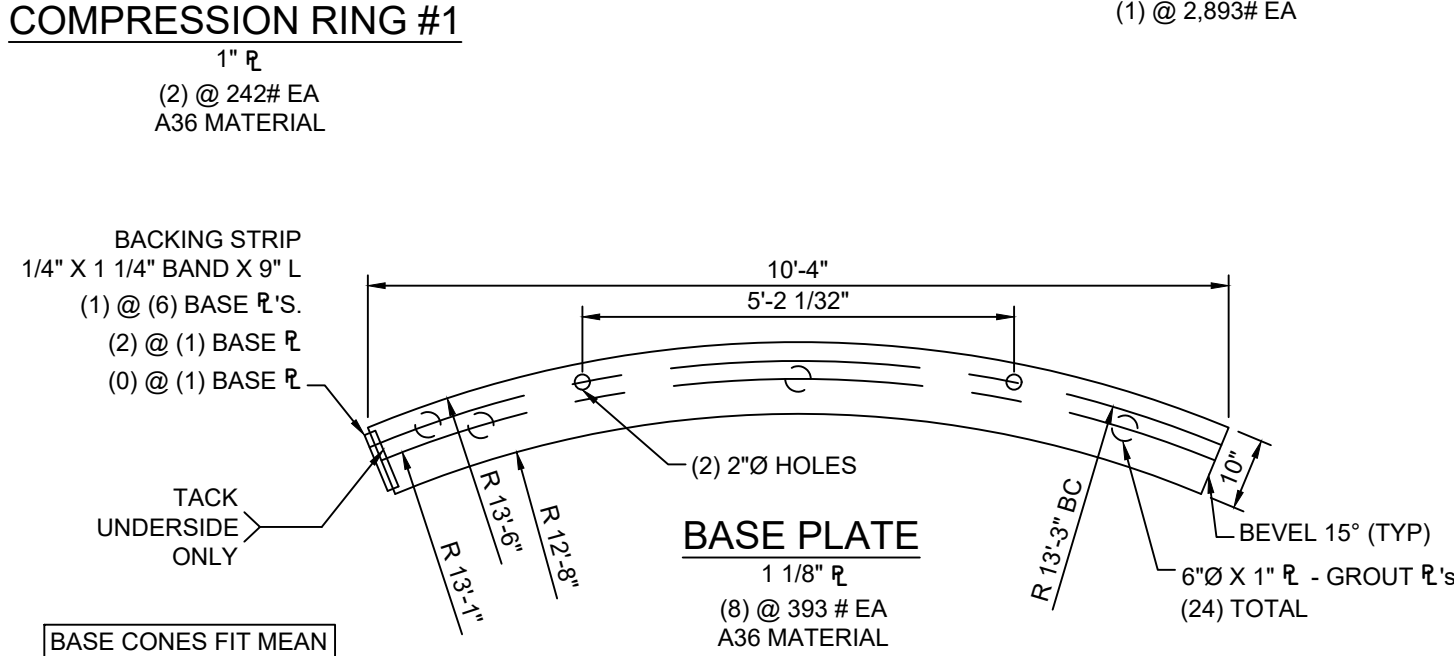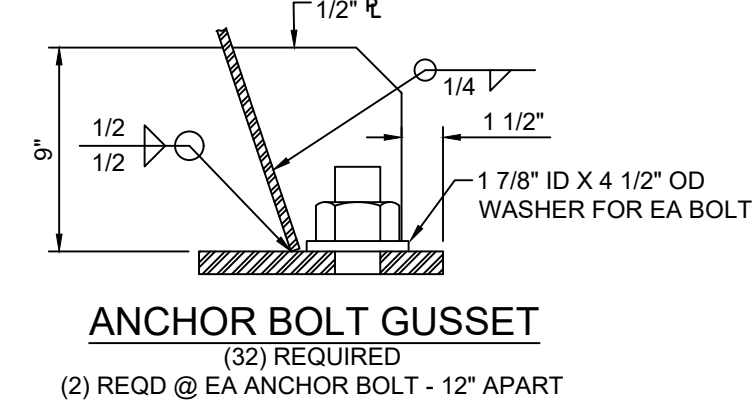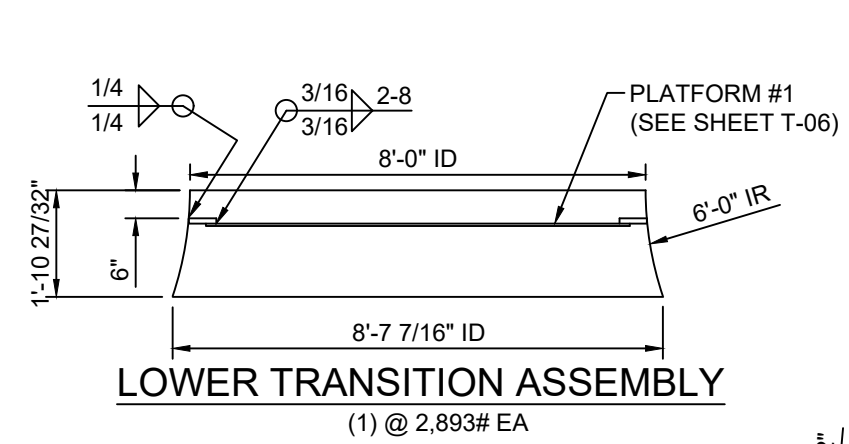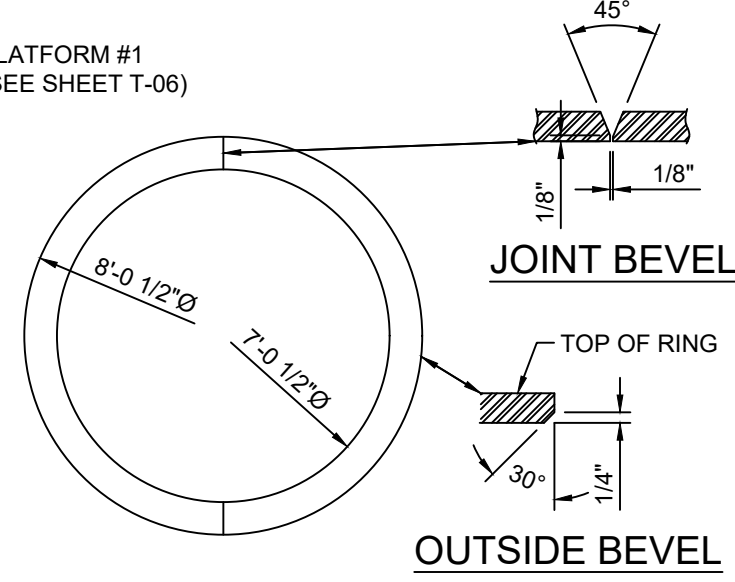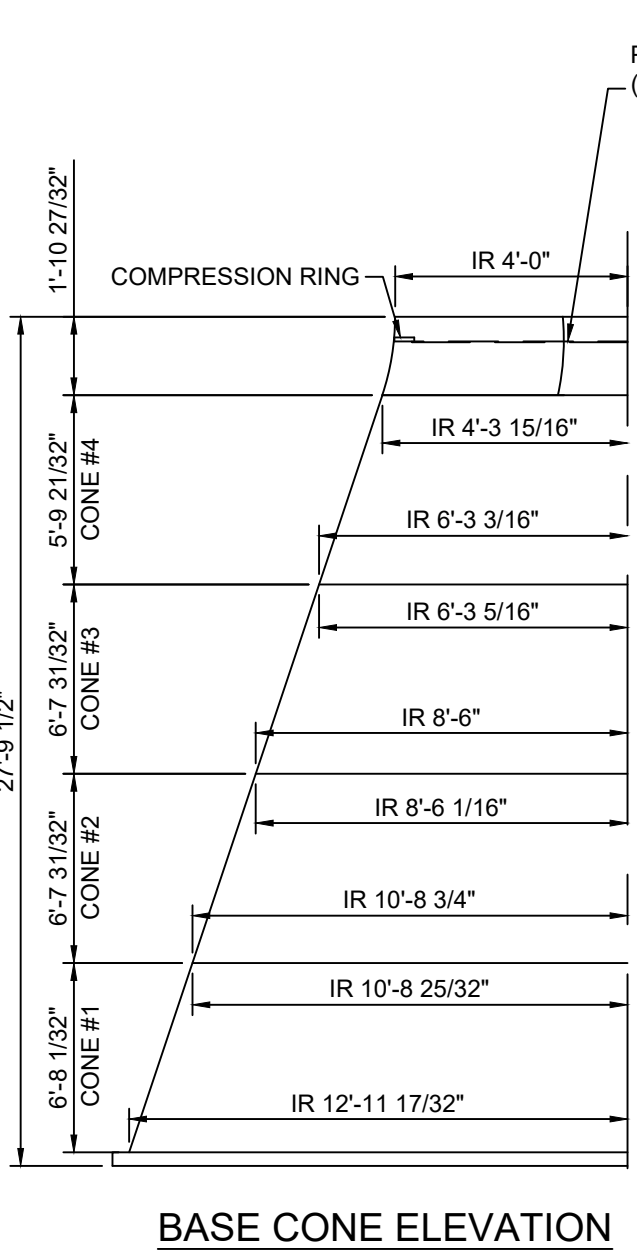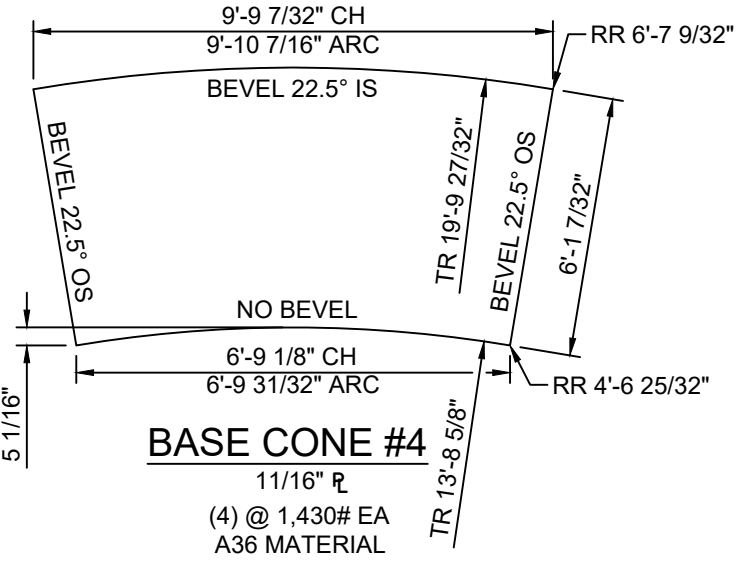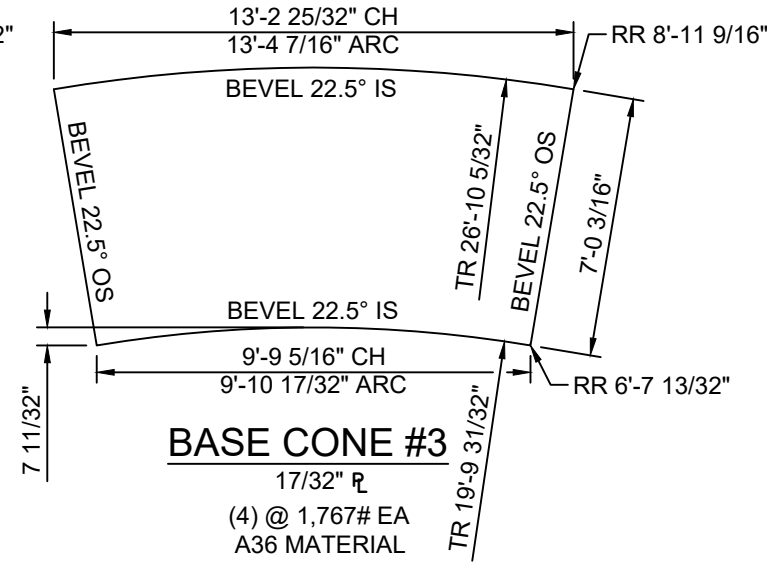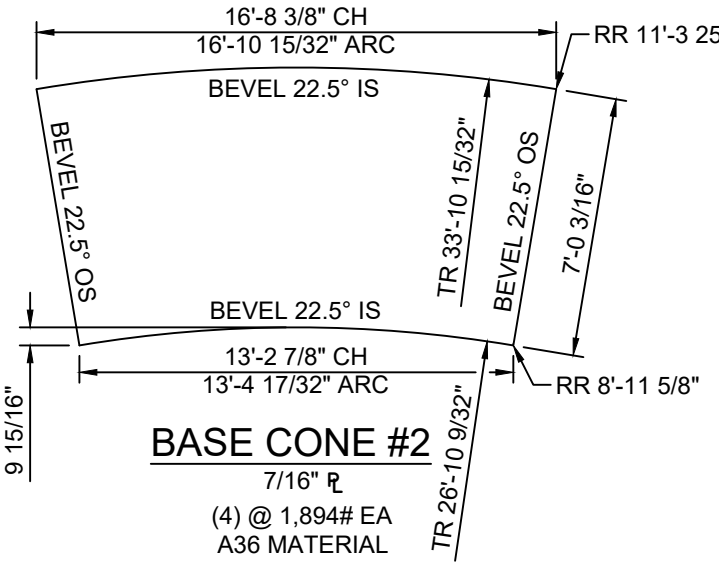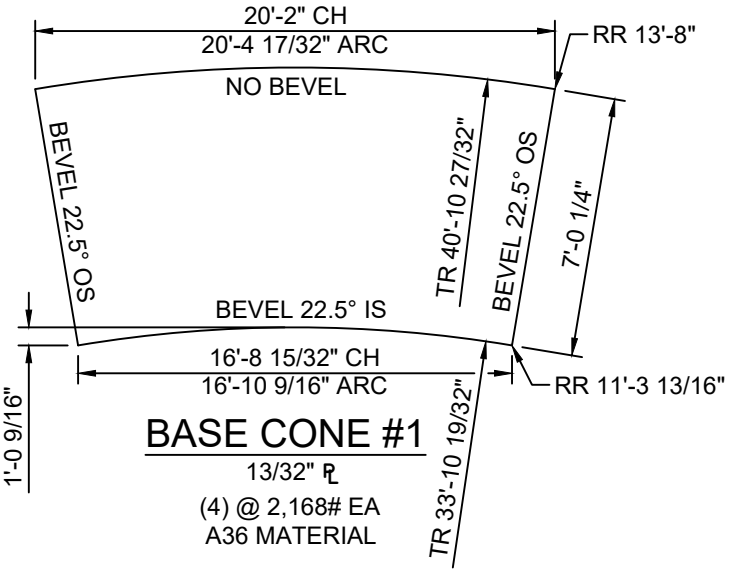


NOT FOR FABRICATION

250,000 GALLON ELEVATED SPHEROIDAL TANK
BASE CONE DETAILS
 CITY OF FLOWERY BRANCH
 FLOWERY BRANCH, GA
 Engineer: KI
 Drawn By: AB
 Checked By: KI
 Date: 10/22
 Revision Description
 Rev. By: Rev. Date
 Copyright © 2017 by Phoenix Fabricators & Erectors, LLC. All rights reserved.


JOB. No.
3907
 SHEET
T-02




FOR REFERENCE ONLY

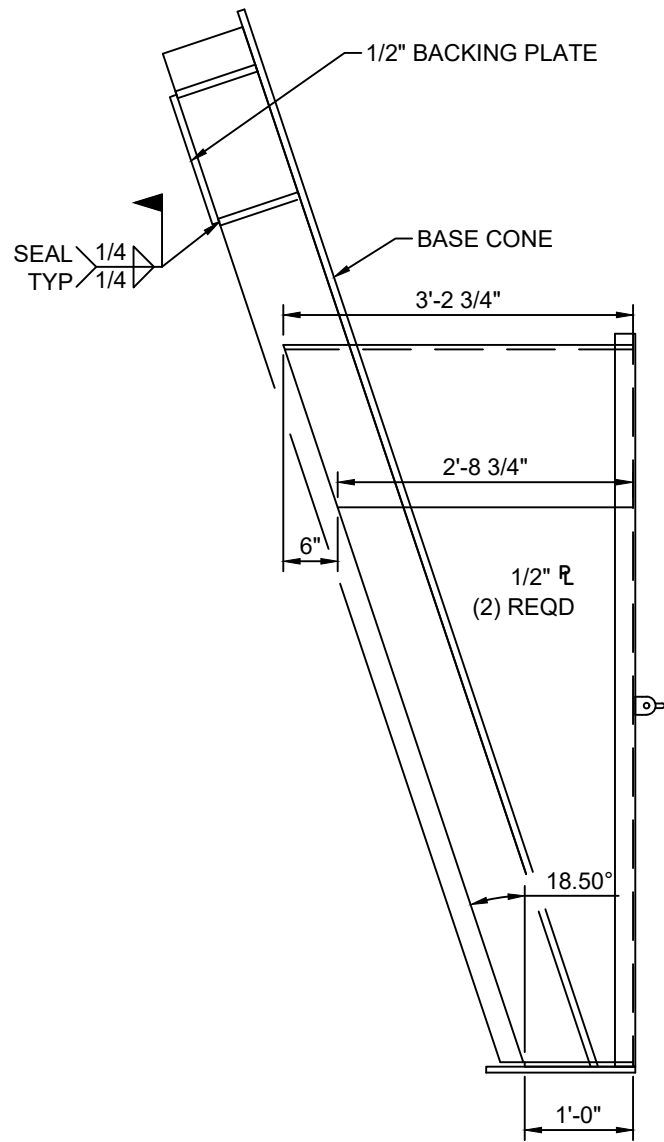


SIDE VIEW

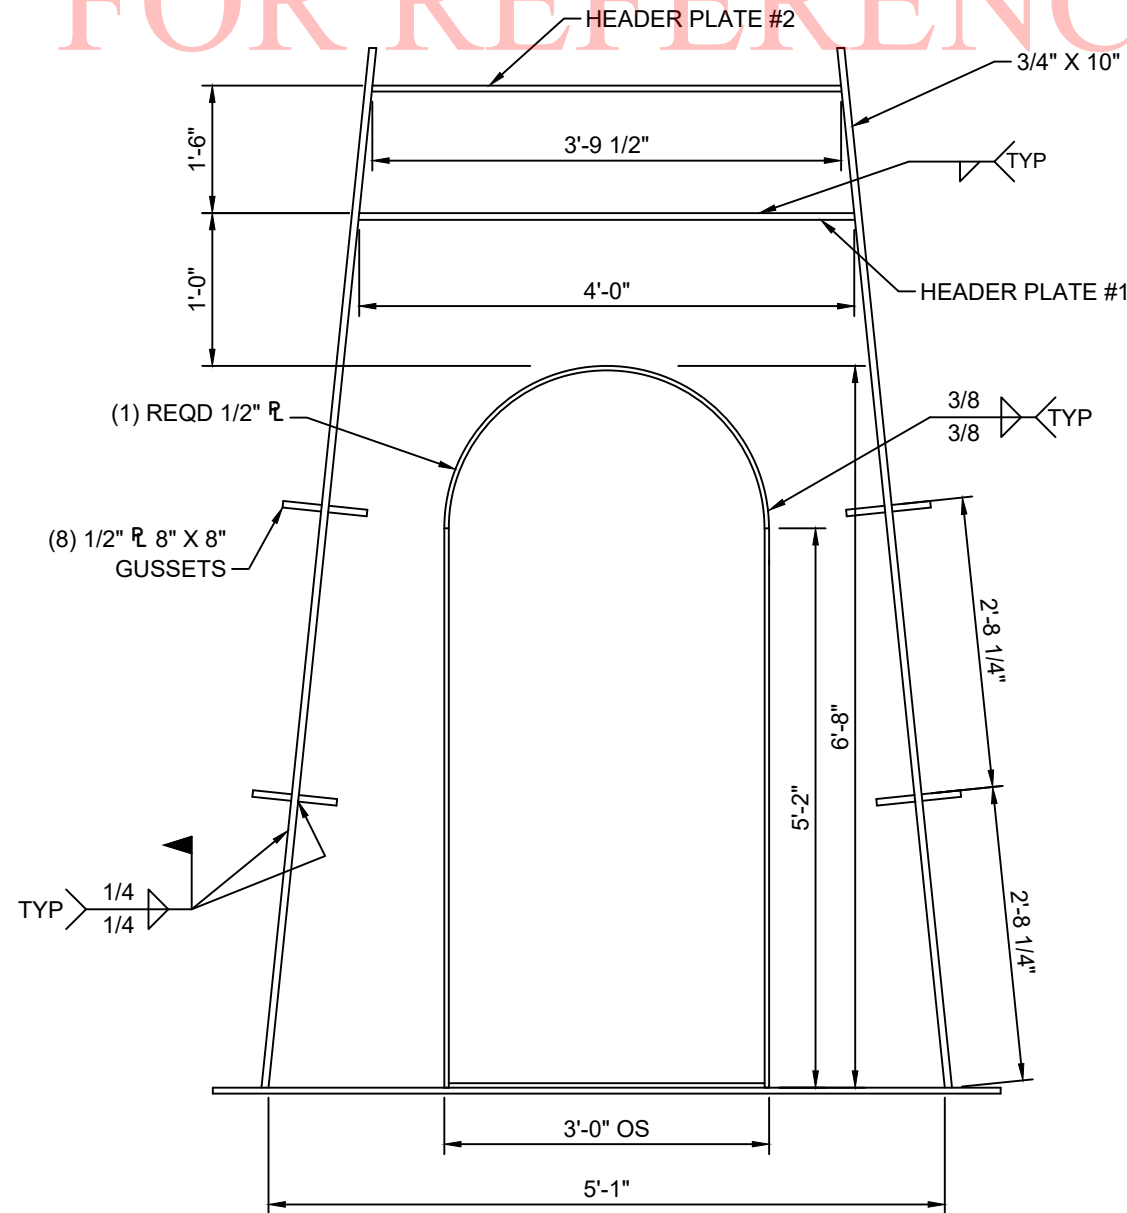

DOOR FRAME DETAIL

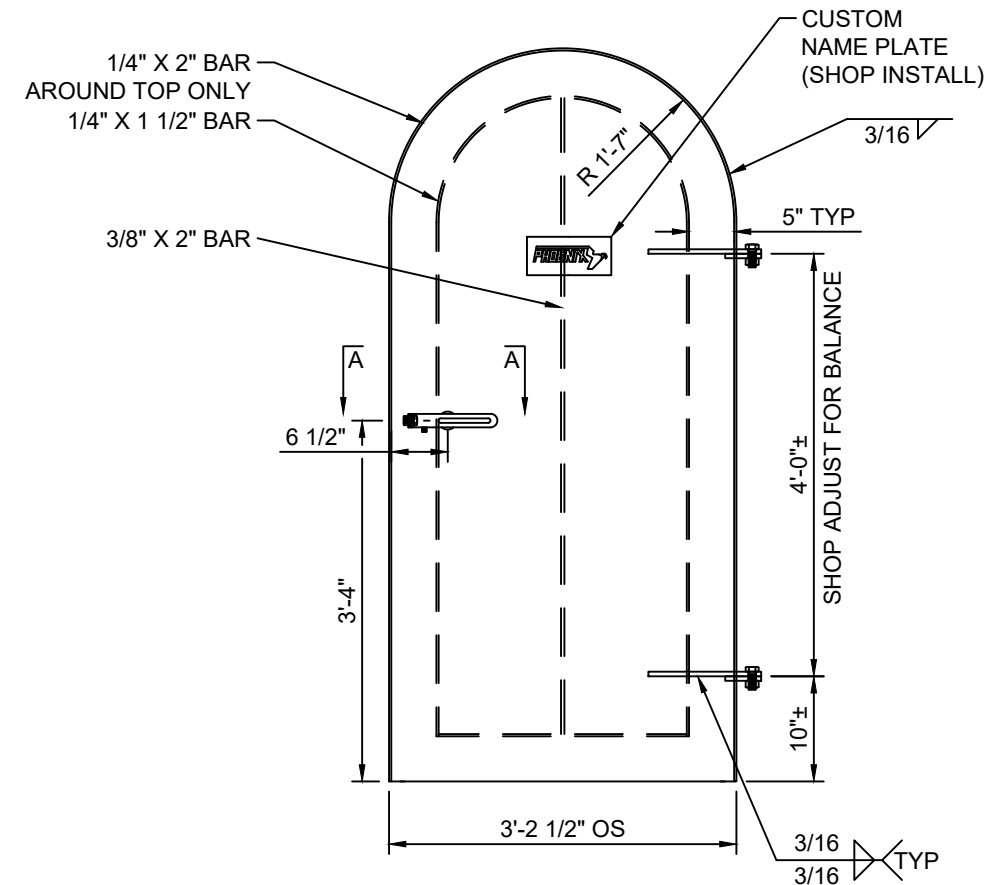


DOOR DETAIL
 DOOR ASSEMBLY = 1,002#

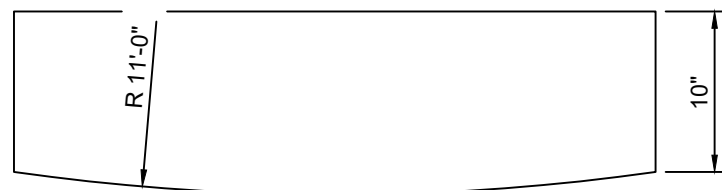


HEADER PLATE #1

3/4" R
 (1) @ 117#
 A36 MATERIAL

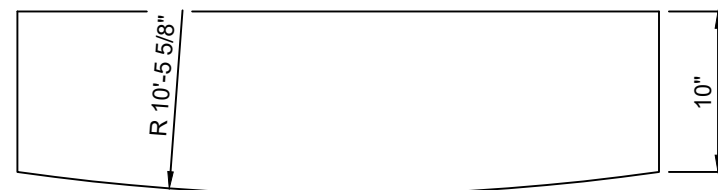

HEADER PLATE #2

3/4" R
 (1) @ 110#
 A36 MATERIAL



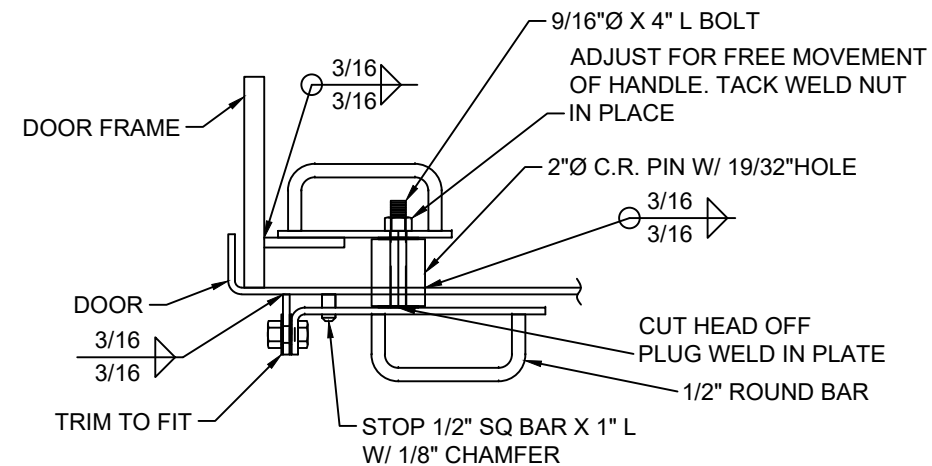


SECTION A-A

NOT FOR FABRICATION


250,000 GALLON ELEVATED SPHEROIDAL TANK	Revision Description
DOORWAY DETAILS	Rev. By Rev. Date
CITY OF FLOWERY BRANCH	Checked By: KI Date: 10/22
FLOWERY BRANCH, GA	Engineer: KI
Drawn By: AB	
Copyright © 2017 by Phoenix Fabricators & Erectors, LLC. All rights reserved.	
Avon, Indiana - Sebree, Kentucky	
JOB. No.	
3907	
SHEET	
T-03	

FOR REFERENCE ONLY

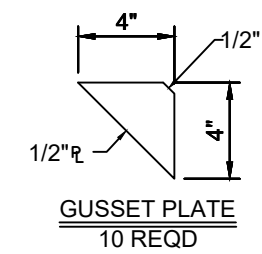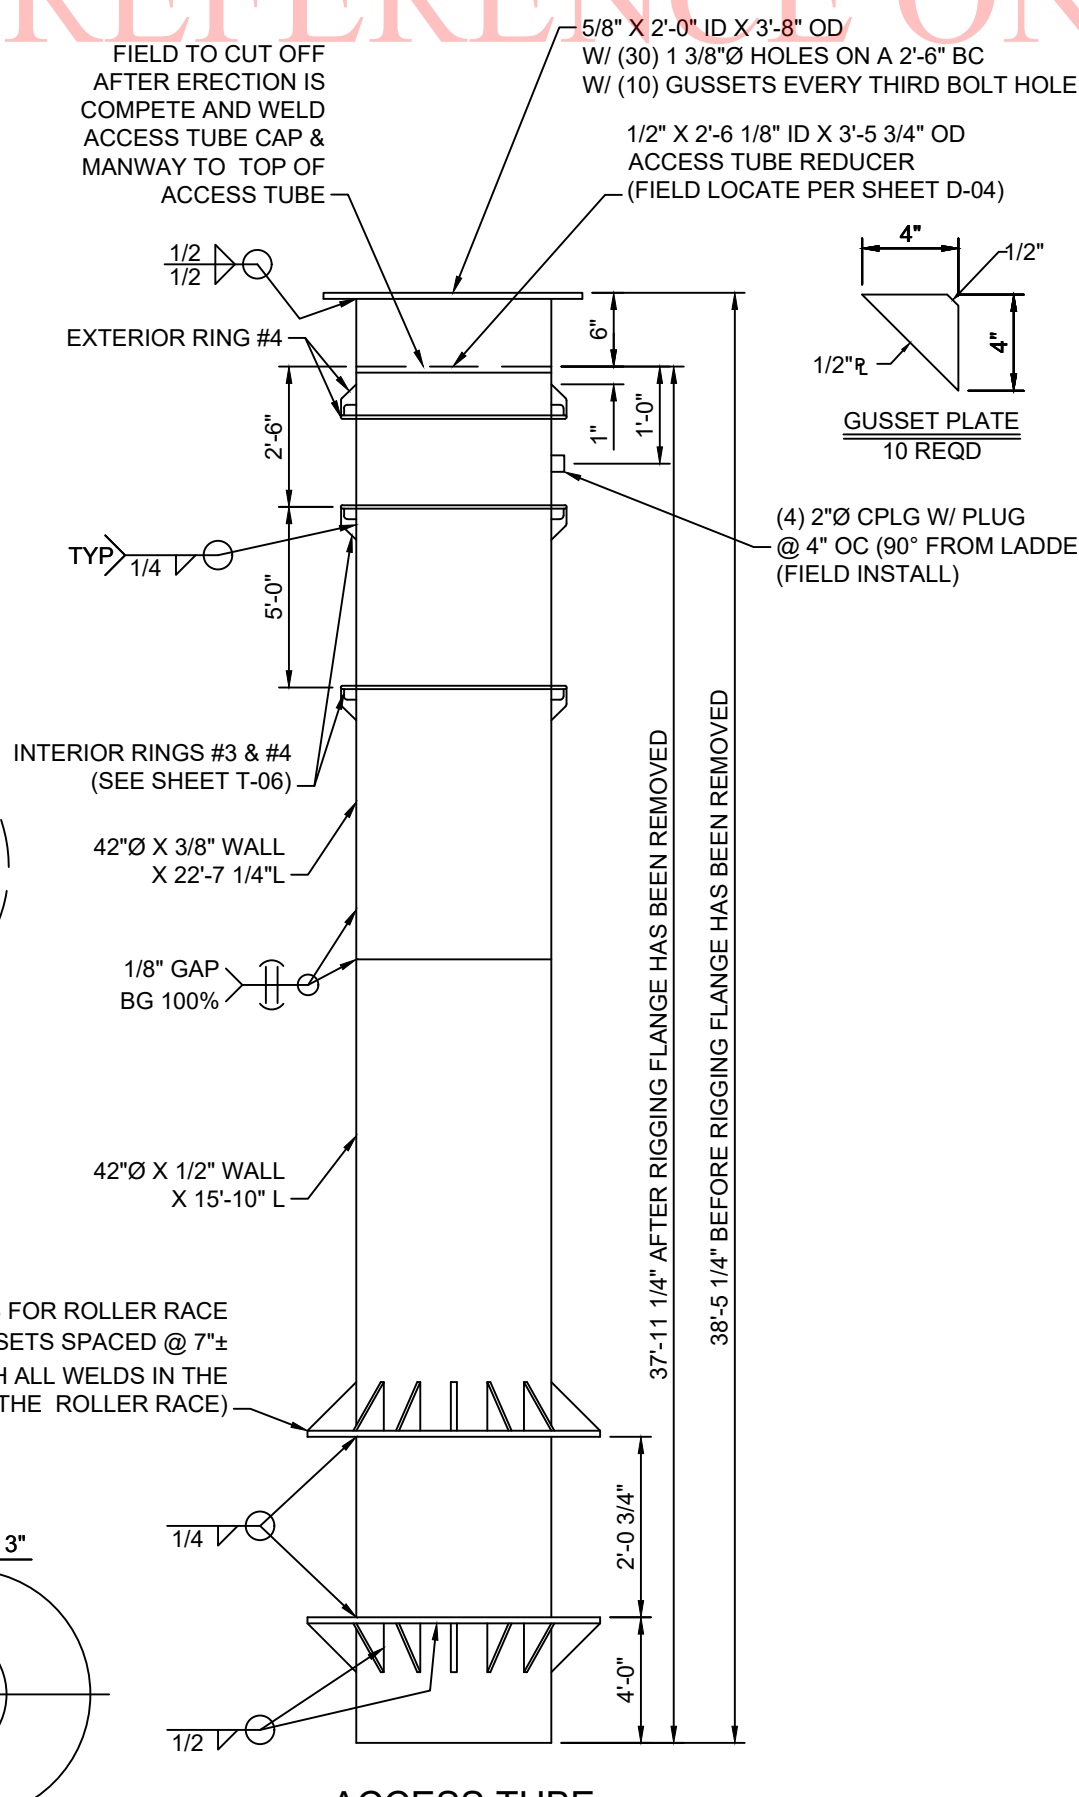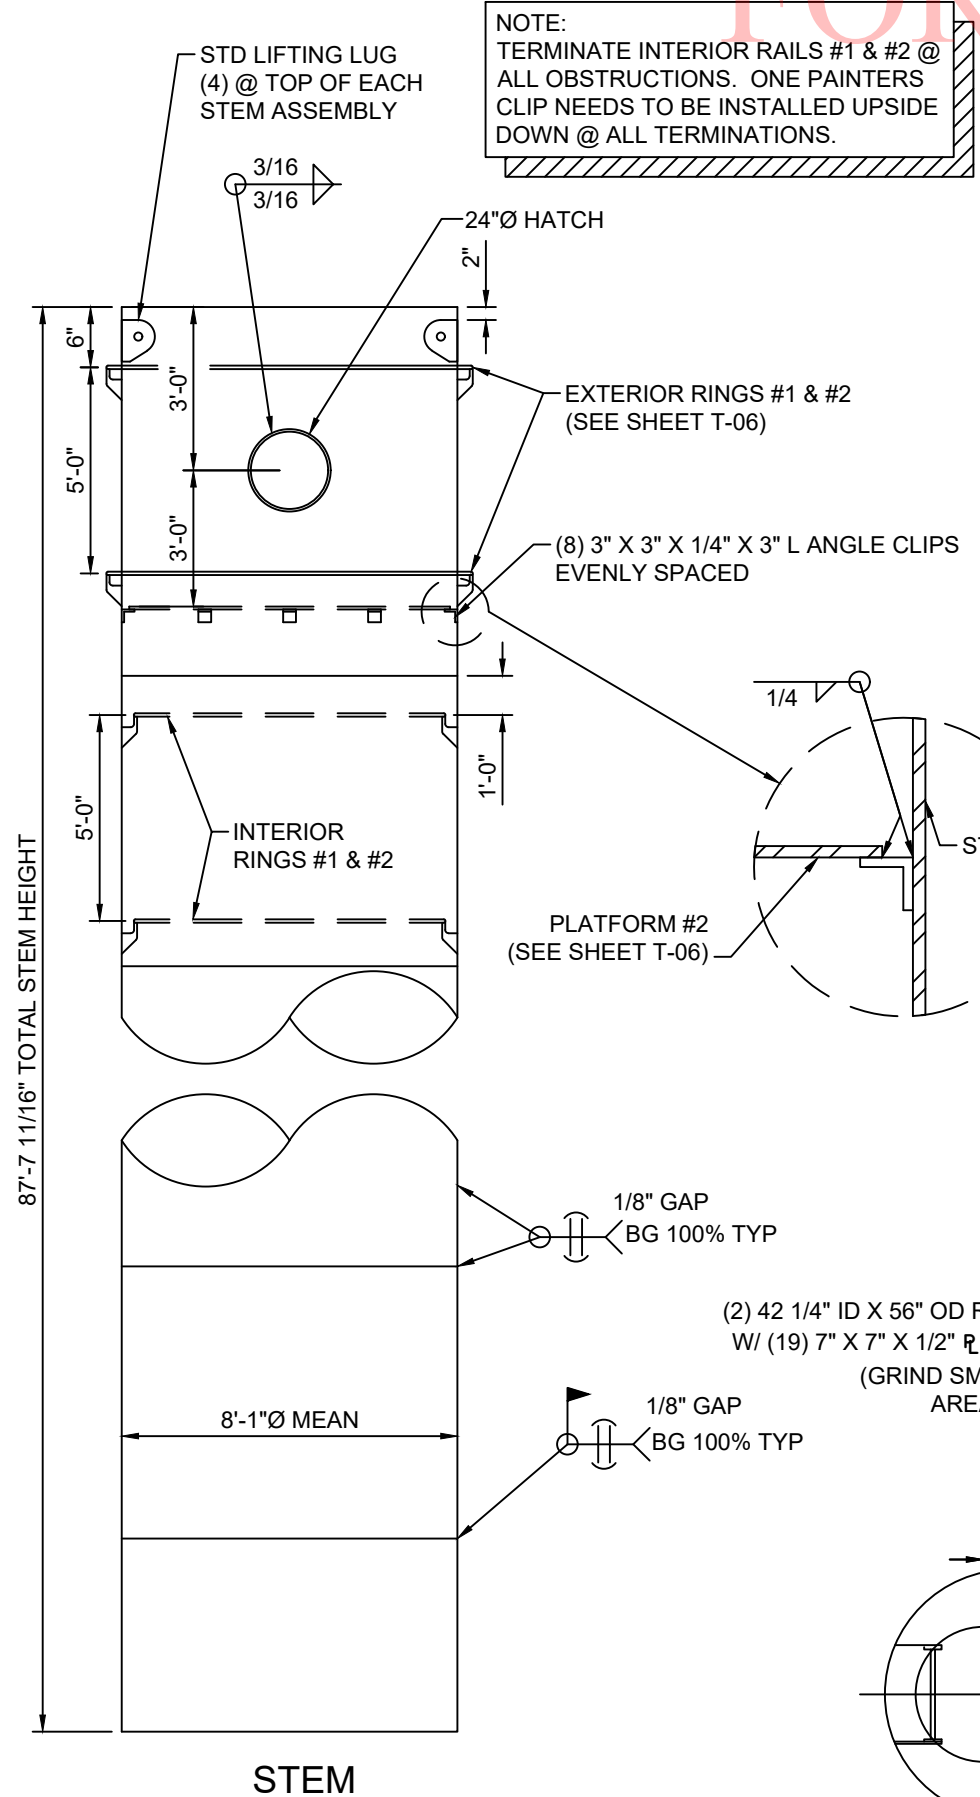


STEM #	THK	OD	WEIGHT
STEM #11	1/2"	8'-1 1/2"	4,143
STEM #10	1/2"	8'-1 1/2"	4,186
STEM #9	17/32"	8'-1 17/32"	4,447
STEM #8	17/32"	8'-1 17/32"	4,447
STEM #7	9/16"	8'-1 9/16"	4,709
STEM #6	19/32"	8'-1 19/32"	4,971
STEM #5	19/32"	8'-1 19/32"	4,971
STEM #4	5/8"	8'-1 5/8"	5,232
STEM #3	21/32"	8'-1 21/32"	5,494
STEM #2	11/16"	8'-1 11/16"	5,756
STEM #1	23/32"	8'-1 23/32"	6,017
	R THK	OD	WEIGHT

STEM SHEETS (A36 MATERIAL TYP)

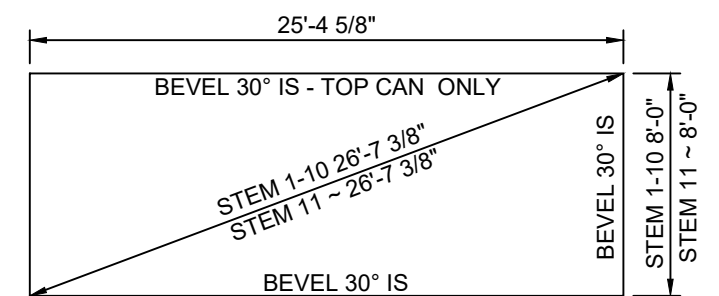

SHOP NOTE: TRIM STEM CAN #10 AS REQUIRED TO MAKEUP STEM HEIGHT

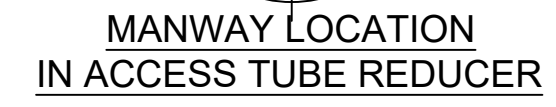

ACCESS TUBE
8,131#

NOT FOR FABRICATION

250,000 GALLON ELEVATED SPHEROIDAL TANK

SUPPORT DETAILS

CITY OF FLOWERY BRANCH
FLOWERY BRANCH, GA





Engineer: KI Drawn By: AB Checked By: KI Date: 10/22

Revision Description
Rev. By Rev. Date
Copyright © 2017 by Phoenix Fabricators & Erectors, LLC. All rights reserved.




PHOENIX
FABRICATORS AND ERECTORS, LLC
Avon, Indiana - Seabree, Kentucky

JOB. No.
3907

SHEET
T-04

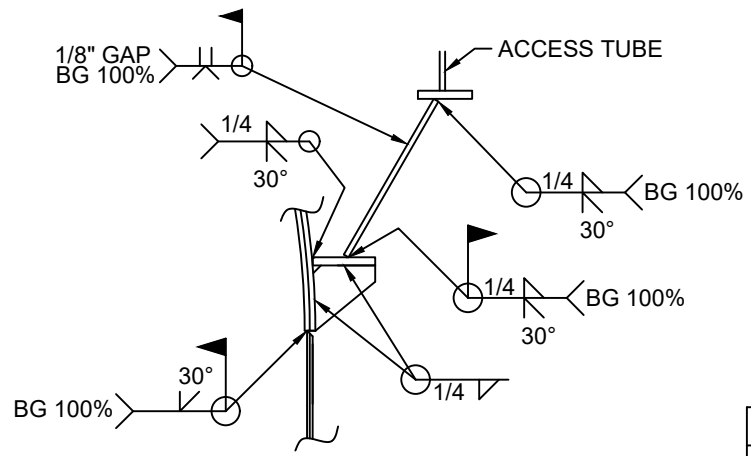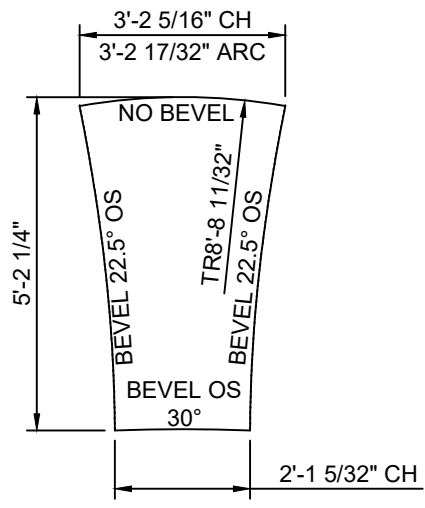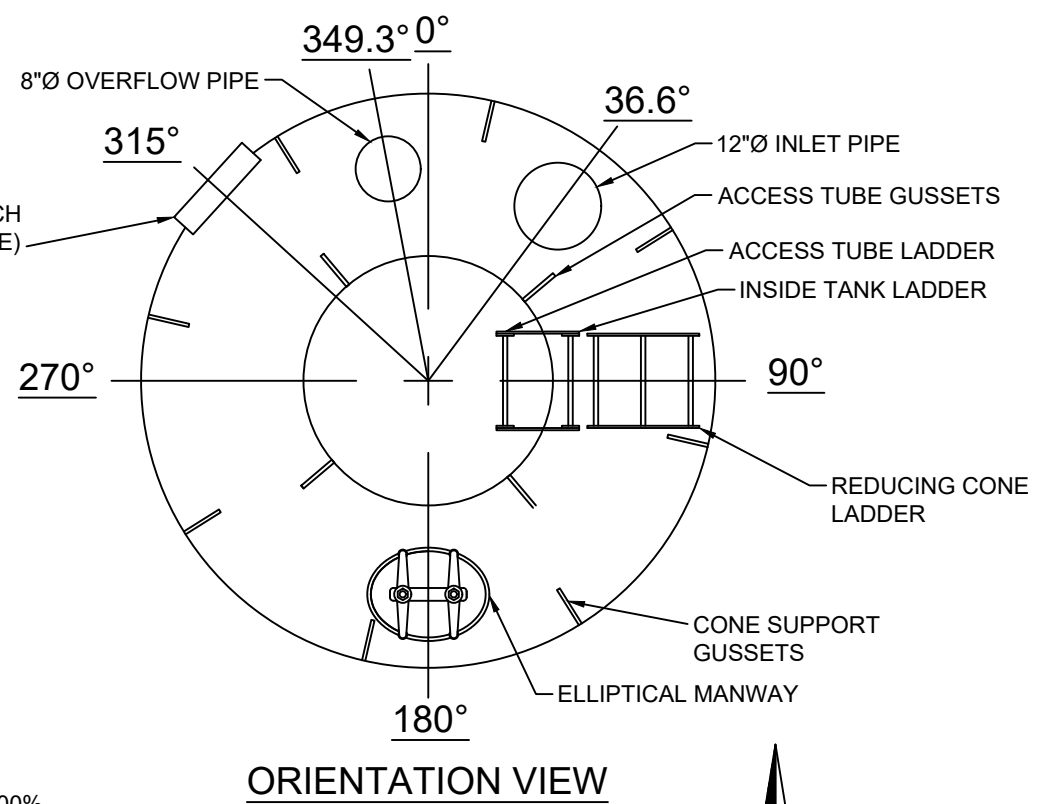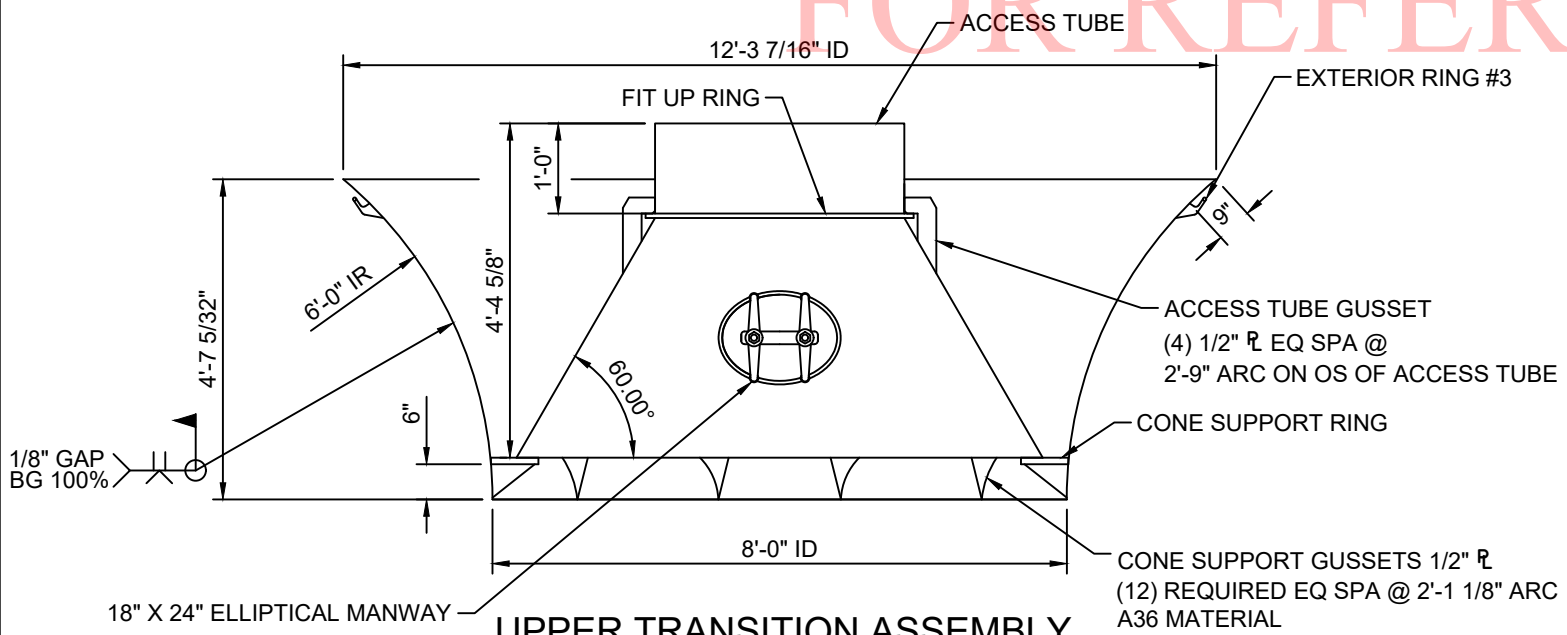

CHORDS AFTER ROLLING	
	CH (1) PC
LARGE END	6'-3 17/32"
SMALL END	3'-0 1/8"

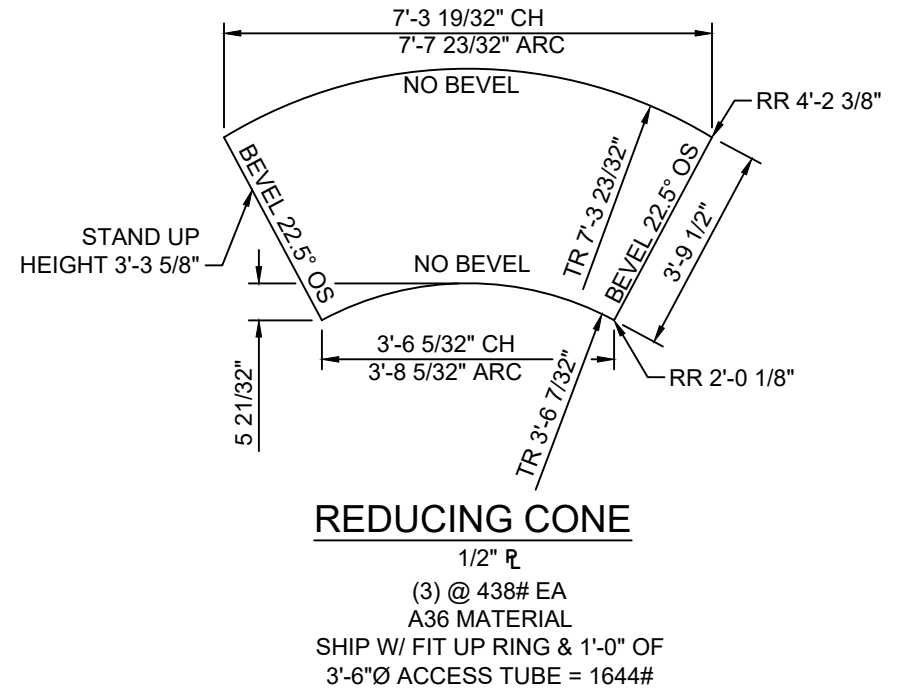
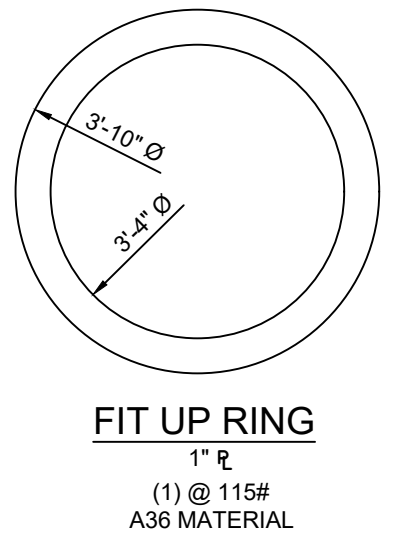
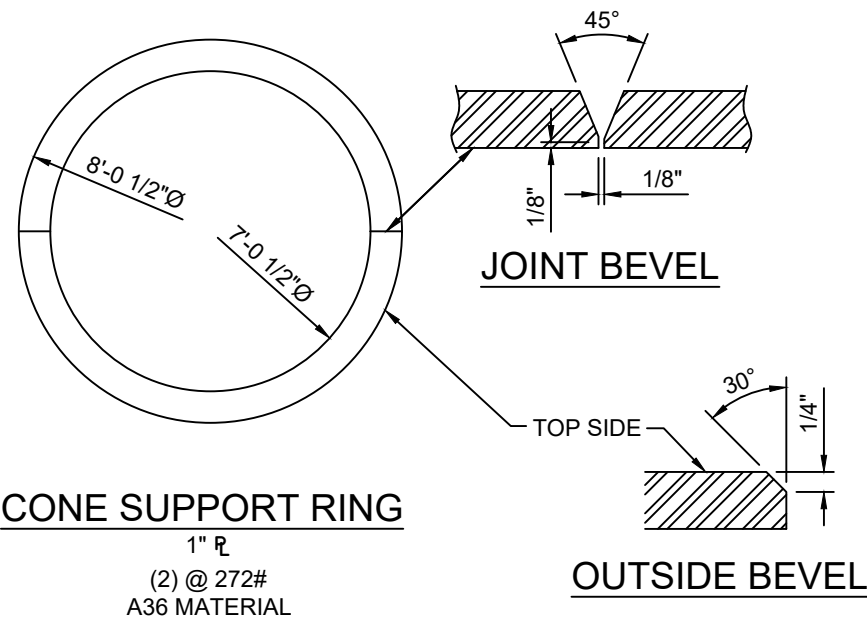


NOT FOR FABRICATION








250,000 GALLON ELEVATED SPHEROIDAL TANK	UPPER TRANSITION DETAILS	CITY OF FLOWERY BRANCH FLOWERY BRANCH, GA	Revision Description	Rev. By	Rev. Date
ENGINEER: KI	DRAWN BY: AB	CHECKED BY: KI	DATE: 10/22		
 PHOENIX FABRICATORS AND ERECTORS, LLC Avon, Indiana - Seabree, Kentucky					
JOB. No.			3907		
SHEET			T-05		
Copyright © 2017 by Phoenix Fabricators & Erectors, LLC. All rights reserved.					

FOR REFERENCE ONLY

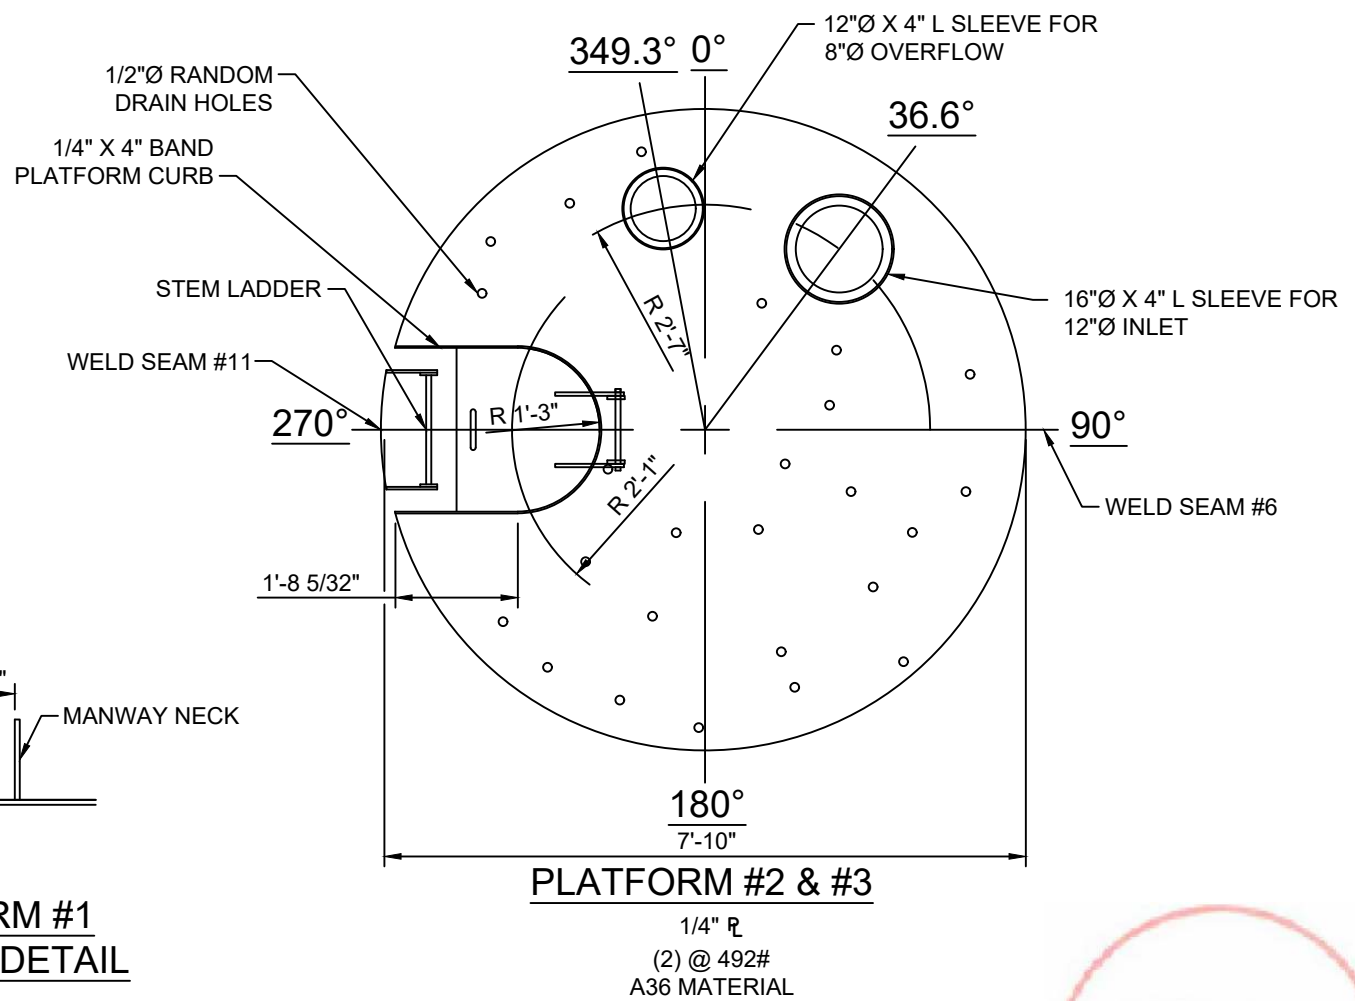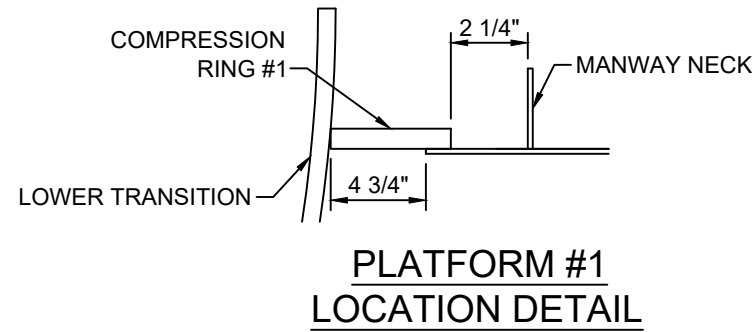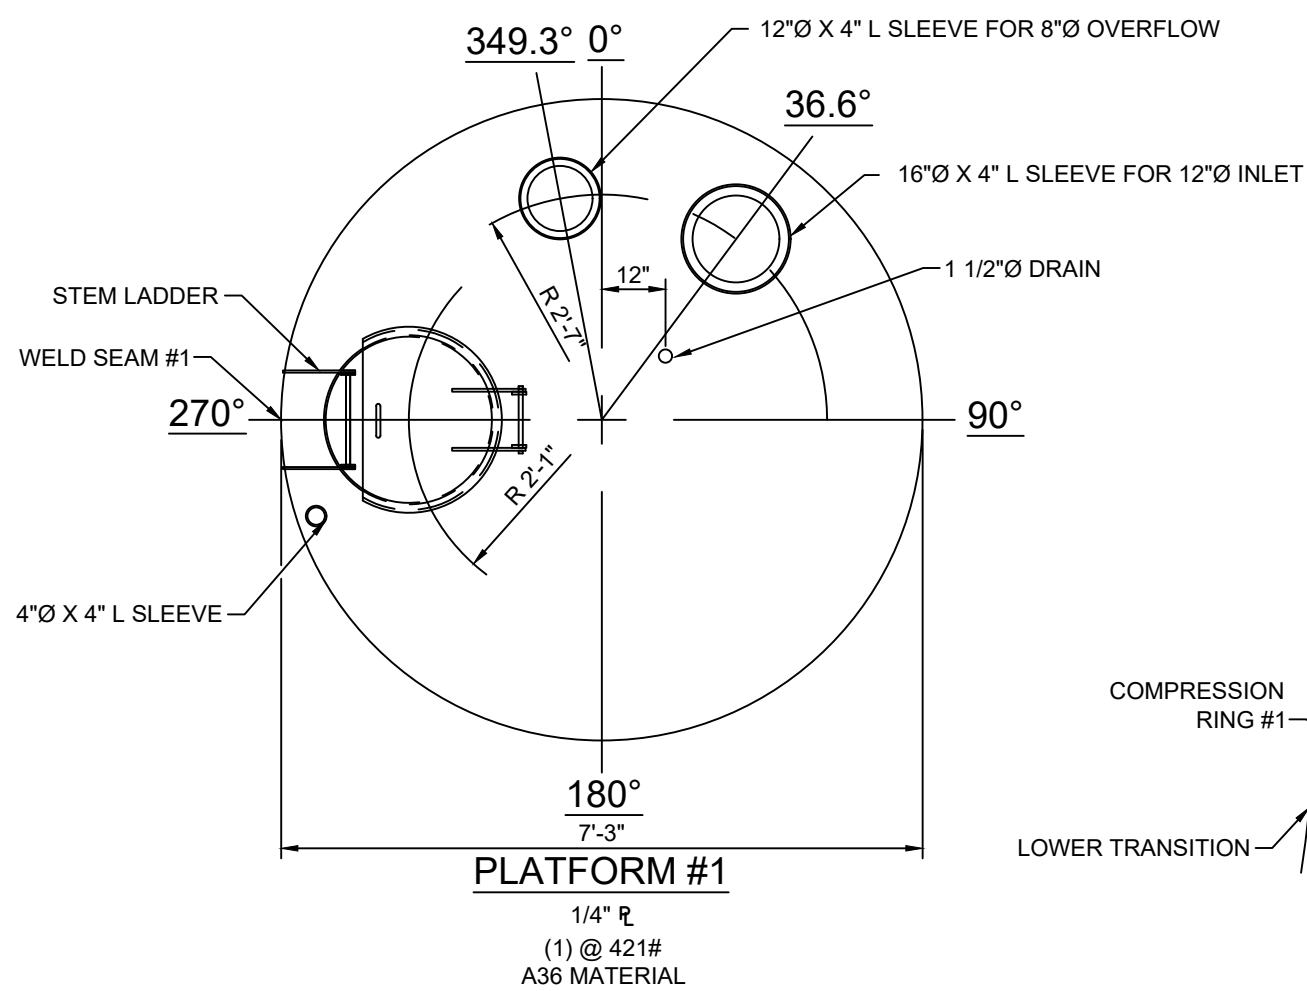

NOT FOR FABRICATION

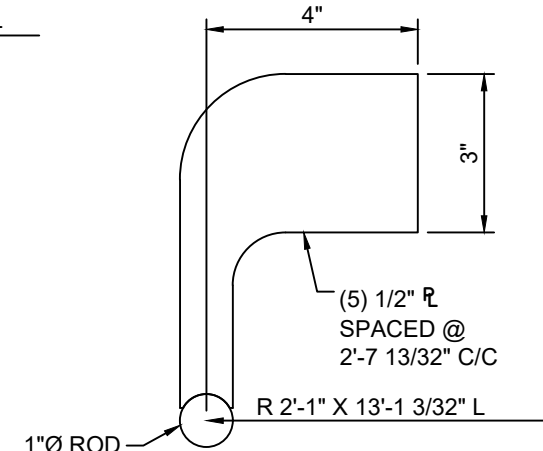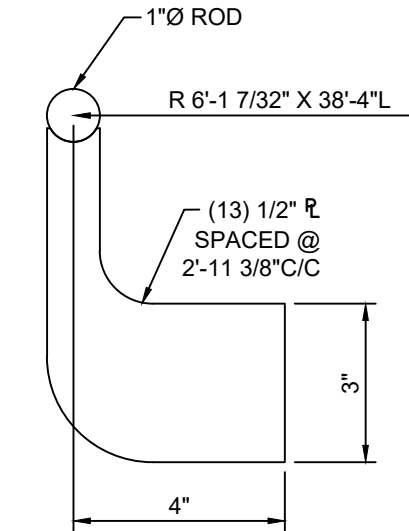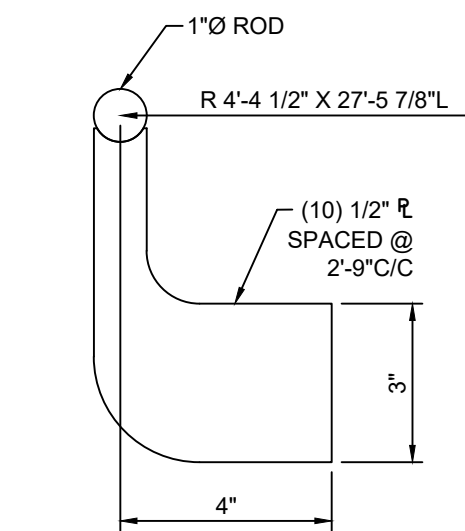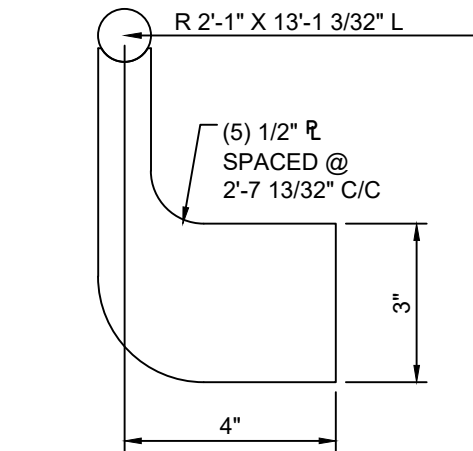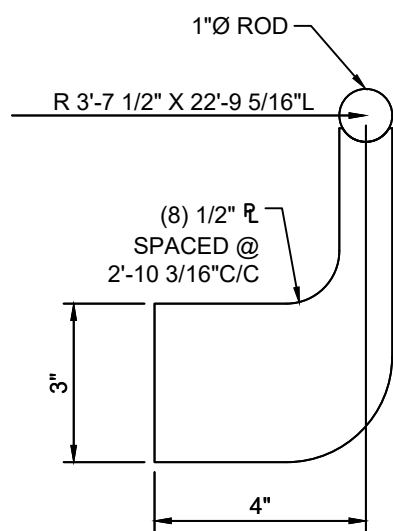

NOTE: ONE CLIP MUST BE AT ROD SPLICE




250,000 GALLON ELEVATED SPHEROIDAL TANK	PLATFORM & RING DETAILS	CITY OF FLOWERY BRANCH FLOWERY BRANCH, GA	Revision Description	Rev. By	Rev. Date
Engineer: KI	Drawn By: AB	Checked By: KI	Date: 10/22		
 PHOENIX FABRICATORS AND ERECTORS, LLC Avon, Indiana - Sebree, Kentucky					
JOB. No.					
3907					
SHEET					
T-06					

Copyright © 2017 by Phoenix Fabricators & Erectors, LLC. All rights reserved.

FOR REFERENCE ONLY

CHORDS AFTER ROLLING		
	CH (1) PC	CH (2) PCS
LARGE END	11'-5 1/4"	19'-9 27/32"
SMALL END	6'-2"	10'-8 9/32"

CHORDS AFTER ROLLING			
	CH (1) PC	CH (2) PCS	CH (4) PCS
LARGE END	12'-9 1/2"	23'-7 3/4"	33'-5 9/32"
SMALL END	8'-9 3/32"	16'-2 5/16"	22'-10 13/16"

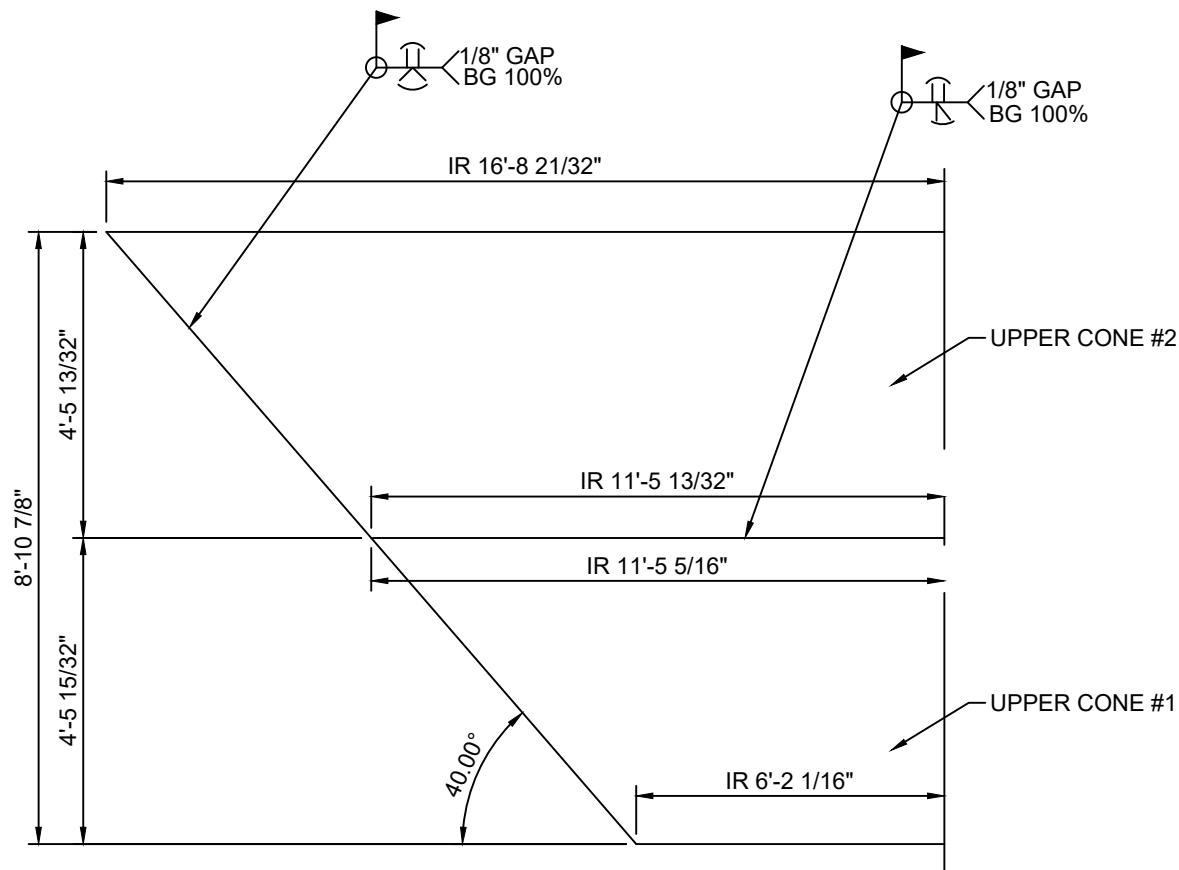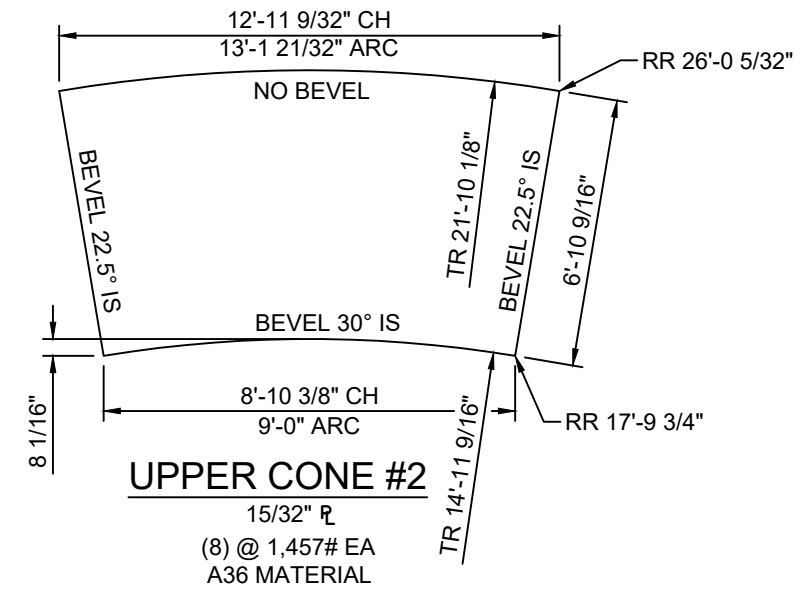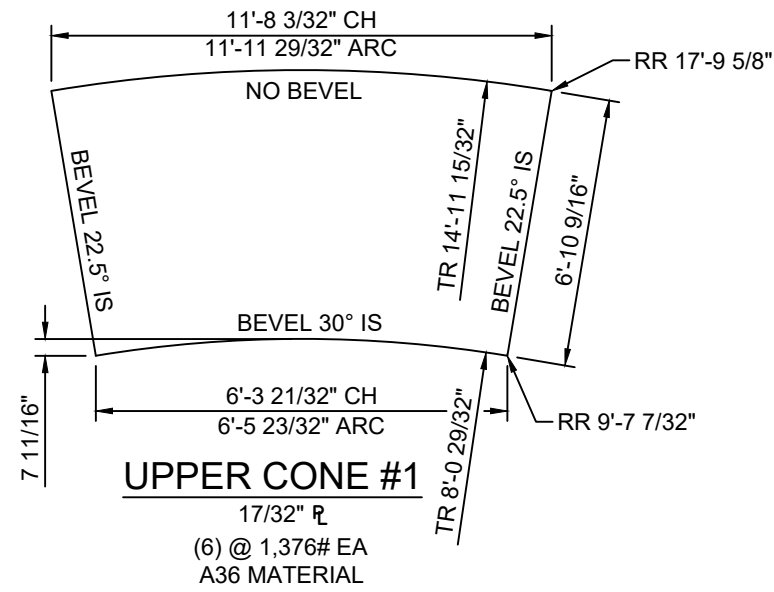

CONES FIT TO OUTSIDE

NOT FOR FABRICATION

250,000 GALLON ELEVATED SPHEROIDAL TANK	
UPPER CONE DETAILS	
CITY OF FLOWERY BRANCH FLOWERY BRANCH, GA	
Engineer: KI	Drawn By: AB
Checked By: KI	Date: 10/22
Rev. By:	Rev. Date:
Rev. Description:	




JOB. No.
3907
 SHEET
T-07

Copyright © 2017 by Phoenix Fabricators & Erectors, LLC. All rights reserved.


FOR REFERENCE ONLY

CHORDS AFTER PRESSING	
	CH (1) PC
LARGE END	6'-7 31/32"
SMALL END	2'-4 7/8"

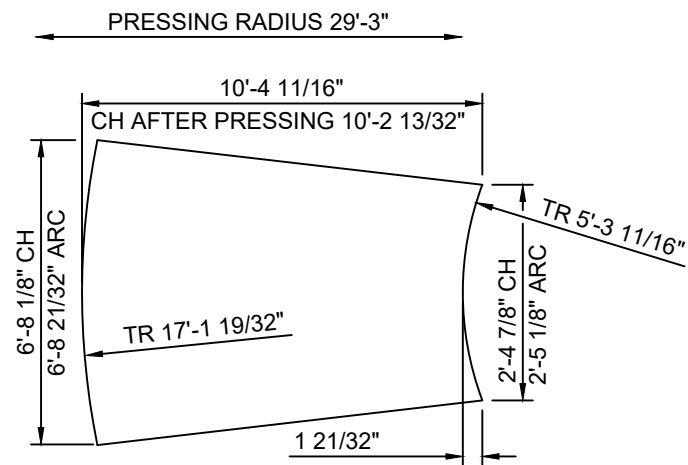


ROOF FINGER

1/4" R
 (14) @ 484# EA
 A36 MATERIAL
 STAND UP HEIGHT = 3'-6 11/16"

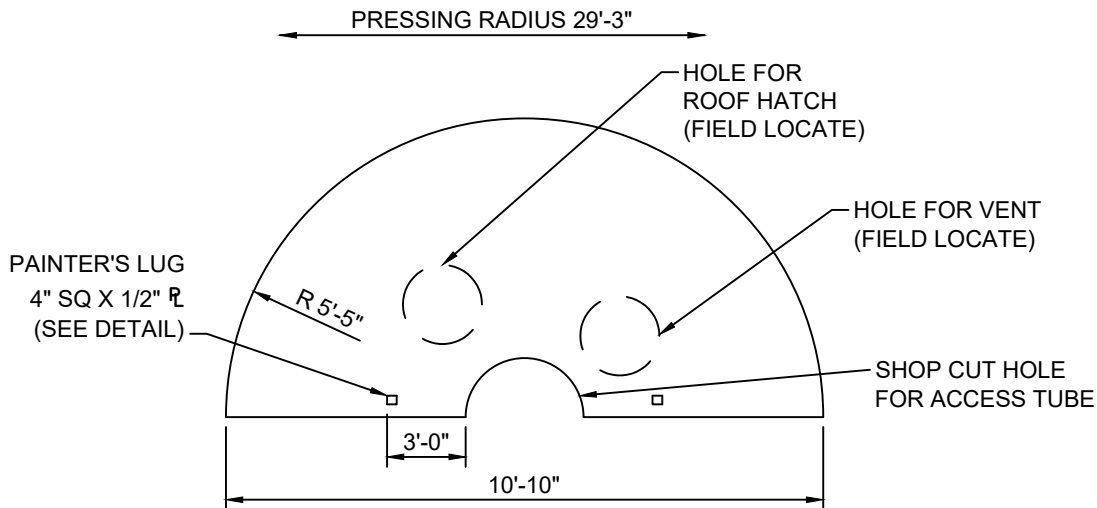

ROOF CAP

1/4" R
 (2) @ 420# EA
 A36 MATERIAL

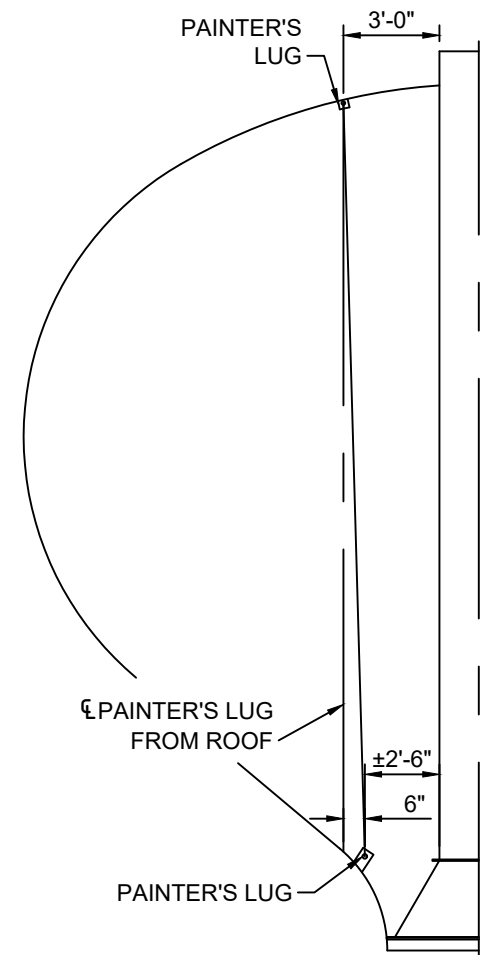


PAINTER'S LUG DETAIL

(2) PLACES @ 180°


CHORDS AFTER PRESSING			
	CH (1) PC	CH (2) PCS	CH (3) PCS
LARGE END	5'-8 31/32"	11'-4 3/4"	16'-10 3/16"
SMALL END	4'-4 7/16"	8'-8"	12'-9 3/4"

CHORDS AFTER PRESSING			
	CH (1) PC	CH (2) PCS	CH (3) PCS
LARGE END	5'-8 31/32"	11'-4 25/32"	16'-10 7/32"
SMALL END	3'-9 27/32"	7'-6 29/32"	11'-2 13/32"

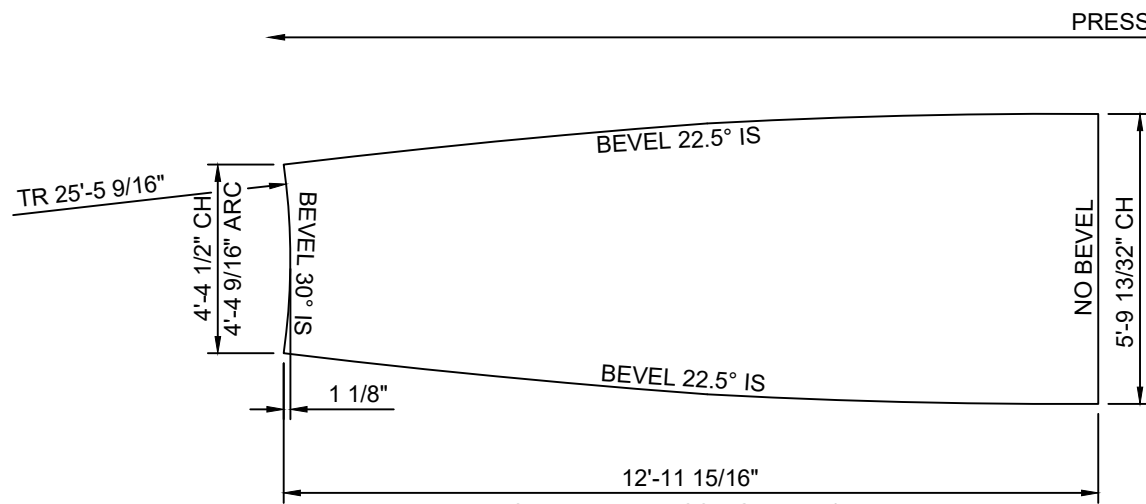

BOWL KNUCKLE

11/32" R
 (24) @ 962# EA
 A36 MATERIAL
 STAND UP HEIGHT = 11'-3 27/32"

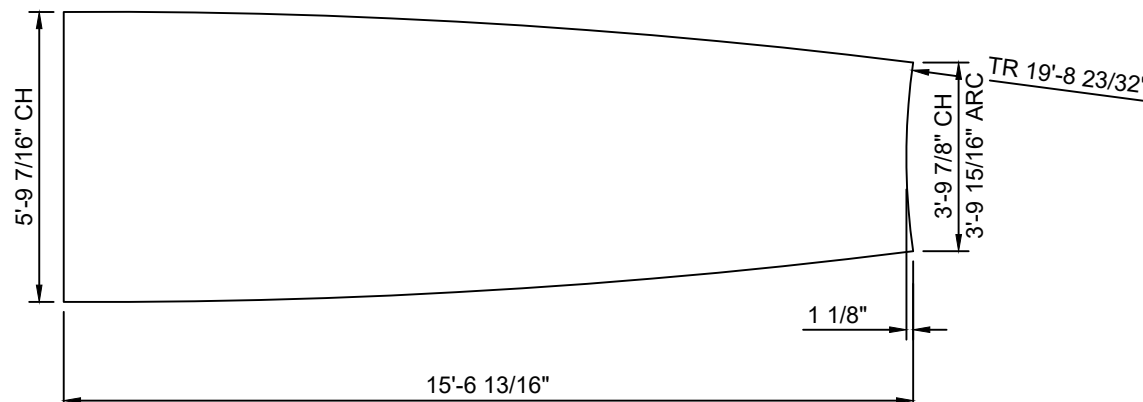

ROOF KNUCKLE

1/4" R
 (24) @ 808# EA
 A36 MATERIAL
 STAND UP HEIGHT = 12'-9 17/32"




250,000 GALLON ELEVATED SPHEROIDAL TANK	Revision Description
GORE DETAILS	Rev. By
CITY OF FLOWERY BRANCH	Rev. Date
FLOWERY BRANCH, GA	Rev. Date
Engineer: KI	Checked By: KI
Drawn By: AB	Date: 10/22
Copyright © 2017 by Phoenix Fabricators & Erectors, LLC. All rights reserved.	




JOB. No.	3907
SHEET	T-08

FOR REFERENCE ONLY

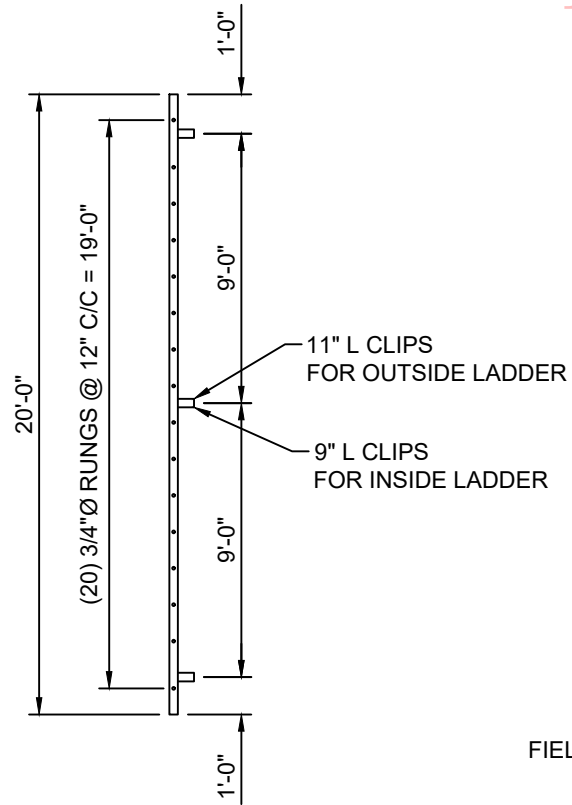


ACCESS TUBE LADDER

INSIDE (1) 20'-0" L SECTIONS (142#) (1) 18'-0" L SECTION (128#)
 OUTSIDE (1) 20'-0" L SECTIONS (142#) (1) 17'-0" L SECTION (121#)

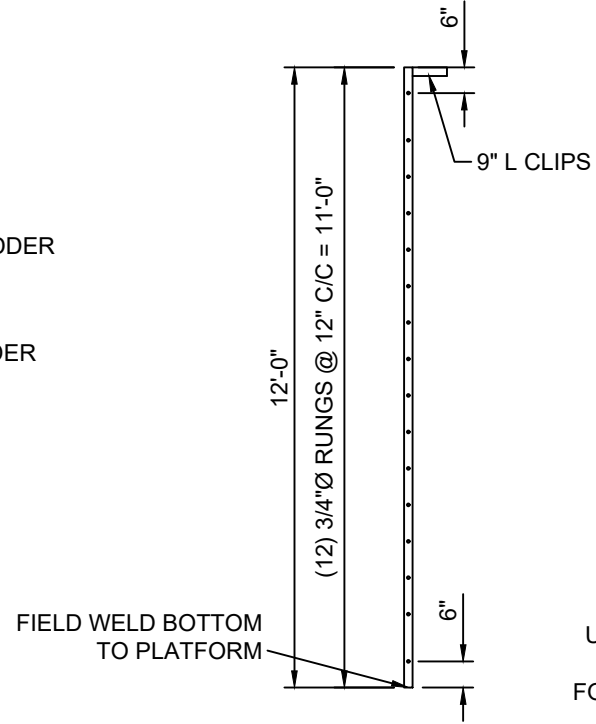

STEM TO ACCESS TUBE LADDER


(85#)

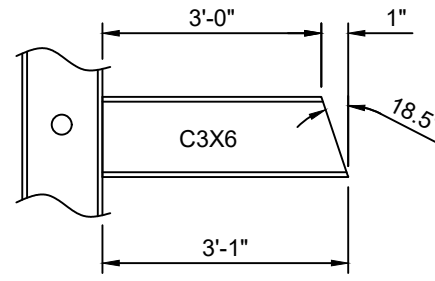

LADDER STAND-OFF


DETAIL A

(2) REQD (18#)
 [SHIP LOOSE]

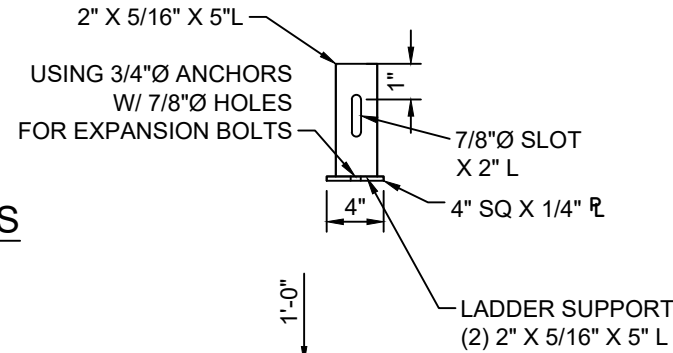

LADDER SUPPORT


(2) 2" X 5/16" X 5" L

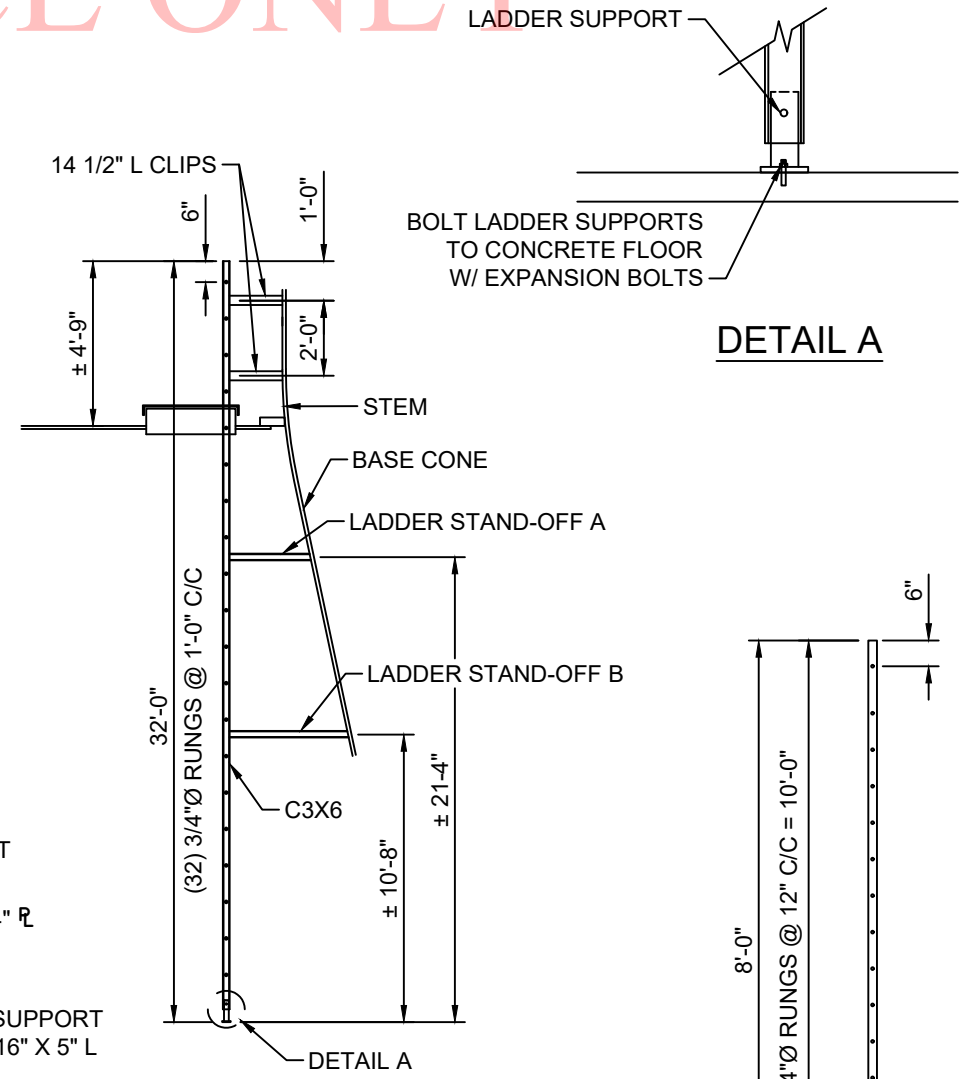

DETAIL A

BASE CONE LADDER

(448#)

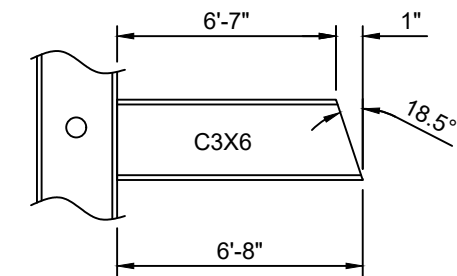


LADDER STAND-OFF

DETAIL B

(2) REQD (42#)
 [SHIP LOOSE]


MANWAY ACCESS LADDER

(57#)

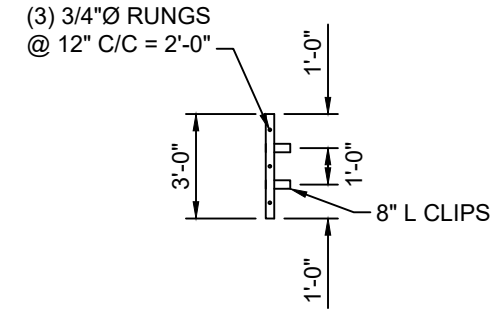

REDUCING CONE LADDER


(1) REQD (21#)

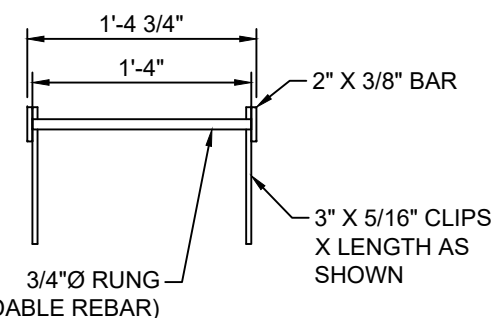

END VIEW TYP

(STANDARD LADDER)

NOTE:
 1. ALL LADDER CLIPS TO BE WELDED INSIDE LADDER RAIL.
 2. GAP LADDER SECTIONS 3/8"

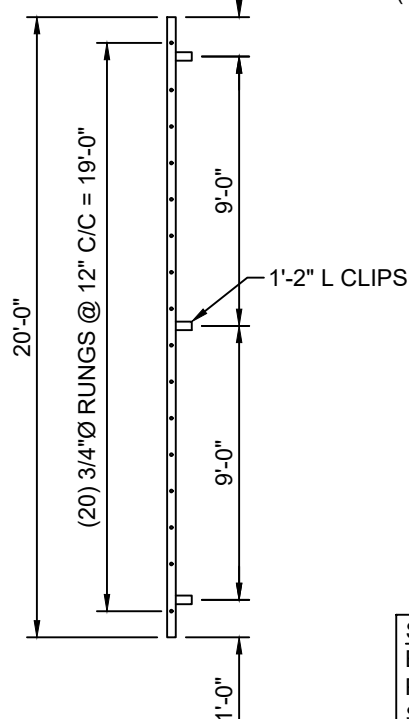

STEM LADDER

(4) 20'-0" L SECTIONS (142# EA)
 (1) 2'-0" SECTION (14#)

STEM LADDER NOTES:
 EXTEND STEM LADDER 48" ± ABOVE PLATFORM #2
 START SAFETY CABLE 24" ± ABOVE CONCRETE FLOOR EXTEND 48" ABOVE PLATFORM #2
 INCLUDES (2) SAFETY HARNESS
 (2) PORTABLE CLAMP




250,000 GALLON ELEVATED SPHEROIDAL TANK	Revision Description
LADDER DETAILS	Rev. By
CITY OF FLOWERY BRANCH	Rev. Date
FLOWERY BRANCH, GA	Copyright © 2017 by Phoenix Fabricators & Erectors, LLC. All rights reserved.
Engineer: KI	Checked By: AB
Date: 10/22	
JOB. No.	
3907	
SHEET	
T-10	

FOR REFERENCE ONLY

ANCHOR BOLT CHORDS	
NUMBER OF SPACES	CHORD LENGTH
1	5'-2 1/32"
2	10'-1 11/16"
3	14'-8 21/32"
4	18'-8 7/8"
5	22'-0 13/32"
6	24'-5 25/32"
7	25'-11 7/8"
8	26'-6"

GENERAL NOTES:

1. FOUNDATION IS DESIGNED FOR AN ALLOWABLE SOIL BEARING CAPACITY OF 4500 PSF @ 7'-0" BELOW FINAL GRADE. ANY CHANGE IN THIS REQUIREMENT SHALL BE A CAUSE FOR A REDESIGN OF THE FOUNDATIONS.
2. CONCRETE SHALL HAVE A MINIMUM 28-DAY COMPRESSIVE STRENGTH OF 4000 PSI.
3. CEMENT SHALL CONFORM TO ASTM C-150 TYPE 1.
4. FOUNDATION SHALL HAVE A RUBBED FINISH TO A POINT 6" BELOW FINISHED GRADE. ALL EXPOSED EDGES SHALL HAVE A 1" CHAMFER. ANY VOIDS EXPOSED WHEN FORMS ARE REMOVED SHALL BE FILLED WITH A GROUT MIXTURE.
5. REINFORCING STEEL SHALL CONFORM TO ASTM A-615 GRADE 60.
6. REINFORCING BARS SHALL CLEAR ALL OPENINGS.
7. ANCHOR BOLTS SHALL BE SET VERTICAL, WITH A TOLERANCE NOT TO EXCEED 1/8" IN 12".
8. ANCHOR BOLTS SHALL BE NO MORE THAN 1/4" FROM THE SPECIFIED LOCATION IN PLAN.
9. ENGINEER SHALL ORIENT THE DIRECTION OF PIPING AND LOCATE THE CENTER OF THE TANK.
10. SOIL BEARING CAPACITY WAS ESTABLISHED BY AN INDEPENDENT SOIL LABORATORY.
11. ALL BACKFILL SHALL BE PLACED IN 6"-8" LIFTS. BACKFILL ON OUTSIDE OF RINGWALL SHALL BE COMPACTED TO AT LEAST 95% OF MAXIMUM STANDARD PROCTOR DENSITY (ASTM D698) AT OPTIMUM MOISTURE CONTENT. BACKFILL ON INSIDE OF RINGWALL SHALL BE ENGINEER FILL TO AT LEAST 95% OF MAXIMUM STANDARD PROCTOR DENSITY (ASTM D698) AT OPTIMUM MOISTURE CONTENT.
12. FLOOR DRAIN NOT SHOWN ON PLAN VIEW. FOUNDATION CREW TO COORDINATE LOCATION OF DRAIN WITH OWNER. SLOPE DRAIN AWAY FROM TANK TO DISCHARGE AT DAYLIGHT.

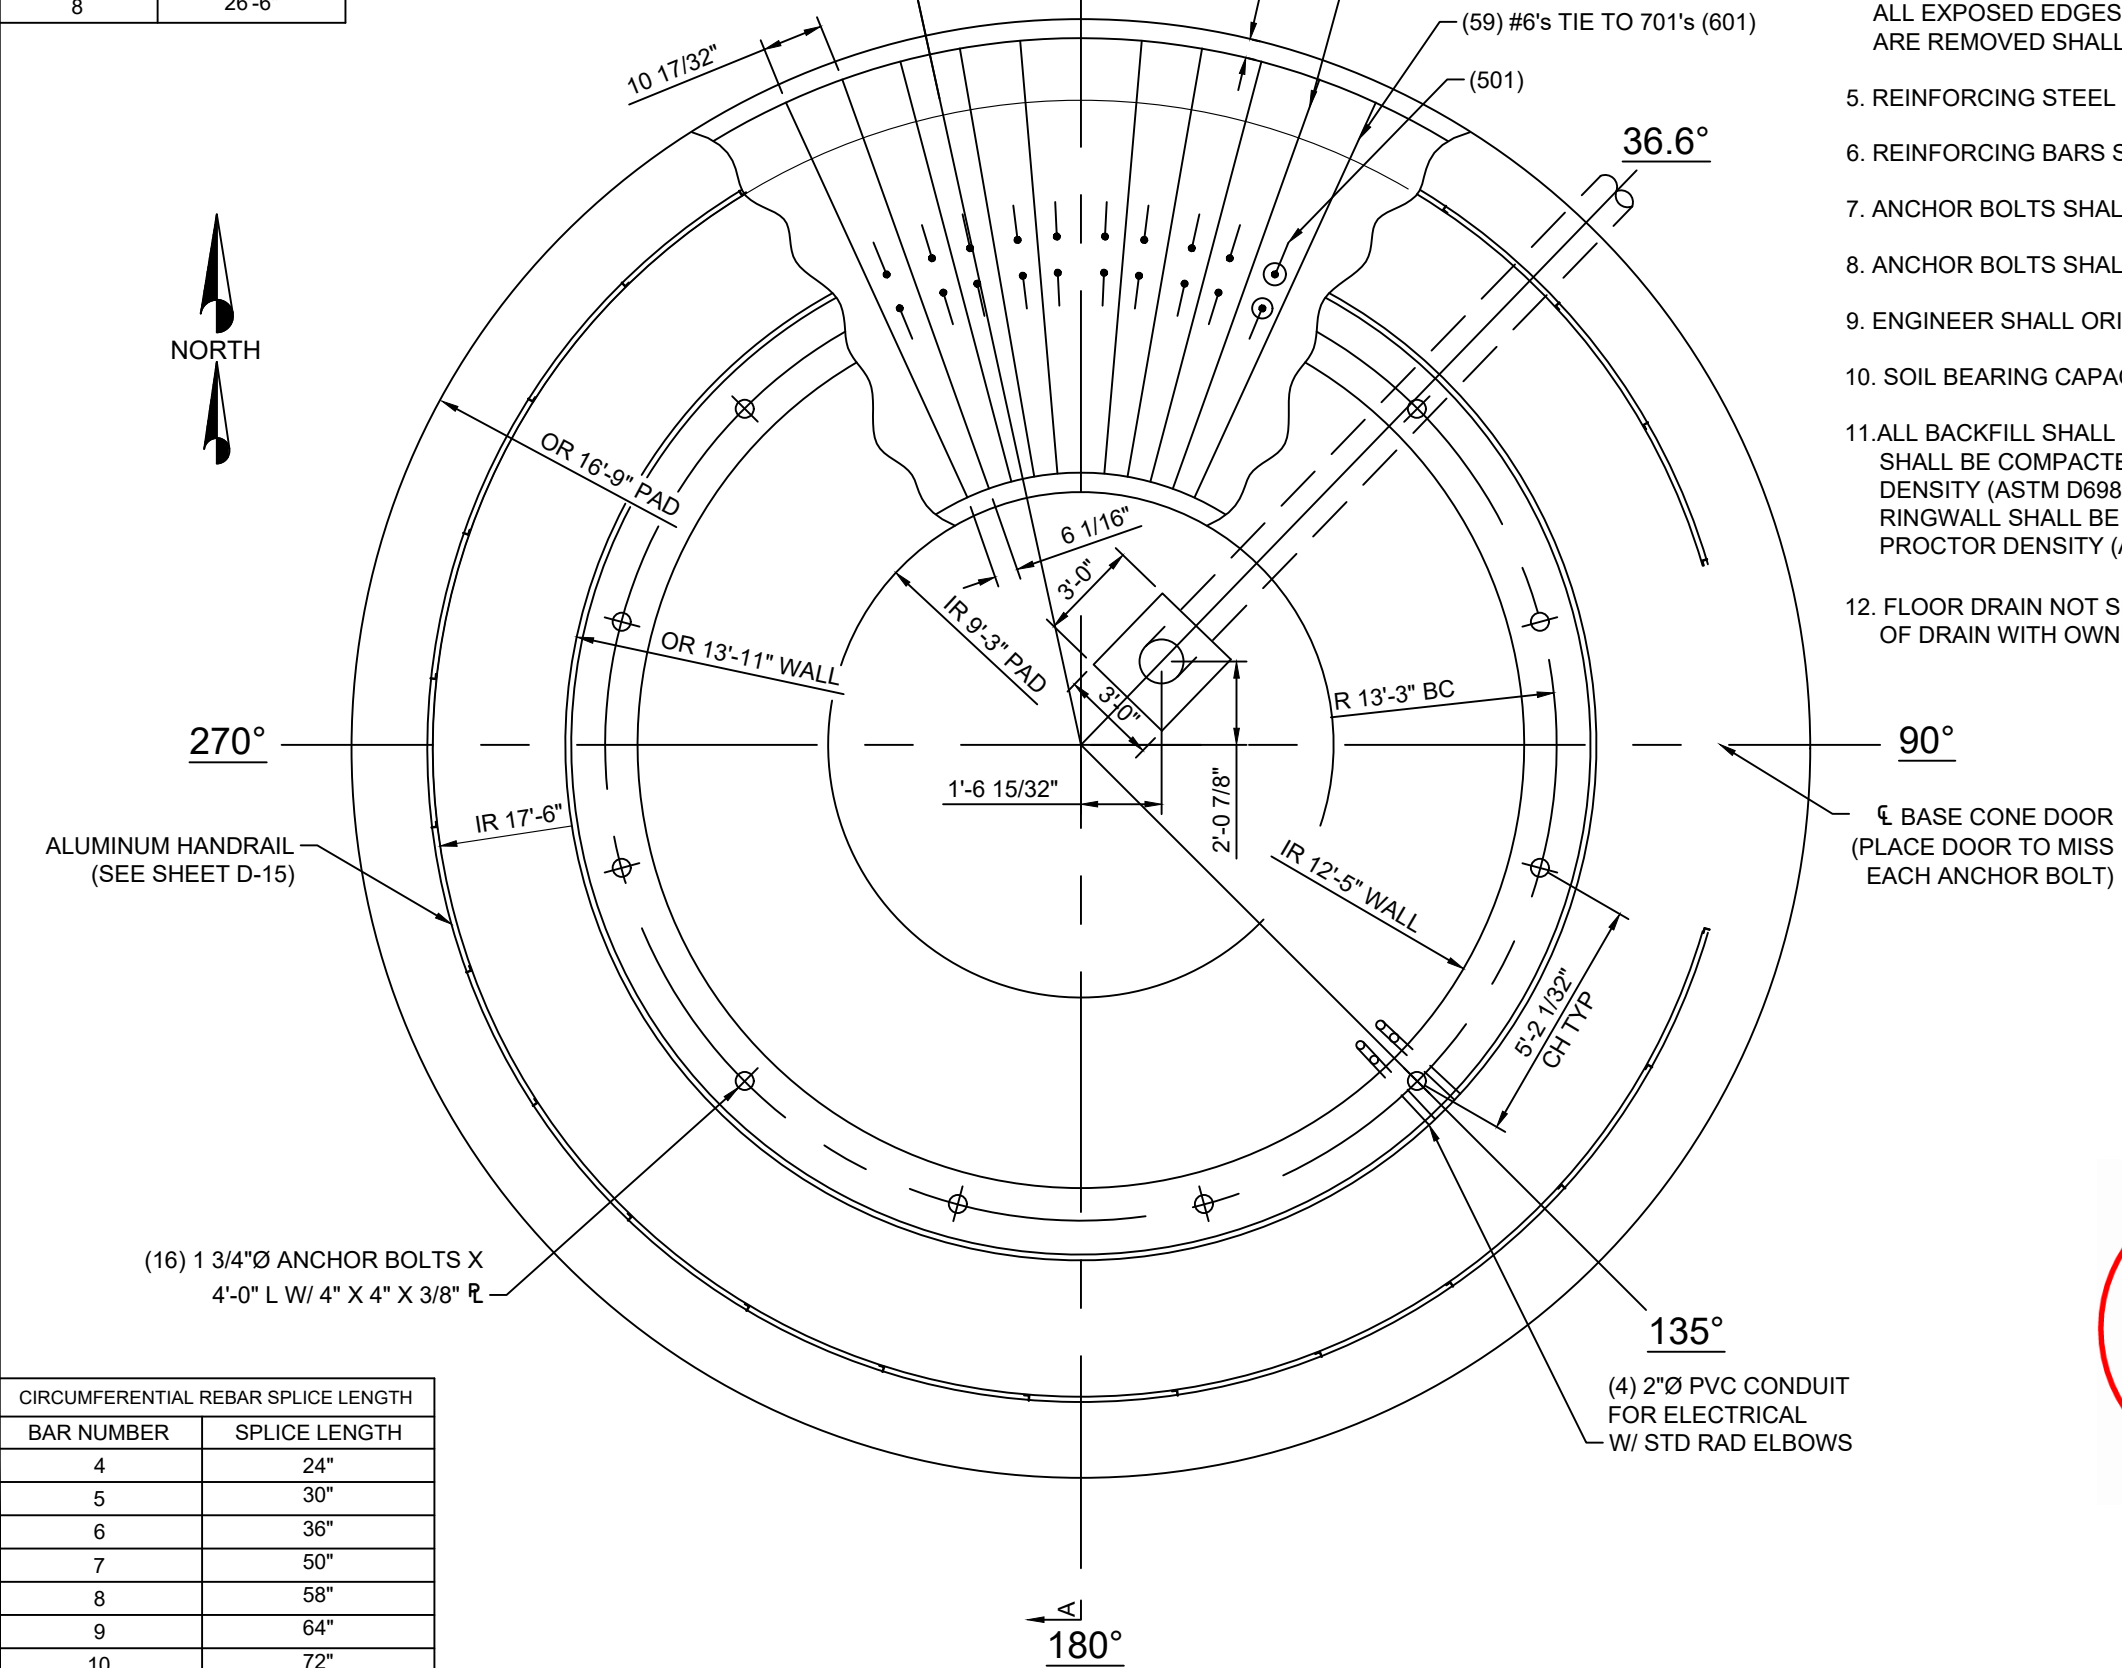

DESIGN CRITERIA

SPECIFICATIONS:	AWWA D100-21 ACI 318-11
WIND:	117 MPH - AWWA
SNOW:	25 PSF - AWWA
SEISMIC:	SITE CLASS C S _s = 0.207 S ₁ = 0.089


NOT FOR
FABRICATION





250,000 GALLON ELEVATED SPHEROIDAL TANK	FOUNDATION DETAILS
CITY OF FLOWERY BRANCH FLOWERY BRANCH, GA	ENGINEER KURT T. FULLER
Engineer: KI	Date: 10/22
Drawn By: AB	Checked By: KI
Rev. By: AB/KI	Rev. Date: 11/28/22
Revised Items Noted	Revision Description
Copyright © 2017 by Phoenix Fabricators & Erectors, LLC. All rights reserved.	

CIRCUMFERENTIAL REBAR SPLICE LENGTH	
BAR NUMBER	SPLICE LENGTH
4	24"
5	30"
6	36"
7	50"
8	58"
9	64"
10	72"

FOR REFERENCE ONLY

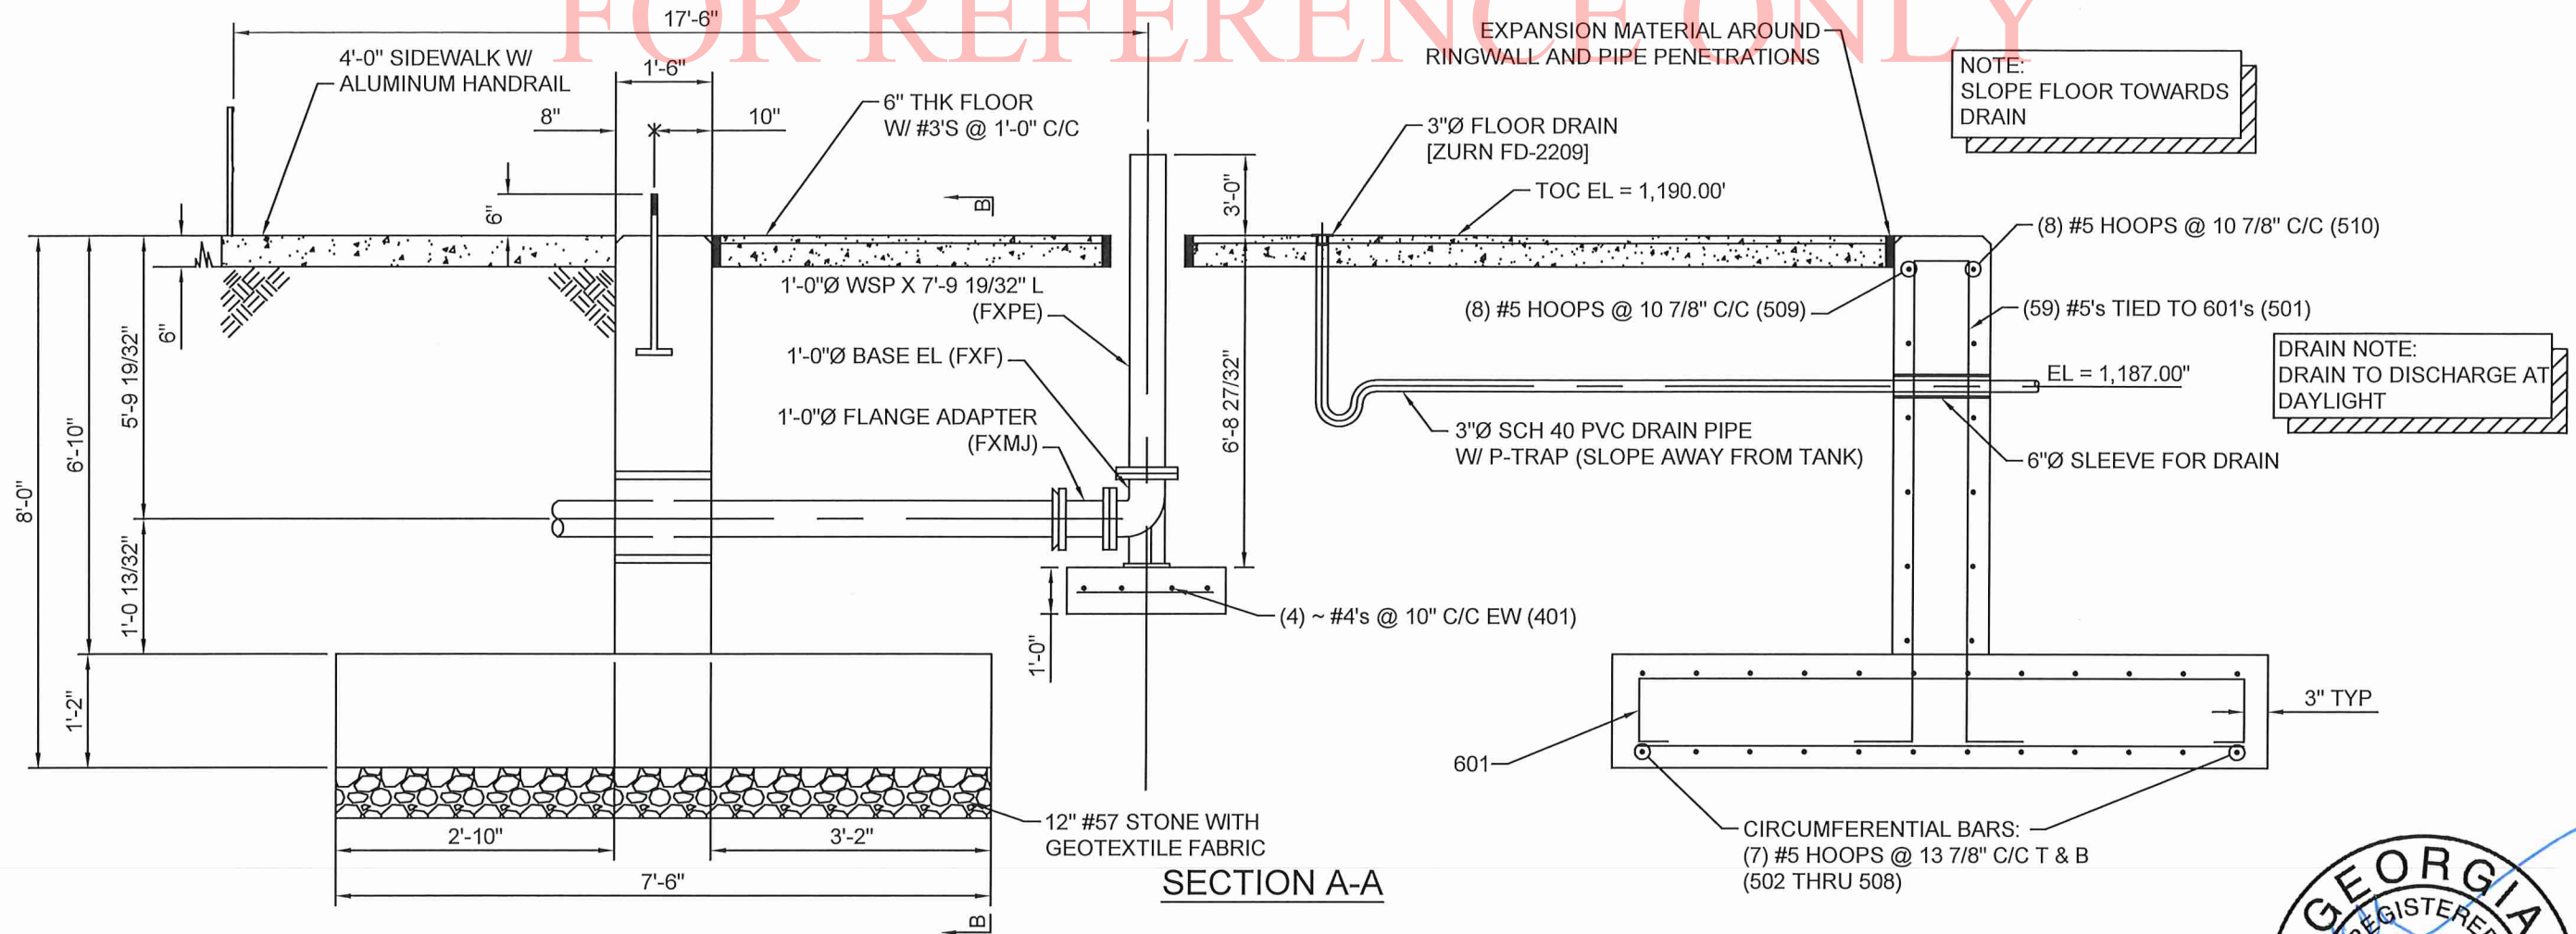

NOTE:
MECHANICAL JOINTS TO BE RESTRAINED

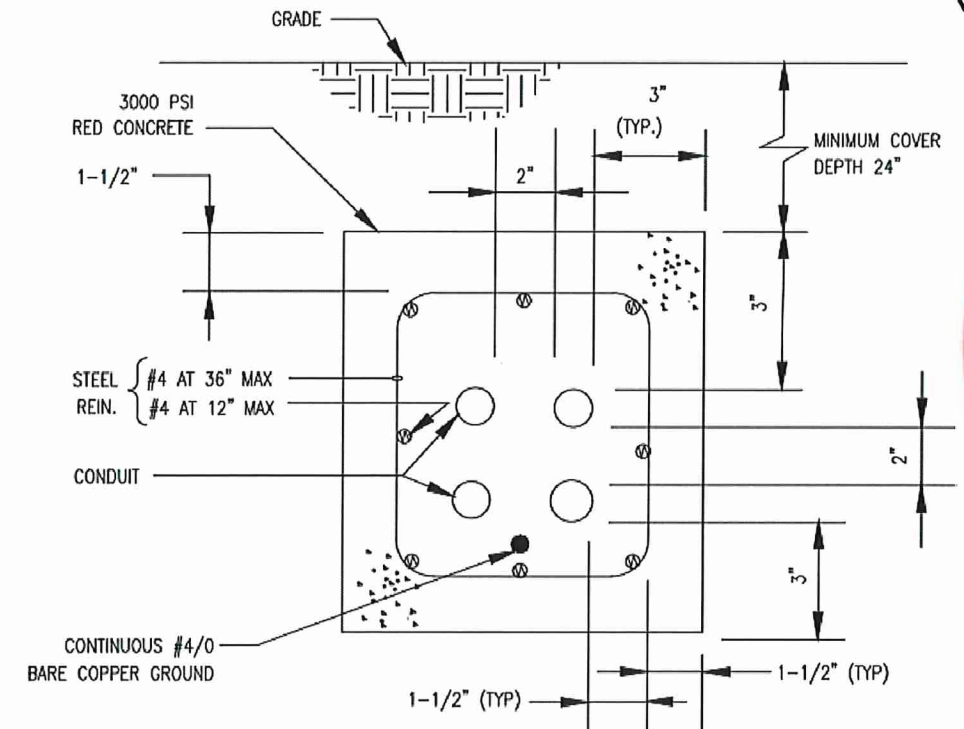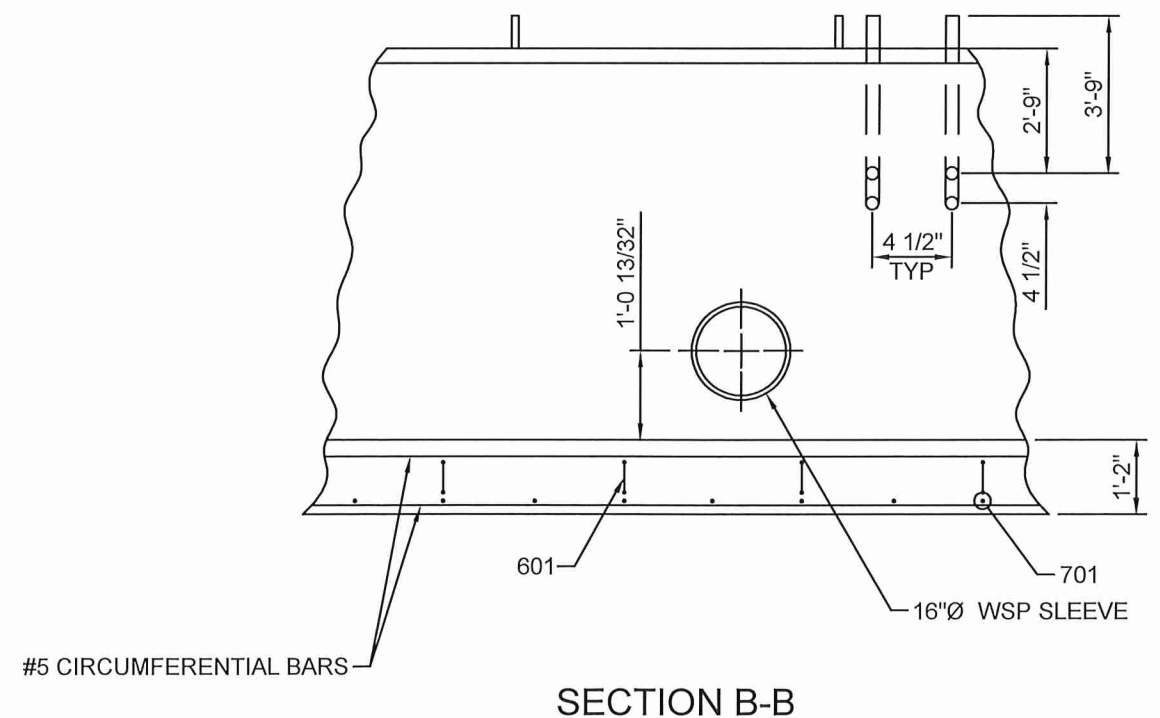

NOT FOR
FABRICATION

<p>250,000 GALLON ELEVATED SPHEROIDAL TANK</p> <p>FOUNDATION ELEVATION DETAILS</p> <p>CITY OF FLOWERY BRANCH FLOWERY BRANCH, GA</p> <p>Engineer: KI Drawn By: AB Checked By: KI Date: 10/22</p>	<p>Revision Description</p> <p>Rev. By: Rev. Date</p> <p>Copyright © 2017 by Phoenix Fabricators & Erectors, LLC. All rights reserved.</p>
<p>Phoenix FABRICATORS AND ERECTORS, LLC Avon, Indiana - Sebree, Kentucky</p>	
<p>JOB. No.</p> <p style="font-size: 1.5em;">3907</p> <p>SHEET</p> <p style="font-size: 1.5em;">F-02</p>	

FOR REFERENCE ONLY

CRITERIA: AWWA D100-21, 117 MPH Wind, Ss=0.207, S1=0.089, Site Class C

DESIGN LOADS: (All Loads in Pounds or In-Kip)	CONCRETE STRENGTH:
Dead = 175860	DESIGN f'C = 3000 psi
Live = 2121975	REBAR: GRADE 60
Snow = 24983	
Wind: Moment(W) = 56500	Shear(W) = 47205
Seismic = 28920	Moment(E) = 73552
	Shear(E) = 36811

GEOTECHNICAL REPORT:
 4500 PSF @ 7.00 Ft. Below Final Grade
 Soil Borings By: Geo-Hydro Engineers, Inc. - Kennesaw, GA
 Report Number: 181823.20

DIMENSIONS:
 Base cone diameter of 26'-0"
 Wall height of 6'-10"
 Inner wall radius of 12'-5"
 Outer wall radius of 13'-11"
 Pad width of 7'-6" and height of 14"
 Inner pad radius of 9'-3"
 Outer pad radius of 16'-9"
 Bearing Area of 612.61 ft²
 Section Modulus of 3347.6 ft³

REINFORCEMENT:
 8 pairs circumferential bars in wall at 10 7/8"
 7 rows of circumferential bars in pad at 13 7/8"
 59 - #6's @ 17 3/4" O/C E.W. (Top)
 118 - #7's @ 8 7/8" O/C E.W. (Bottom)

BEARING: DLE Critical

D+L+S Capacity = 4500 psf	>	D+L+S Actual = 3939 psf
D+L+W Capacity = 6000 psf	>	D+L+W Actual = 5418 psf
D+L+E Capacity = 6000 psf	>	D+L+E Actual = 5865 psf

OVERTURNING:

Capacity = 139741 in-kip > Actual = 61032 in- kip

ANCHOR BOLTS:

Use 16 - 1 3/4" Dia. A36 Bolts x 48" Lg.

Tension Capacity = 37000 lbs	>	Tension Actual = 33557 lbs
Shear Capacity = 18500 lbs	>	Shear Actual = 2950 lbs

Top of Foundation Elevation = 1190.00'






11-21-22

250,000 GALLON ELEVATED SPHEROIDAL TANK	Rev. By	Rev. Date	Revision Description
FOUNDATION DESIGN SUMMARY			
CITY OF FLOWERY BRANCH	Engineer: KI	Checked By: AB	Date: 10/22
FLOWERY BRANCH, GA	Drawn By: AB	Checked By: KI	Date: 10/22
Avon, Indiana - Sebree, Kentucky			
JOB. No.			
3907			
SHEET			
F-03			

Copyright © 2017 by Phoenix Fabricators & Erectors, LLC. All rights reserved.

FOR REFERENCE ONLY

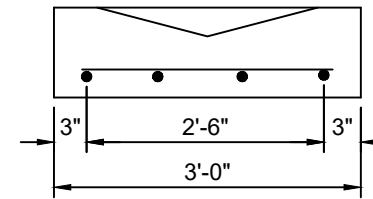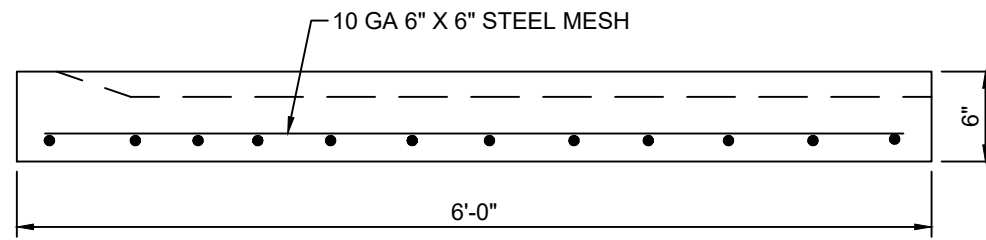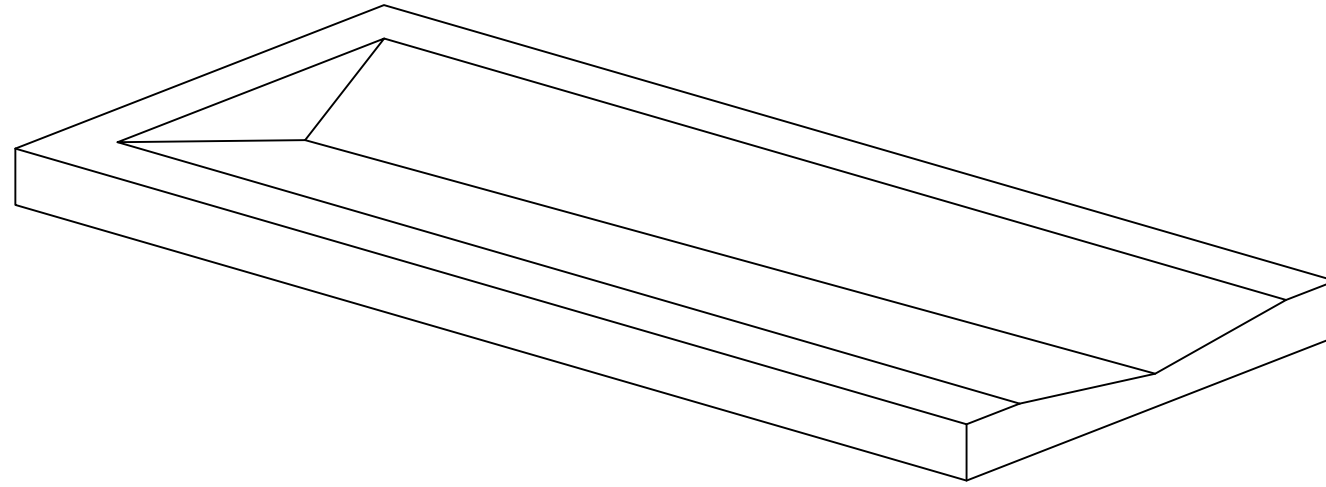

NOT FOR FABRICATION

250,000 GALLON ELEVATED SPHEROIDAL TANK	⬠			
SPLASH BLOCK DETAILS	⊙			
CITY OF FLOWERY BRANCH FLOWERY BRANCH, GA	⊕			
Engineer: KI	⚠	Rev. By	Rev. Date	Revision Description
Drawn By: AB		Checked By: KI	Date: 10/22	Copyright © 2017 by Phoenix Fabricators & Erectors, LLC. All rights reserved.



JOB. No.
3907
SHEET
F-04

COATING SYSTEMS PREPARATION AND APPLICATION INSTRUCTIONS

Project Information	Owner Information	Engineer Information	Coating Manufacturer Information
Project Number: 3907 Project Name: Flowery Branch, GA Project Size: 250,000 Project Design: TE High Water Level: 152' GPS Location: 34.186609, -83.928547	City of Flowery Branch 5410 W. Pine Street, Flowery Branch, GA 30542 770-967-6371	Infratec Consultants, Inc 310 Saddle Hill Ct. Roswell, GA 30075 Keith Hendrix 404-861-6956 kh.infratec@aol.com	Tnemec Company, Inc. Jeff Parish 317-694-0861 jparish@tnemec.com

SHOP PROCEDURES

Surface Preparation	Primer Application	DFT's	Shop Notes
Interior Wet: SSPC SP-10 Near White Abrasive Blast Interior Dry: SSPC SP-6 Commercial Blast Exterior: SSPC SP-6 Commercial Blast All Surfaces: SSPC SP-1 Solvent Cleaning (free of visible contaminants)	Interior Wet: Tnemec Series 94 H2O Hydro-Zinc Interior Dry: Tnemec Series 94 H2O Hydro-Zinc Exterior: Tnemec Series 94 H2O Hydro-Zinc	2.5 - 3.5 2.5 - 3.5 2.5 - 3.5	1. Leave margin on edges of sheets for welding

FIELD PROCEDURES

Surface Preparation	Coating Application	DFT's	Surface Area:
Interior Wet: a. SSPC SP-10 Near White Abrasive Blast all weld seams and abraded areas. b. SSPC SP-7 Brush-Off Blast all remaining shop primed areas. Interior Dry: a. SSPC SP-6 Commercial Abrasive Blast all weld seams and abraded areas. b. SSPC SP-7 Brush-Off Blast all remaining shop primed areas. Exterior: a. SSPC SP-6 Commercial Abrasive Blast all weld seams and abraded areas. b. SSPC SP-7 Brush-Off Blast all remaining shop primed areas. Ductile Pipe: NA All Surfaces: SSPC SP-1 Solvent Cleaning (free of visible contaminants) Field Abrasive: Starblast	<u>Interior Wet Coating System</u> Prime: Tnemec Series 91 H2O Hydro-Zinc Stripe: Tnemec Series N140 Pota-Pox Plus 15BL Tank White Intermediate: Tnemec Series N140 Pota-Pox Plus 1255 Beige Finish: Tnemec Series N140 Pota-Pox Plus 15BL Tank White <u>Interior Dry Coating System</u> Prime: Tnemec Series 91 H2O Hydro-Zinc Stripe: Tnemec Series N140 Pota-Pox Plus 15BL Tank White Intermediate: Tnemec Series N140 Pota-Pox Plus 1255 Beige Finish: Tnemec Series N140 Pota-Pox Plus 15BL Tank White <u>Exterior Coating System</u> Prime: Tnemec Series 91 H2O Hydro-Zinc Stripe: Tnemec Series N140 Pota-Pox Plus 15BL Tank White Intermediate: Tnemec Series 73 Endura-Shield Finish: Tnemec Series 700 HydroFlon (Color TBD)	2.5 - 3.5 6.0 - 8.0 6.0 - 8.0 Total: 8.5 - 19.5 2.5 - 3.5 6.0 - 8.0 6.0 - 8.0 Total: 8.5 - 19.5 2.5 - 3.5 2.0 - 3.0 2.0 - 3.0 Total: 6.5 - 9.5	6710 ft ² 8520 ft ² 9600 ft ²
<u>Logo/Lettering/Paint Scheme</u> Exterior Finish: Tnemec Series 700 HydroFlon Color(s): Color TBD Logo/Lettering: "FLOWERY BRANCH" pounced logo Colors: Colors TBD Location: "by engineer" Target Color: NA	<u>Manufacturers Notes</u> 1. Fast cure version of N140 to be used for low temperature applications. 2. 44-710 Urethane accelerator to be used with 73,700,91H2O for low temperature applications.		
<u>Additional Field Notes</u> 1.	(undefined) System Prime: NA Stripe: NA Intermediate: NA Finish: NA	NA - NA NA - NA NA - NA Total: NA - NA	Surface Area: NA



Disinfection: AWWA C652: Method 2
Owner to take samples and arrange for testing.

250,000 GALLON ELEVATED SPHEROIDAL TANK

PAINTING INSTRUCTIONS

CITY OF FLOWERY BRANCH
FLOWERY BRANCH, GA

Engineer: KI Drawn By: AB Checked By: KI Date: 10/22


Revision Description
Copyright © 2017 by Phoenix Fabricators & Erectors, LLC. All rights reserved.

Avon, Indiana - Sebree, Kentucky

JOB. No.
3907

SHEET
D-01

FOR REFERENCE ONLY

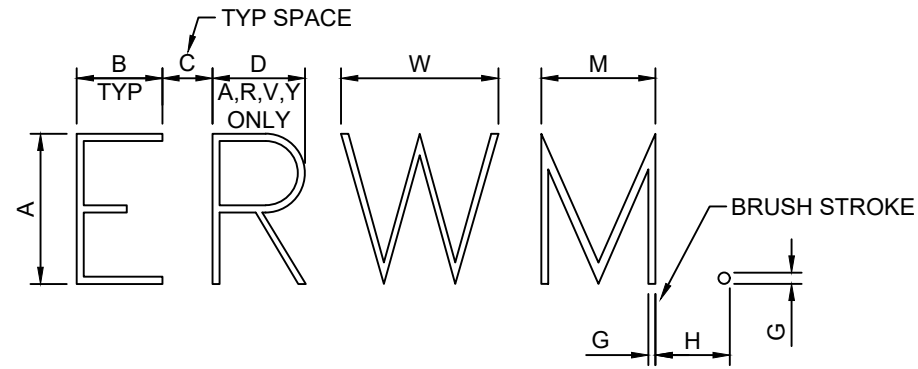

OWNER TO SUPPLY DIGITAL IMAGE.

SIGN TO BE AS SHOWN ABOVE.
PAINTED ON TWO SIDES OF THE
TANK.

SIGN COLOR: BY OWNER
LOCATION: BY ENGINEER

A	B	C	D	W	M	G	H
24"	14"	4"	18"	24"	21"	4"	8"
30"	21"	6"	25"	30"	32"	6"	12"
48"	28"	8"	32"	48"	42"	8"	16"
60"	34"	10"	38"	60"	54"	10"	20"
72"	42"	12"	48"	72"	64"	12"	24"
96"	55"	14"	61"	96"	84"	14"	28"

NOT FOR
FABRICATION

250,000 GALLON ELEVATED SPHEROIDAL TANK

SIGN LAYOUT

CITY OF FLOWERY BRANCH
FLOWERY BRANCH, GA

Engineer: KI Drawn By: AB Checked By: KI Date: 10/22

Rev. No.	Rev. Date	Revision Description
1		
2		
3		
4		







JOB. No.
3907
SHEET
D-02


Copyright © 2017 by Phoenix Fabricators & Erectors, LLC. All rights reserved.

FOR REFERENCE ONLY

FIELD NOTE:
AFTER BURNING HOLE FOR HATCH;
SET HATCH IN PLACE & MAKE SURE
THE HATCH WILL OPEN FULLY
BEFORE WELDING

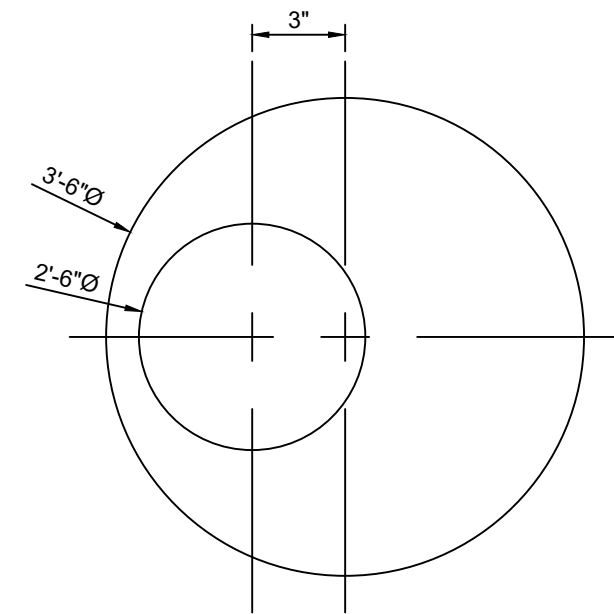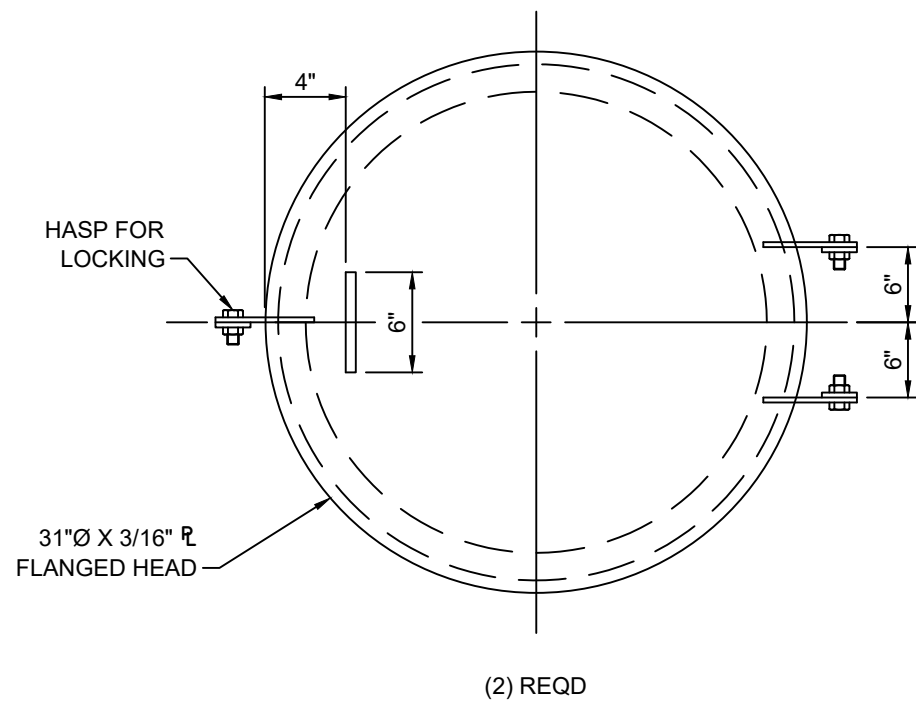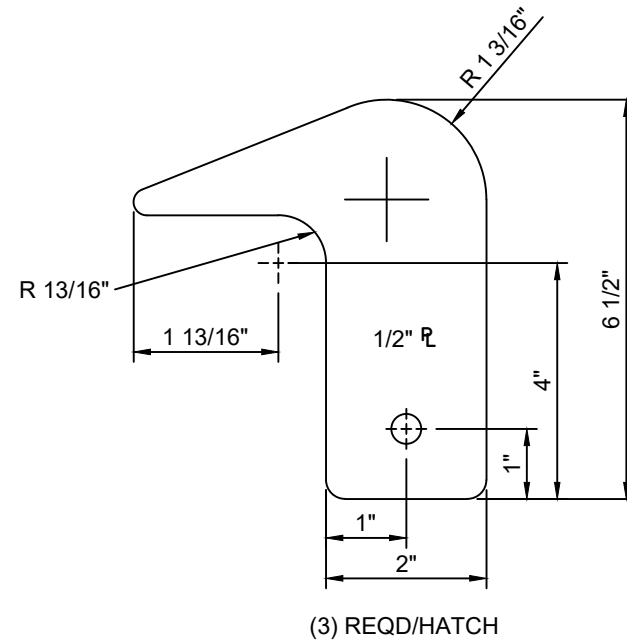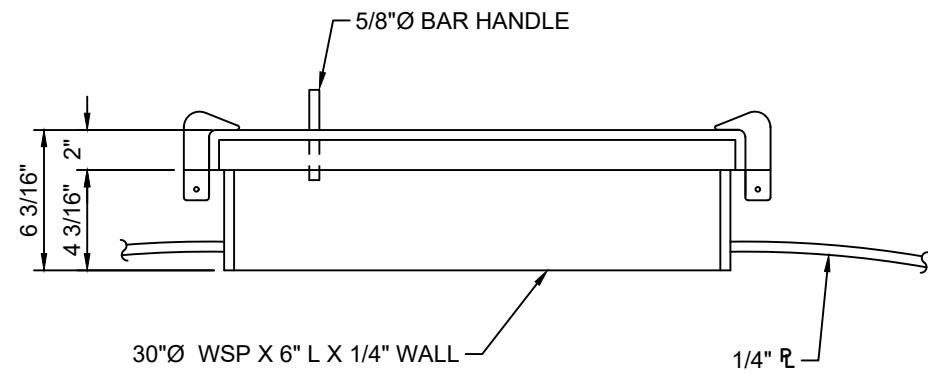

ACCESS TUBE REDUCER
1/2" R
(1) @ 97#
A36 MATERIAL

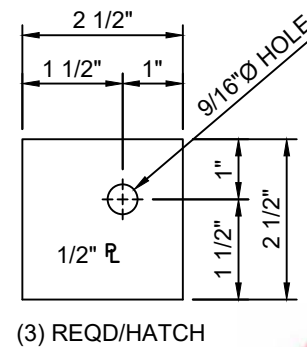

1 ~ MANWAY IN THE TOP OF ACCESS TUBE, FIELD INSTALL W/
HASP & HANDLE INSIDE W/ ACCESS TUBE REDUCING RING
1 ~ MANWAY IN ROOF ~ FIELD INSTALL W/
HASP & HANDLE OUTSIDE

NOT FOR FABRICATION





250,000 GALLON ELEVATED SPHEROIDAL TANK	Revision Description
30"Ø ROOF HATCH	Rev. By
CITY OF FLOWERY BRANCH	Rev. Date
FLOWERY BRANCH, GA	Rev. Description
FLOWERY BRANCH, GA	Rev. Date
Engineer: KI	Rev. Description
Drawn By: AB	Rev. Date
Checked By: KI	Rev. Description
Date: 10/22	Rev. Date
Copyright © 2017 by Phoenix Fabricators & Erectors, LLC. All rights reserved.	



JOB. No.
3907
SHEET
D-04

FOR REFERENCE ONLY

FIELD NOTE:
AFTER BURNING HOLE FOR HATCH;
SET HATCH IN PLACE & MAKE SURE
THE HATCH WILL OPEN FULLY
BEFORE WELDING

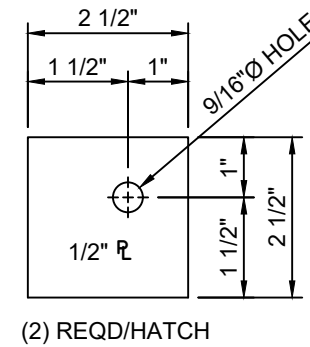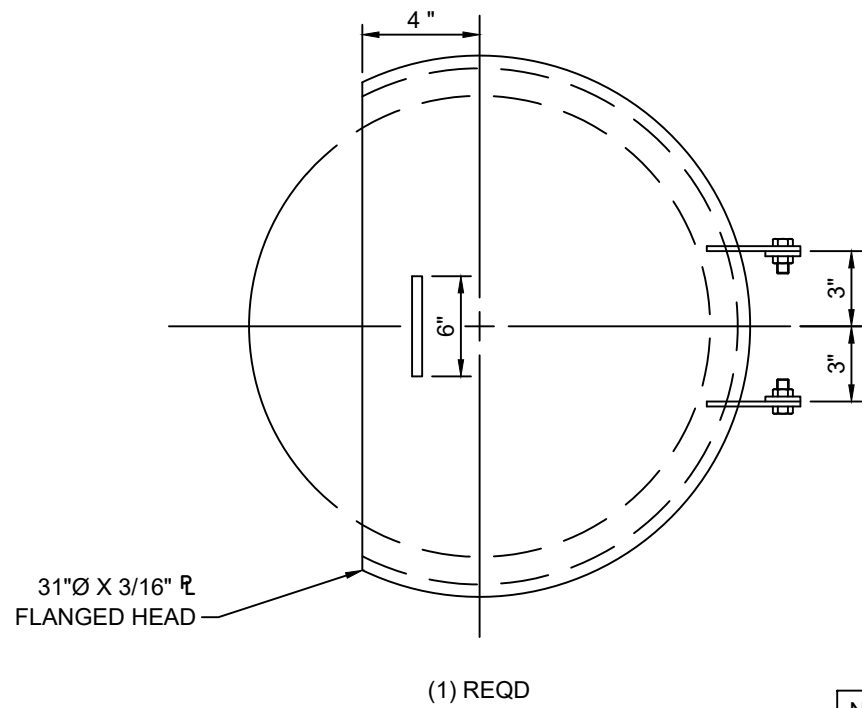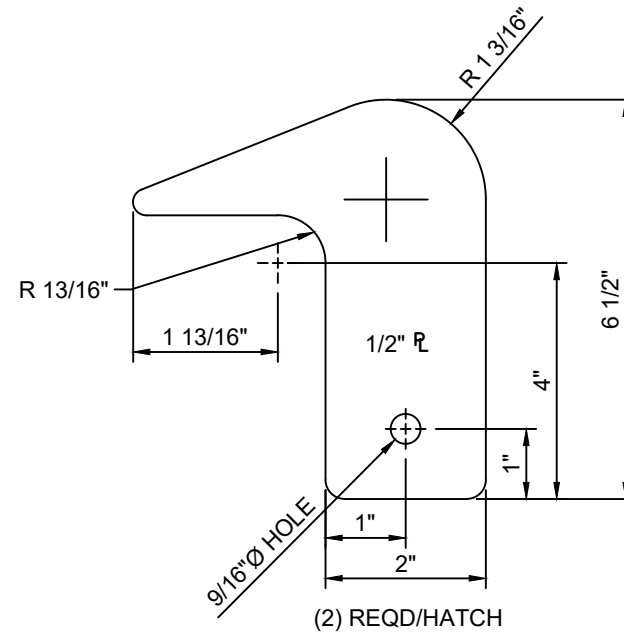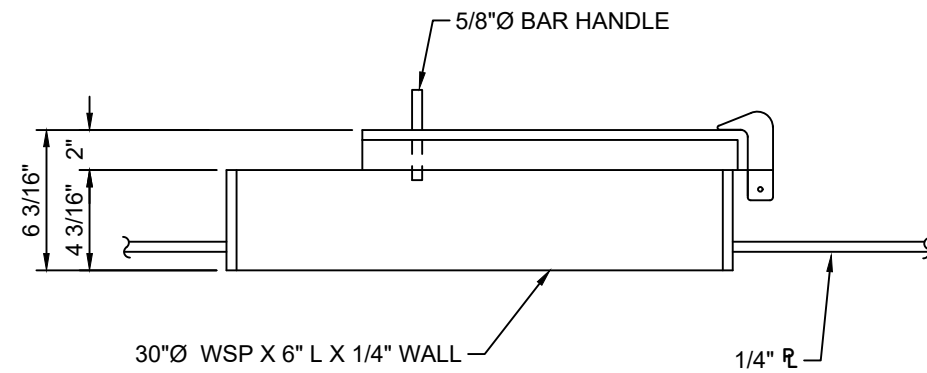

NOTE:
SHOP INSTALL HATCH TO CLEAR
SAFETY SYSTEM WHICH WILL BE
INSTALLED LATER

1 ~ MANWAY IN THE PLATFORM #1
SHOP INSTALL W/ HANDLE INSIDE & OUTSIDE

NOT FOR
FABRICATION

250,000 GALLON ELEVATED SPHEROIDAL TANK

30"Ø HATCH - PLATFORM #1

CITY OF FLOWERY BRANCH
FLOWERY BRANCH, GA

Engineer: KI Drawn By: AB Checked By: KI Date: 10/22

⊕ ⊙ ⊕ ⊕

Rev. By Rev. Date

Revision Description

Copyright © 2017 by Phoenix Fabricators & Erectors, LLC. All rights reserved.





JOB. No.

3907

SHEET

D-05



FOR REFERENCE ONLY

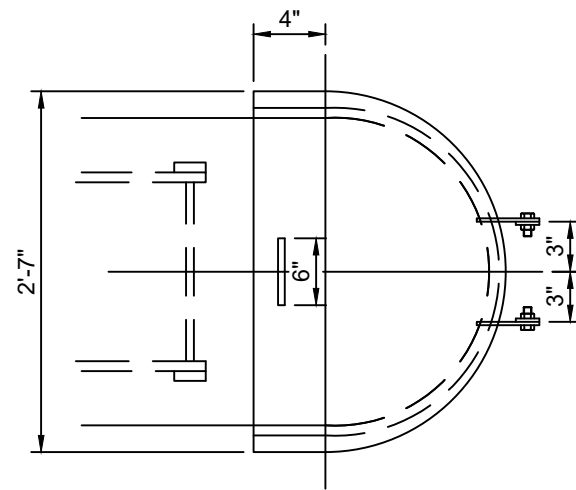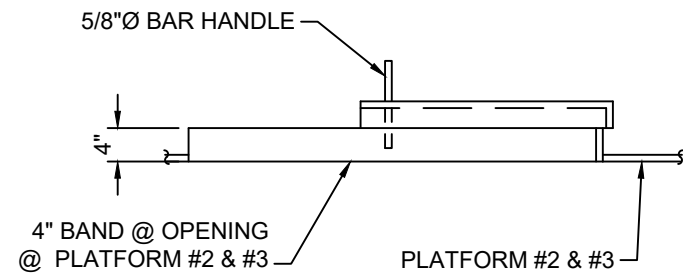

1 REQD

NOTE:
SHOP INSTALL HATCH TO CLEAR SAFETY SYSTEM WHICH WILL BE INSTALLED LATER

1 ~ MANWAY IN THE PLATFORM #2
1 ~ MANWAY IN THE PLATFORM #3
SHOP INSTALL W/ HANDLE INSIDE & OUTSIDE

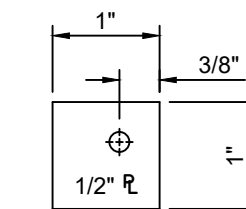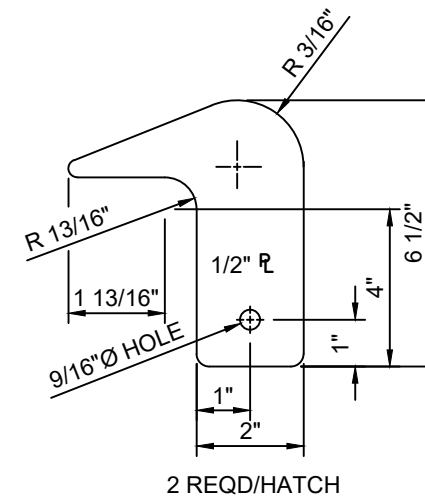

2 REQD/HATCH

NOT FOR FABRICATION

250,000 GALLON ELEVATED SPHEROIDAL TANK

30"Ø HATCH - PLATFORM #2

CITY OF FLOWERY BRANCH
FLOWERY BRANCH, GA

Engineer: KI Drawn By: AB Checked By: KI Date: 10/22



JOB. No.


3907

SHEET

D-06

Revision Description
Rev. By Rev. Date
Copyright © 2017 by Phoenix Fabricators & Erectors, LLC. All rights reserved.

FOR REFERENCE ONLY

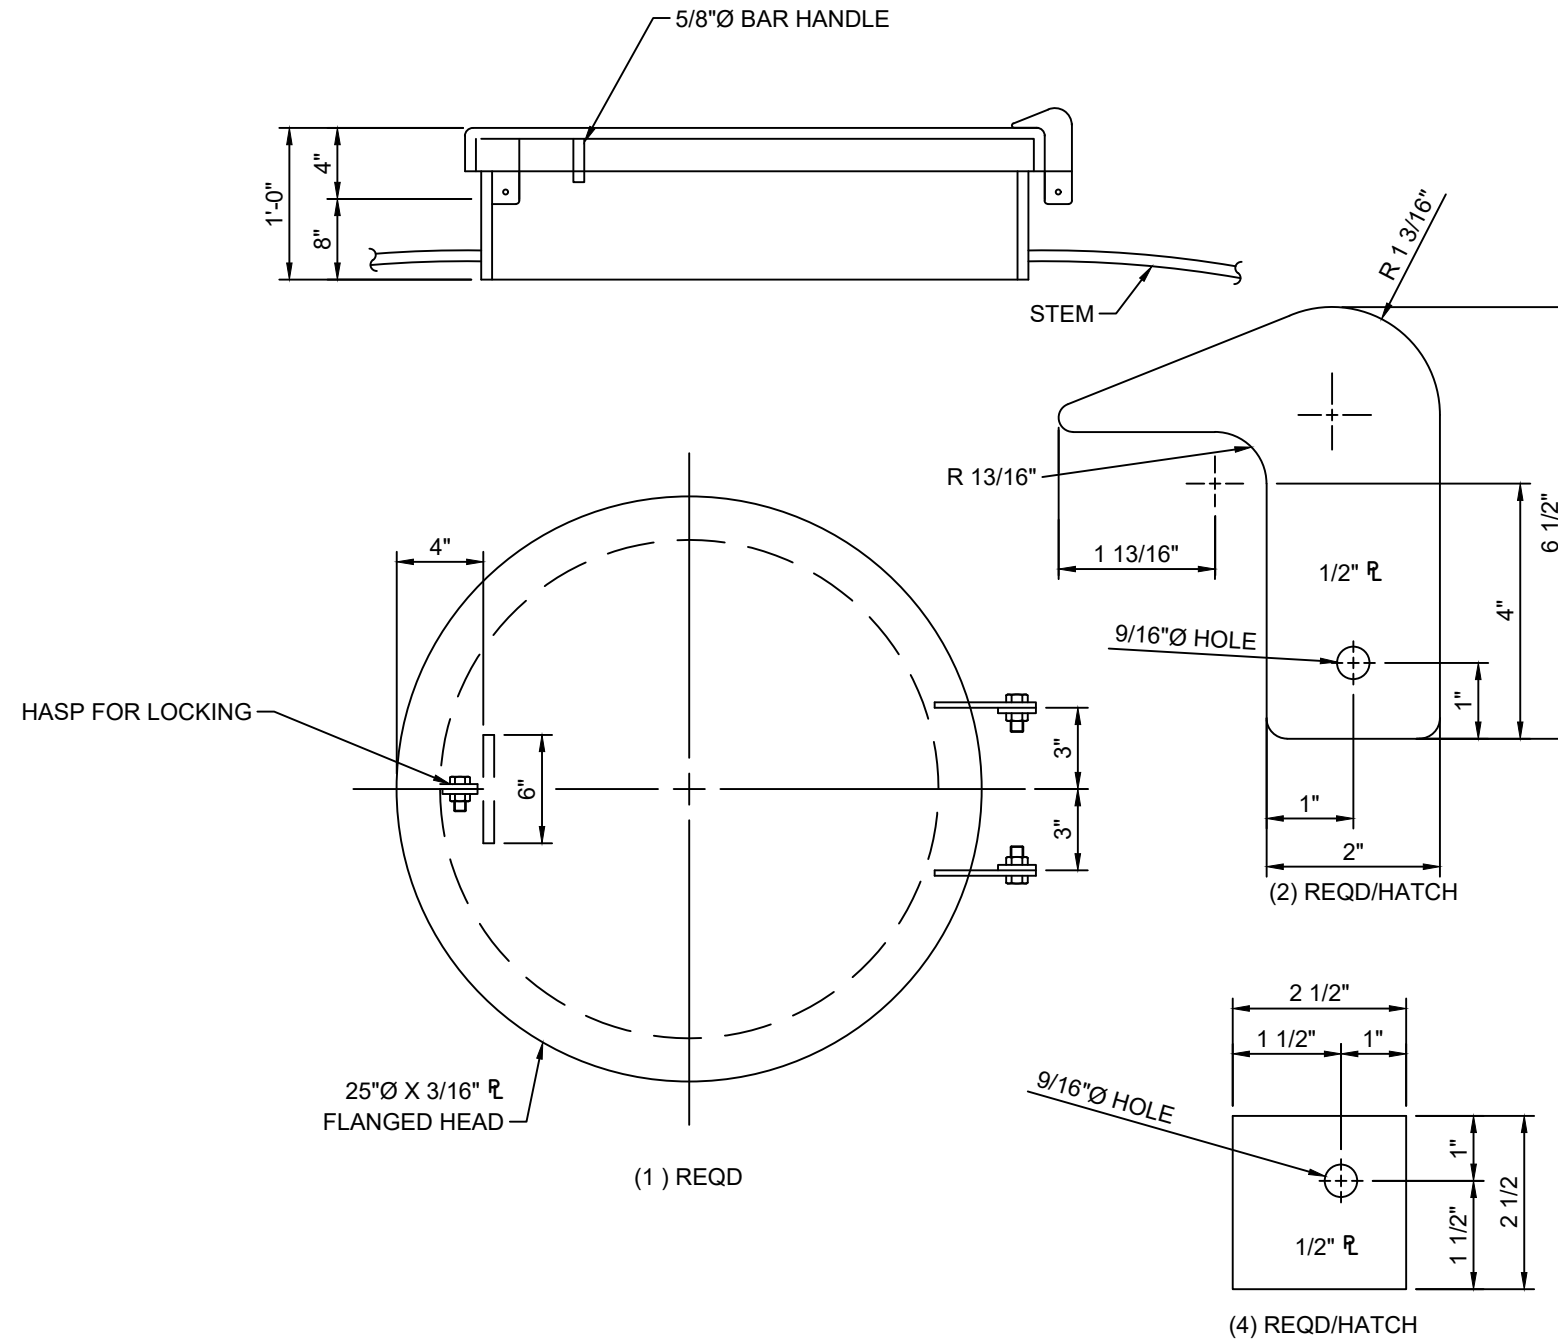

1 ~ MANWAY IN THE TOP STEM SECTION W/ 3/4" THK X 12" LG NECK ~ SHOP INSTALL W/ HASP & HANDLE INSIDE

NOT FOR FABRICATION

250,000 GALLON ELEVATED SPHEROIDAL TANK

24"Ø STEM HATCH

CITY OF FLOWERY BRANCH
FLOWERY BRANCH, GA

Engineer: KI Drawn By: AB Checked By: KI Date: 10/22



Avon, Indiana - Sebree, Kentucky

JOB. No.

3907

SHEET


D-07

Revision Description

Rev. By Rev. Date

Copyright © 2017 by Phoenix Fabricators & Erectors, LLC. All rights reserved.

FOR REFERENCE ONLY

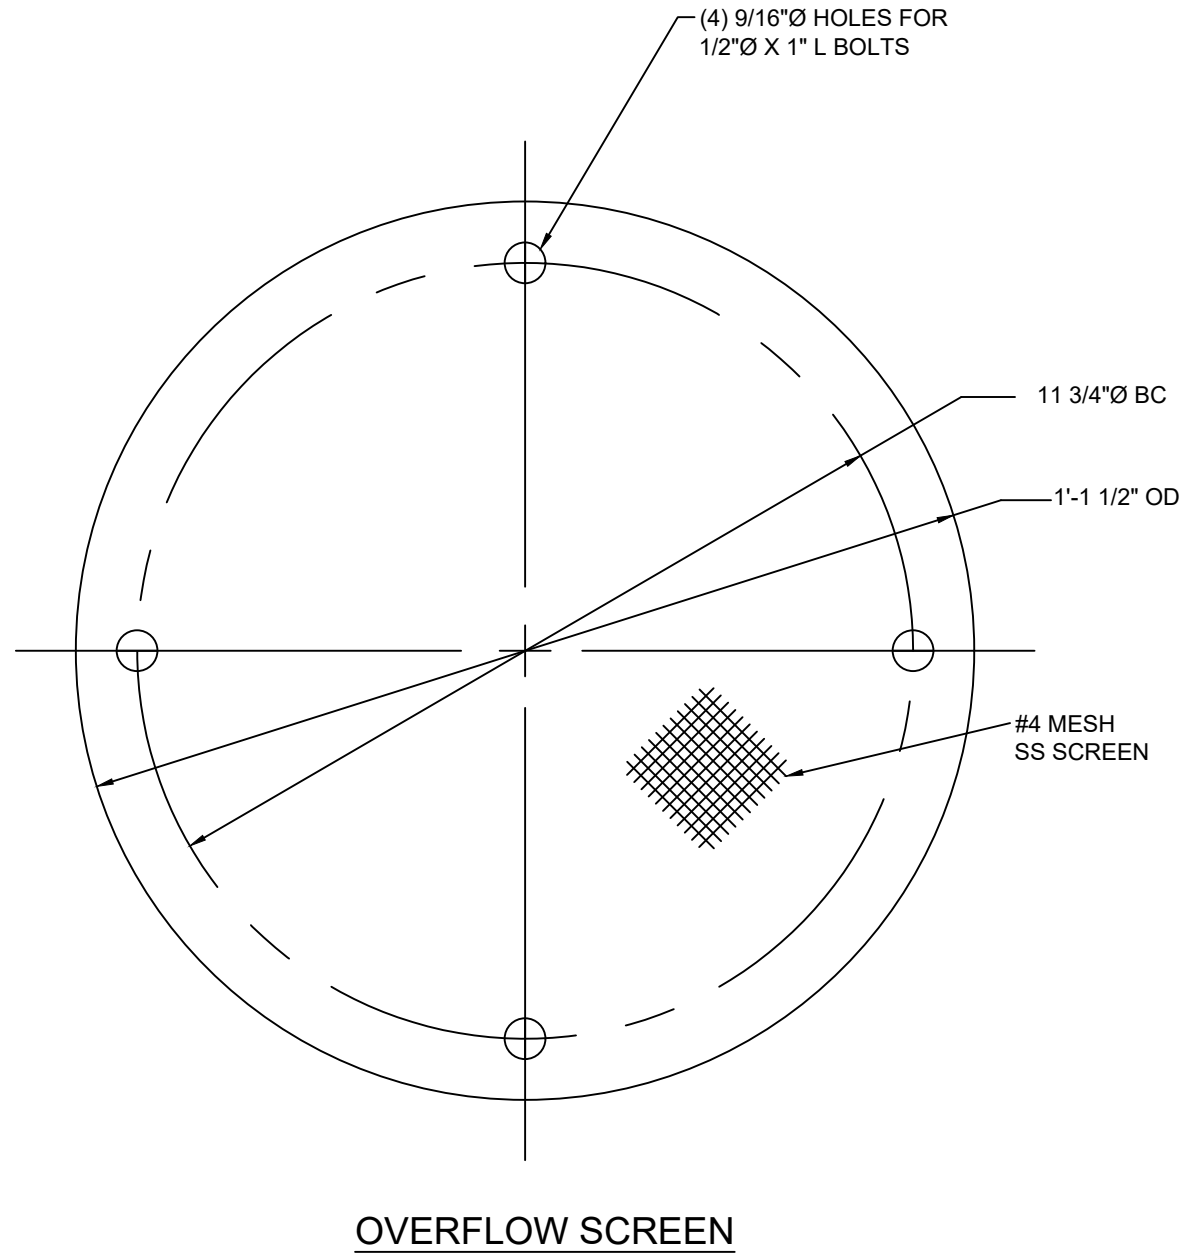

NOT FOR
FABRICATION

250,000 GALLON ELEVATED SPHEROIDAL TANK

OVERFLOW SCREEN

CITY OF FLOWERY BRANCH
FLOWERY BRANCH, GA

Engineer: KI Drawn By: AB Checked By: KI Date: 10/22



JOB. No.


3907

SHEET

D-08

Revision Description
Rev. By Rev. Date
A
Rev. By Rev. Date
A
Copyright © 2017 by Phoenix Fabricators & Erectors, LLC. All rights reserved.


FOR REFERENCE ONLY

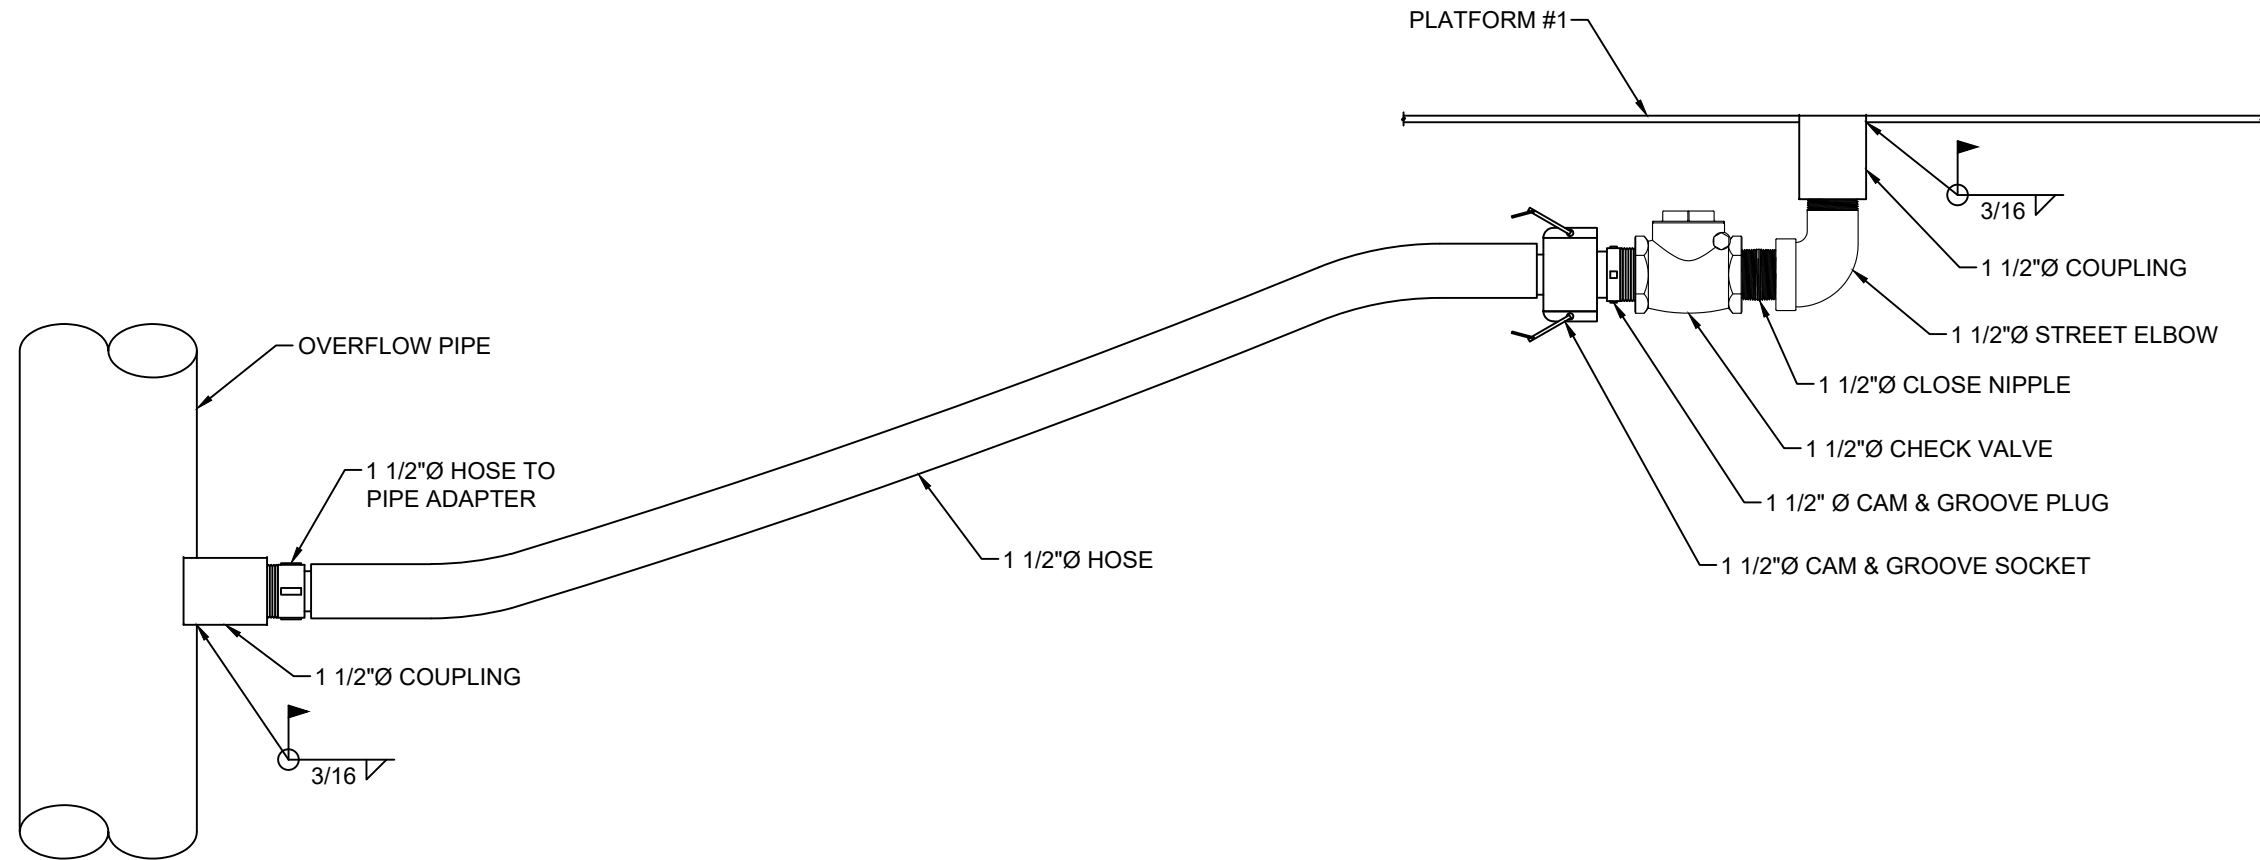

NOTE:
ALWAYS INSTALL HOSE
TO COMPLETELY DRAIN
TO OVERFLOW.


BILL OF MATERIALS	
1~	1 1/2" CHECK VALVE (MCMASTER CARR # 4708K57)
2~	1 1/2"Ø 3000# COUPLING (MCMASTER CARR # 4513K67)
1~	1 1/2"Ø HOSE TO PIPE ADAPTER (MCMASTER CARR # 5218K39)
1~	1 1/2"Ø CLEAR HOSE (MCMASTER CARR # 9118T5)
1~	1 1/2"Ø CAM & GROOVE SOCKET (MCMASTER CARR # 5535K11)
1~	1 1/2"Ø CAM & GROOVE PLUG (MCMASTER CARR # 5535K23)
2~	1 1/2"Ø HOSE CLAMP (MCMASTER CARR # 5443K25)
1~	1 1/2"Ø STREET ELBOW (MCMASTER CARR # 4627K237)
1~	1 1/2"Ø CLOSE NIPPLE (MCMASTER CARR # 4550K262)

NOT FOR
FABRICATION

250,000 GALLON ELEVATED SPHEROIDAL TANK	Rev. Description
PLATFORM DRAIN ASSEMBLY	Rev. By
CITY OF FLOWERY BRANCH	Rev. Date
FLOWERY BRANCH, GA	Rev. Date
Engineer: KI	Checked By: KI
Drawn By: AB	Date: 10/22
 Avon, Indiana - Seabree, Kentucky	
JOB. No.	
3907	
SHEET	
D-09	

Copyright © 2017 by Phoenix Fabricators & Erectors, LLC. All rights reserved.

FOR REFERENCE ONLY

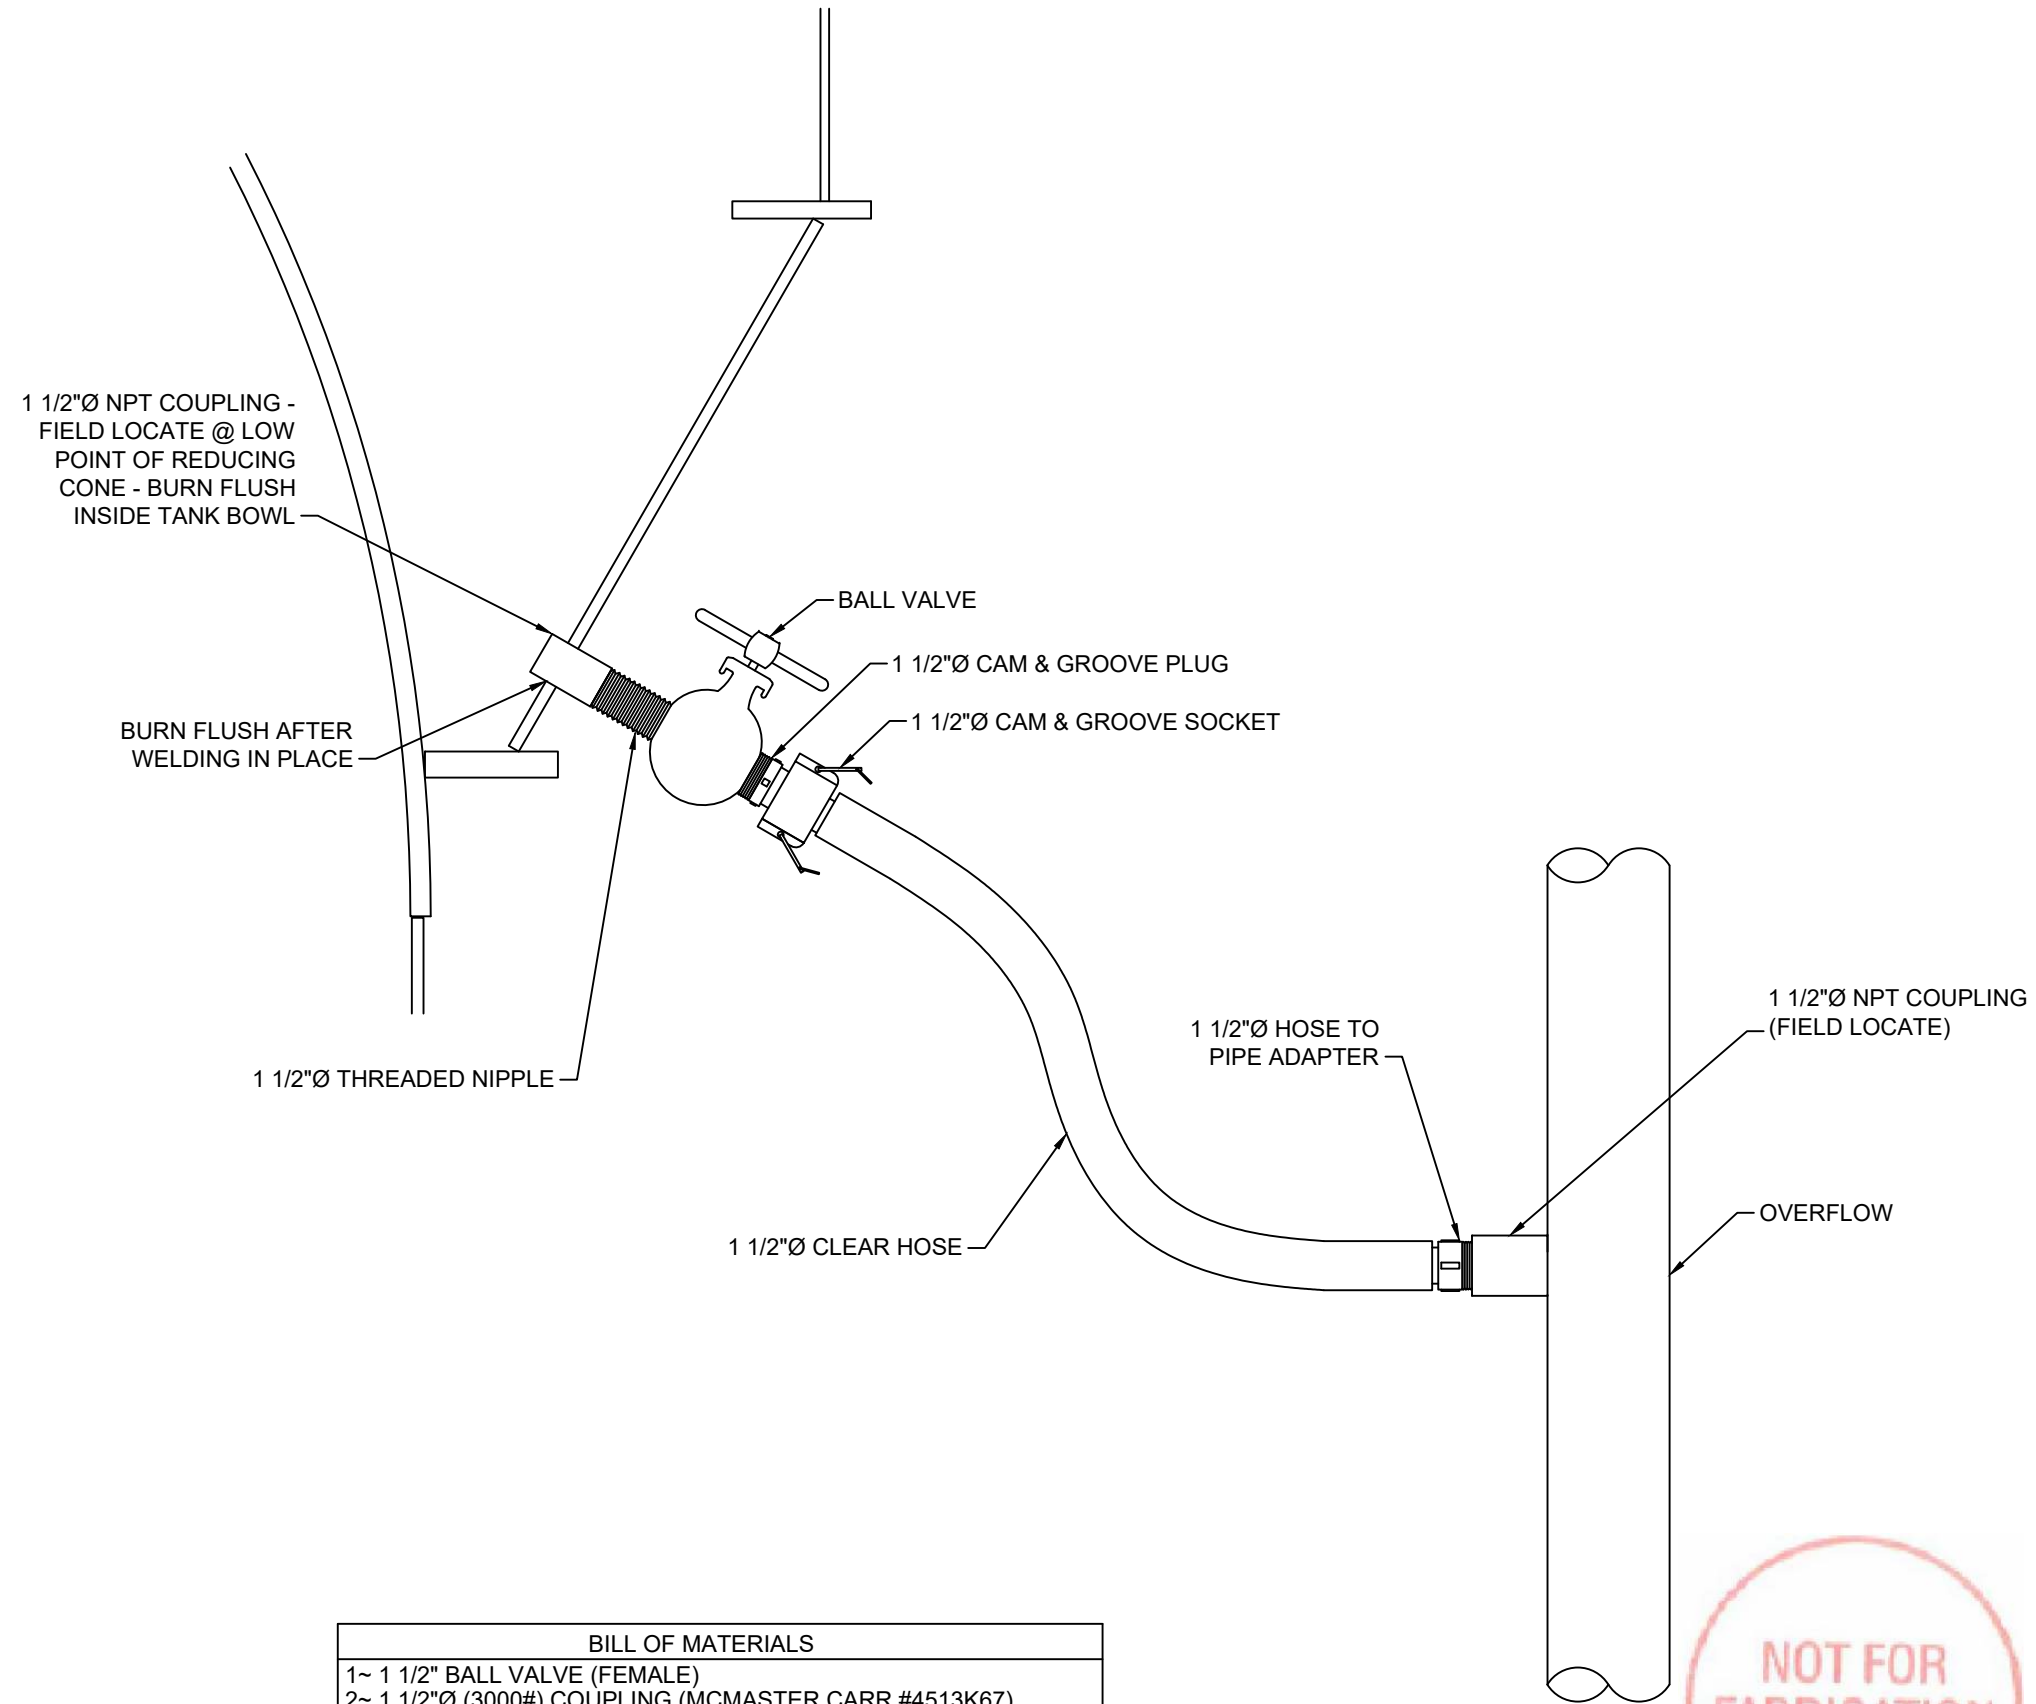

BILL OF MATERIALS	
1~	1 1/2" BALL VALVE (FEMALE)
2~	1 1/2" (3000#) COUPLING (MCMASTER CARR #4513K67)
1~	1 1/2" HOSE TO PIPE ADAPTER (MCMASTER CARR #5218K39)
1~	1 1/2" CLEAR HOSE (MCMASTER CARR #9118T5)
1~	1 1/2" CAM & GROOVE SOCKET (MCMASTER CARR #5535K11)
1~	1 1/2" CAM & GROOVE PLUG (MCMASTER CARR #5535K23)
2~	1 1/2" HOSE CLAMPS (MCMASTER CARR #5443K25)
1~	1 1/2" CLOSE NIPPLE (MCMASTER CARR #4550K262)

NOT FOR FABRICATION

250,000 GALLON ELEVATED SPHEROIDAL TANK		Rev. Description
BOWL DRAIN		Rev. By
CITY OF FLOWERY BRANCH		Rev. Date
FLOWERY BRANCH, GA		Rev. Date
Engineer: KI	Drawn By: AB	Checked By: KI
Date: 10/22	Copyright © 2017 by Phoenix Fabricators & Erectors, LLC. All rights reserved.	



JOB. No.
3907
 SHEET
D-10



THE EUCLID CHEMICAL COMPANY

19218 REDWOOD ROAD • Cleveland, OH 44110
 (216) 531-9222 • (800) 321-7628 • FAX (216) 531-9596
 www.euclidchemical.com

NS GROUT

◆ ◆ ◆ ◆ ◆
NON-SHRINK, NON-STAIN, NON-METALLIC

<p>NSGROUT is designed for critical use where high strength, non-staining characteristics and positive expansion are required. It contains only natural aggregate and an expansive cementitious binder. It is extremely flowable, and when cured, appears similar in appearance to concrete.</p> <p>PRIMARY APPLICATIONS</p> <ul style="list-style-type: none"> • Pumps • Fans • Motors • Compressors • Generators • Machine bases of all types • Anchor bolts • Column baseplates <p>FEATURES/BENEFITS</p> <ul style="list-style-type: none"> • Non-staining natural aggregate for better appearance • Non-shrink performance provides excellent bearing • Flowable and self-leveling • High strength • Appearance of plain concrete • Does not contain any added chloride ions <p>SPECIFICATION/COMPLIANCES</p> <ul style="list-style-type: none"> • Meets the requirements of CRD C-621, Corps of Engineers Specification for Non-Shrink Grout. • Shows positive expansion when tested in accordance with ASTM Specification C-1090, Standard Test Method for Measuring Changes in Height of Cylindrical Specimens from Hydraulic-Cement Grout. • Meets the performance requirements of ASTM C-1107, Grades A & B as well as Grade C, "Standard Specification for Packaged Dry, Hydraulic-Cement Grout (non-shrink)." • Meets ASTM C-827 "Test method for early volume of cementitious mixtures." 	<p>TECHNICAL INFORMATION Typical Engineering Data The following results were developed under laboratory conditions.</p> <p>Flowable Consistency 1.0 gal/50 lb (3.8 liter/22.7 kg) Flow Rate: ASTM C-939 & CRD C-621 120% Flow (flow table)</p> <p>Compressive Strength 2" (50 mm) cubes (ASTM C-109 Modified*)</p> <table border="1"> <thead> <tr> <th>Age</th> <th>Strength</th> </tr> </thead> <tbody> <tr> <td>3 days</td> <td>5,000 psi (34 MPa)</td> </tr> <tr> <td>7 days</td> <td>7,000 psi (48 MPa)</td> </tr> <tr> <td>14 days</td> <td>8,000 psi (55 MPa)</td> </tr> <tr> <td>28 days</td> <td>9,000 psi (62 MPa)</td> </tr> </tbody> </table> <p>*See ASTM C-1107 Section 11.5 & 11.5.1 - 11.5.3</p> <p>Expansion Tested in Accordance with CRD C-621</p> <table border="1"> <thead> <tr> <th>Age</th> <th>Expansion</th> </tr> </thead> <tbody> <tr> <td>3 days</td> <td>.01%</td> </tr> <tr> <td>7 days</td> <td>.06%</td> </tr> <tr> <td>14 days</td> <td>.06%</td> </tr> <tr> <td>28 days</td> <td>.06%</td> </tr> </tbody> </table> <p>Fluid Consistency 1.2 gal/50 lb (4.5 liter/22.7 kg) Flow Rate: ASTM C-939 & CRD C-621 20 to 30 seconds (Flow Cone)</p> <p>Compressive Strength 2" (50 mm) cubes (ASTM C-109)</p> <table border="1"> <thead> <tr> <th>Age</th> <th>Strength</th> </tr> </thead> <tbody> <tr> <td>3 days</td> <td>4,000 psi (28 MPa)</td> </tr> <tr> <td>7 days</td> <td>6,000 psi (41 MPa)</td> </tr> <tr> <td>14 days</td> <td>6,500 psi (45 MPa)</td> </tr> <tr> <td>28 days</td> <td>7,000 psi (48 MPa)</td> </tr> </tbody> </table> <p>Expansion Tested in Accordance with CRD C-621</p> <table border="1"> <thead> <tr> <th>Age</th> <th>Expansion</th> </tr> </thead> <tbody> <tr> <td>3 days</td> <td>.01%</td> </tr> <tr> <td>7 days</td> <td>.06%</td> </tr> <tr> <td>14 days</td> <td>.06%</td> </tr> <tr> <td>28 days</td> <td>.06%</td> </tr> </tbody> </table> <p>Setting Time ASTM C-191</p> <table border="1"> <thead> <tr> <th>Set</th> <th>Time</th> </tr> </thead> <tbody> <tr> <td>Initial Set</td> <td>3 hrs 5 mins.</td> </tr> <tr> <td>Final Set</td> <td>4 hrs 47 mins</td> </tr> </tbody> </table>	Age	Strength	3 days	5,000 psi (34 MPa)	7 days	7,000 psi (48 MPa)	14 days	8,000 psi (55 MPa)	28 days	9,000 psi (62 MPa)	Age	Expansion	3 days	.01%	7 days	.06%	14 days	.06%	28 days	.06%	Age	Strength	3 days	4,000 psi (28 MPa)	7 days	6,000 psi (41 MPa)	14 days	6,500 psi (45 MPa)	28 days	7,000 psi (48 MPa)	Age	Expansion	3 days	.01%	7 days	.06%	14 days	.06%	28 days	.06%	Set	Time	Initial Set	3 hrs 5 mins.	Final Set	4 hrs 47 mins
Age	Strength																																														
3 days	5,000 psi (34 MPa)																																														
7 days	7,000 psi (48 MPa)																																														
14 days	8,000 psi (55 MPa)																																														
28 days	9,000 psi (62 MPa)																																														
Age	Expansion																																														
3 days	.01%																																														
7 days	.06%																																														
14 days	.06%																																														
28 days	.06%																																														
Age	Strength																																														
3 days	4,000 psi (28 MPa)																																														
7 days	6,000 psi (41 MPa)																																														
14 days	6,500 psi (45 MPa)																																														
28 days	7,000 psi (48 MPa)																																														
Age	Expansion																																														
3 days	.01%																																														
7 days	.06%																																														
14 days	.06%																																														
28 days	.06%																																														
Set	Time																																														
Initial Set	3 hrs 5 mins.																																														
Final Set	4 hrs 47 mins																																														

GROUT QUANTITY IS BASED ON AN ASSUMED GROUT THICKNESS OF ONE INCH. IF FOUNDATION IS NOT LEVEL OR ADDITIONAL SHIMMING IS REQUIRED, CONTACT THE OFFICE SO THAT ADDITIONAL GROUT MAY BE SHIPPED TO JOB SITE.

1. DAMPEN TOP OF FOUNDATION WITH WATER BEFORE MIXING GROUT.
2. ADD ONE GALLON OF CLEAN WATER PER 50 LBS CONTAINER OF GROUT. DO NOT ADD ADDITIONAL WATER. CAUTION MIX ONLY THE AMOUNT OF GROUT THAT CAN BE USED IN ABOUT ONE-HALF HOUR AS THE GROUT SETS RAPIDLY.
3. THE GROUT MIXTURE SHOULD BE FORCED UNDER THE BASE PLATE WITH A ROD OR FLAT BAR TO ASSURE COMPLETE FILLING UNDER THE BASE PLATE.

GROUT FOR: 250,000 GALLON SPHEROID
 QUANTITY OF 50 LBS BAGS = 22



250,000 GALLON ELEVATED SPHEROIDAL TANK

GROUTING PROCEDURE

CITY OF FLOWERY BRANCH
 FLOWERY BRANCH, GA

Engineer: KI | Drawn By: AB | Checked By: KI | Date: 10/22



JOB. No.


3907

SHEET

D-11

Revision Description
 Rev. By Rev. Date
 Copyright © 2017 by Phoenix Fabricators & Erectors, LLC. All rights reserved.


FOR REFERENCE ONLY

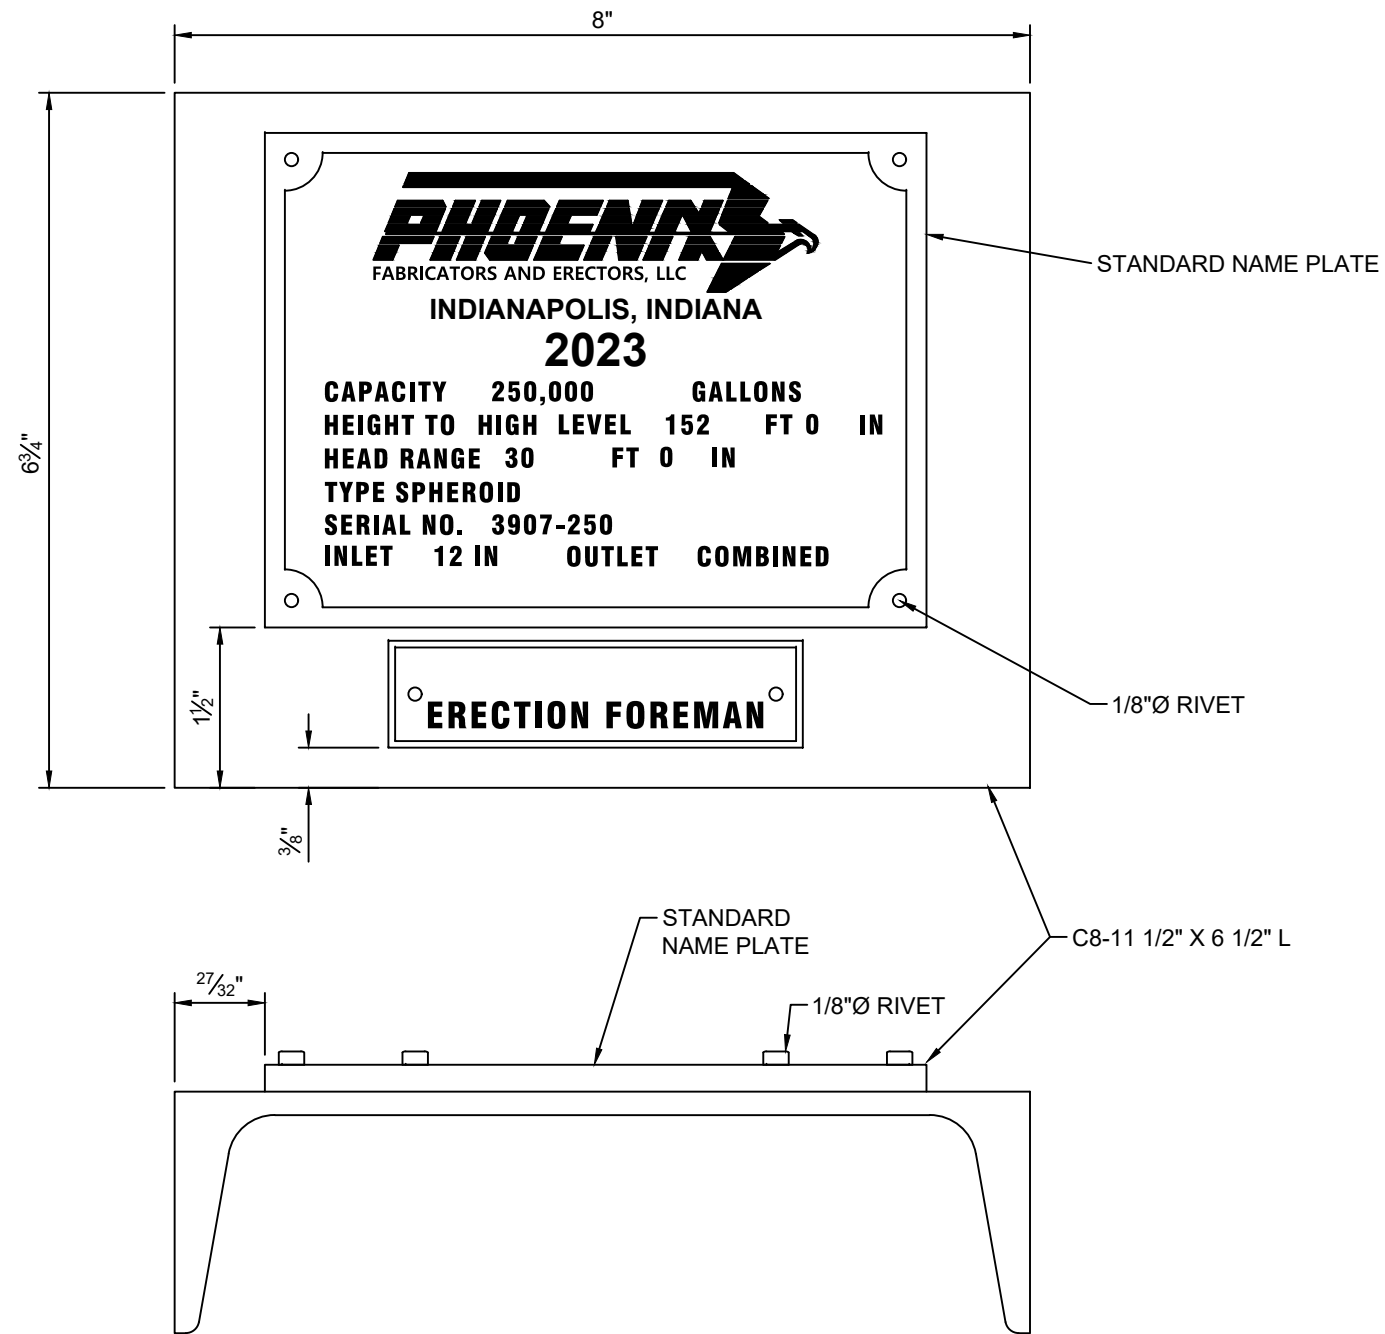

NOTE:
NAME PLATE SHALL BE SHOP INSTALLED
ON TANK MAN DOOR.


NAME PLATE

NOT FOR
FABRICATION

250,000 GALLON ELEVATED SPHEROIDAL TANK		Rev. Description
NAME PLATE		Rev. By
CITY OF FLOWERY BRANCH		Rev. Date
FLOWERY BRANCH, GA		Rev. Date
Engineer: KI	Drawn By: AB	Checked By: KI
	Date: 10/22	
 Avon, Indiana - Sebree, Kentucky		
JOB. No.		
3907		
SHEET		
D-12		

Copyright © 2017 by Phoenix Fabricators & Erectors, LLC. All rights reserved.

(1) CLIP ON ACCESS TUBE ABOVE ROOF (VERTICAL)
 (4) 2"Ø COUPLING [THRU SIDE OF ACCESS TUBE]

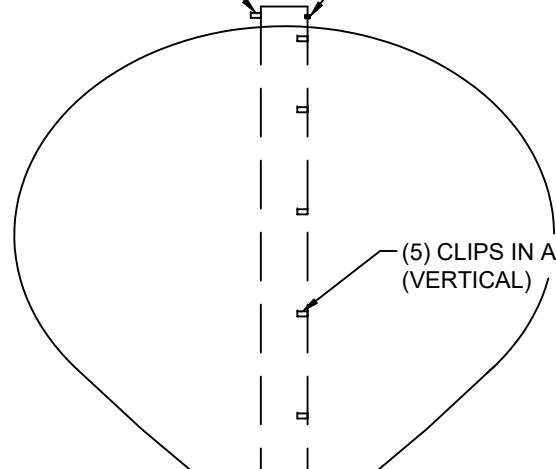

(5) CLIPS IN ACCESS TUBE (VERTICAL)

(1) CLIP ABOVE PLATFORM #3 (VERTICAL)

(1) CLIP BELOW PLATFORM #3 (VERTICAL)

(7) CLIPS IN STEM (VERTICAL)

(1) CLIP ABOVE PLATFORM #1 (VERTICAL)

(4) CLIPS @ ROUND SEAMS (VERTICAL)

(1) 2"Ø COUPLING [LOCATE 6" ABOVE DOOR]


(8) CLIPS 8'-0" ABOVE TOC (HORIZONTAL)

(1) CLIP ON TOP OF DOOR (VERTICAL)

ELECTRICAL BRACKET
 (4) CLIPS 4'-0" ABOVE TOC (VERTICAL)
 (4) 2"Ø CONDUITS [THRU FOUNDATION]



NOTE: BASE CONE BRACKETS TO BE ALIGNED WITH FOUNDATION CONDUIT. STEM AND ACCESS TUBE TO BE ALIGNED WITH PLATFORM PENETRATIONS.

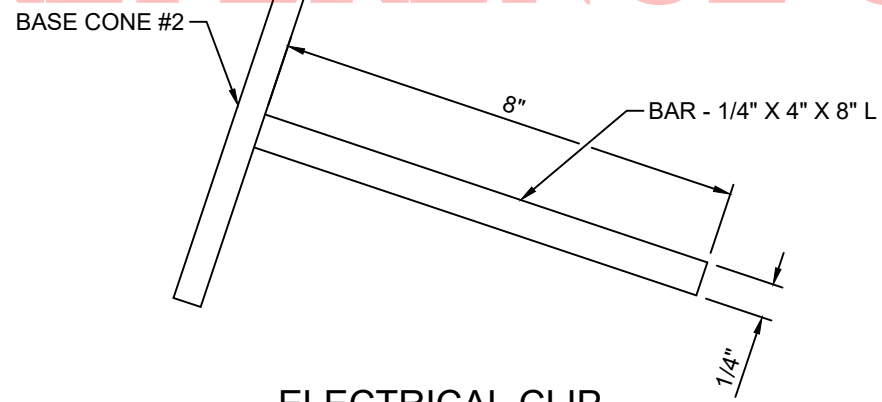


ELECTRICAL CLIP

(34) REQD


ELECTRICAL CLIP LOCATION NOTE: FIELD INSTALL

- (4) CLIPS @ 4'-0" FROM TOC SPACED 90° APART ~ TURNED VERTICALLY
- (1) CLIP @ 4'-0" FROM TOC LOCATED BY DOOR ~ TURNED VERTICALLY
- (1) CLIP @ 4'-0" FROM TOC LOCATED BY LADDER ~ TURNED VERTICALLY
- (8) CLIPS @ 8'-0" FROM TOC SPACED @ ±8'-0" APART ~ TURNED HORIZONTALLY
- (1) CLIP @ EACH HORIZONTAL ROUND SEAM IN BASE CONE STARTING AT TOP OF BASE CONE #2, ALIGNED WITH CONDUIT SLEEVE IN PLATFORM #1 ~ TURNED VERTICALLY (4 TOTAL)
- (1) CLIP @ ±6'-0" ABOVE PLATFORM #1
- (7) CLIPS SPACED @ ±10'-0" C/C ABOVE PLATFORM #1 ~ TURNED VERTICALLY
- (1) CLIP @ ±2'-0" BELOW PLATFORM #3
- (1) CLIP @ 5'-0" ABOVE PLATFORM #3 ~ TURNED VERTICALLY
- (5) CLIPS SPACES @ ±10'-0" C/C IN ACCESS TUBE ~ TURNED VERTICALLY
- (1) CLIP ON OUTSIDE OF ACCESS TUBE ~ TURNED VERTICALLY

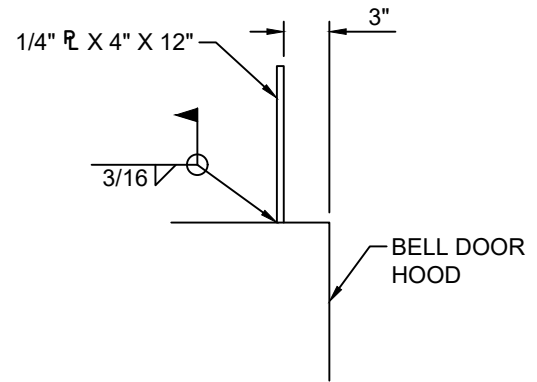


EXTERIOR LIGHT BRACKET

(1) REQD

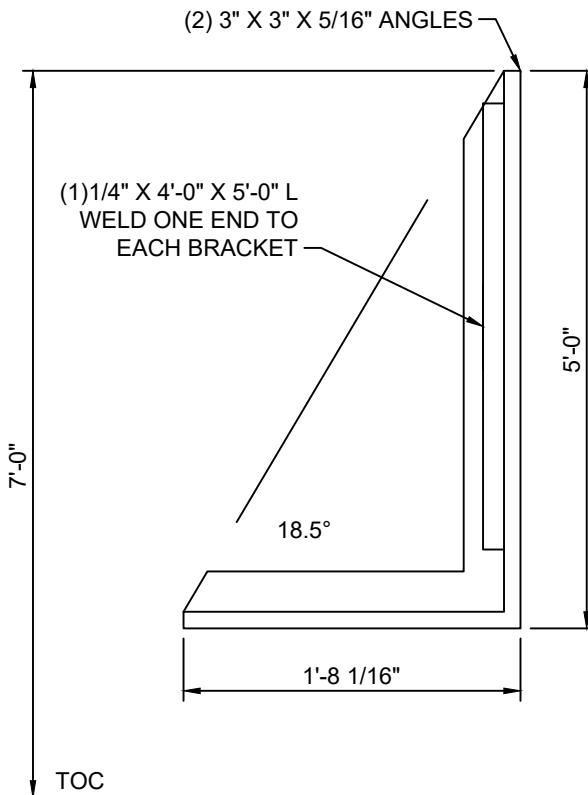

ELECTRICAL BRACKET

(2) ASSEMBLY REQD (FIELD TRIM END FOR SQUARE FIT)
 (1) BRACKET AS SHOWN
 (1) BRACKET OPP HAND

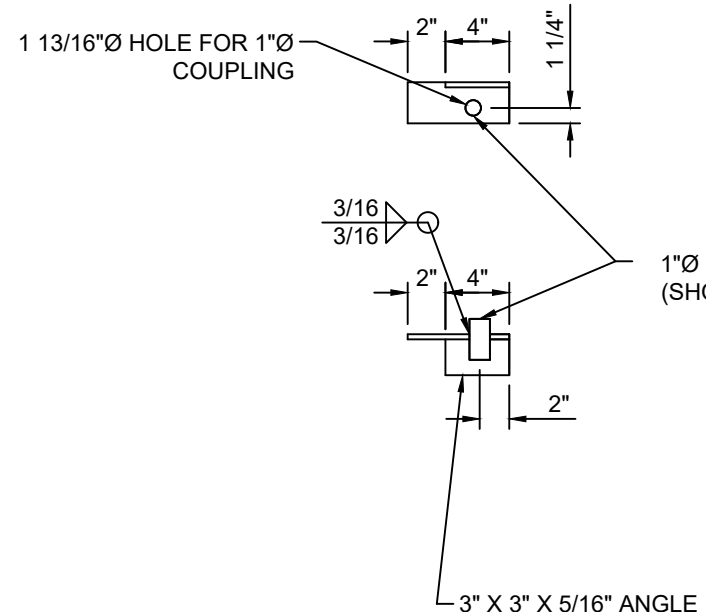

OBSTRUCTION LIGHT BRACKET

(4) REQD

NOT FOR FABRICATION

INSTALLED BY FIELD CREW ON THE ROOF HANDRAIL

250,000 GALLON ELEVATED SPHEROIDAL TANK

ELECTRICAL BRACKETS

CITY OF FLOWERY BRANCH
FLOWERY BRANCH, GA

Engineer: KI Drawn By: AB Checked By: KI Date: 10/22





JOB. No.

3907

SHEET

D-13

FOR REFERENCE ONLY

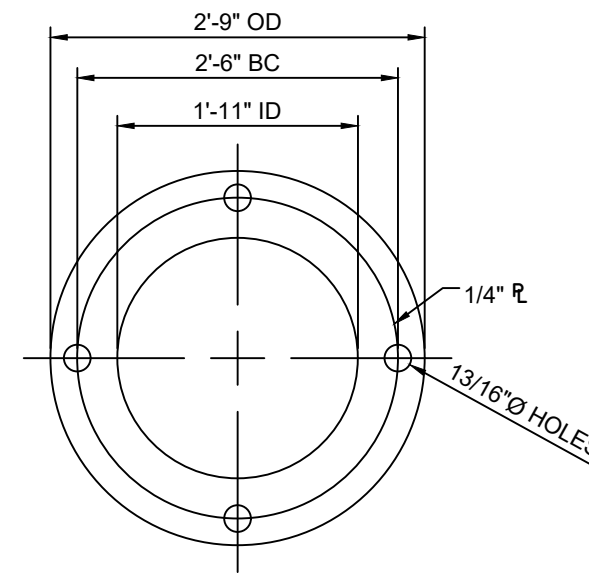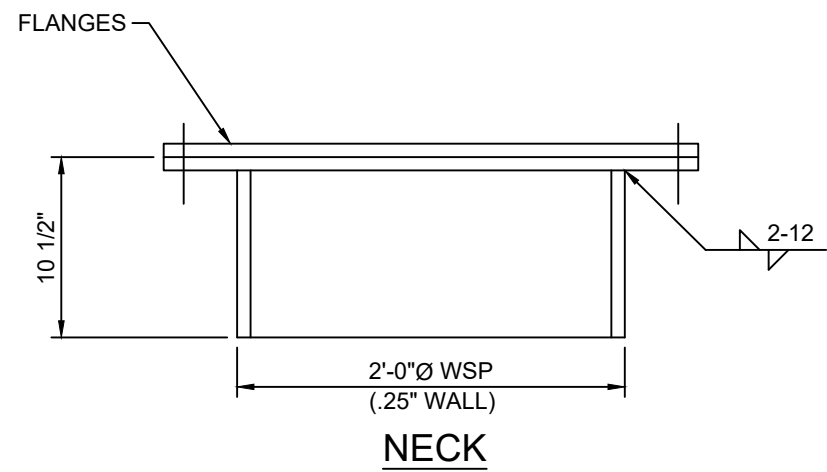

FLANGE
2-REQD (ONE WITH NO HOLE IN CENTER)
(FURNISHED 4 - 3/4"Ø X 1 1/2" L
BOLTS W/ NUTS)

NOT FOR
FABRICATION

250,000 GALLON ELEVATED SPHEROIDAL TANK	Rev. By	Rev. Date	Revision Description
ROOF FLANGE			
CITY OF FLOWERY BRANCH			
FLOWERY BRANCH, GA			
Engineer: KI	Drawn By: AB	Checked By: KI	Date: 10/22





JOB. No.
3907
SHEET
D-14


Copyright © 2017 by Phoenix Fabricators & Erectors, LLC. All rights reserved.

FOR REFERENCE ONLY


ALUM ANGLE 2" X 2" X 3/16" X 100'-0" L
ROLLED TO IR 17'-6"
SHIP IN 5 SECTIONS

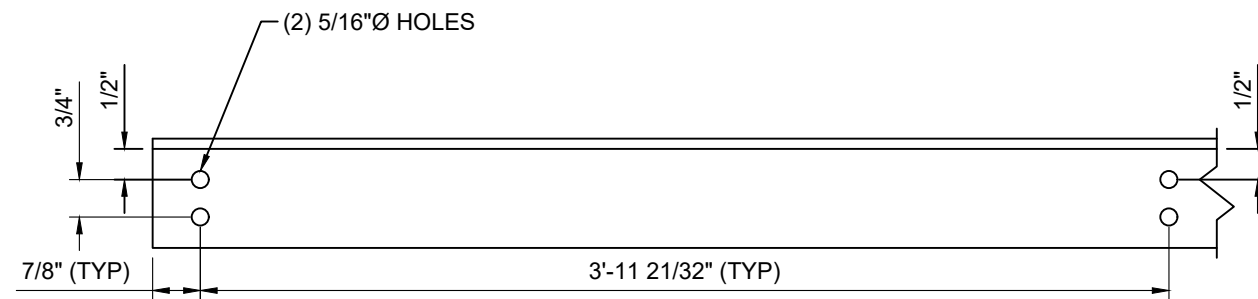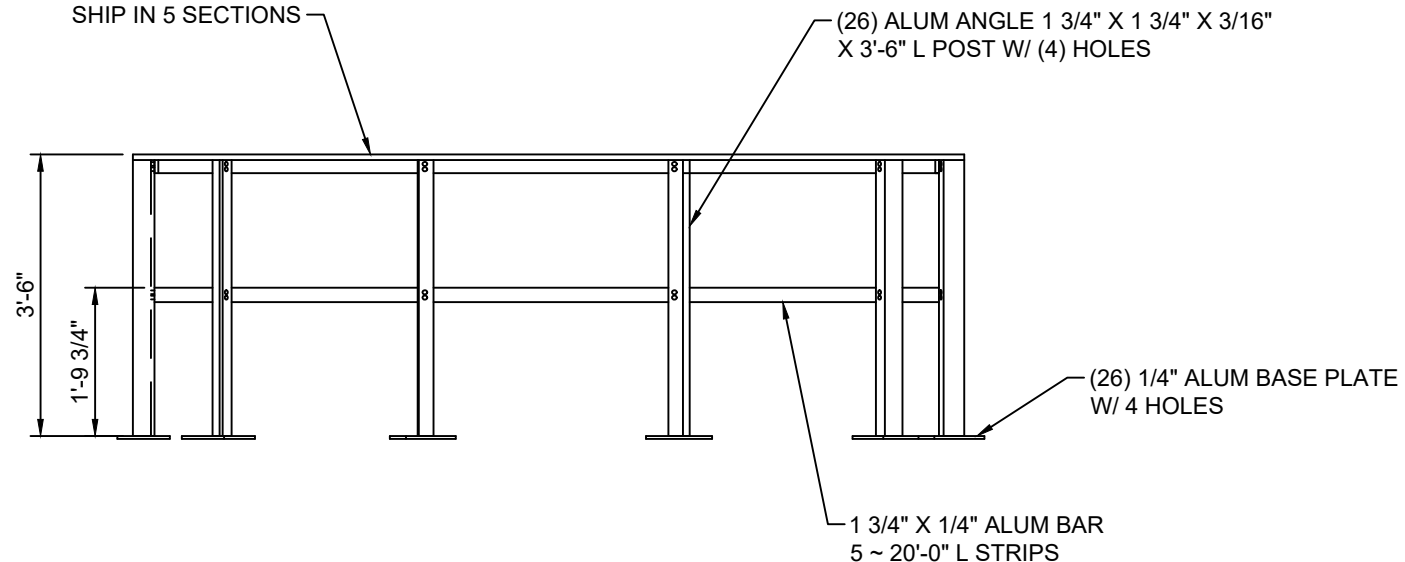

BOLT HOLE DETAIL

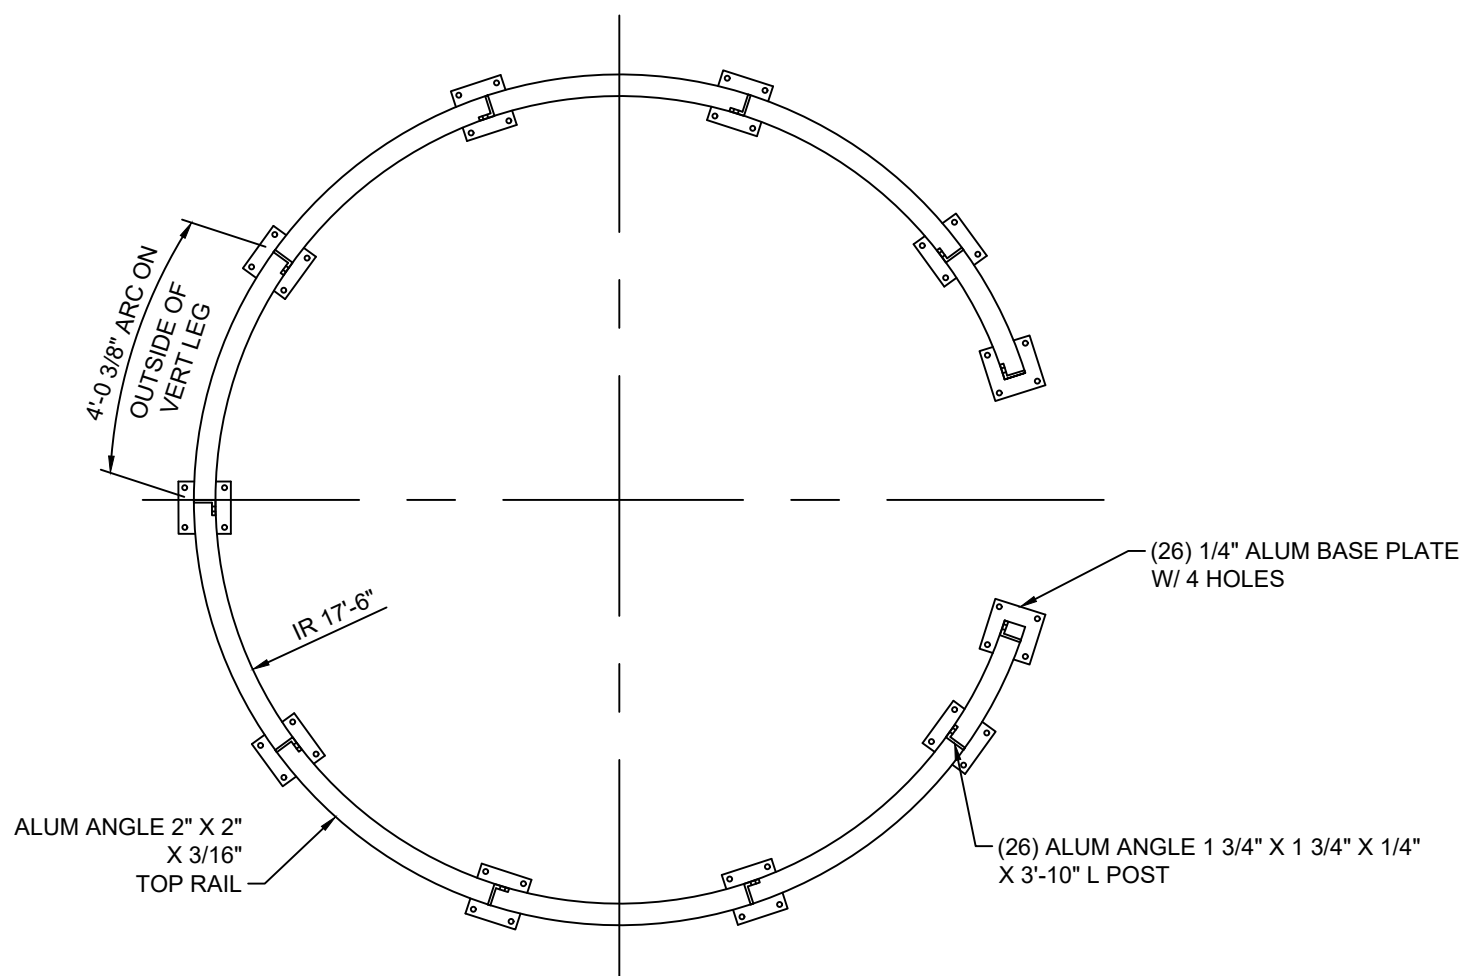

PLAN VIEW

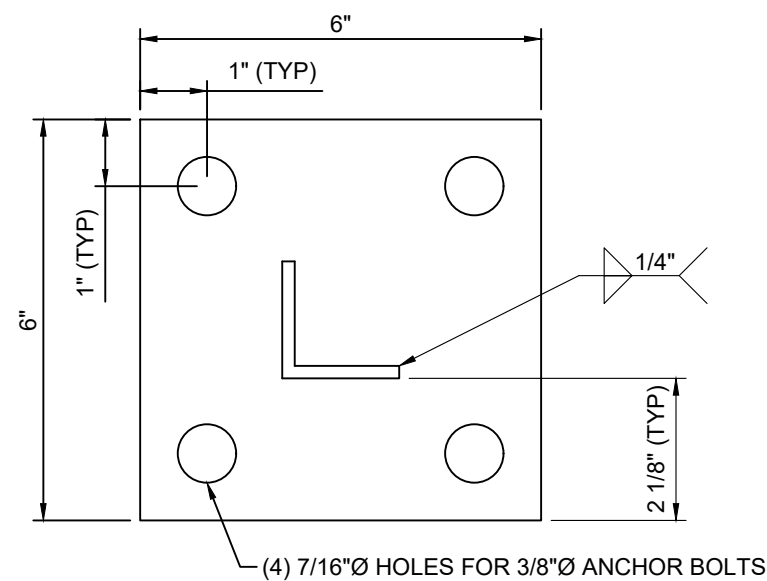

FLANGE

(26) REQUIRED
1/4" ALUM \square

NOTE:
FIT UP IN SHOP
PRIOR TO SHIPPING

NOTE:
HANDRAIL TO BE INSTALLED
AFTER PAINTING IS COMPLETE

NOT FOR
FABRICATION

250,000 GALLON ELEVATED SPHEROIDAL TANK

BASE CONE HANDRAIL

CITY OF FLOWERY BRANCH
FLOWERY BRANCH, GA

Engineer: KI Drawn By: AB Checked By: KI Date: 10/22

Rev. By Rev. Date Revision Description

Copyright © 2017 by Phoenix Fabricators & Erectors, LLC. All rights reserved.




JOB. No.
3907
SHEET
D-15

FOR REFERENCE ONLY

ANGLE 2" X 2" X 3/16" X 47'-2" L
ROLLED TO IR 7'-6"
SHIP IN QUARTERS


ANGLE 1 3/4" X 1 3/4" X 3/16"
X 3'-6" L POST
NOTE: VERTICAL POSTS TO BE TRIMMED AS NECESSARY TO MAINTAIN
LEVEL AND 42" ± 3" FROM WALKING SURFACE

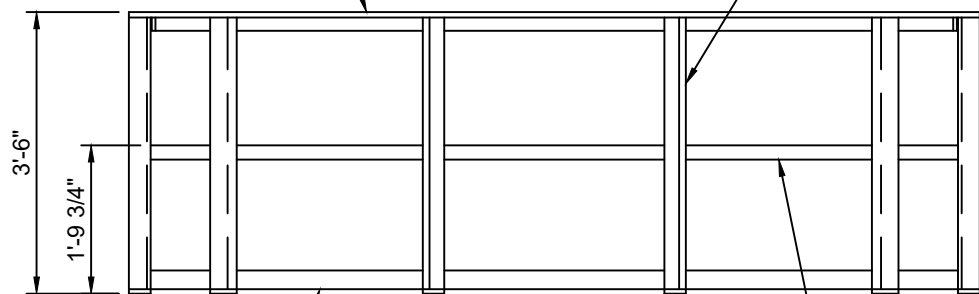

4" X 1/4" BAR X 47'-2" L
ROLLED TO IR 7'-6"
(SHIP IN QUARTERS)
(LOCATE 1/2" ABOVE ROOF
FOR DRAINAGE)

1 1/2" X 1/4" BAR
2 ~ 23'-7" L STRIPS

NOTE: TOE RAIL TO BE SHIPPED LOOSE. TOE RAIL TO BE AFTER
VERTICAL POSTS HAVE BEEN SET AND PLUMBED AND SHOULD
MAINTAIN 1/4" GAP AT ALL LOCATIONS.

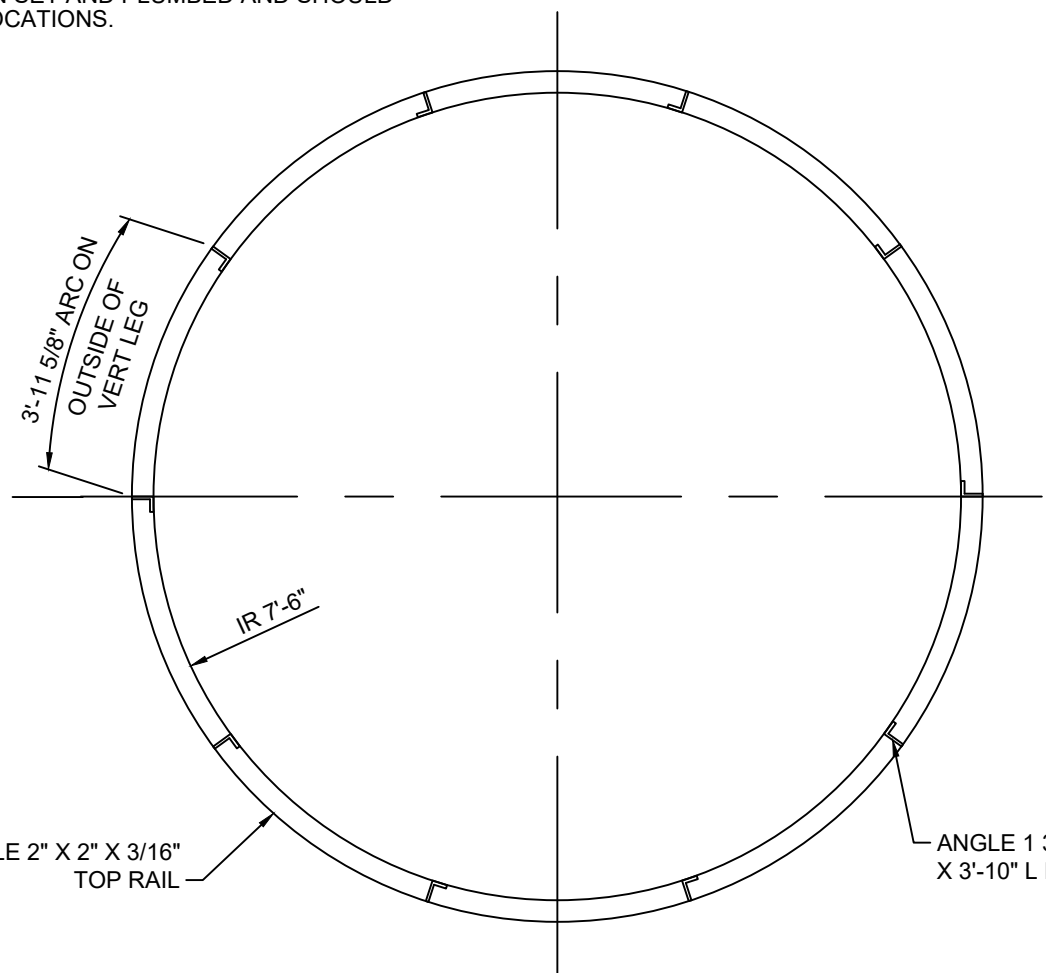

ANGLE 2" X 2" X 3/16"
TOP RAIL

ANGLE 1 3/4" X 1 3/4" X 1/4"
X 3'-10" L POST

PLAN VIEW



250,000 GALLON ELEVATED SPHEROIDAL TANK

ROOF HANDRAIL

CITY OF FLOWERY BRANCH
FLOWERY BRANCH, GA

Engineer: KI Drawn By: AB Checked By: KI Date: 10/22

Ⓢ Ⓣ Ⓟ Ⓠ

Rev. By Rev. Date

Revision Description
Copyright © 2017 by Phoenix Fabricators & Erectors, LLC. All rights reserved.





JOB. No.

3907

SHEET

D-16

FOR REFERENCE ONLY

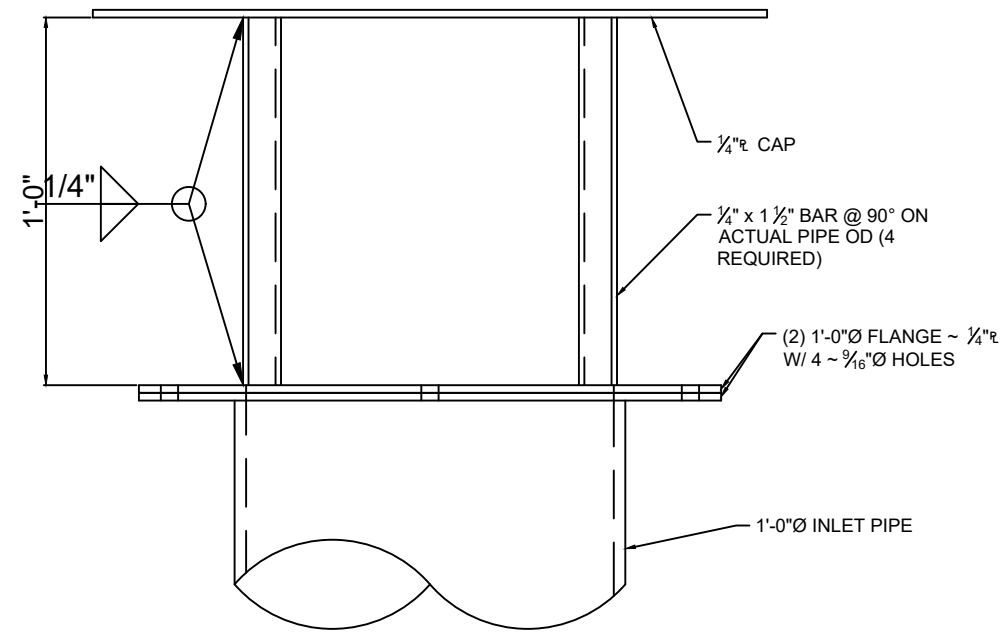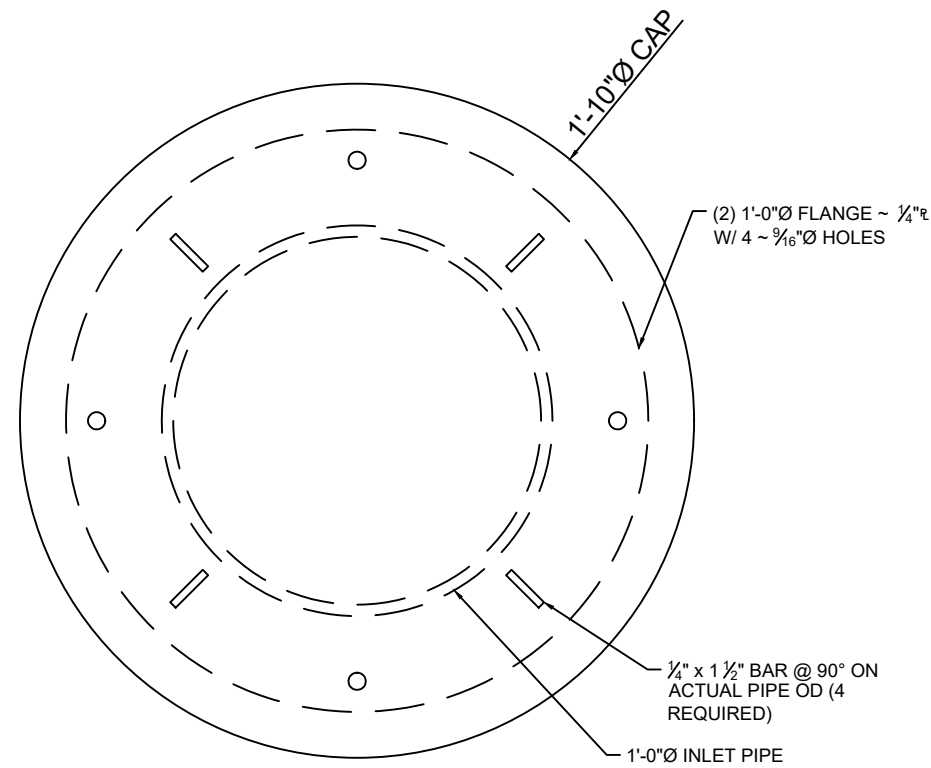

NOT FOR
FABRICATION

250,000 GALLON ELEVATED SPHEROIDAL TANK

PROTECTIVE DISCHARGE CAP

CITY OF FLOWERY BRANCH

FLOWERY BRANCH, GA

Engineer: KI Drawn By: AB Checked By: KI Date: 10/22



JOB. No.

3907

SHEET

D-18

Revision Description

Rev. By Rev. Date

Copyright © 2017 by Phoenix Fabricators & Erectors, LLC. All rights reserved.