



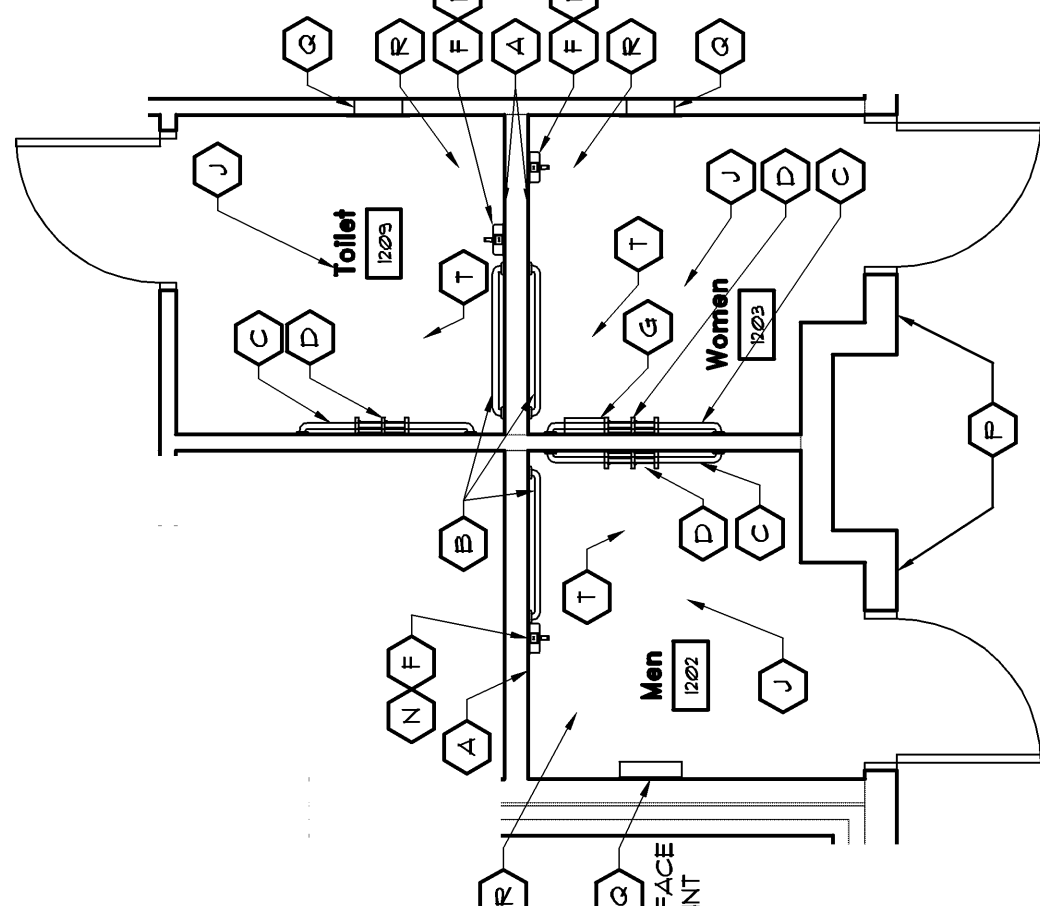


1 Enlarged Restroom Plan

SCALE 1/4" = 1'-0"

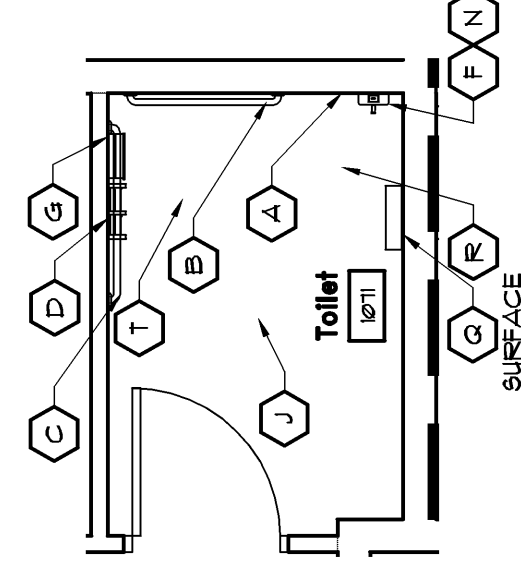


2 Enlarged Restroom Plan

SCALE 1/4" = 1'-0"

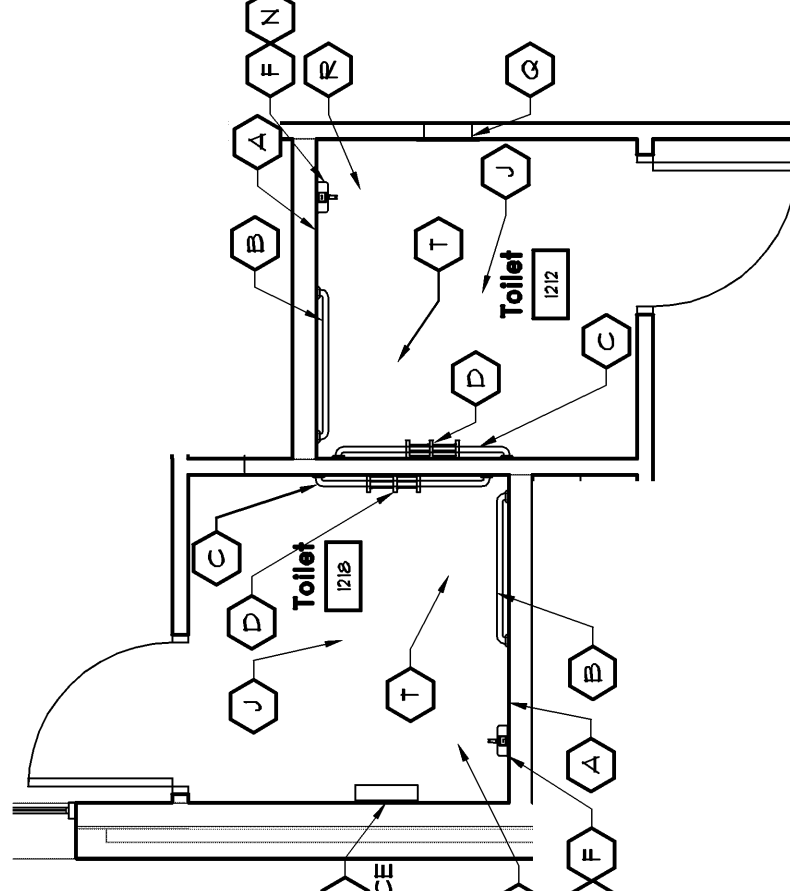


3 Enlarged Restroom Plan

SCALE 1/4" = 1'-0"

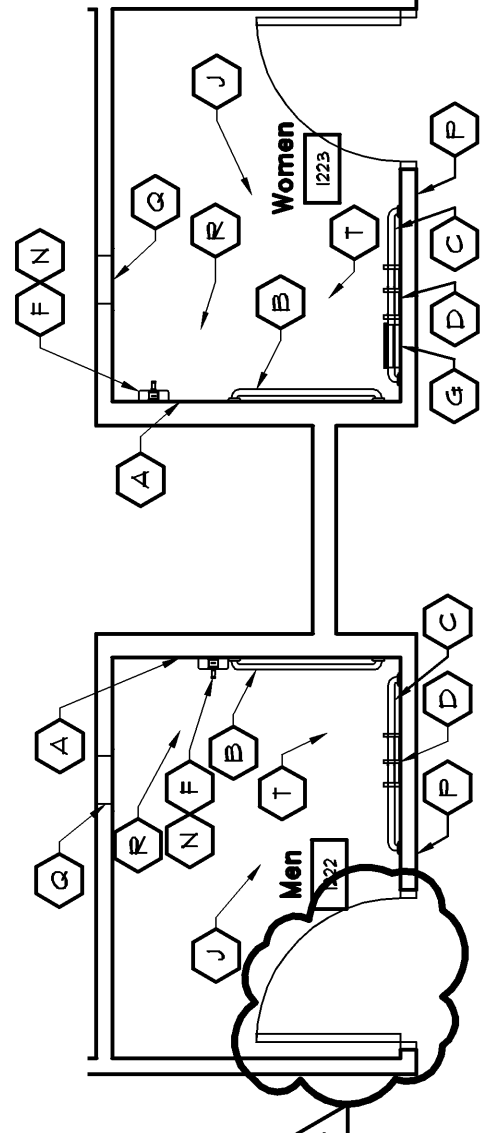


4 Enlarged Restroom Plan

SCALE 1/4" = 1'-0"

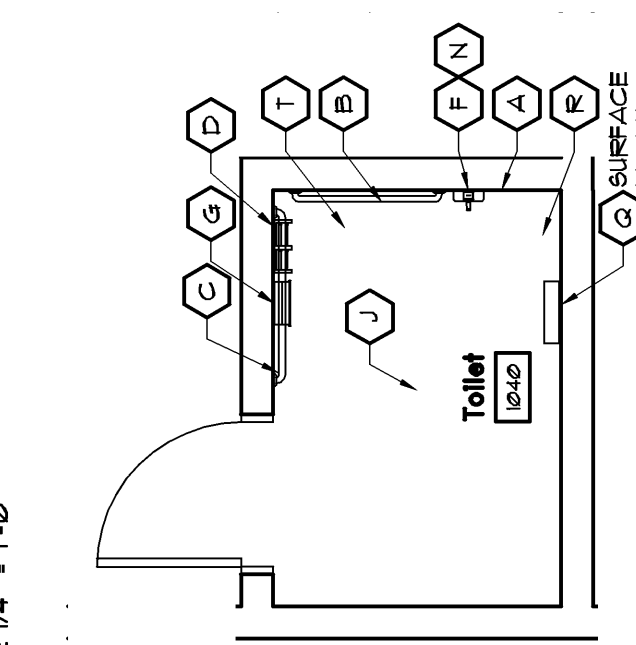


5 Enlarged Restroom Plan

SCALE 1/4" = 1'-0"

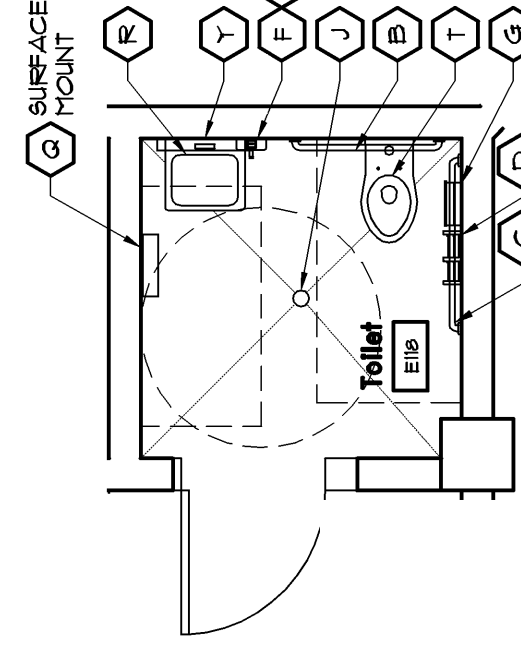


6 Enlarged Restroom Plan

SCALE 1/4" = 1'-0"

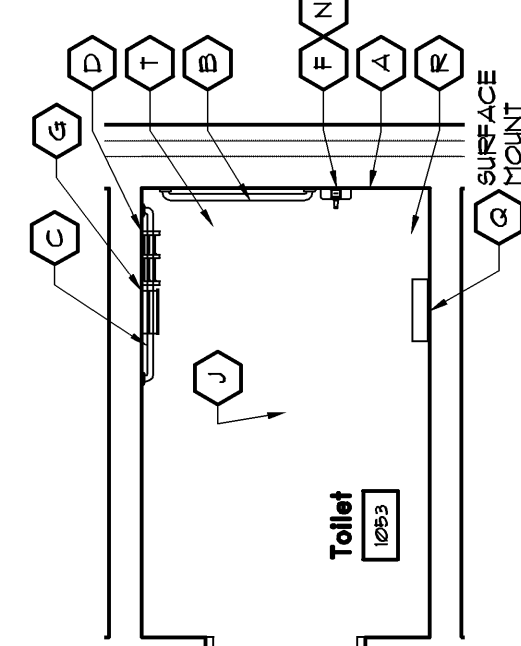

7 Enlarged Restroom Plan

SCALE 1/4" = 1'-0"

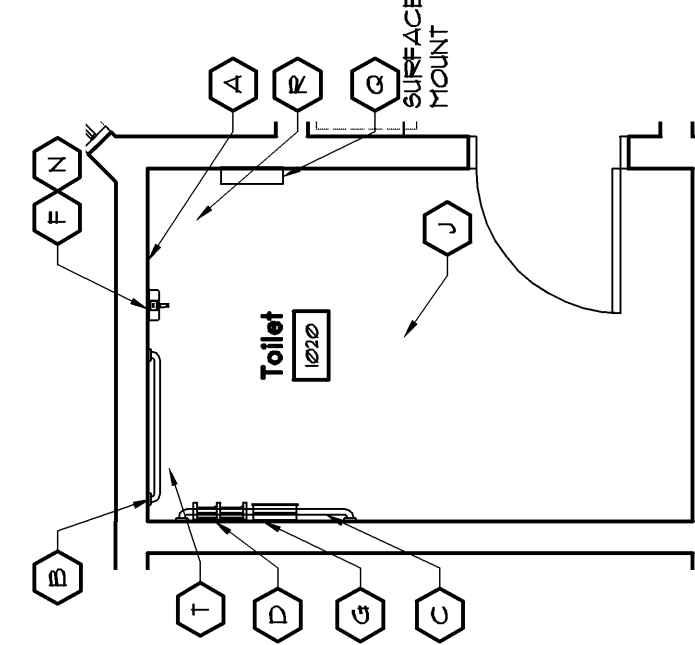


8 Enlarged Restroom Plan

SCALE 1/4" = 1'-0"


9 Enlarged Restroom Plan

SCALE 1/4" = 1'-0"

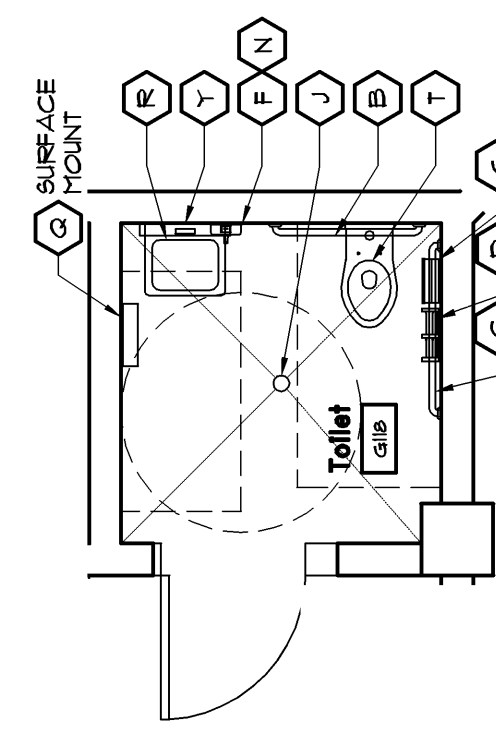


10 Enlarged Restroom Plan

SCALE 1/4" = 1'-0"

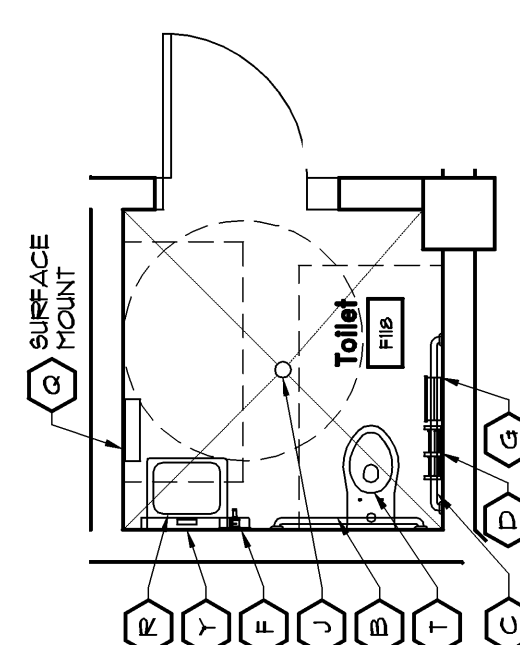


11 Enlarged Restroom Plan

SCALE 1/4" = 1'-0"

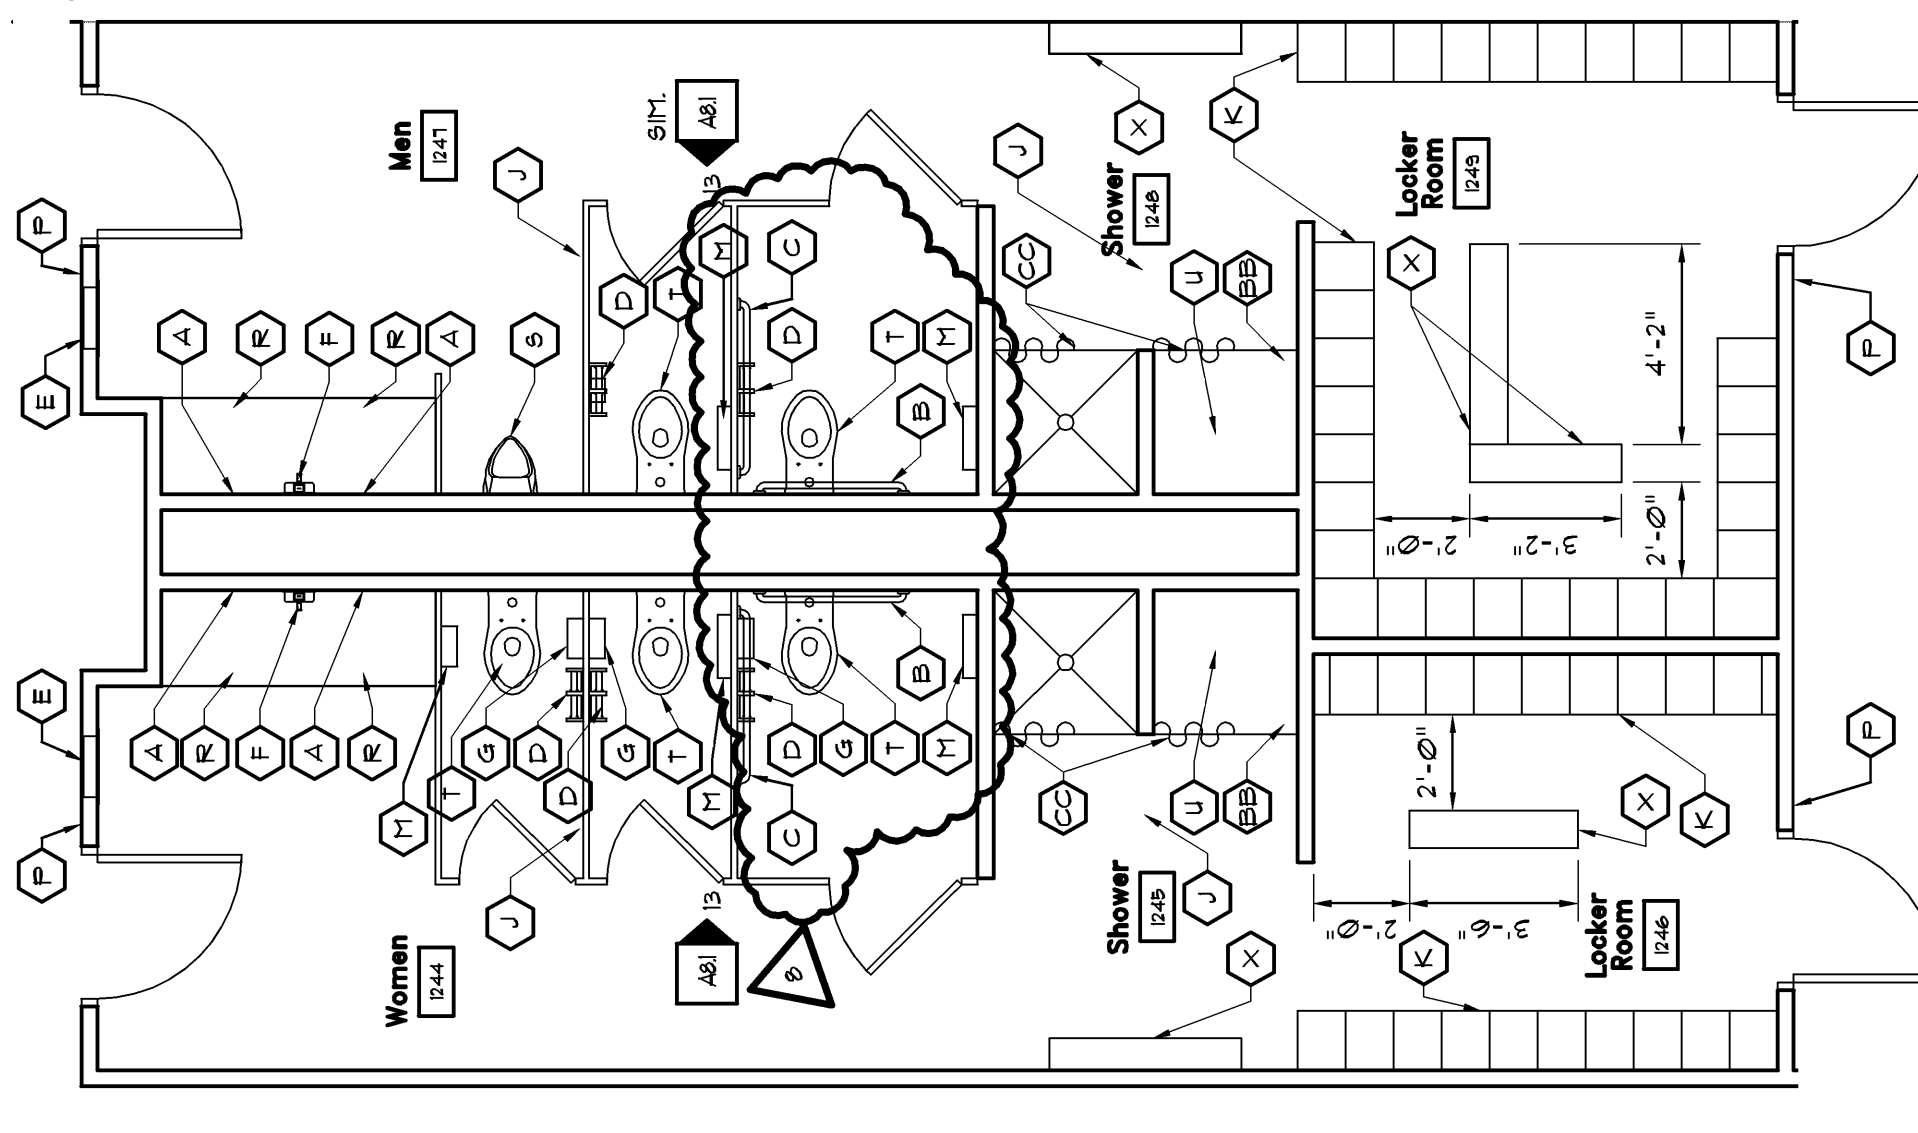


12 Enlarged Restroom Plan

SCALE 1/4" = 1'-0"

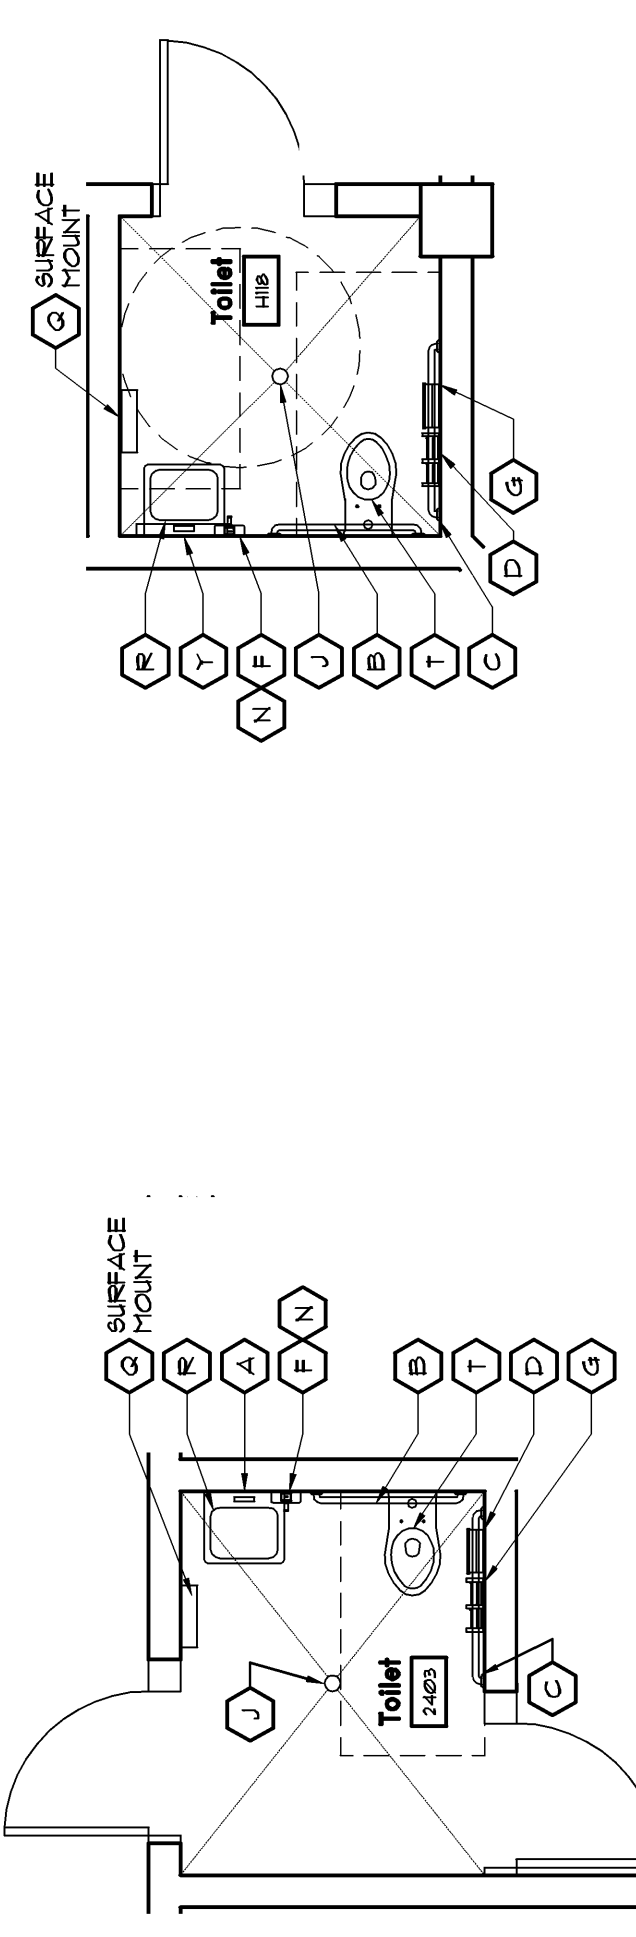


13 Enlarged Restroom Plan

SCALE 1/4" = 1'-0"

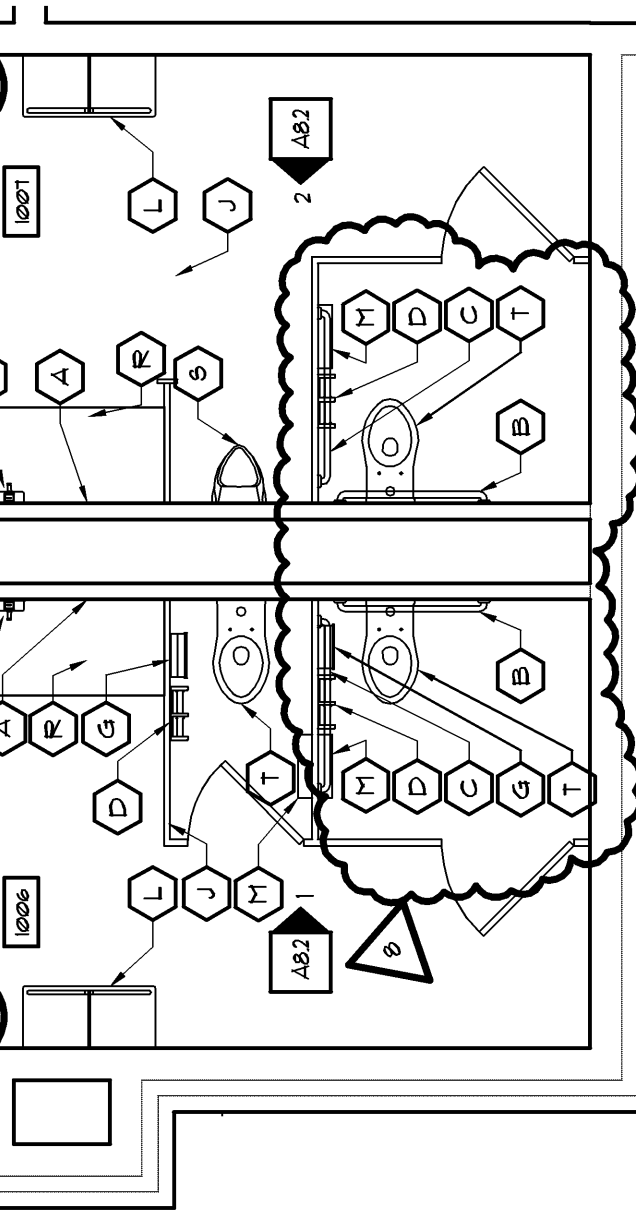


14 Enlarged Restroom Plan

SCALE 1/4" = 1'-0"

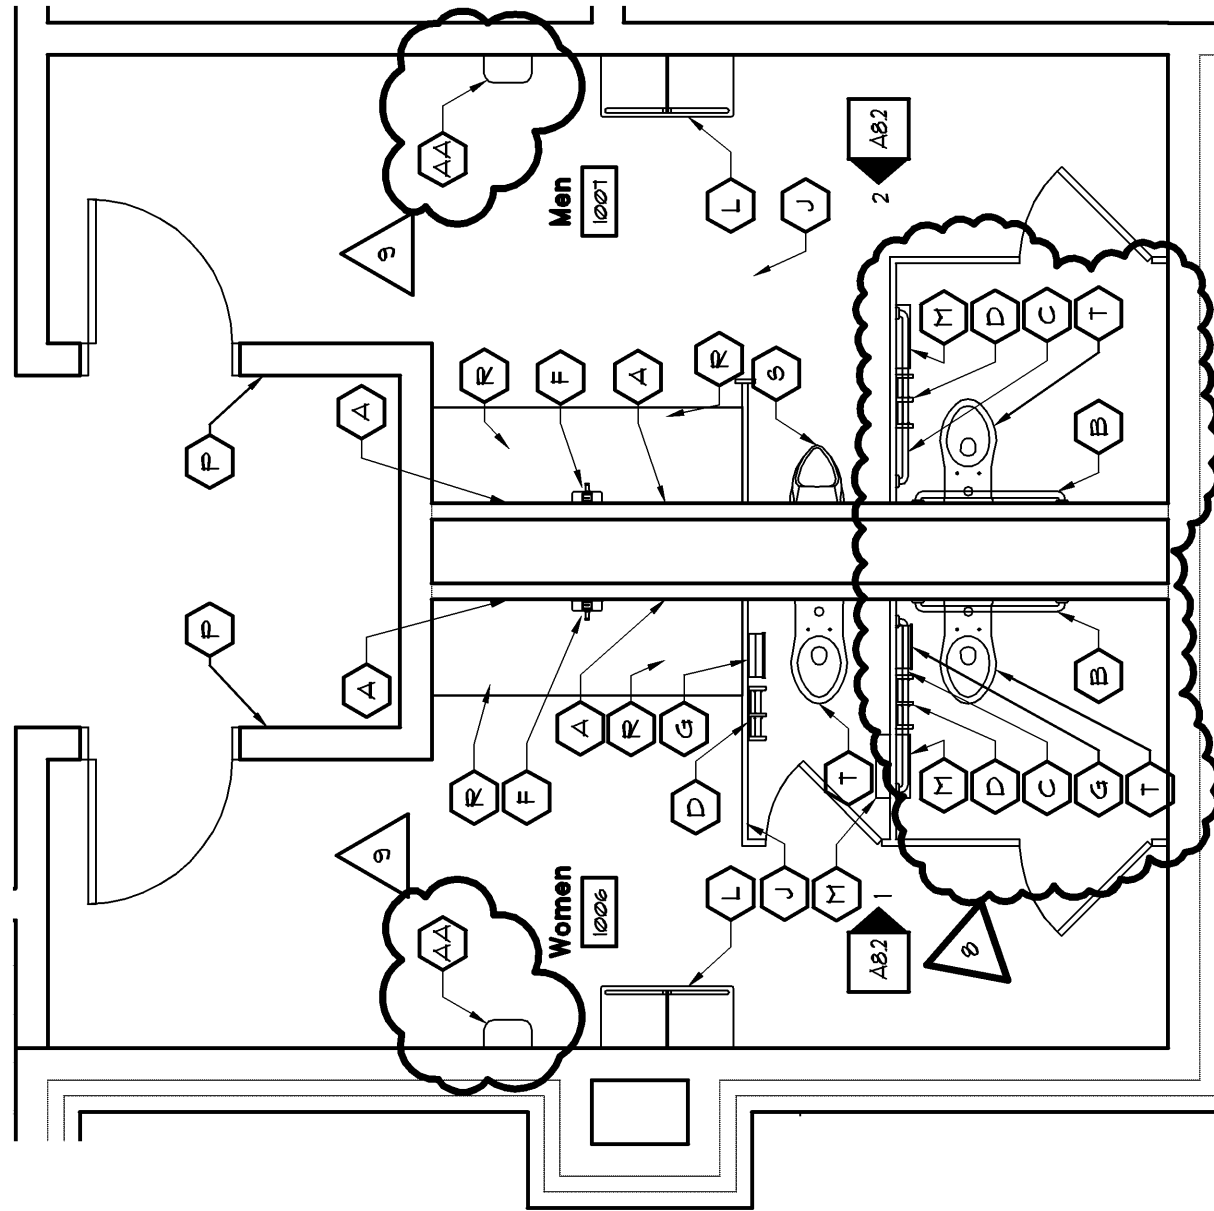


15 Enlarged Restroom Plan

SCALE 1/4" = 1'-0"

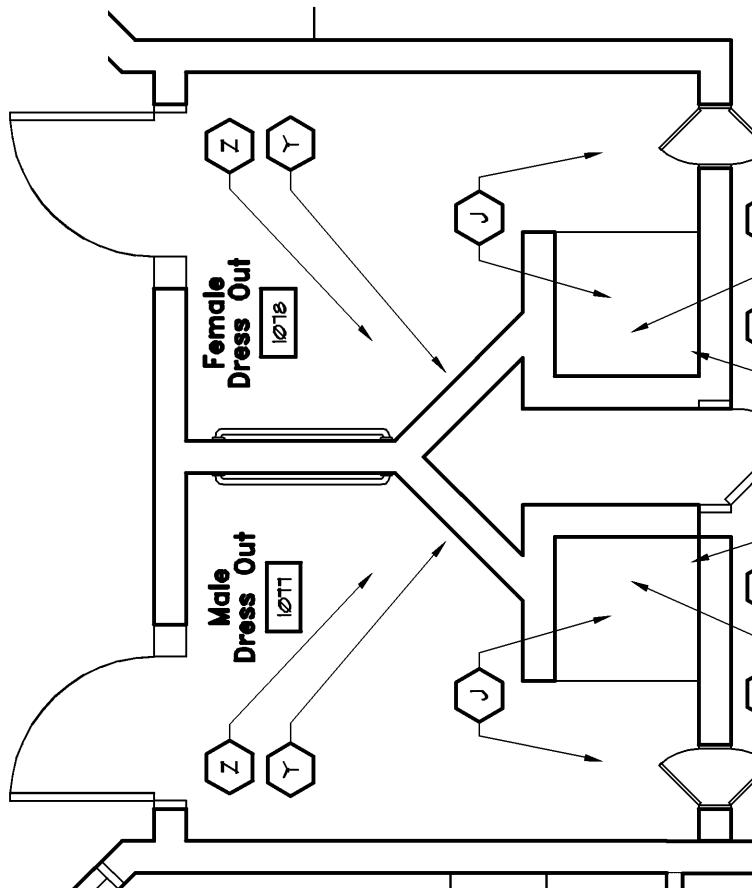


Enlarged Plan At Dress Out

SCALE 1/4" = 1'-0"

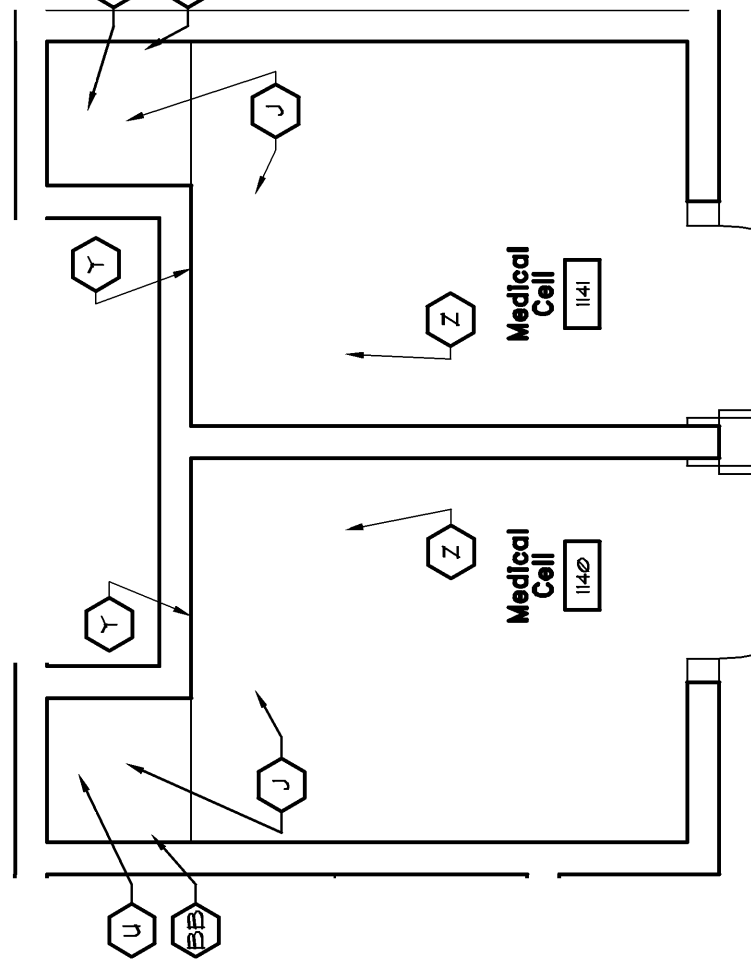

Enlarged Plan At Medical

SCALE 1/4" = 1'-0"

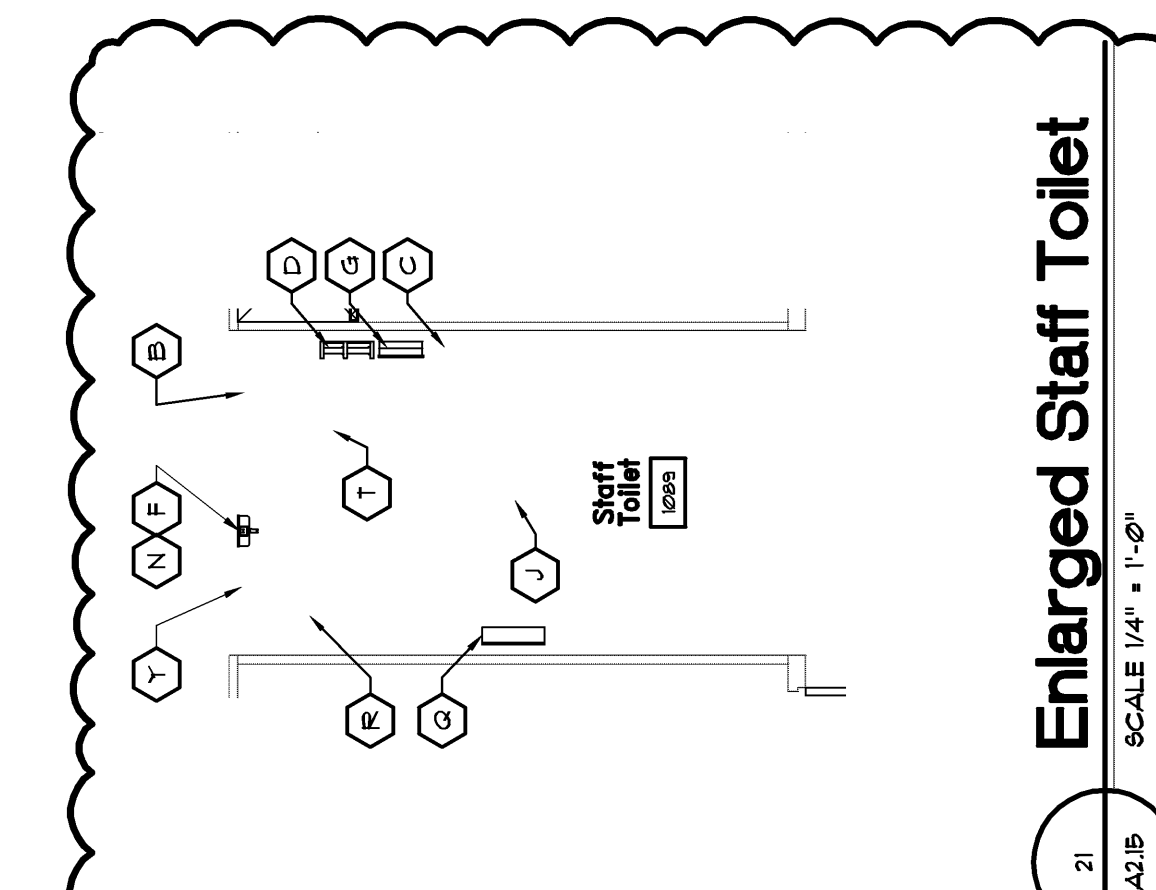


Enlarged Staff Toilet

SCALE 1/4" = 1'-0"

Drawing Release Summary

DATE	NO.	DESCRIPTION
5/17/2007	1	MECHANICAL / ELECTRICAL BID PACKAGE RELEASE
5/18/07	2	RFI #271
07/09/09	3	AS 1/9 REVISIONS TO RESTROOM LAYOUTS
07/09/09	4	MECHANICAL / KITCHEN BID PACKAGE RELEASE
07/10/09	5	BALANCE OF REMAINING BID PACKAGES
07/28/2009	6	FINAL MARSHAL REVIEW COMMENTS

Typical Mounting Heights

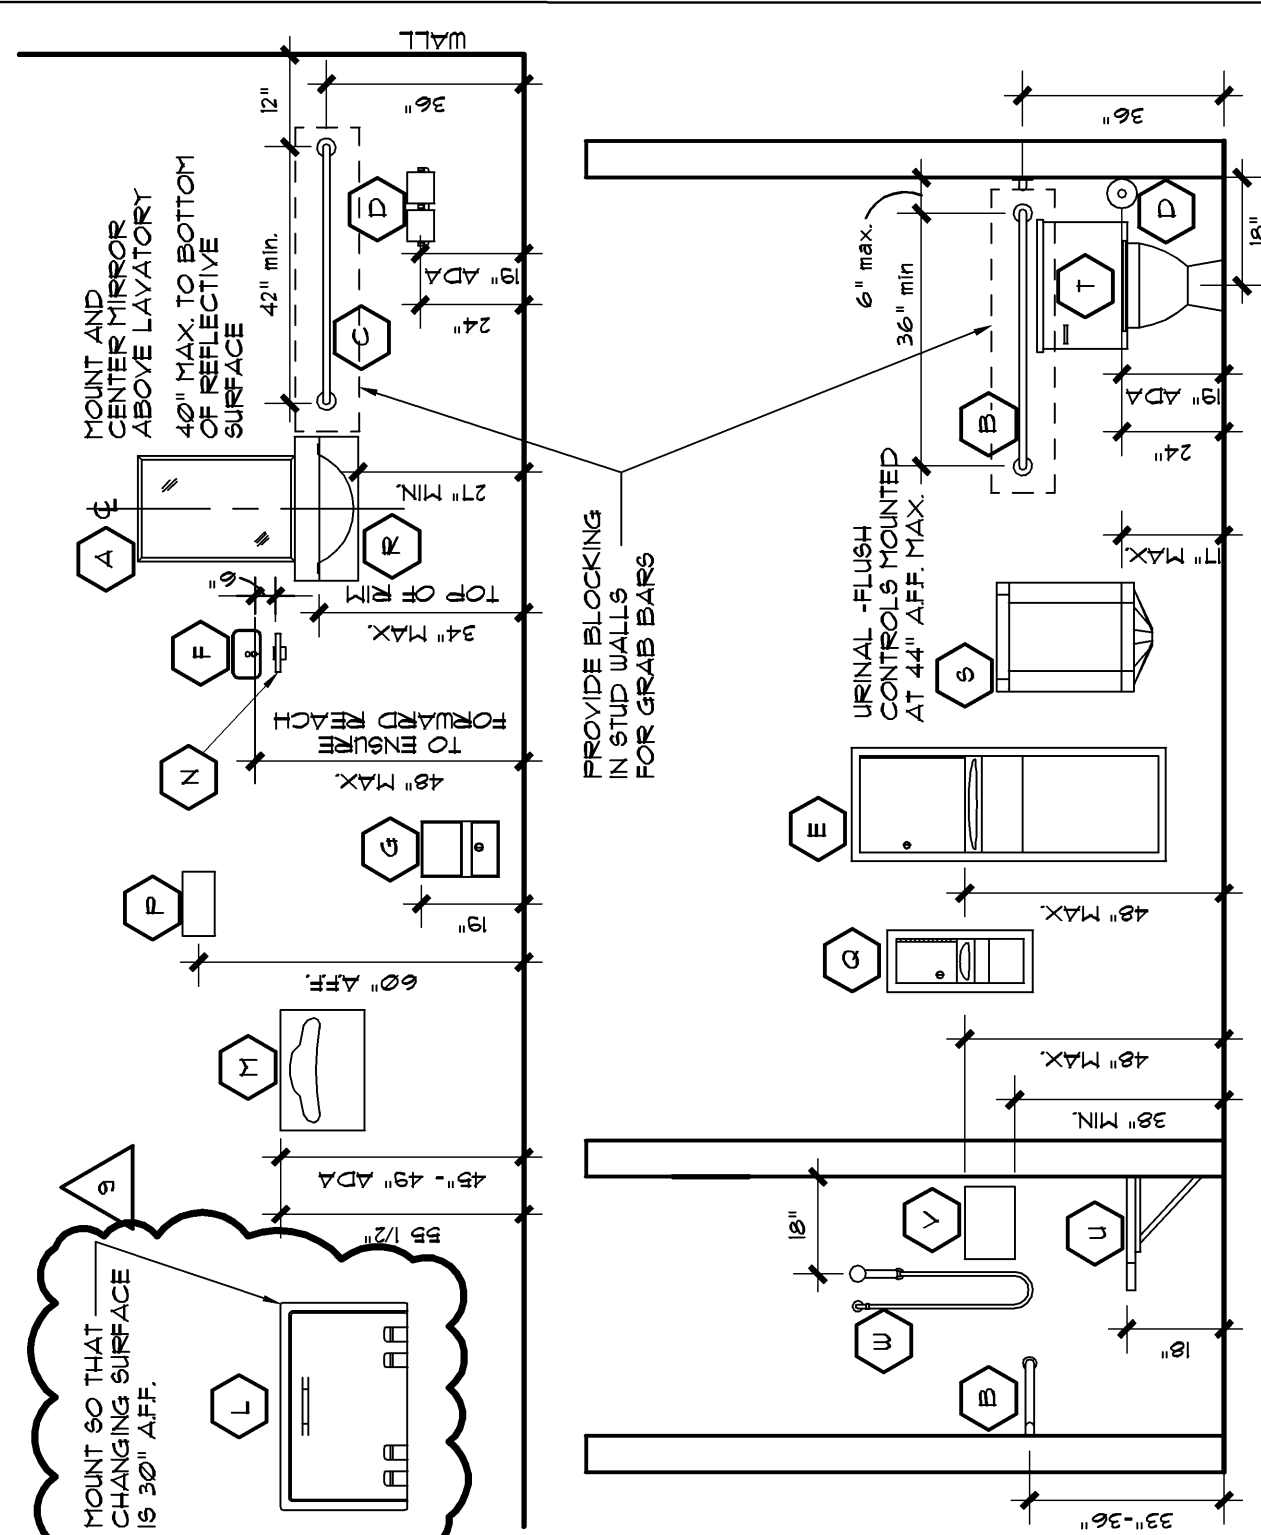

Toilet Accessory Legend

REFER TO SPECIFICATIONS FOR MORE INFORMATION

- A 24" x 36" MIRROR SURFACE MOUNTED, BOTTOM OF REFLECTIVE SURFACE LOCATED AT 5'-4" AFF.
- B 36" HANDICAP GRAB BAR
- C 47" HANDICAP GRAB BAR
- D TOILET TISSUE DISPENSER, SURFACE MOUNTED.
- E PAPER TISSUE DISPENSER AND WASTE RECEPTACLE - RECESSED UNLESS NOTED OTHERWISE
- F SOAP DISPENSER
- G SCARF DISPENSER
- H SANITARY NAPKIN DISPOSAL
- I HOP SINK - REFER TO PLUMBING
- J FLOOR DRAIN - REFER TO PLUMBING
- K BABY CHANGING STATION
- L SEAT COVER DISPENSER
- M DRAIN TRAY
- N 24" x 36" MIRROR SURFACE MOUNTED, BOTTOM OF REFLECTIVE SURFACE LOCATED AT 5'-4" AFF.
- O PAPER TISSUE DISPENSER AND WASTE RECEPTACLE - RECESSED UNLESS NOTED OTHERWISE
- P LAVATORY - REFER TO PLUMBING
- Q URINAL - REFER TO PLUMBING
- R WATER CLOSET - REFER TO PLUMBING
- S ADA SHOWER SEAT
- T SHOWER CONTROLS
- U SHOWER UNIT - ADA
- V SOLID URBAN PEDIATRIC BENCH - REFER TO TOILET SPECIFICATIONS
- W DETENTION GRADE MIRROR - REFER TO SECURITY FURNISHINGS PLANS
- X STAINLESS STEEL ADA LOCKED UNIT
- Y ELECTRIC HAND DRYER
- Z ADA GRAB BAR

- 1. FOUNTAIN TO BE MOUNTED WITH THE SPOT AT 36" AFF. MAXIMUM. PROVIDE A KNEE SPACE OF 27" MINIMUM.
- 2. ALL EXPOSED PIPING UNDER LAVATORIES TO BE INSULATED OR PROTECTED IN ACCORDANCE WITH ANSI A.111.186 EDITION AS PER SECTION 413.4
- 3. PROVIDE L.C. SHOWER SPRAY UNIT AT HANDICAP SHOWER WITH AT LEAST A 60" LONG MORE. PROVIDE A SPRAY UNIT THAT CAN BE USED BOTH AS A FIXED SHOWER HEAD AND AS A HAND-HELD SHOWER.
- 4. PROVIDE BLOCKING IN WALLS FOR GRAB BARS AND TOILET ACCESSORIES. GRAB BARS SHALL WITHSTAND A LOAD OF 250 LB. APPLIED IN ANY DIRECTION.
- 5. POINT SOAP DISPENSER TO DRIP INTO TRAY - NOT ONTO FLOOR.
- 6. DRAIN LINES FOR LAVATORIES - CONTRACTORS SHALL PROVIDE A STAINLESS STEEL SEAT COVER DISPENSER AT WALL INTERSECTION.

FILE NUMBER
13642-15.dwg

PROJECT NUMBER
150136

DATE
03-28-08

DATE
05/16/09

NO. DESCRIPTION
24 FIRE MARSHAL REVIEW COMMENTS

RELEASE

TOILET ACCESSORY

REFERENCE PLAN

SHEET TITLE

LBD
DESIGN

CAC
DRAWN

LBD
CHECKED

PROJECT

JACKSON COUNTY JAIL
555 GENERAL JACKSON DRIVE
JEFFERSON, GEORGIA 30549

STAMP

REGISTERED ARCHITECT
LANE G. DAVIS
0000000000

PRECISION PLANNING, INC.
P.O. Box 2210
400 Pike Boulevard
Lawrenceville, GA 30046-2210
(770) 338-8000 or (770) 962-8000
(Fax) (770) 822-5990