


KAKUHIHEWA BUILDING (Kapolei SOB)


[1] All windows on the northwest side facing Kamokila Blvd (1st - 6th floors)

[2] All windows on the southwest side facing the parking garage (1st - 6th floors)



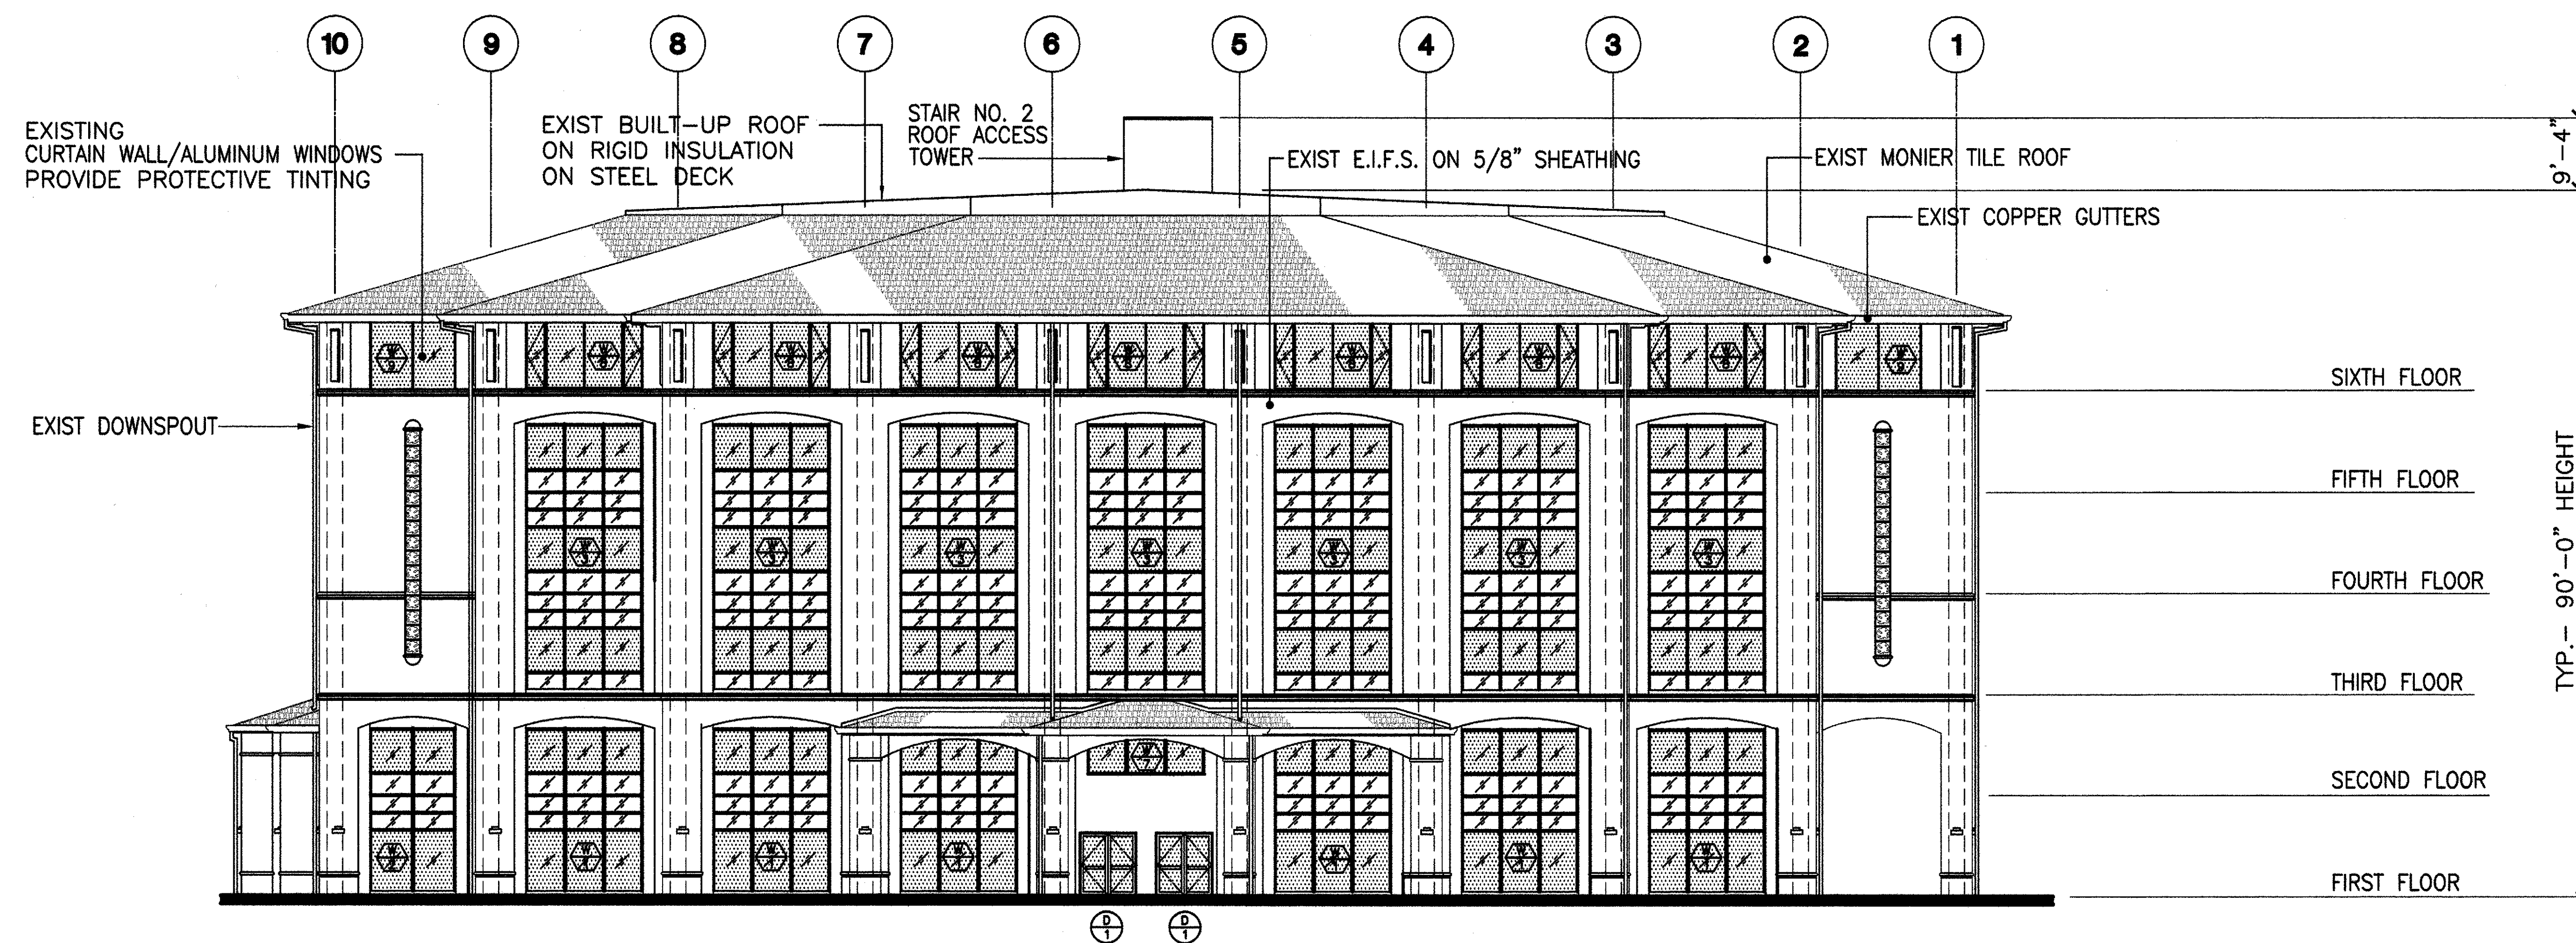

A NORTH WEST ELEVATION
A-6 SCALE: 1/16" = 1'-0"

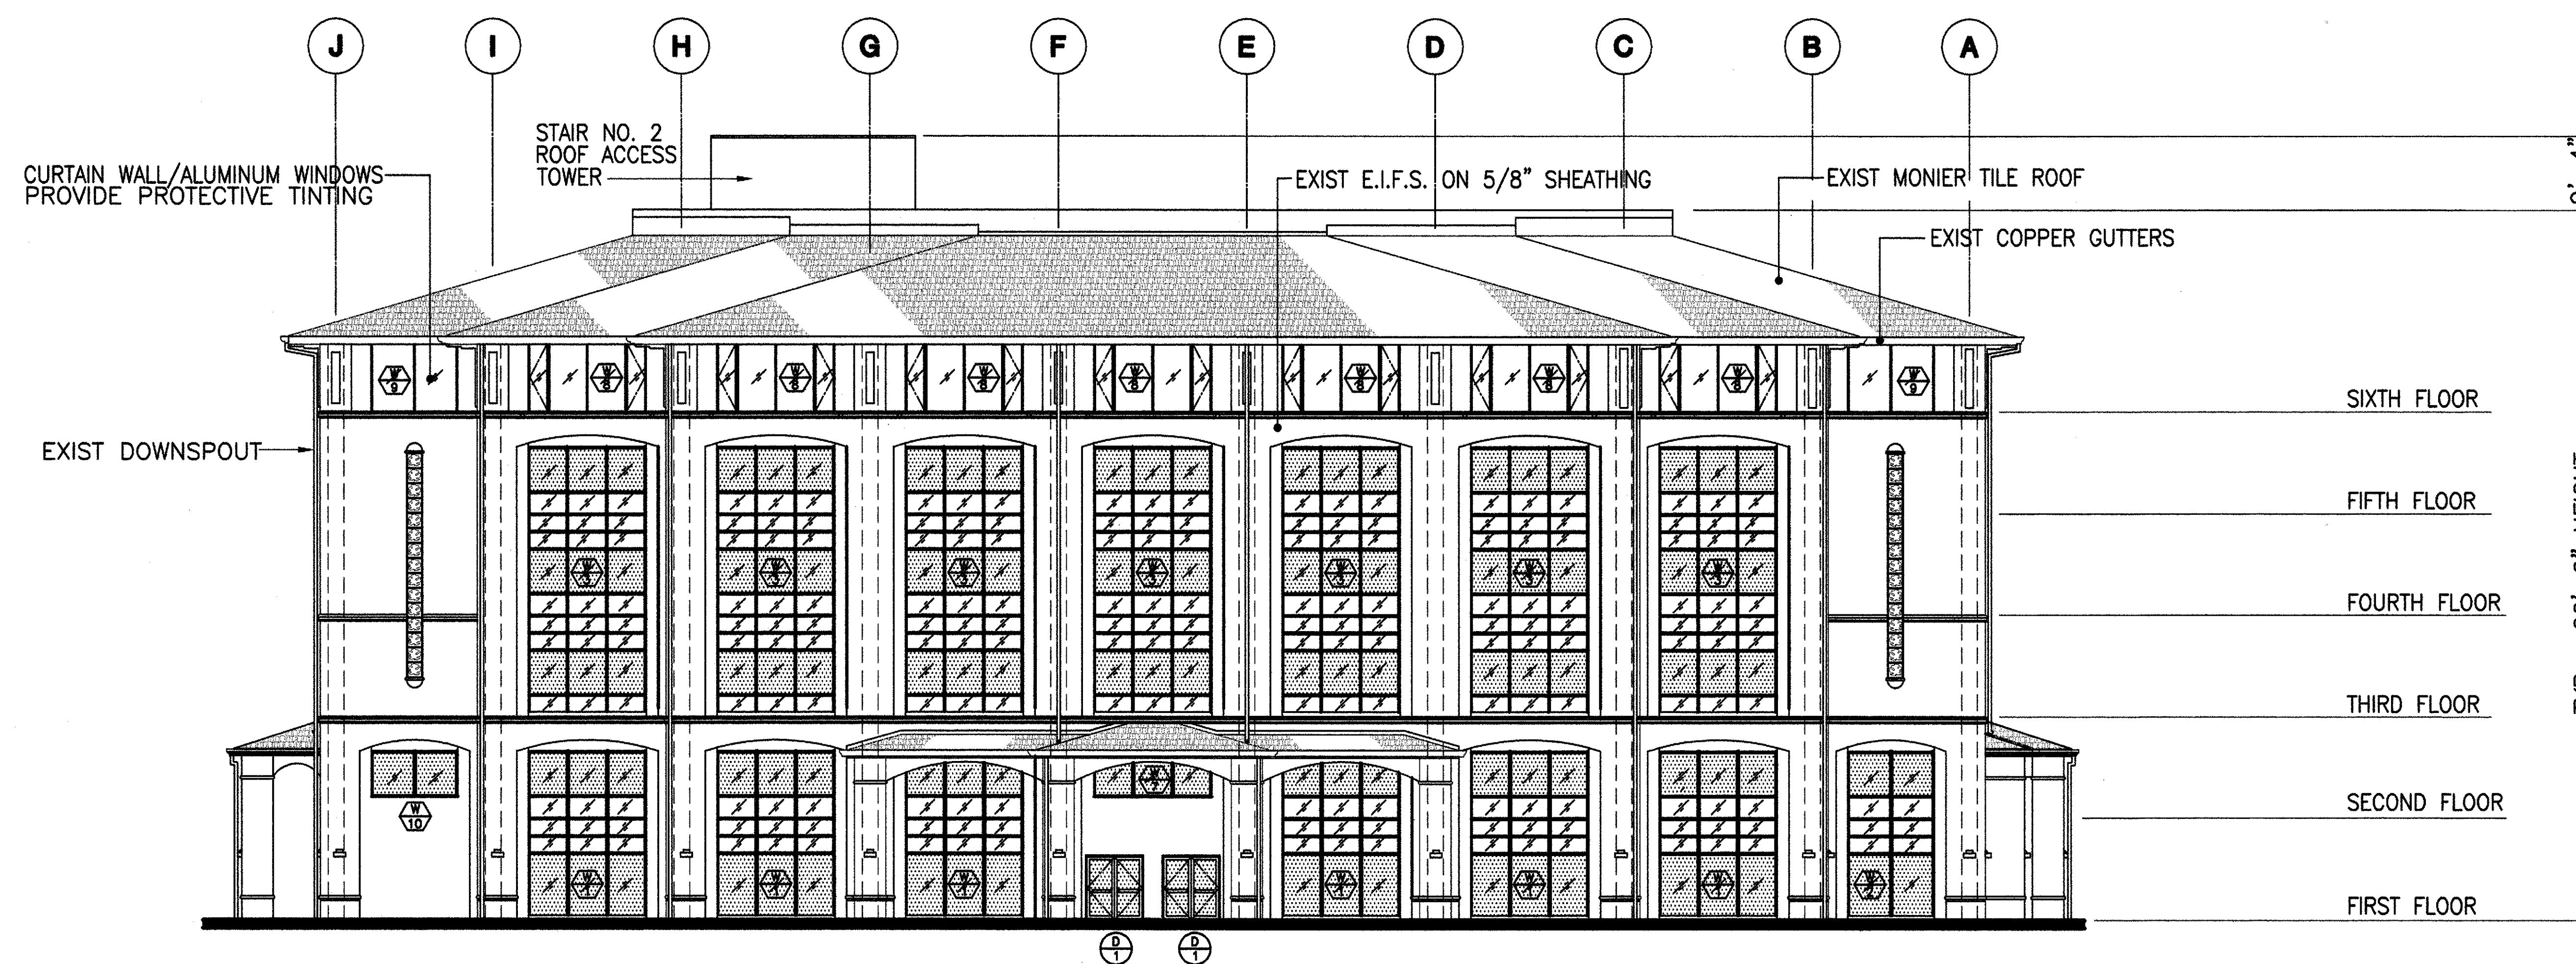

B NORTH EAST ELEVATION
A-6 SCALE: 1/16" = 1'-0"

AS BUILT DRAWING

SEP 8 2008

10' 0 10' 20' 30'
1/16" = 1'-0"


POST APP-1	REVISED DSGS JOB NO.	7/10	10/05/07
REVISION NO.	SYM.	DESCRIPTION	SHT OF DATE APPROVED: PUBLIC WORKS ADMINISTRATOR
DEPARTMENT OF ACCOUNTING & GENERAL SERVICES STATE OF HAWAII KAKUHIHEWA BUILDING INSTALL PROTECTIVE TINTING KAPOLEI OAHU HAWAII EXTERIOR ELEVATIONS			
MITSUNAGA & ASSOC., INC. DESIGNED BY: SW DRAWN BY: CAD SCALE: AS NOTED		DSGS JOB NO. 62-10-0515 42-10-0443 DATE: JULY 2007 SHEET 7 OF 11 SHTS	

THIS WORK WAS PREPARED BY ME OR UNDER MY SUPERVISION AND CONSTRUCTION OF THIS PROJECT WILL BE UNDER MY OBSERVATION. (OBSERVATION OF CONSTRUCTION AS DEFINED IN CHAPTER 16-115, SUBCHAPTER 1 DEFINITIONS, OF THE HAWAII ADMINISTRATIVE RULES, "PROFESSIONAL ENGINEERS, ARCHITECTS, SURVEYORS, AND LANDSCAPE ARCHITECTS") EXPIRATION DATE: 4-30-08


STEVEN D. WONG
LICENSED PROFESSIONAL ARCHITECT
No. 4646
HAWAII U.S.A.

MITUNAGA & ASSOCIATES, INC.

FILE 4 DRAWER 2 FOLDER 5

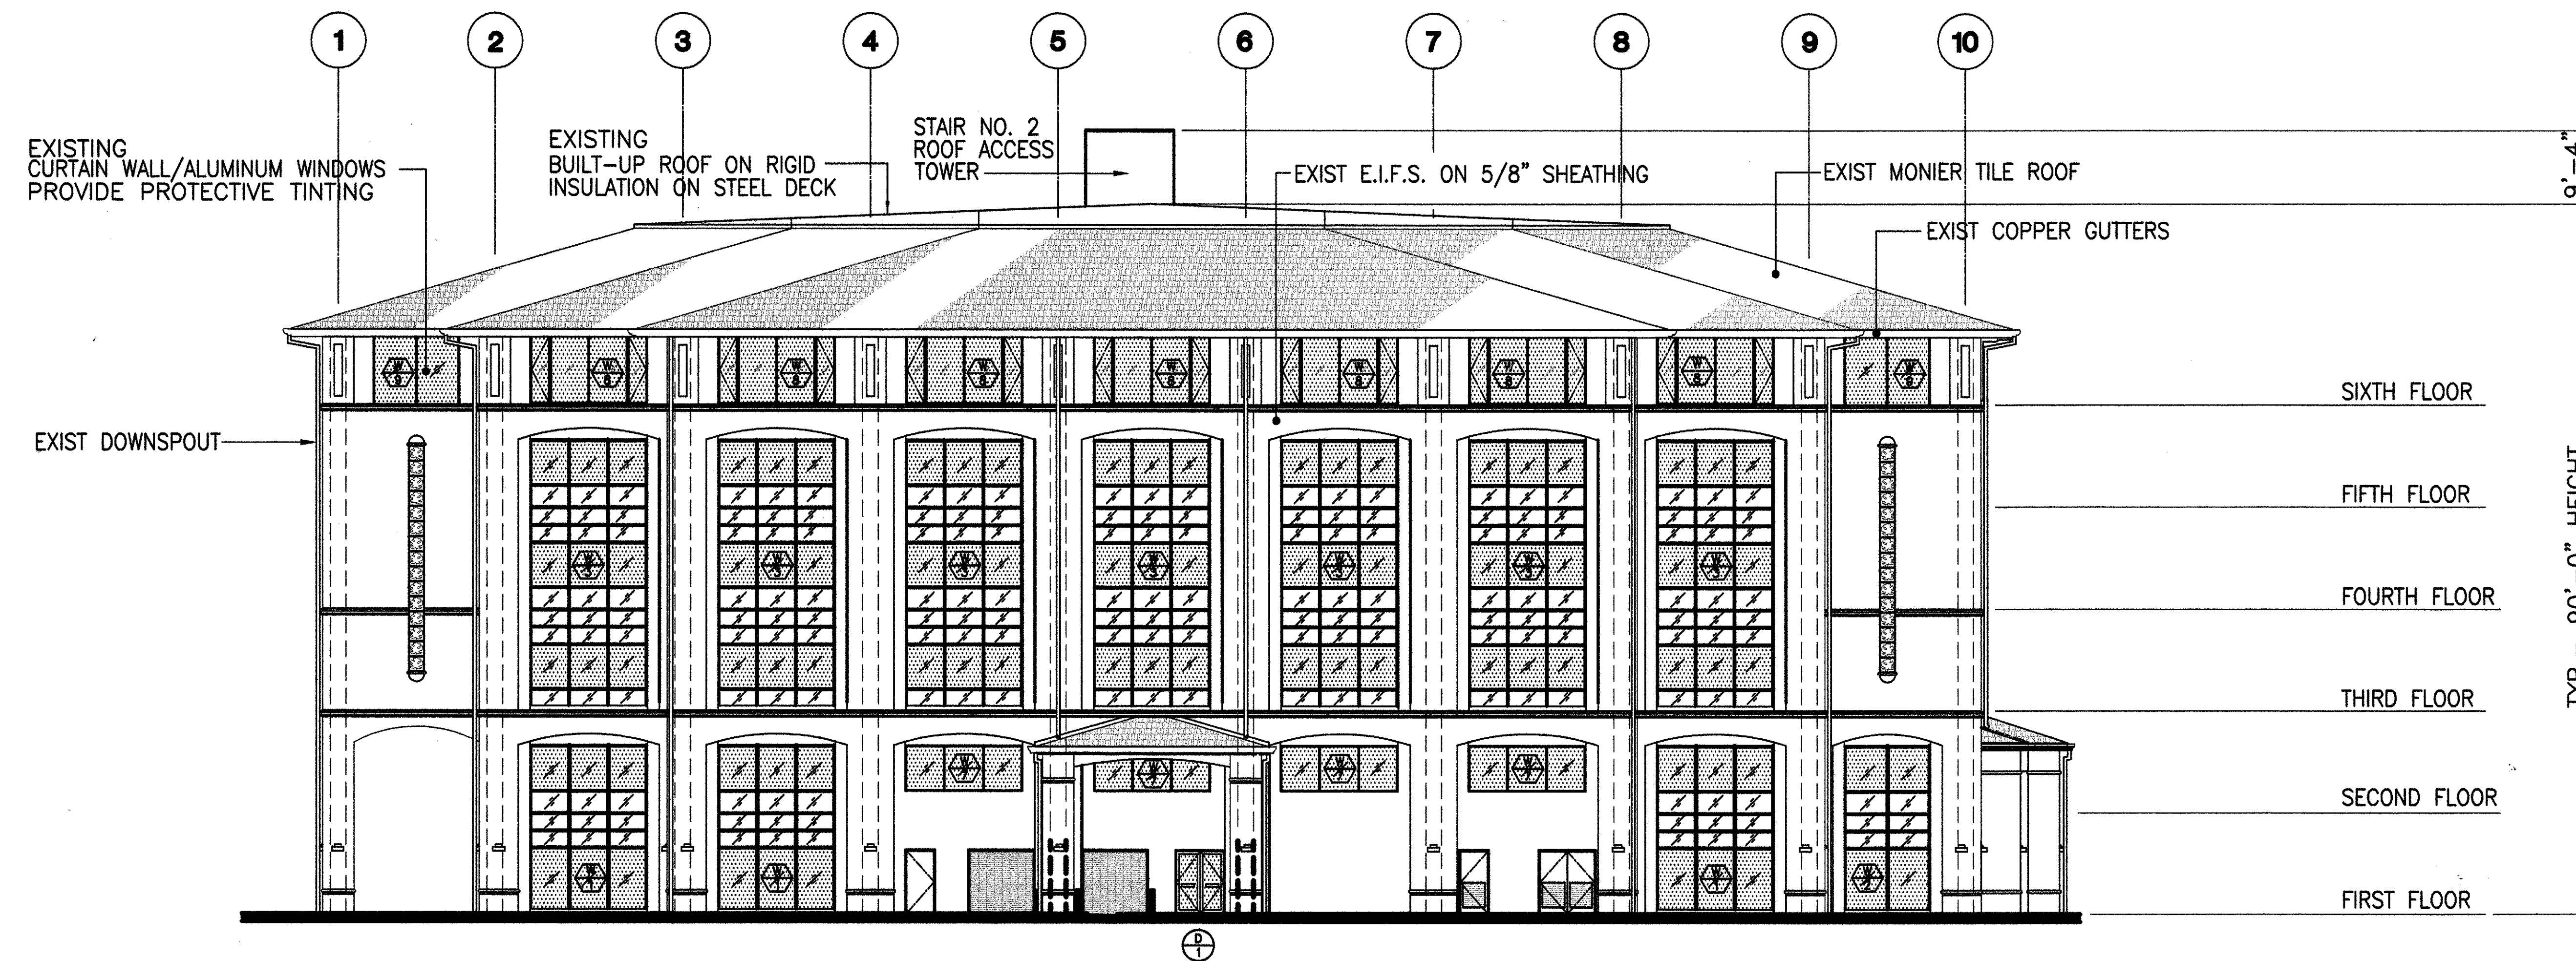

A SOUTH EAST ELEVATION
A-7 SCALE: 1/16" = 1'-0"

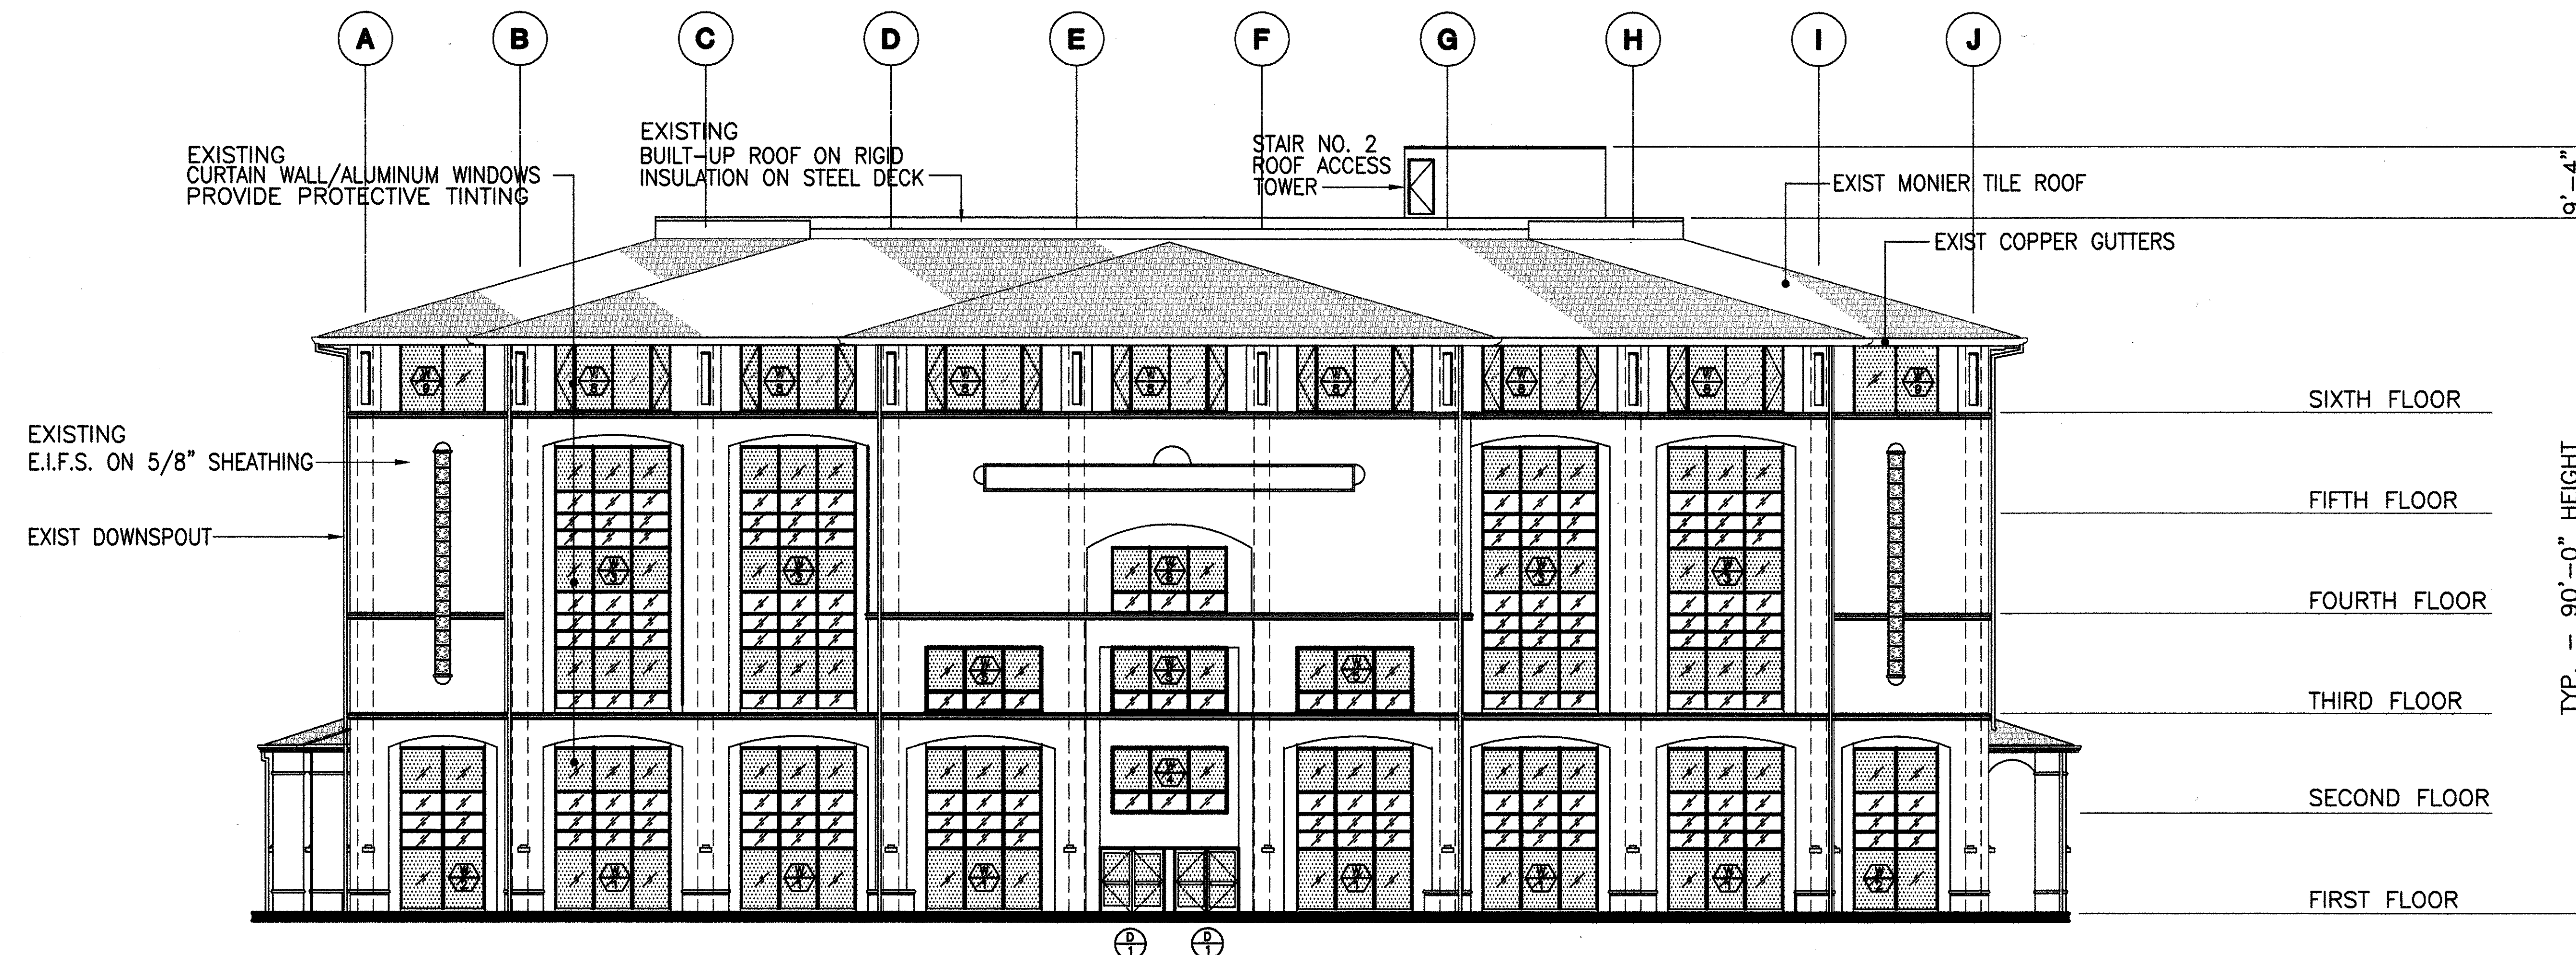

B SOUTH WEST ELEVATION
A-7 SCALE: 1/16" = 1'-0"

AS BUILT DRAWING


SEP 8 2008

10' 0 10' 20' 30'
1/16" = 1'-0"


POST ADD-1	REVISED DAPS JOB NO	5/11	10/05/07	
REVISION NO.	SYM.	DESCRIPTION	SHT OF	DATE
APPROVED: PUBLIC WORKS ADMINISTRATOR				

DEPARTMENT OF ACCOUNTING & GENERAL SERVICES STATE OF HAWAII KAKUHIHEWA BUILDING INSTALL PROTECTIVE TINTING KAPOLEI OAHU HAWAII		
EXTERIOR ELEVATIONS		
MITSUNAGA & ASSOC., INC. DESIGNED BY: SW DRAWN BY: CAD SCALE: AS NOTED		DAPS JOB NO. G2-10-0443 DATE JULY 2007
THIS WORK WAS PREPARED BY ME OR UNDER MY SUPERVISION AND CONSTRUCTION OF THIS PROJECT WILL BE UNDER MY OBSERVATION, (OBSERVATION OF CONSTRUCTION AS DEFINED IN CHAPTER 15-112, SUBCHAPTER 1, DEFINITIONS, OF THE HAWAII ADMINISTRATIVE RULES, "PROFESSIONAL ENGINEERS, ARCHITECTS, SURVEYORS, AND LANDSCAPE ARCHITECTS") EXPIRATION DATE: 4-30-09 		DRAWING NO. A-7 SHEET 8 OF 11 SHTS


FILE 11 DRAWER 2 FOLDER 5

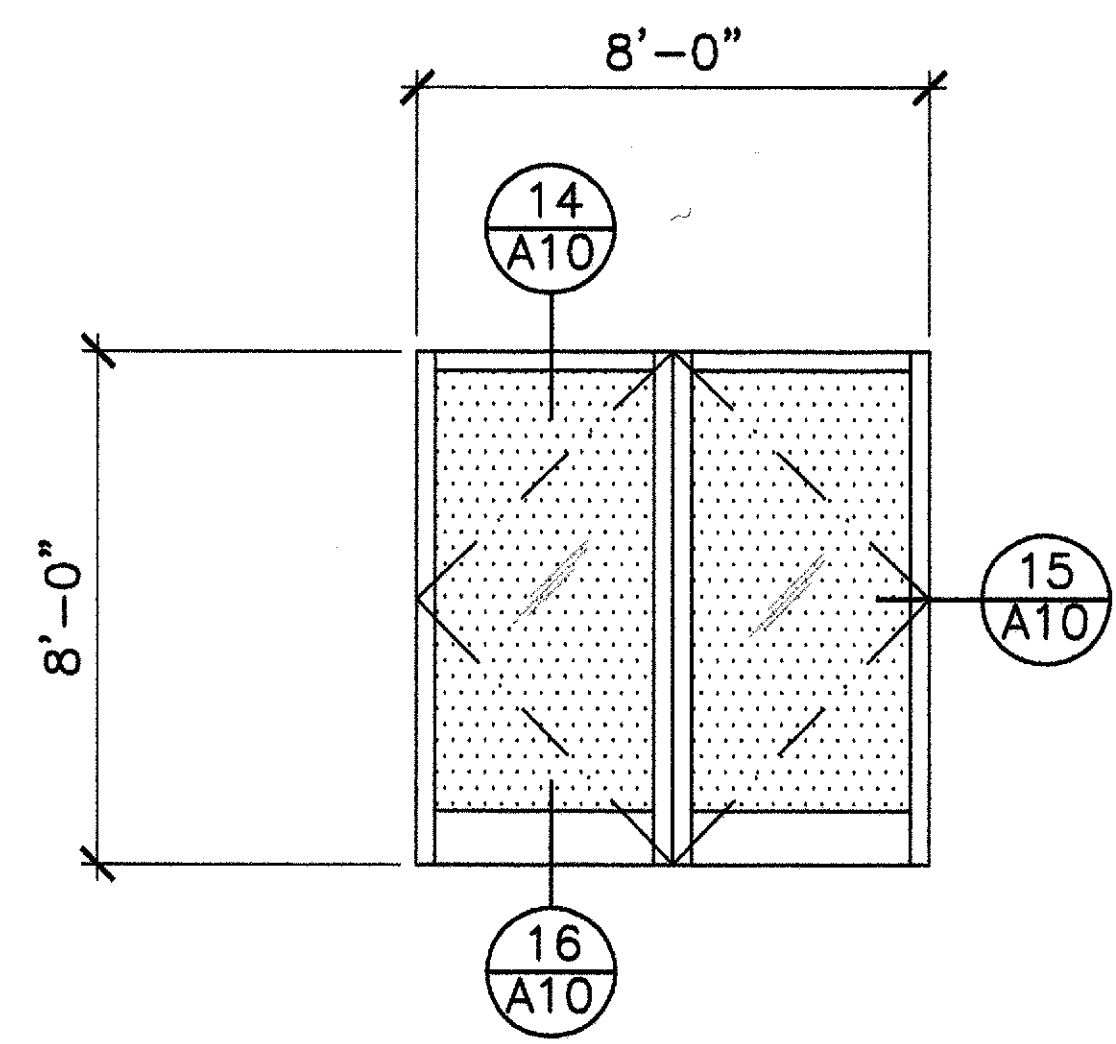


DOOR TYPE AA

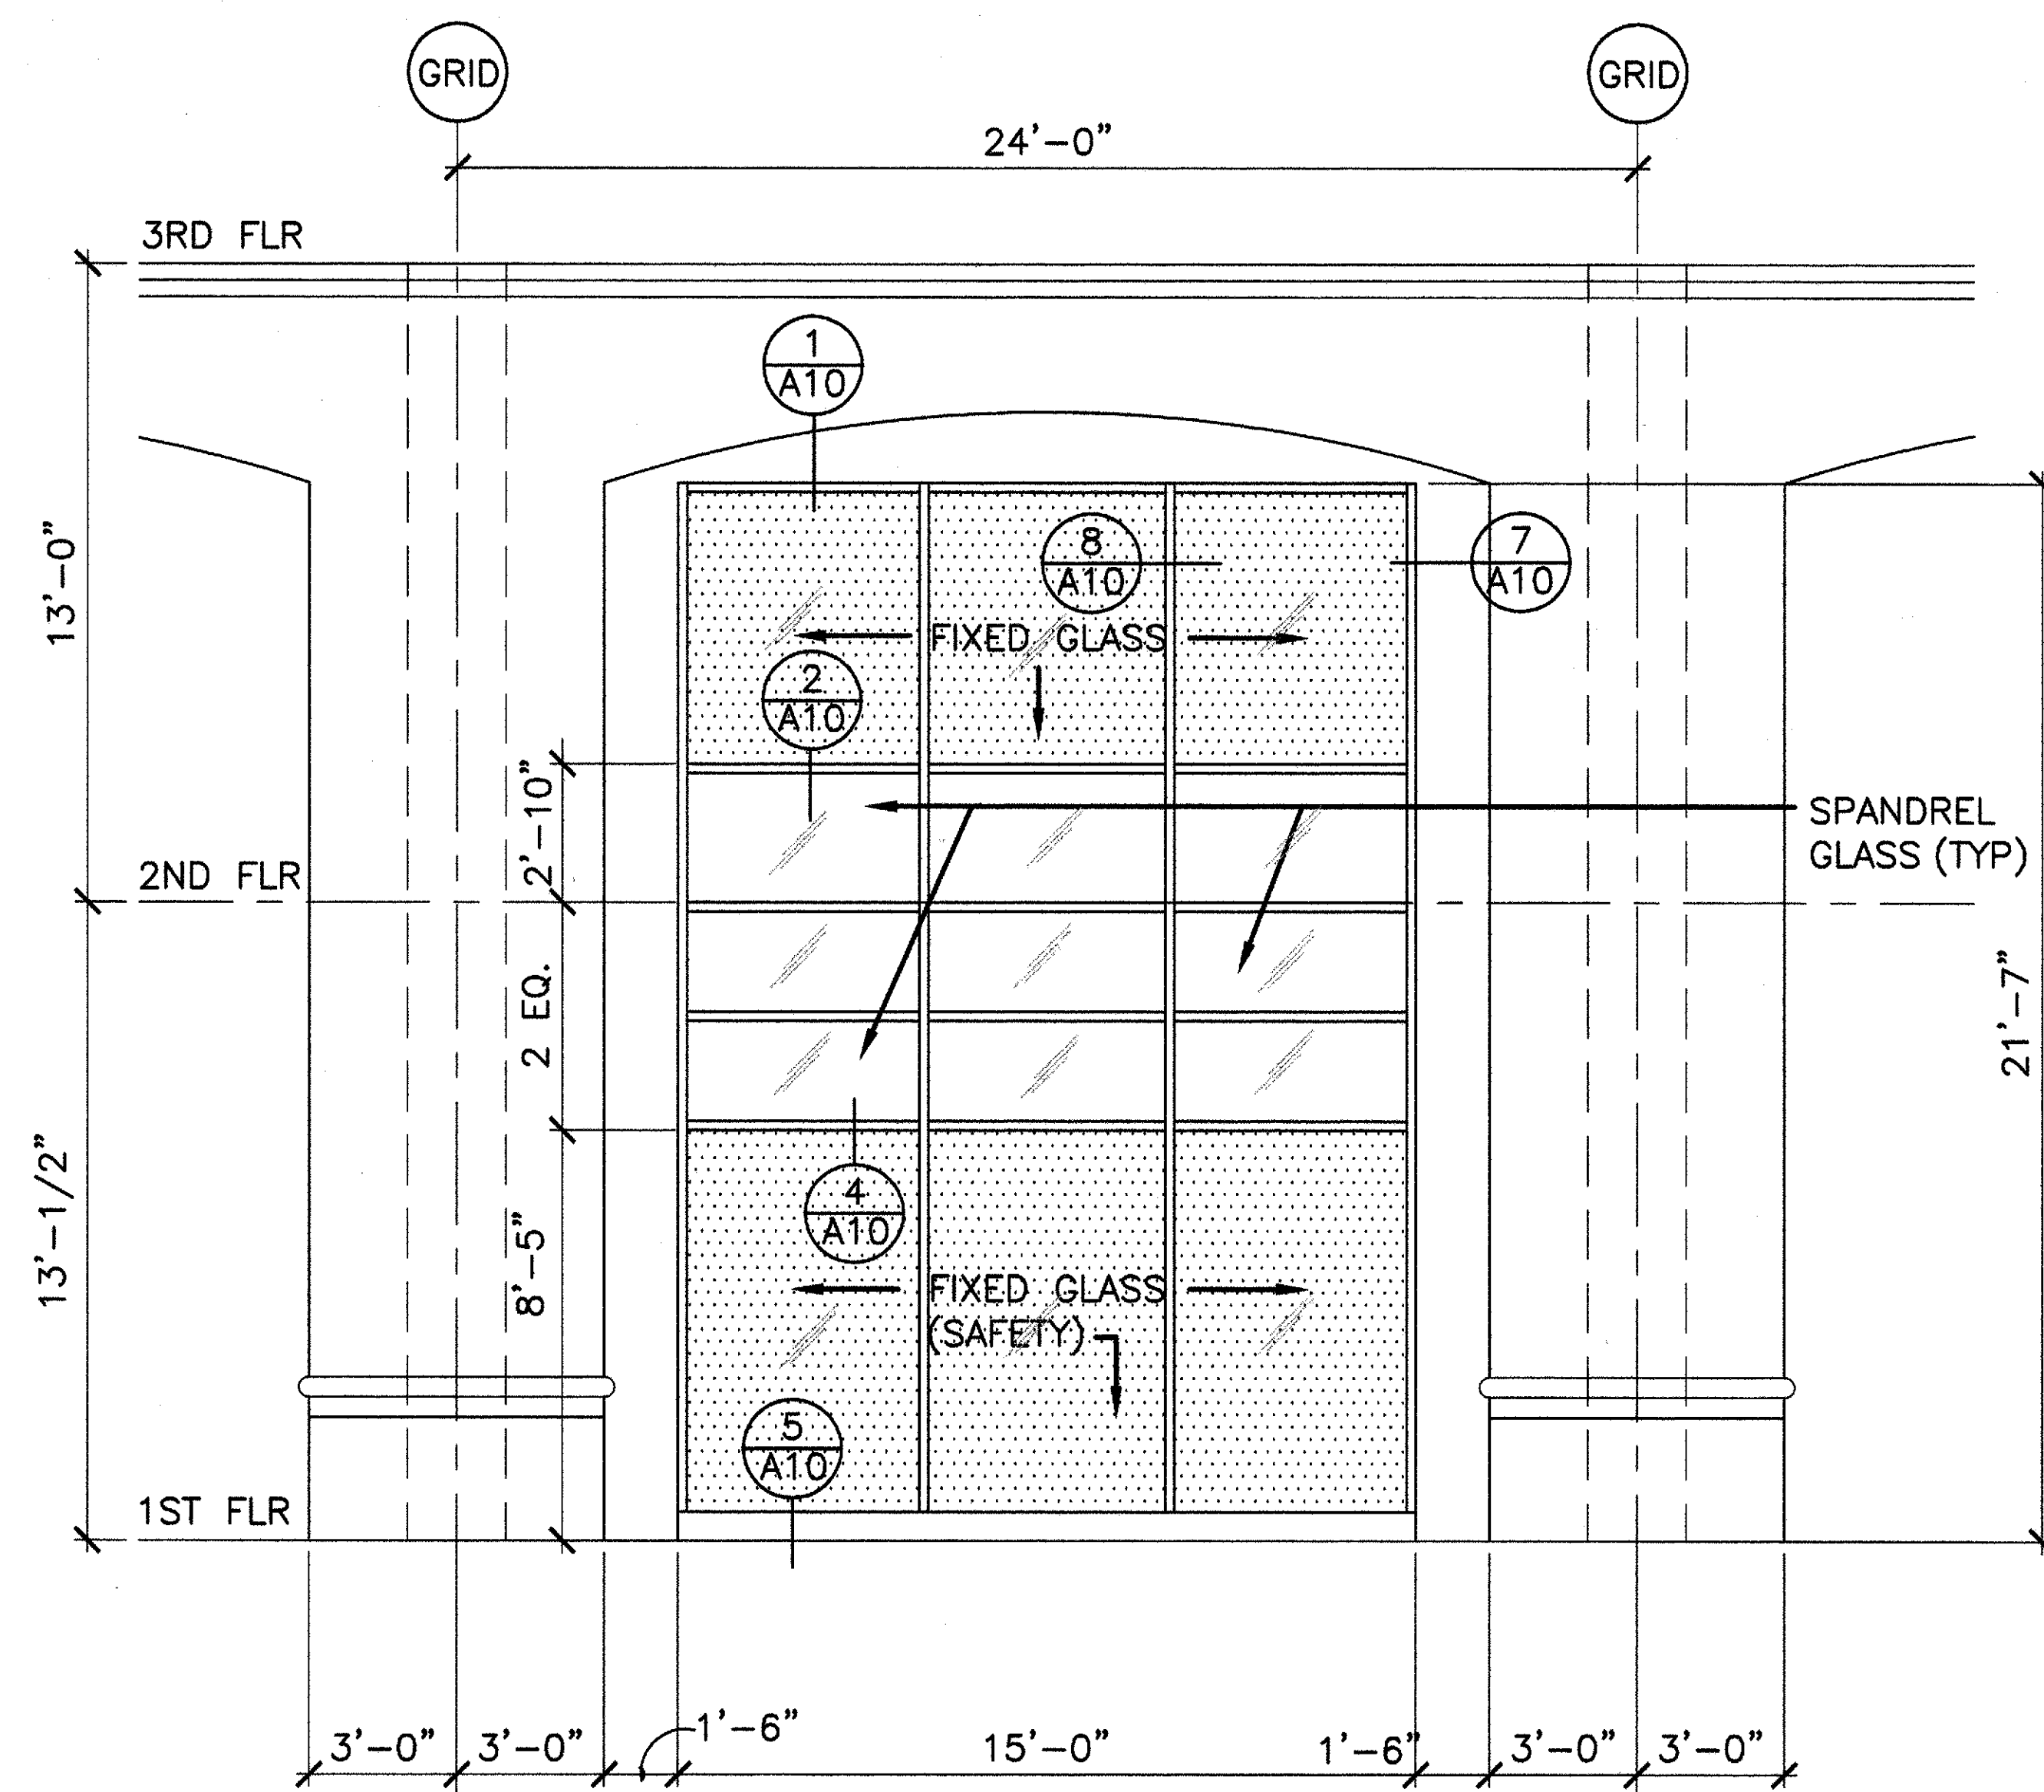

WINDOW TYPE A

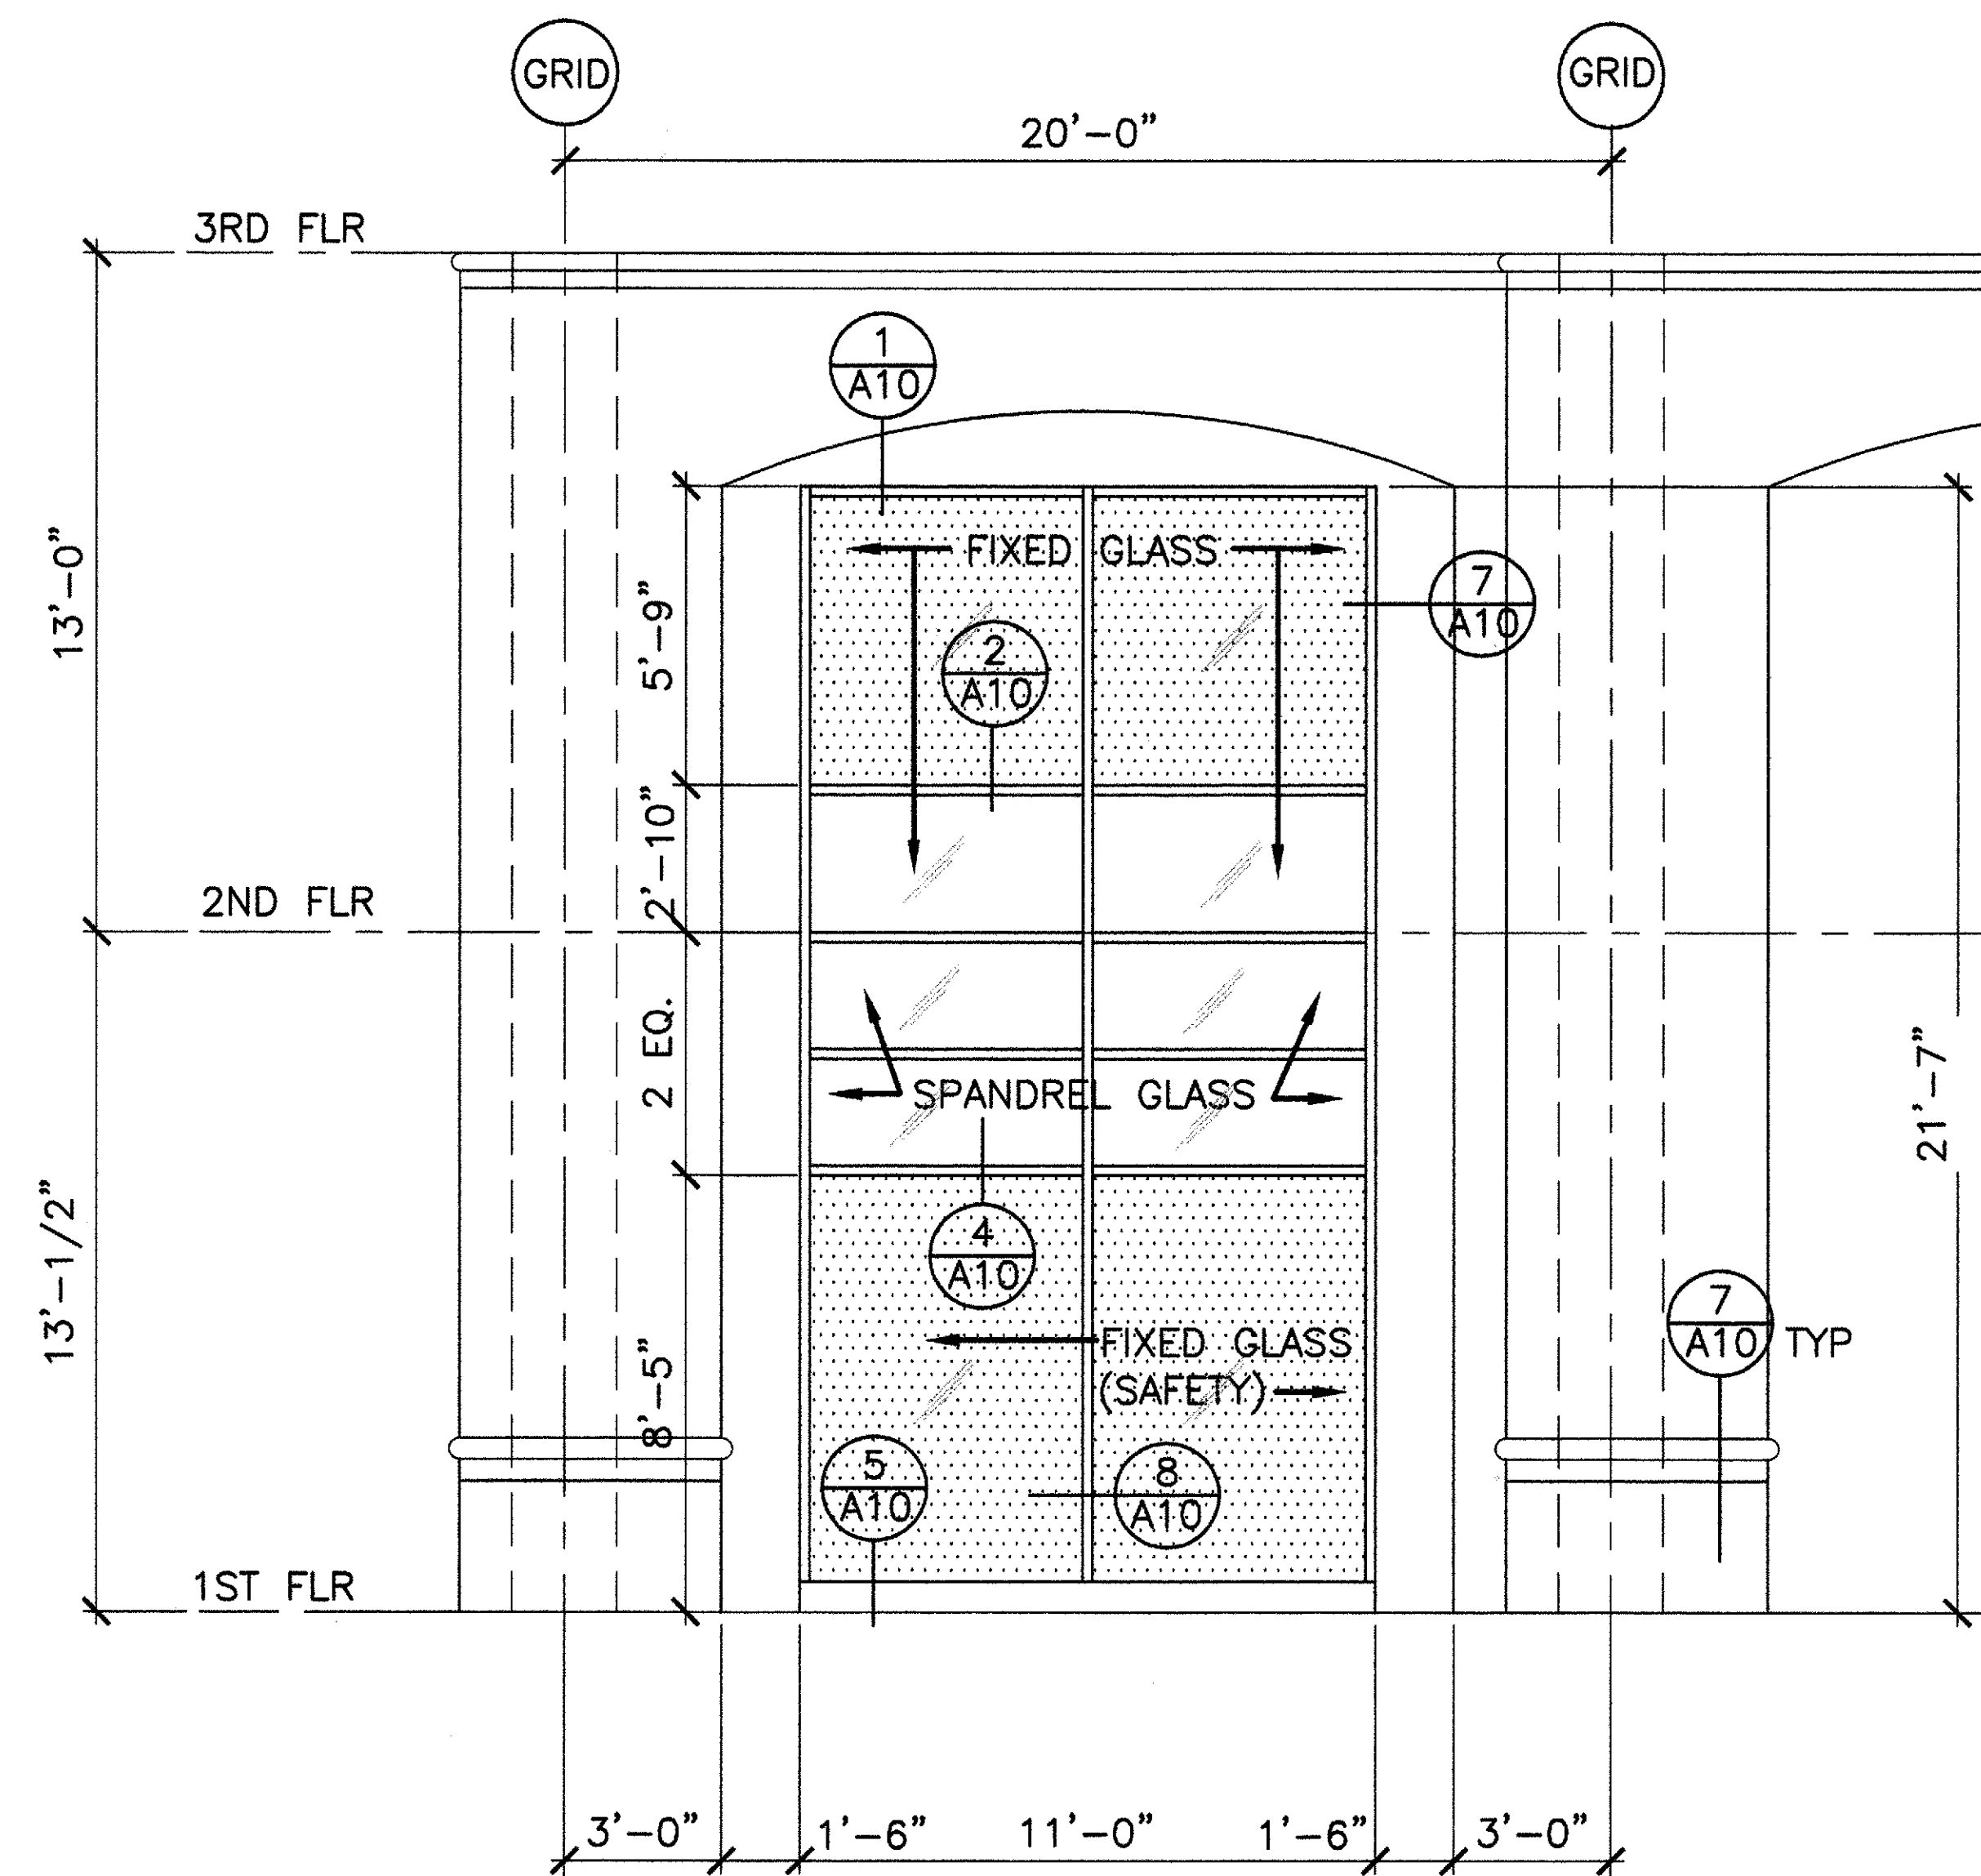

WINDOW TYPE B

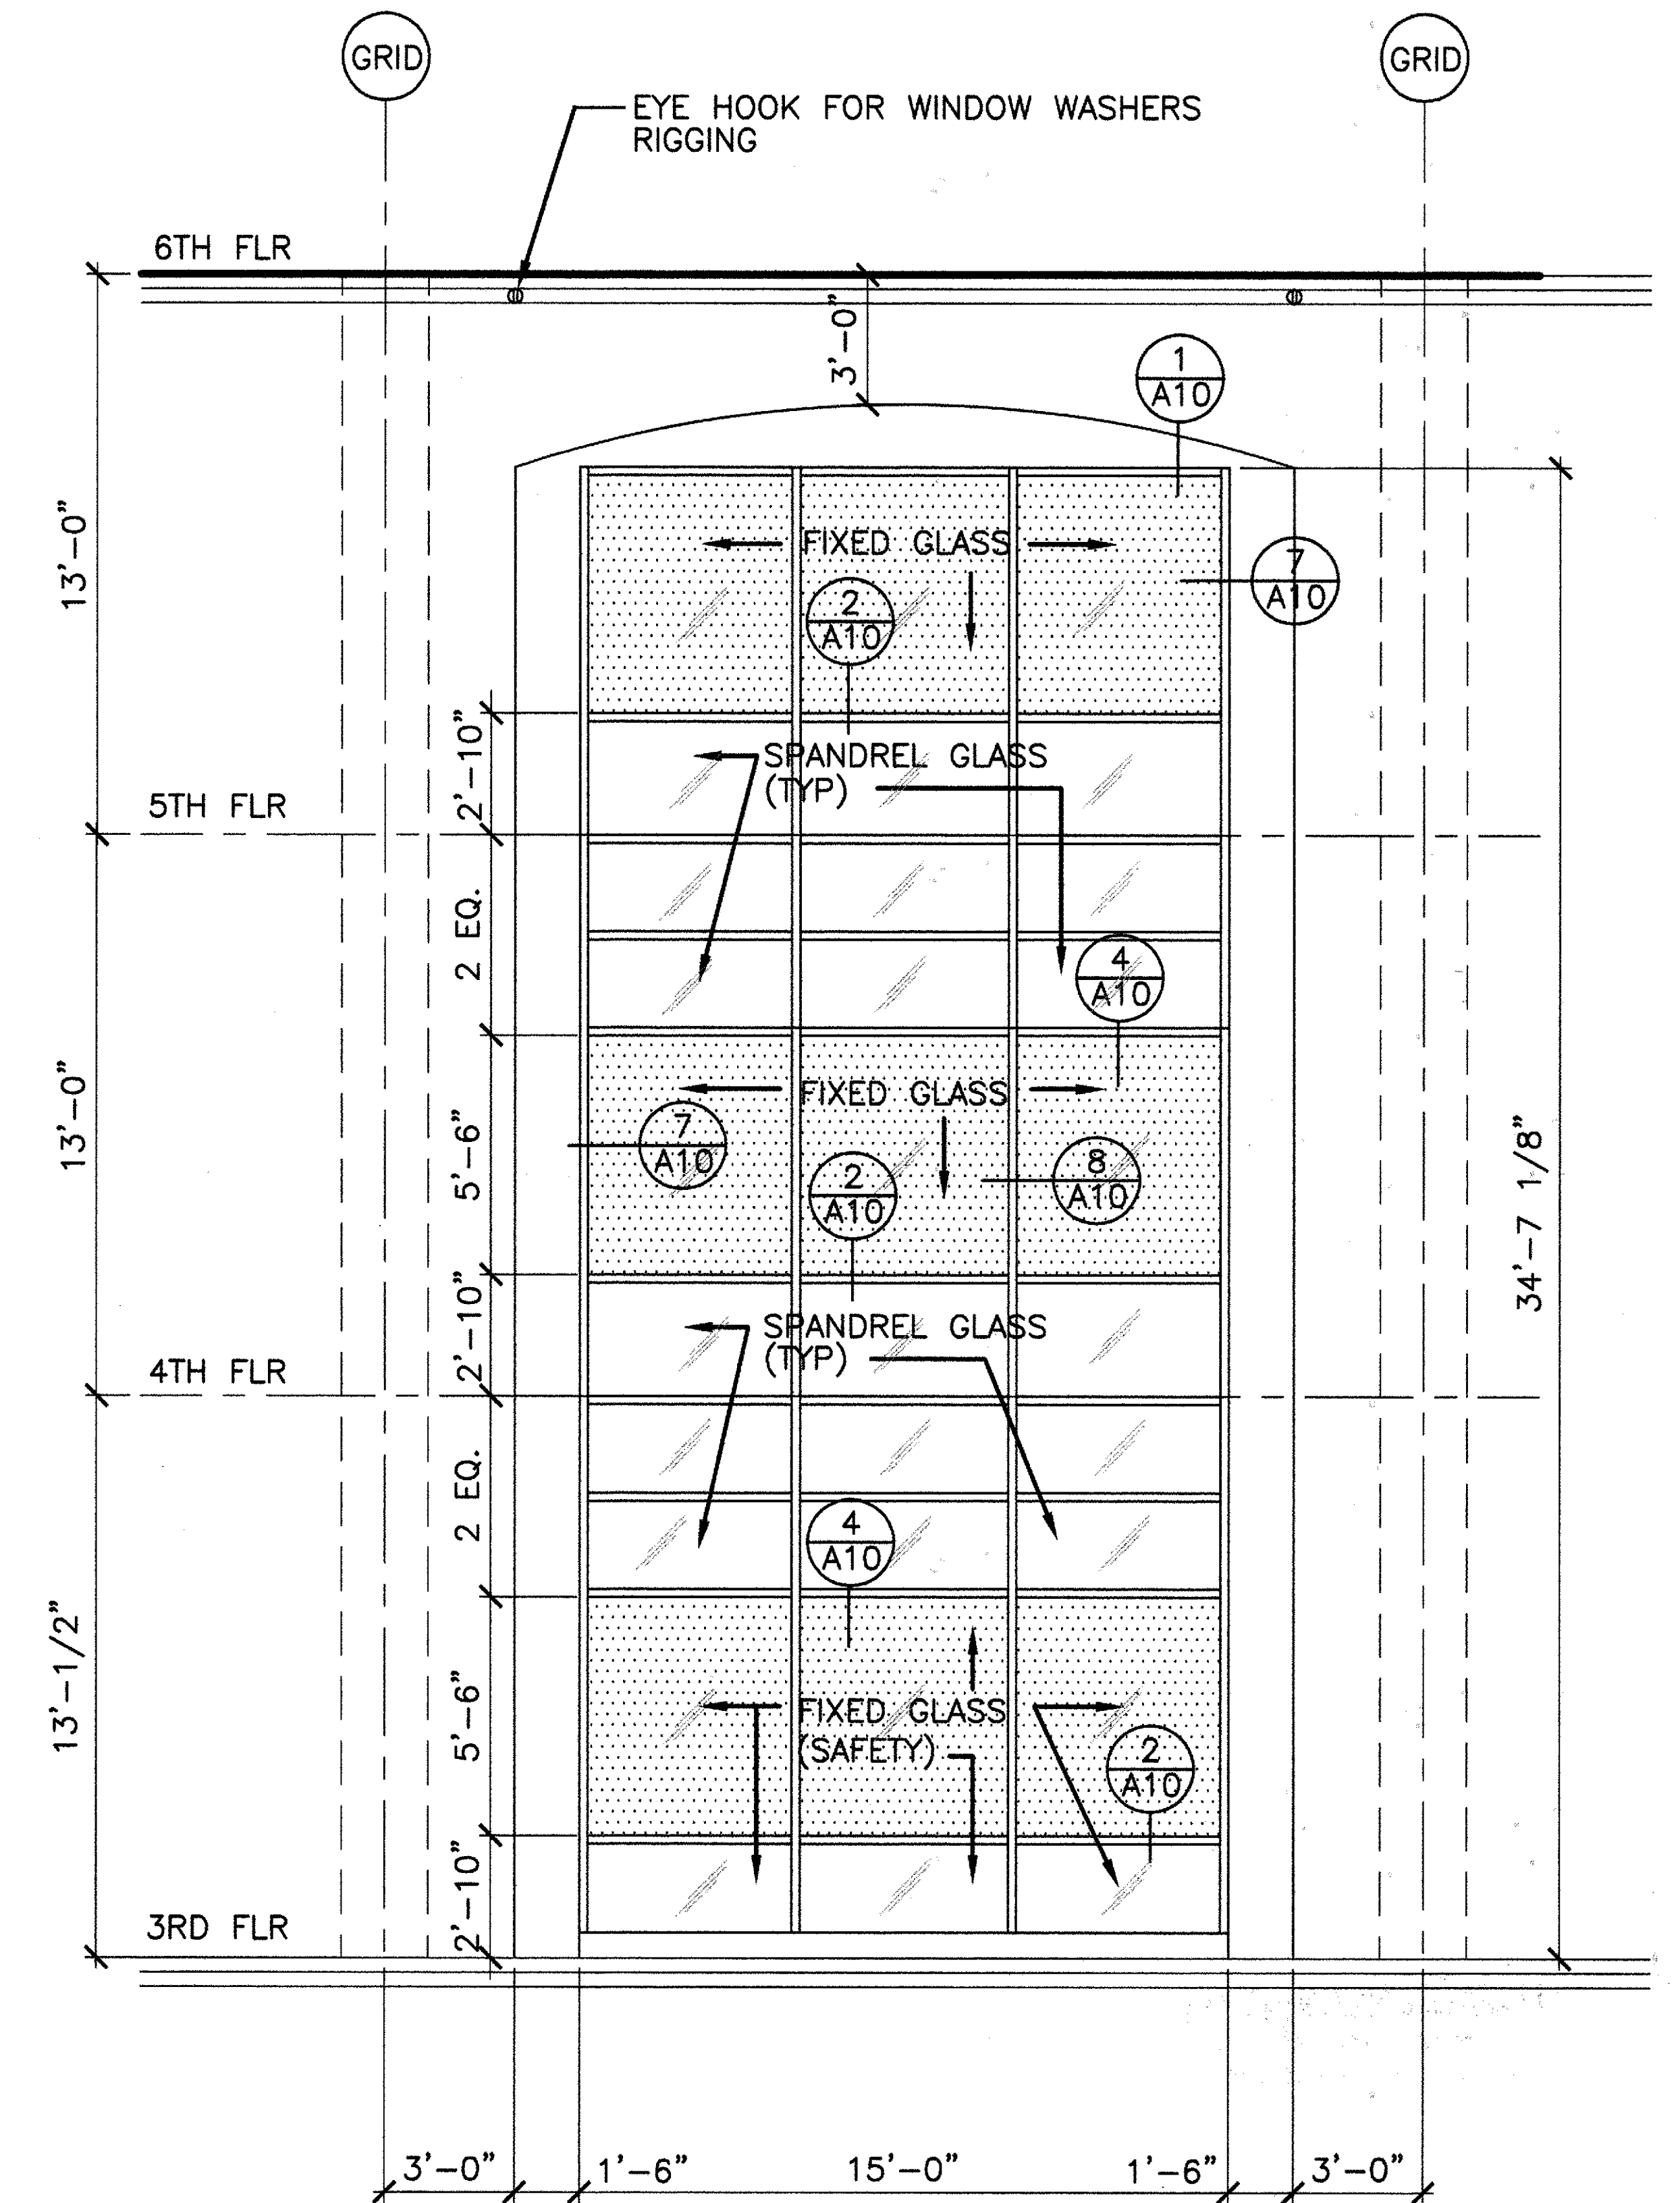

WINDOW TYPE C

DOOR/ WINDOW SCHEDULE

NO.	TYPE	SIZE (WxH)	FRAME MAT'L	GLASS	FRAME DETAILS			REMARKS
					HEAD	JAMB	SILL	
W1	A	15'-0" x 21'-6 5/8"	ALUMINUM	GRAY TINT .71 S.C.	1/A-10	7/A-10	5/A-10	
W2	B	11'-0" x 21'-6 5/8"	ALUMINUM	GRAY TINT .71 S.C.	1/A-10	7/A-10	5/A-10	
W3	C	15'-0" x 34'-7 1/8"	ALUMINUM	GRAY TINT .71 S.C.	1/A-10	7/A-10	9/A-10	
W4	D	15'-0" x 8'-7 1/8"	ALUMINUM	GRAY TINT .71 S.C.	11/A-10	1/A-10	9/A-10	
W5	E	15'-0" x 8'-7 1/8"	ALUMINUM	GRAY TINT .71 S.C.	11/A-10	7/A-10	9/A-10	
W6	F	15'-0" x 8'-7 1/8"	ALUMINUM	GRAY TINT .71 S.C.	13/A-10	7/A-10	9/A-10	
W7	G	15'-0" x 5'-8 5/8"	ALUMINUM	GRAY TINT .71 S.C.	10/A-10	8/A-10	10/A-10	
W8	H	15'-0" x 8'-7 1/8"	ALUMINUM	GRAY TINT .71 S.C.	11/A-10	8/A-10	5/A-10 (SIM)	
W9	J	11'-0" x 8'-7 1/8"	ALUMINUM	GRAY TINT .71 S.C.	11/A-10	7/A-10	5/A-10 (SIM)	
W10	K	11'-0" x 5'-8 5/8"	ALUMINUM	GRAY TINT .71 S.C.	10/A-10	8/A-10	10/A-10	
D1	AA	8'-0" x 8'-0"	ALUMINUM	GRAY TINT .71 S.C.	14/A-10	15/A-10	16/A-10	

AS BUILT DRAWING


SEP 8 2008
KKK ALUMINUM & GLASS INC.
 746 Kopke Street
 Honolulu, Hawaii 96819

NOTE: STIPPLED AREA INDICATES APPLICATION OF PROTECTIVE TINTING TO INTERIOR SURFACE OF WINDOW AND DOOR GLAZING.


GRAPHIC SCALE

1/4" = 1'-0"


POST APP-1	REVISED	DAGS JOB NO	9/11	10/05/07
REVISION NO.	SYMBOL	DESCRIPTION	SHEET OF	DATE
APPROVED:		PUBLIC WORKS ADMINISTRATOR		
DEPARTMENT OF ACCOUNTING & GENERAL SERVICES STATE OF HAWAII KAKUHIHEWA BUILDING INSTALL PROTECTIVE TINTING KAPOLEI OAHU HAWAII				
DOOR/ WINDOW SCHEDULE AND TYPES				
MITSUNAGA & ASSOC., INC. DESIGNED BY: SW CHECKED BY: SW DATE: JULY 2007		DAGS JOB NO. 62-10-0515 42-10-0443 SHEET 9 OF 11 SHES		

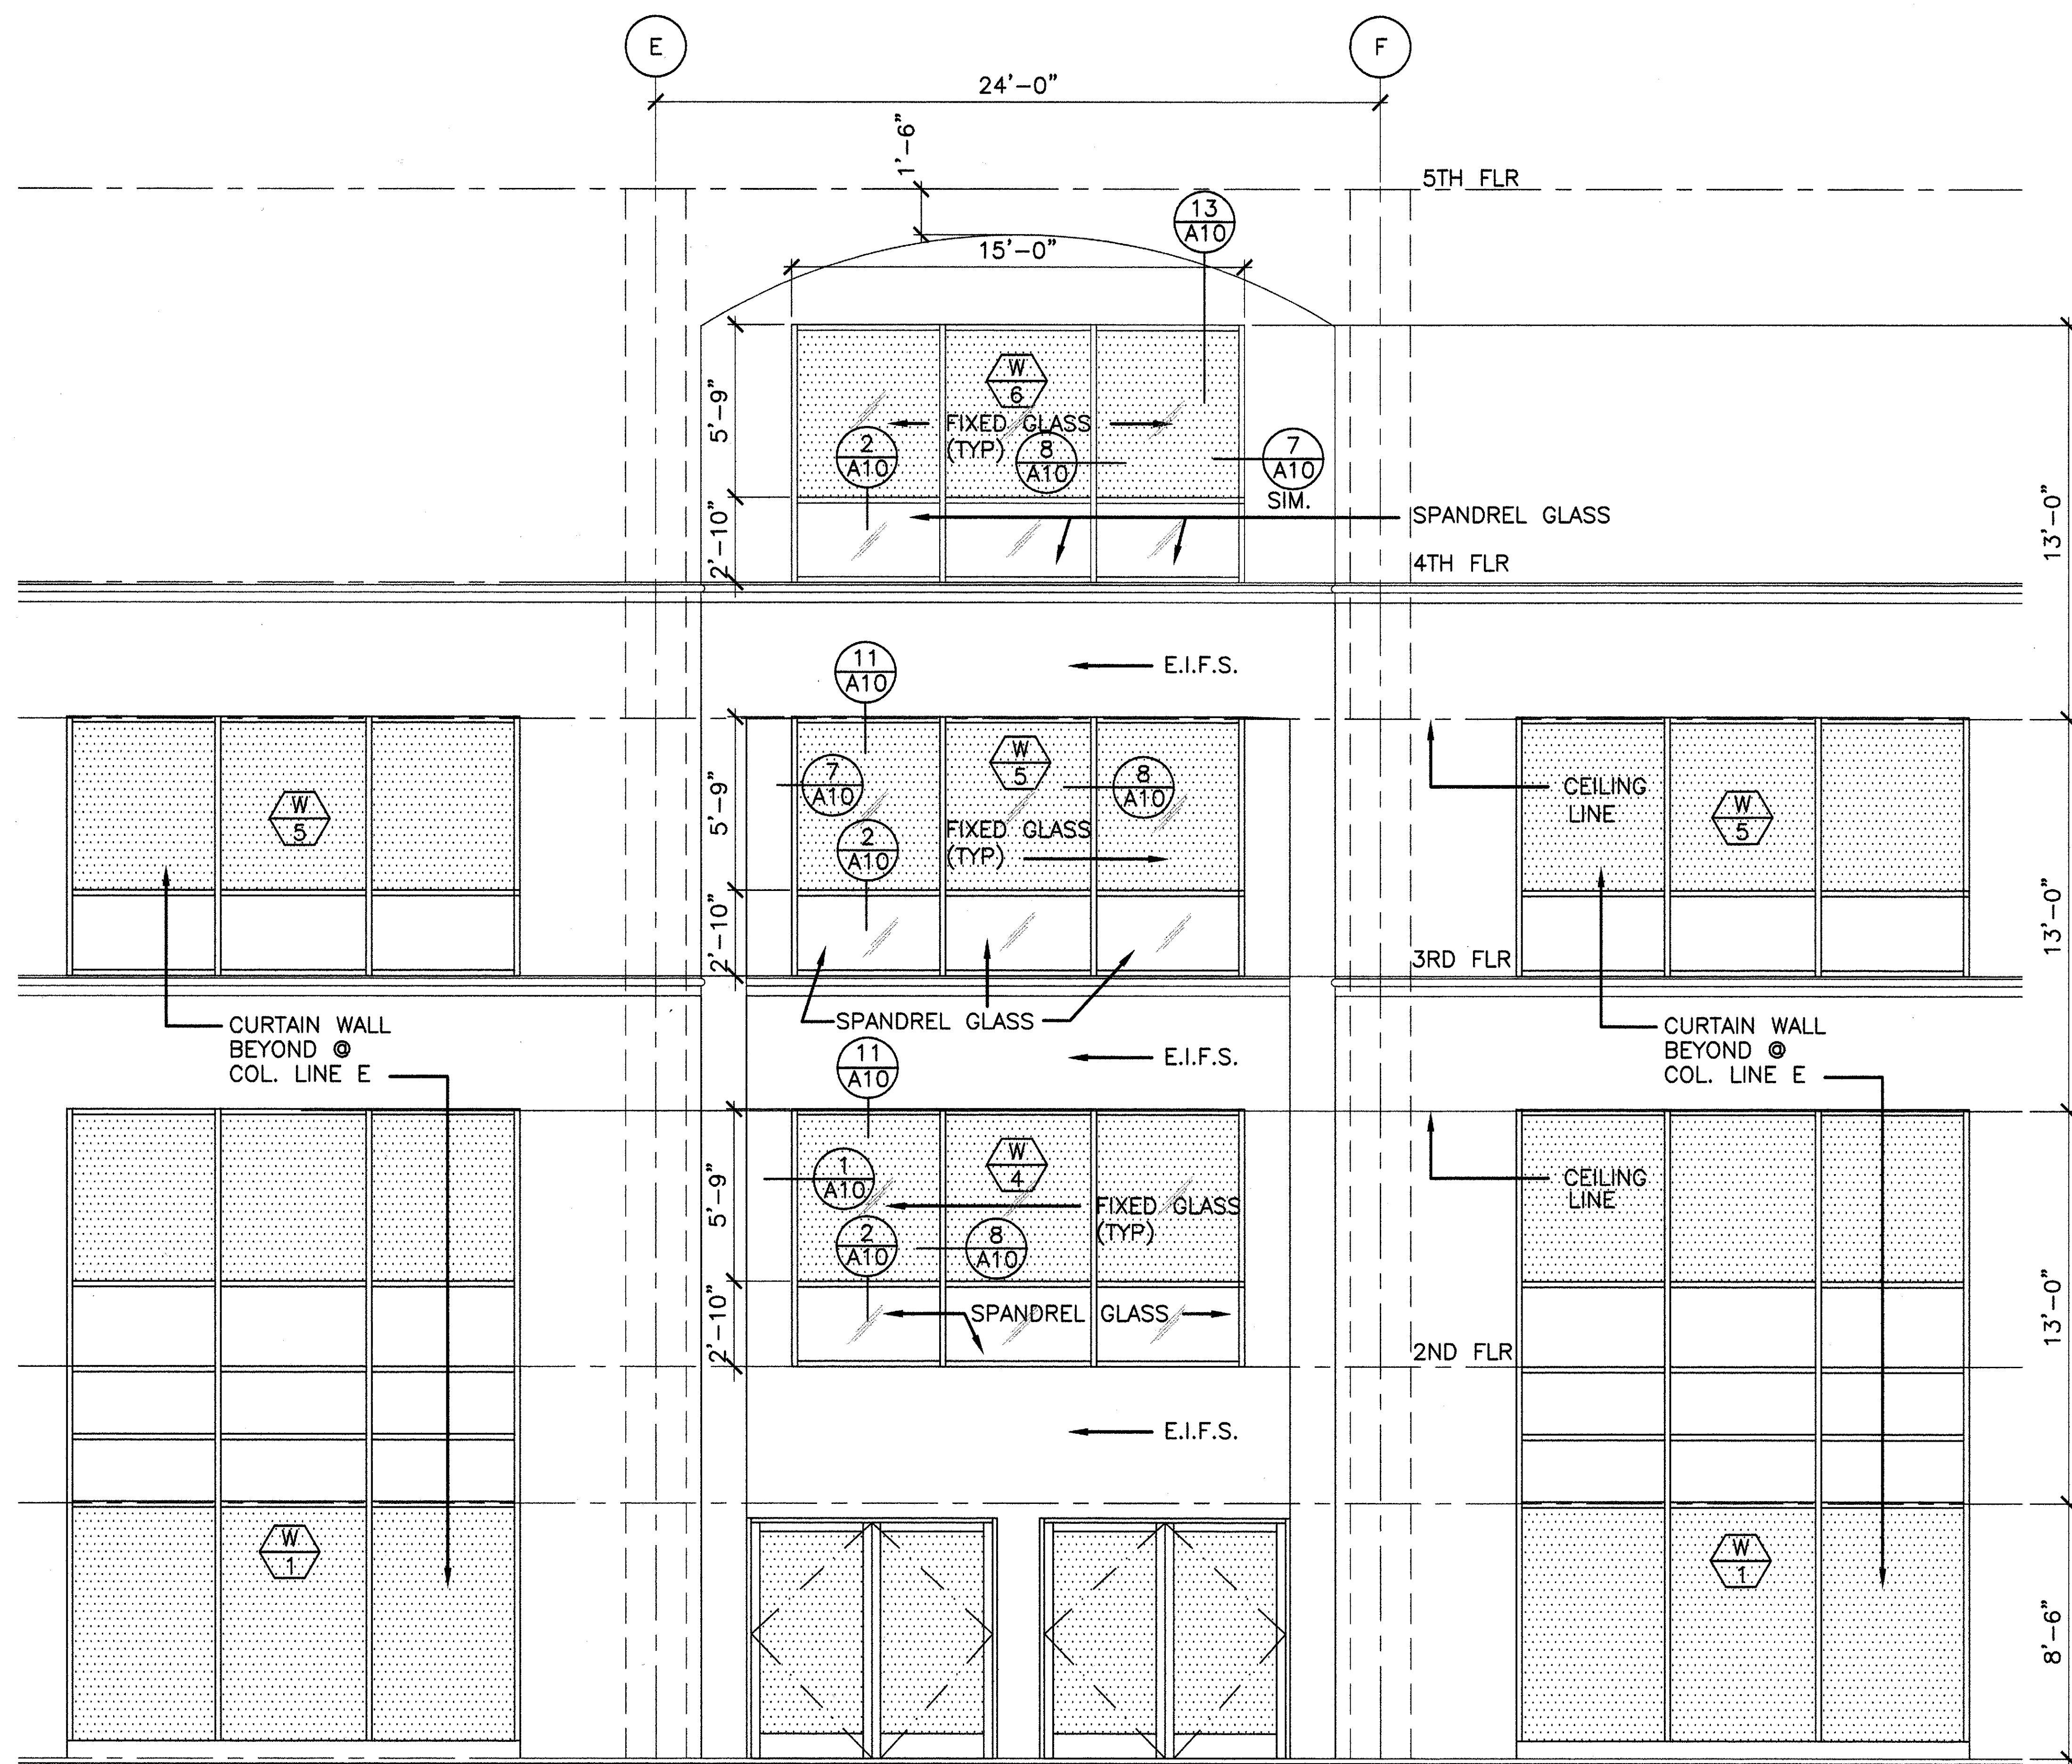


WINDOW TYPE D, E, & F

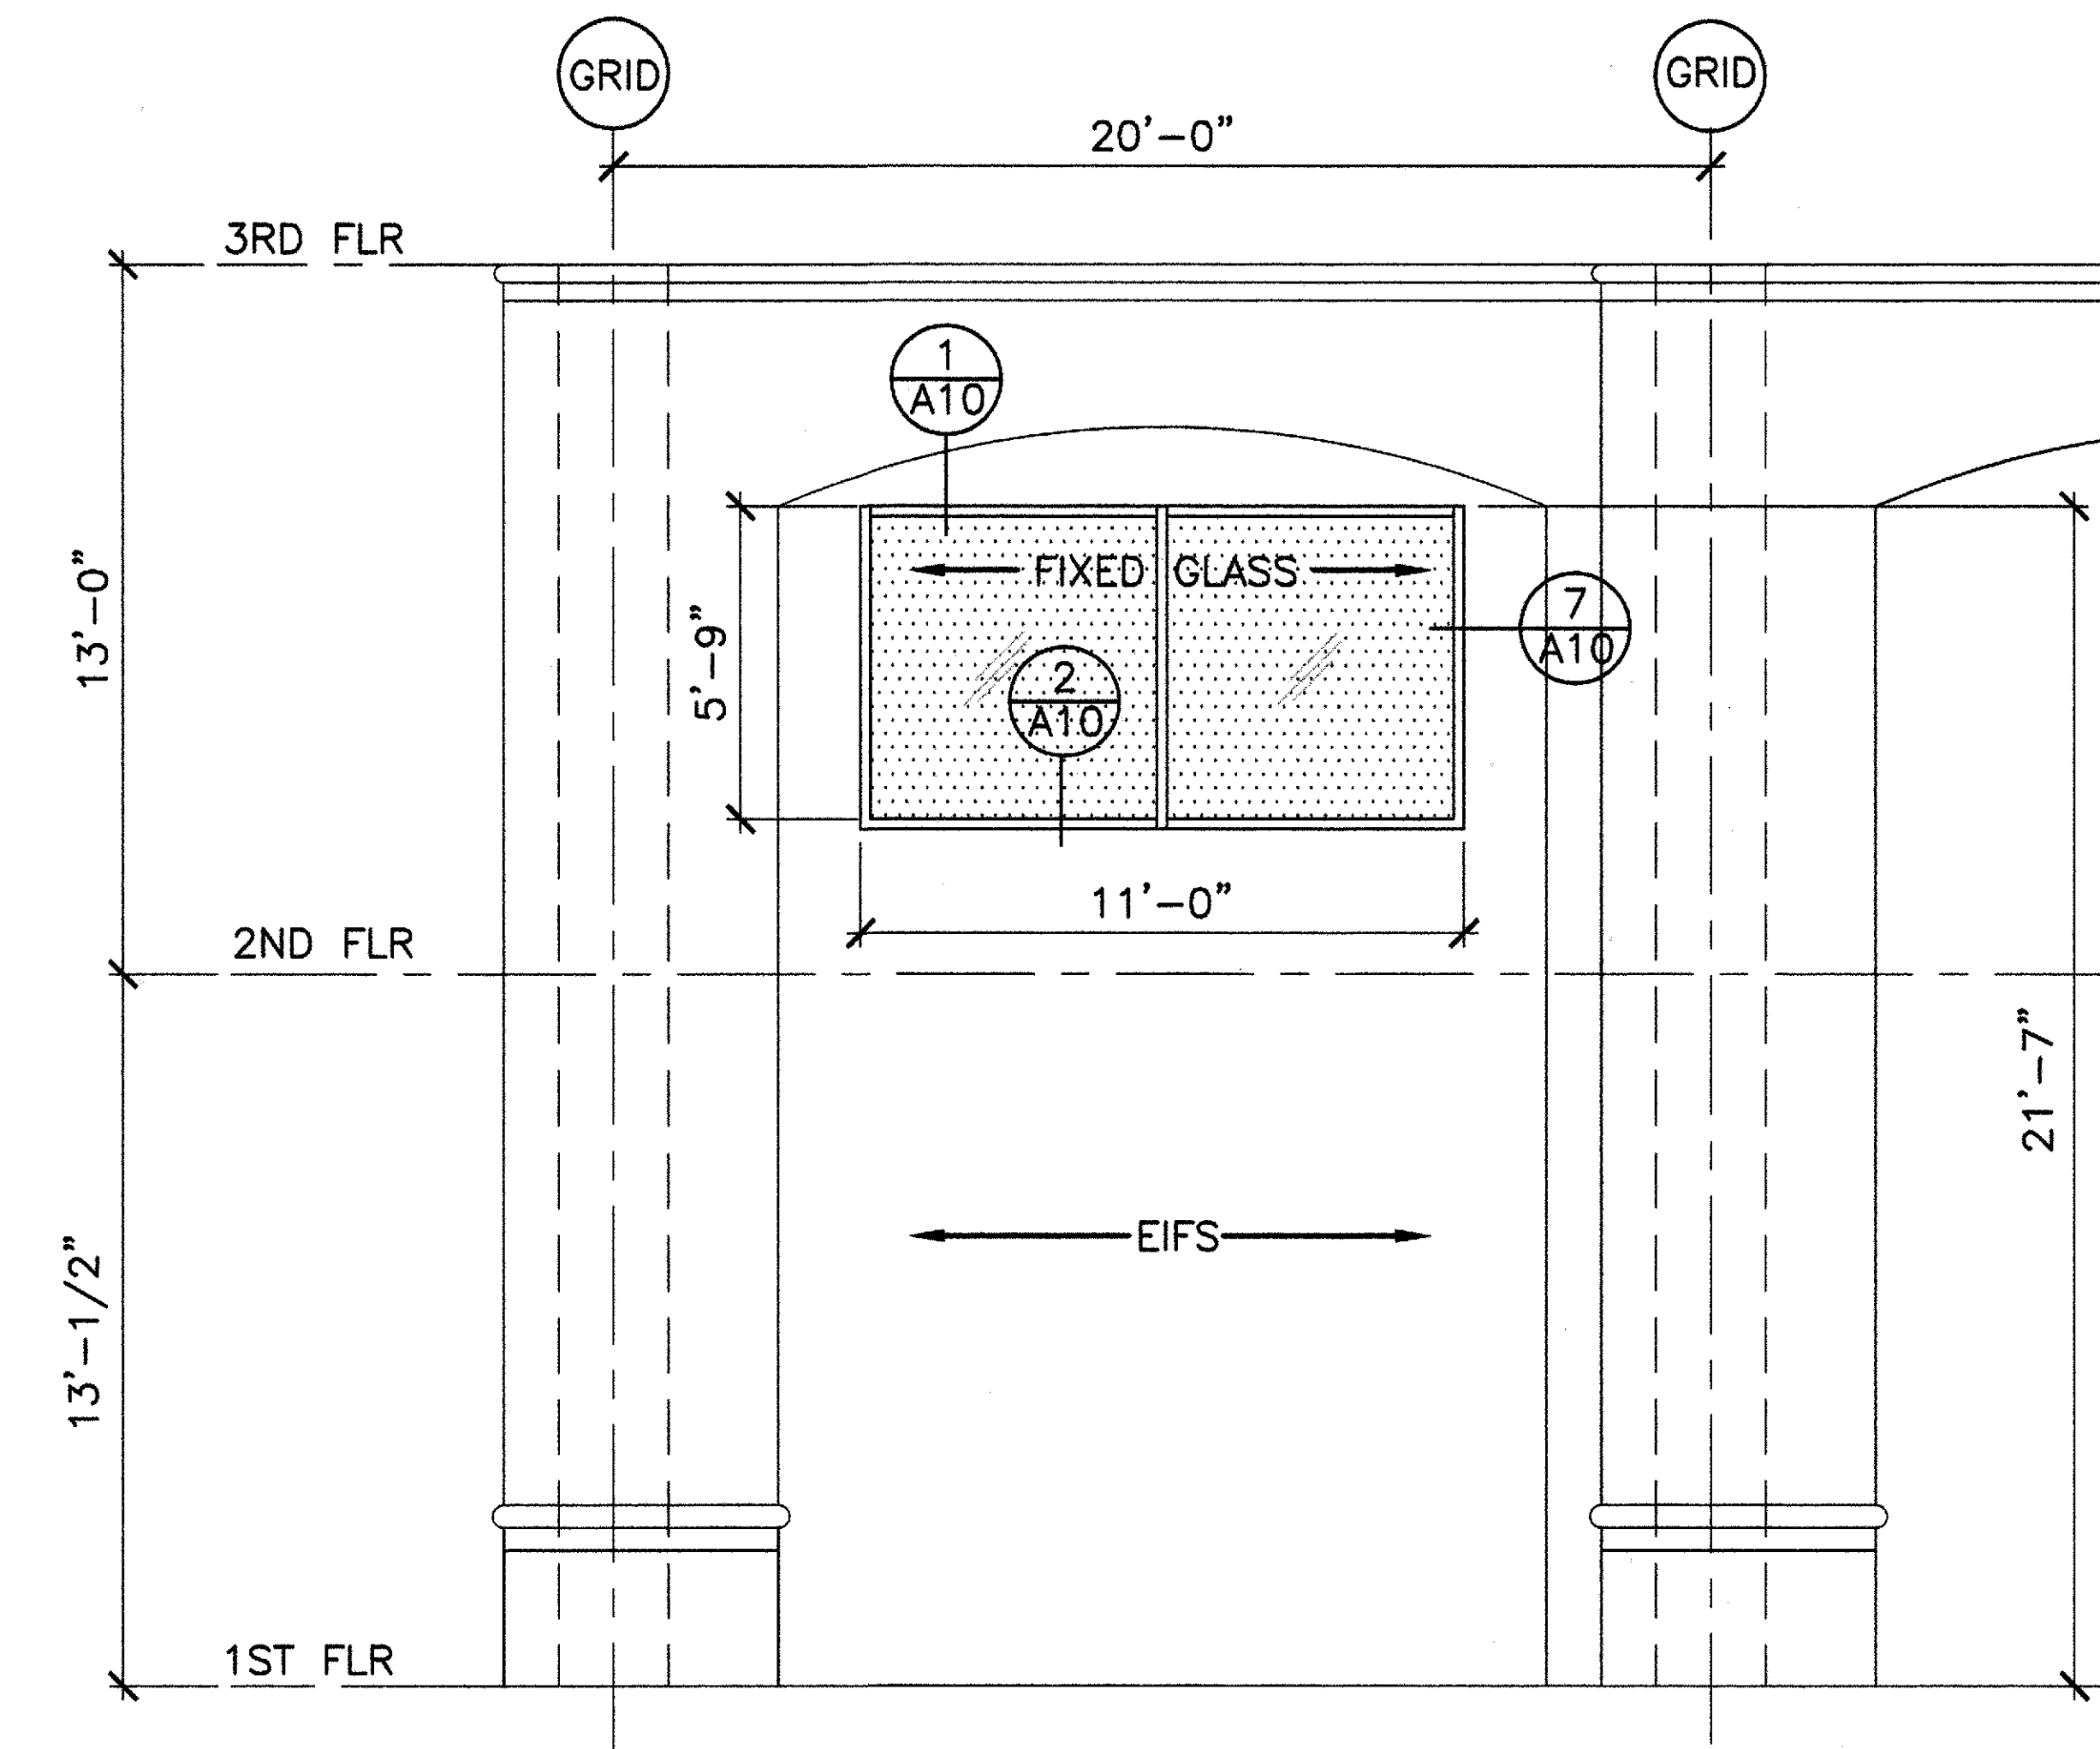


WINDOW TYPE K

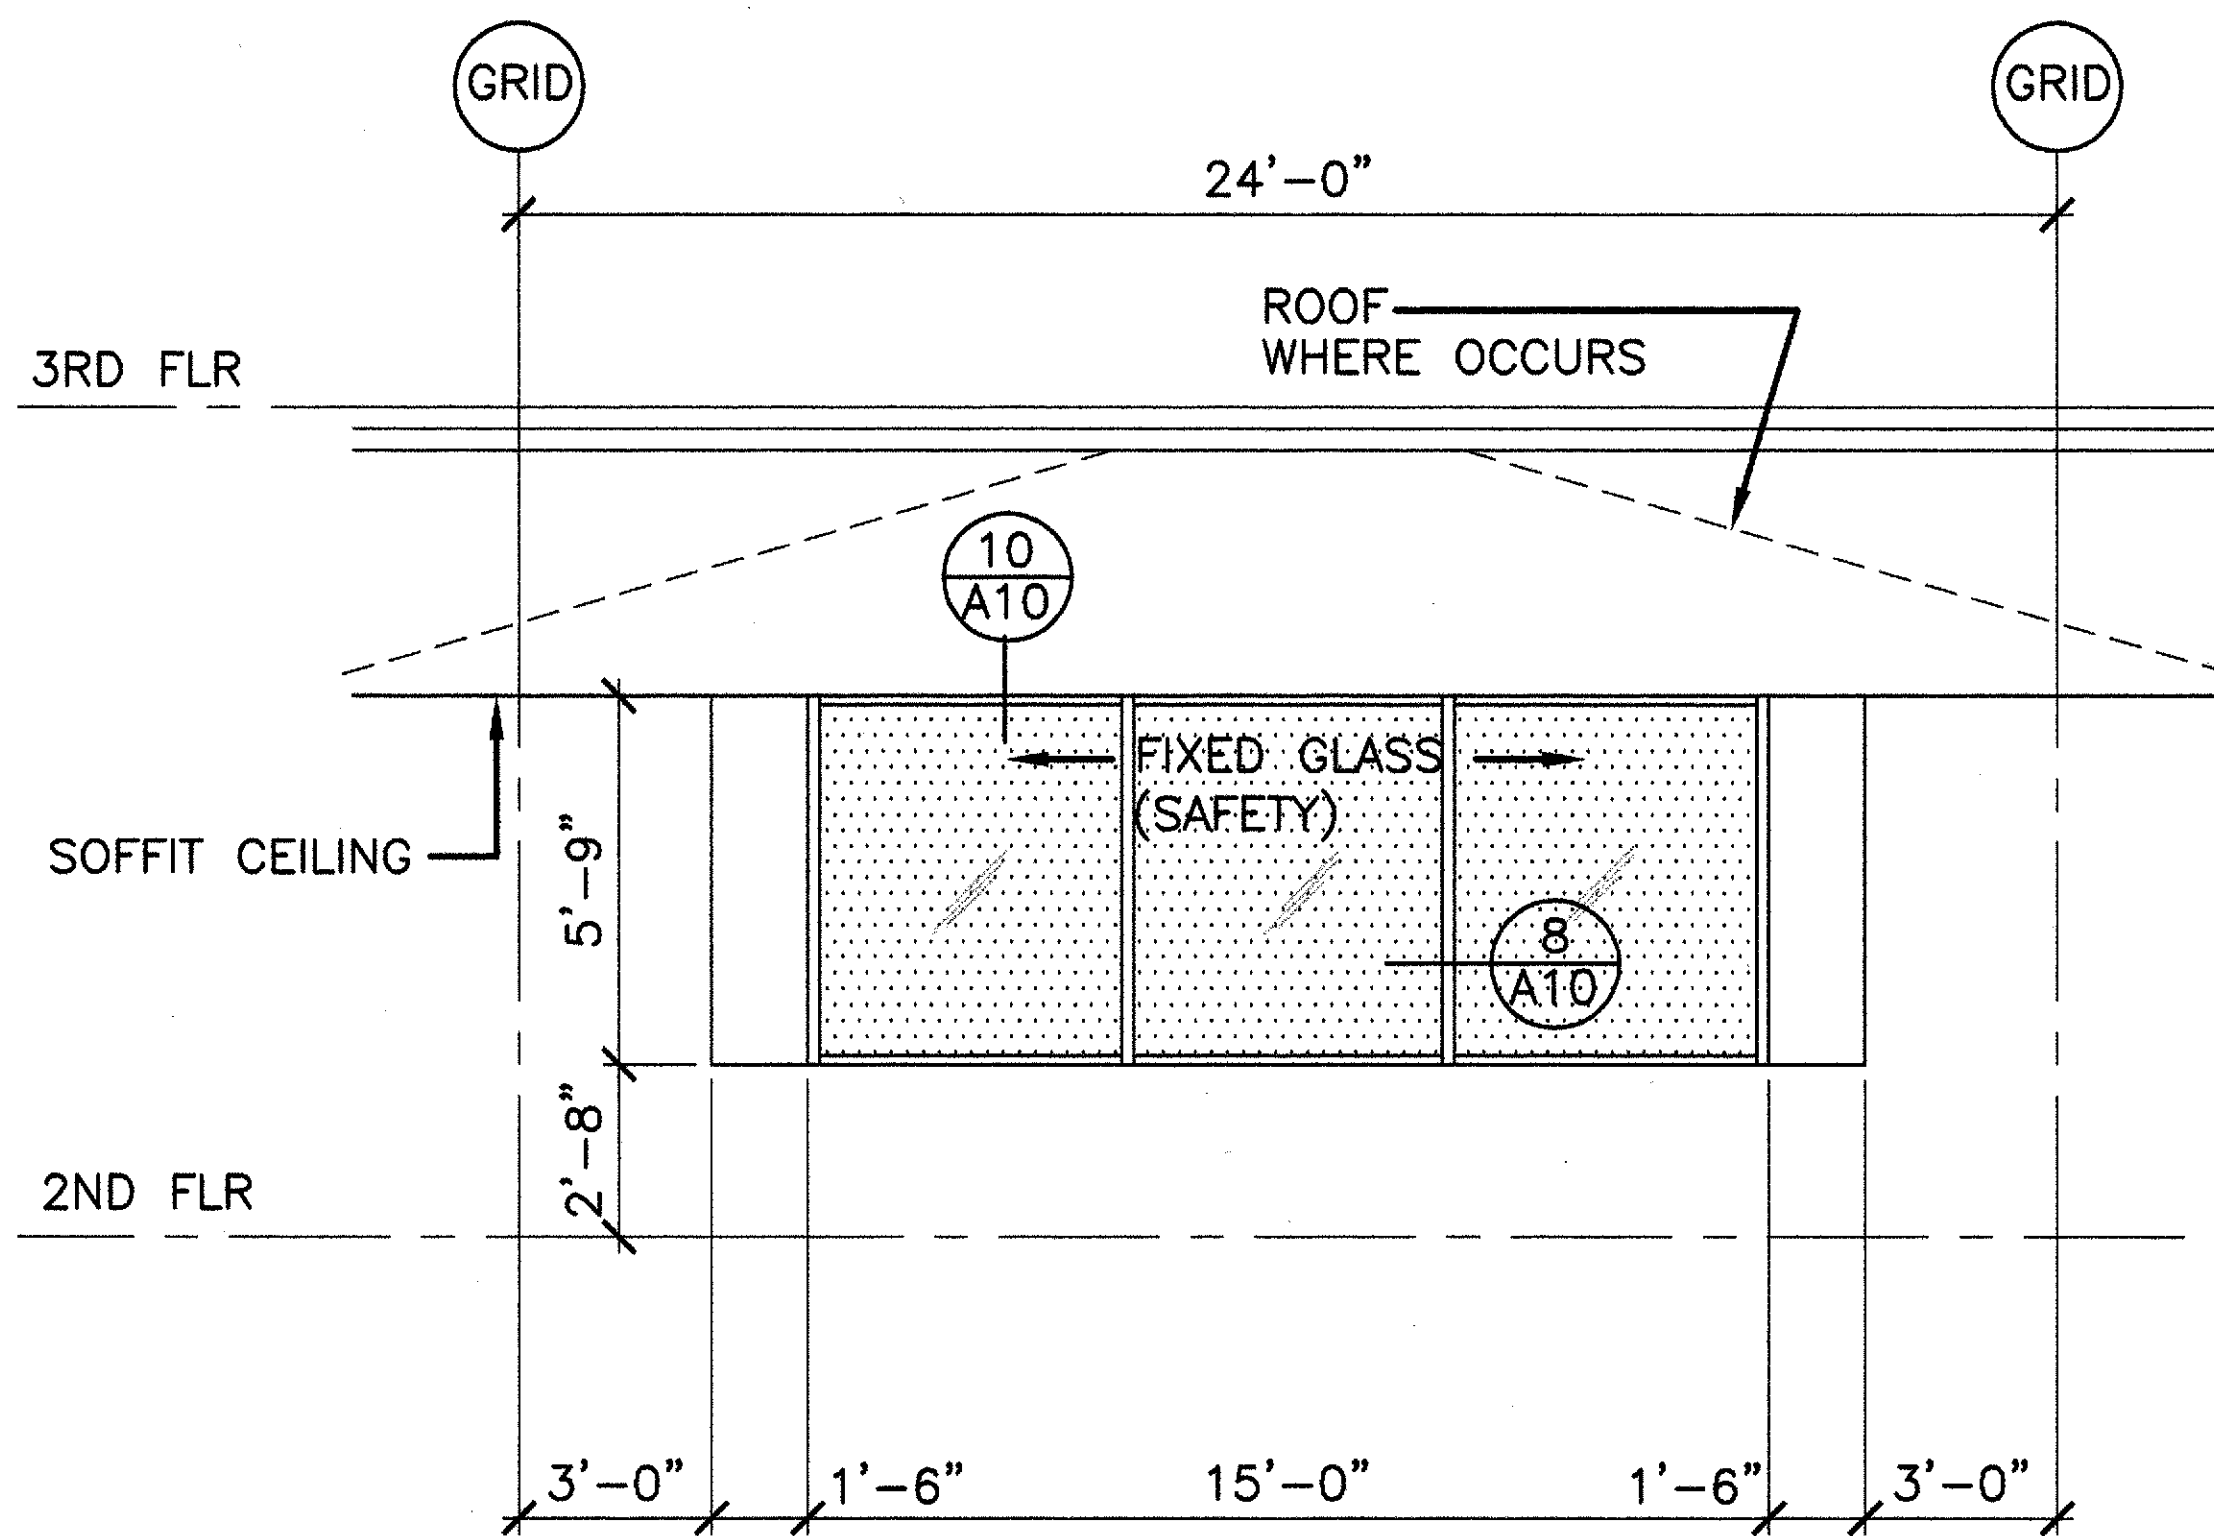

WINDOW TYPE G

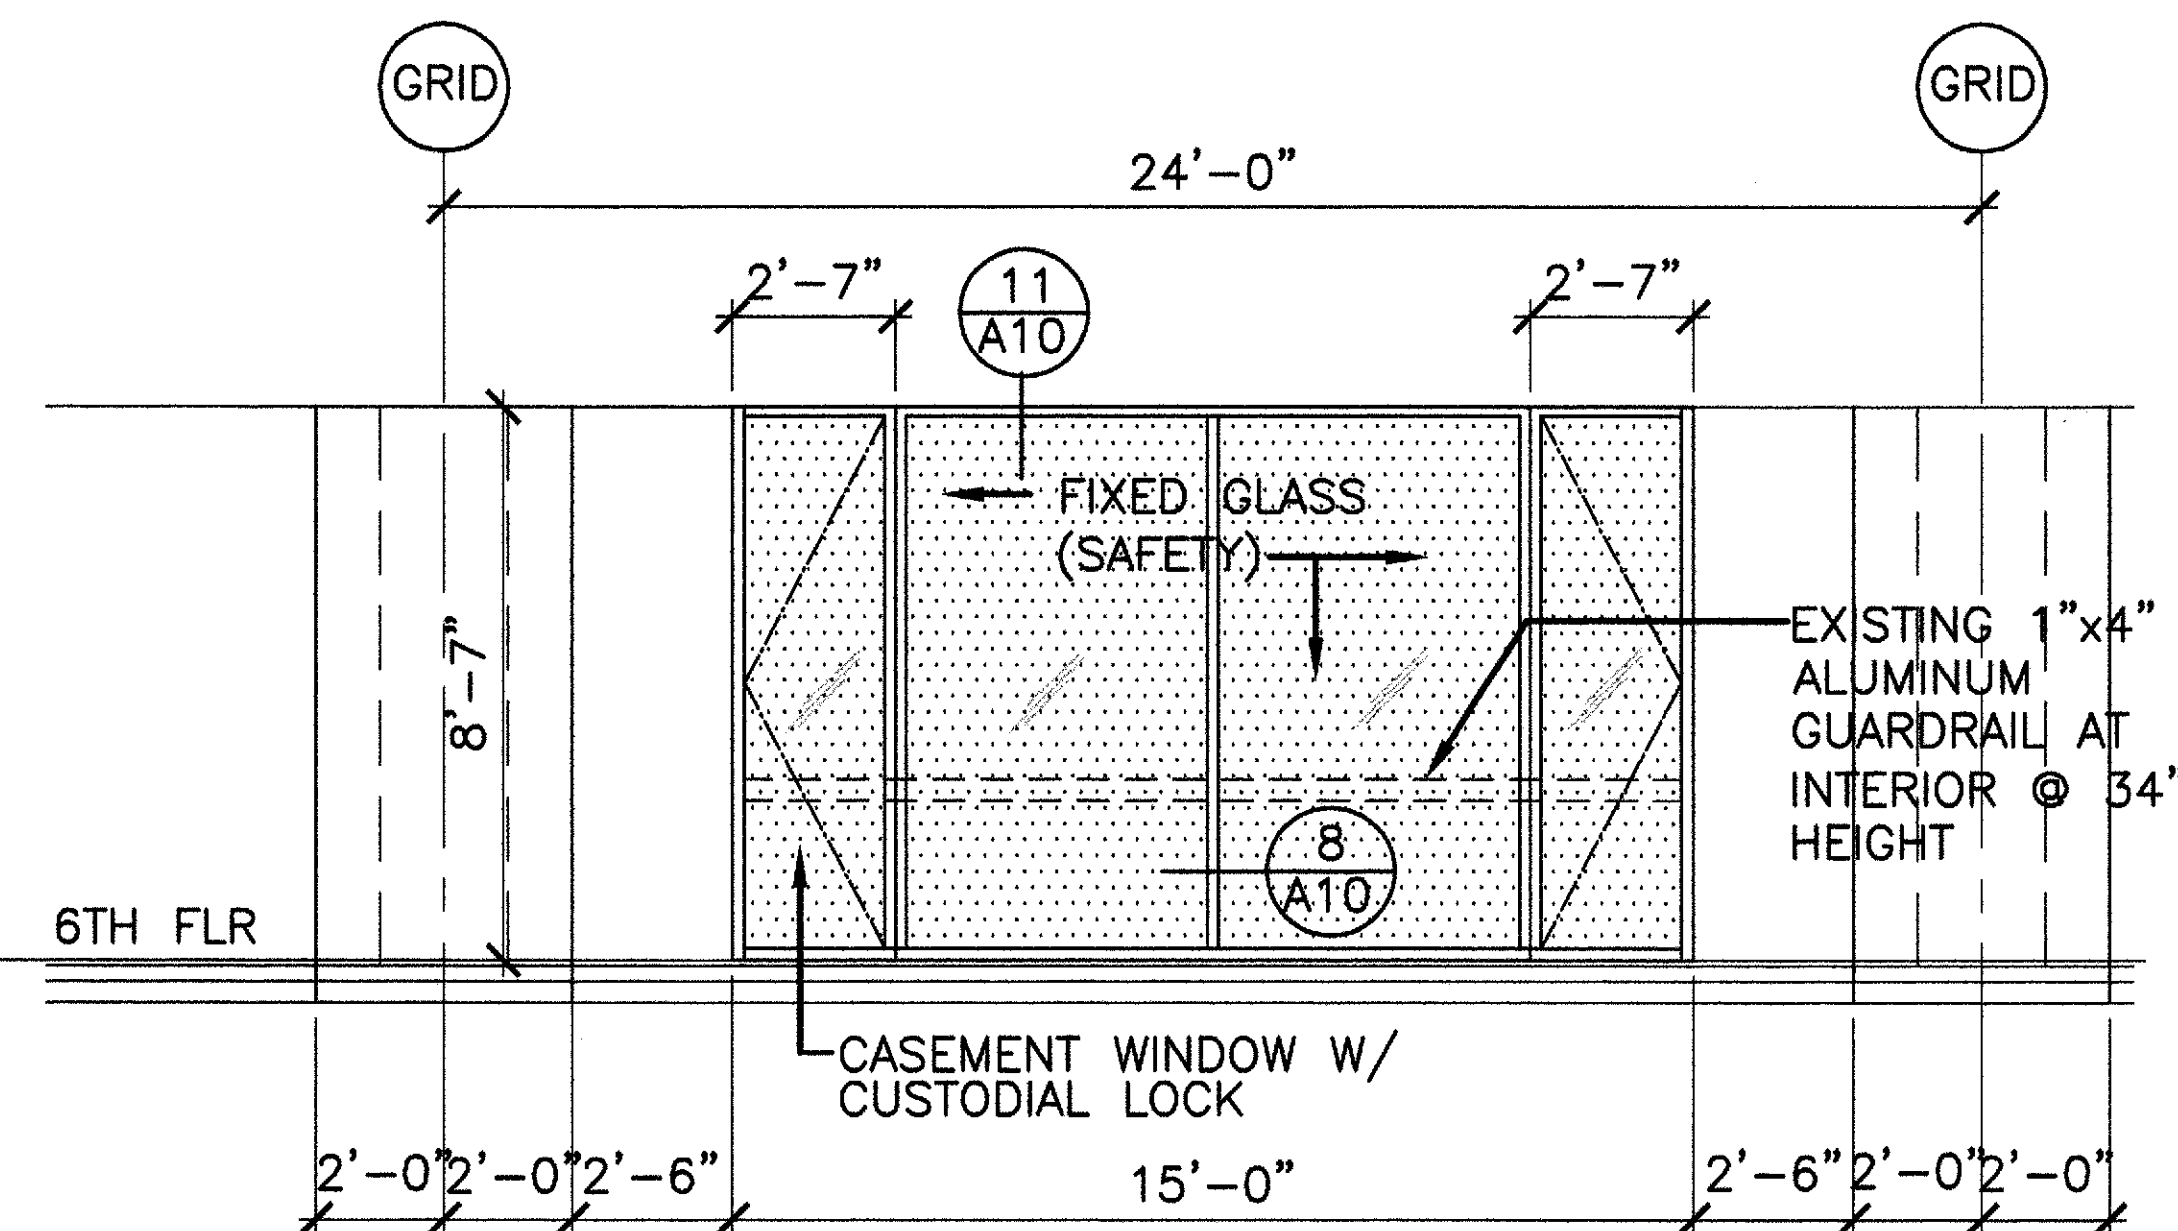

WINDOW TYPE H

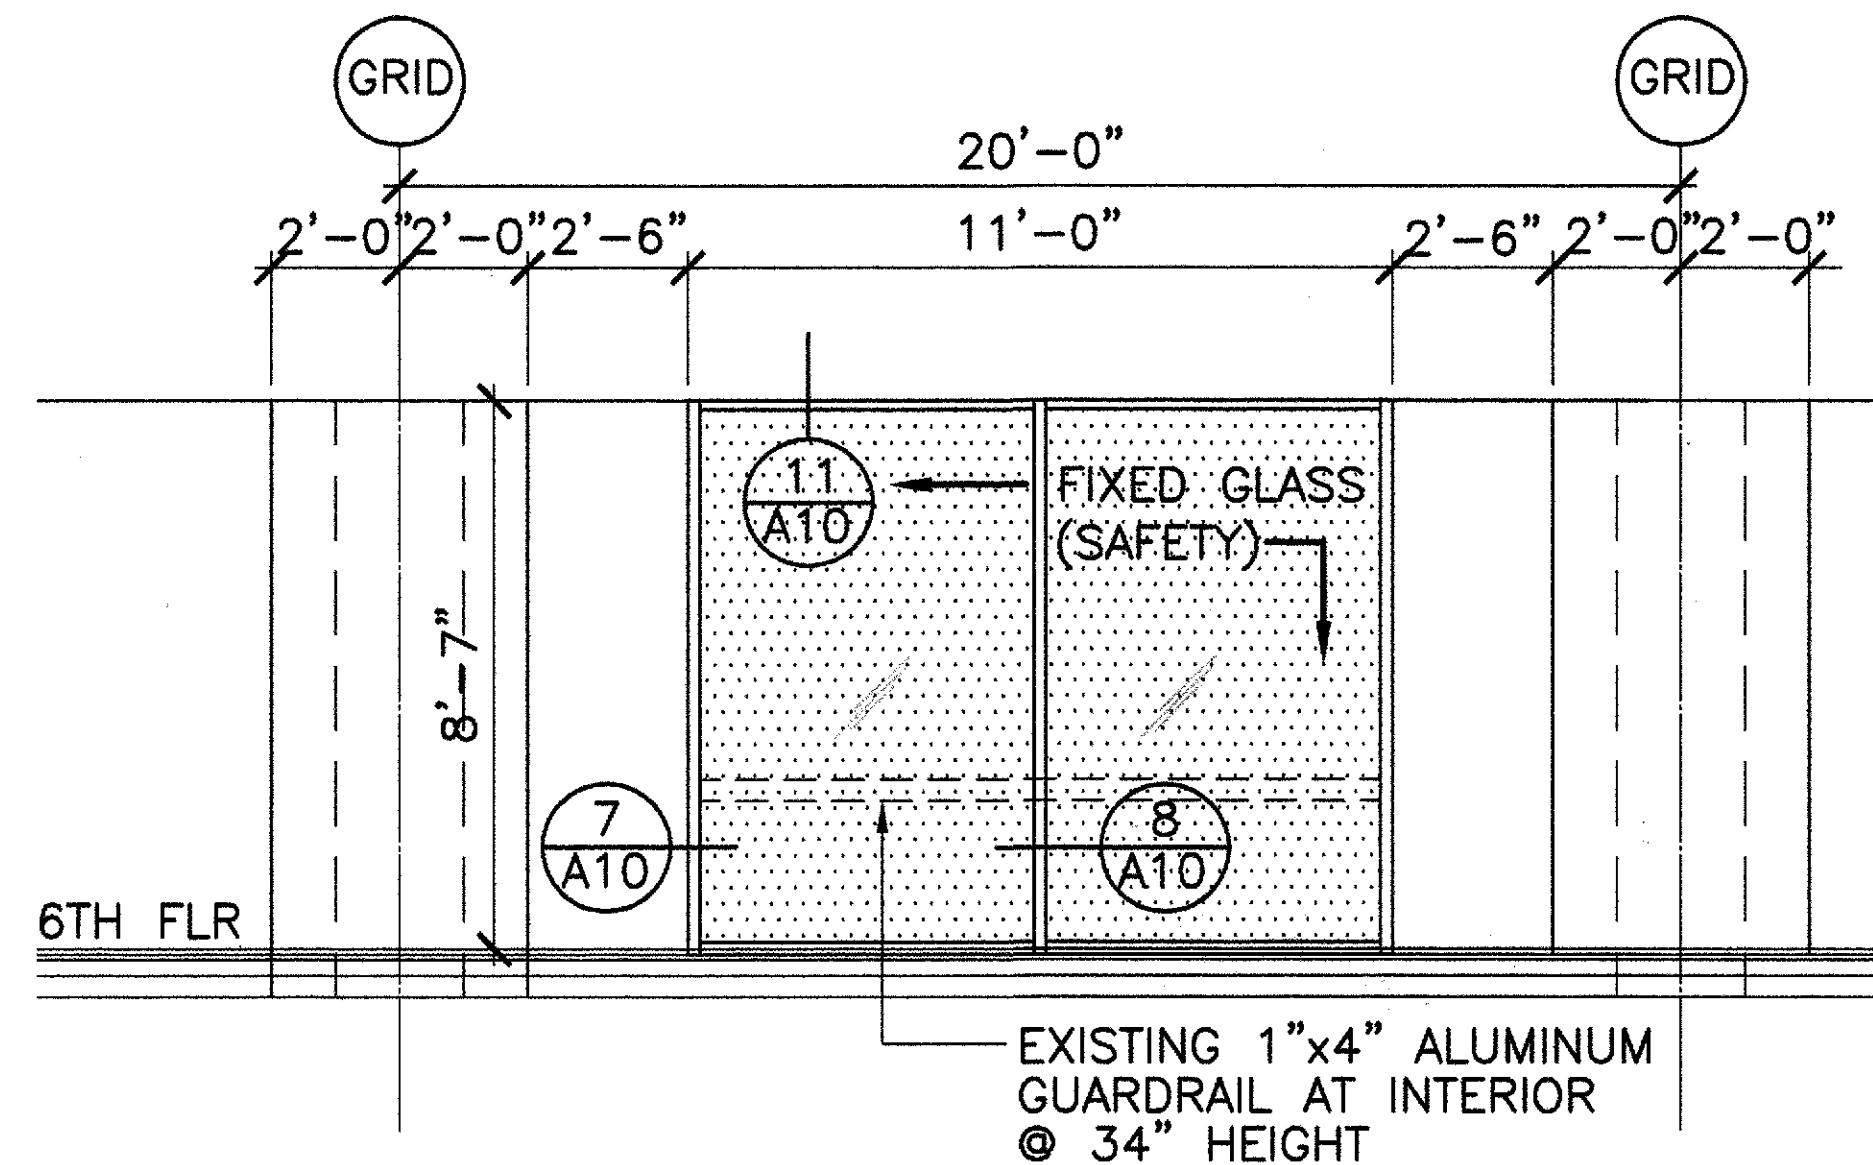

WINDOW TYPE J

AS BUILT DRAWING


SEP. 8 2008
KKK ALUMINUM & GLASS INC.
746 Kopke Street
Honolulu, Hawaii 96819

NOTE: STIPPLED AREA INDICATES APPLICATION OF PROTECTIVE TINTING TO INTERIOR SURFACE OF WINDOW AND DOOR GLAZING.

GRAPHIC SCALE

1/4" = 1'-0" 5' 0' 5'

POST	REVISED	DATE	JOB NO	10/11	10/09/07
ADD-1					
REVISION	SYMBOL	DESCRIPTION	SHEET	DATE	APPROVED
NO.			OF		PUBLIC WORKS ADMINISTRATOR

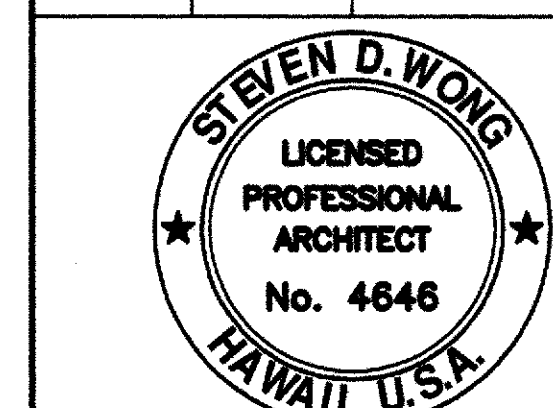

THIS WORK WAS PREPARED BY ME OR UNDER MY SUPERVISION AND CONSTRUCTION OF THIS PROJECT WILL BE UNDER MY OBSERVATION, (OBSERVATION OF CONSTRUCTION AS DEFINED IN CHAPTER 16-112, SUBCHAPTER 1, DEFINITIONS, OF THE HAWAII ADMINISTRATIVE RULES, PROFESSIONAL ENGINEERS, ARCHITECTS, SURVEYORS, AND LANDSCAPE ARCHITECTS) EXPIRATION DATE: 4-30-08
MITSUNAGA & ASSOC., INC.

DEPARTMENT OF ACCOUNTING & GENERAL SERVICES STATE OF HAWAII	
KAKUHIHEWA BUILDING INSTALL PROTECTIVE TINTING	
KAPOLEI	OAHU HAWAII
DOOR TYPES	
MITSUNAGA & ASSOC., INC.	DAGS JOB NO. 62-10-0515 42-10-0443
DESIGNED BY: SW	CHECKED BY: SW
DRAWN BY: CAD	APPROVED BY: SW
SCALE: AS NOTED	DATE: JULY 2007
FILE: 4	DRAWER: 2 FOLDER: 5

DRAWING NO. A-9
SHEET 10 OF 11 SHES