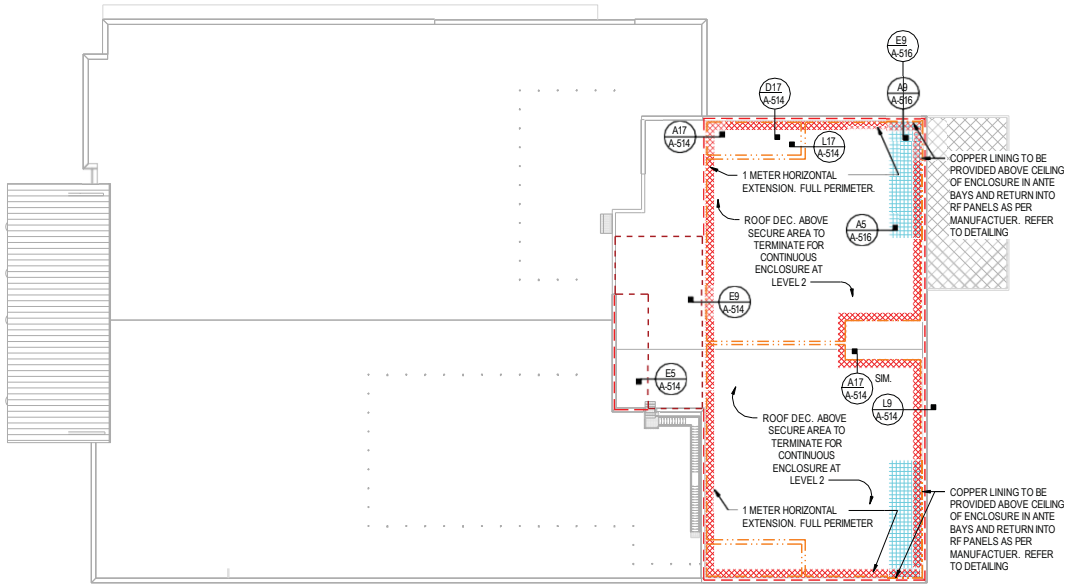

H1 2ND FLOOR ROOF SECURE PERIMETER / SHIELDING PLAN

3/64" = 1'-0"

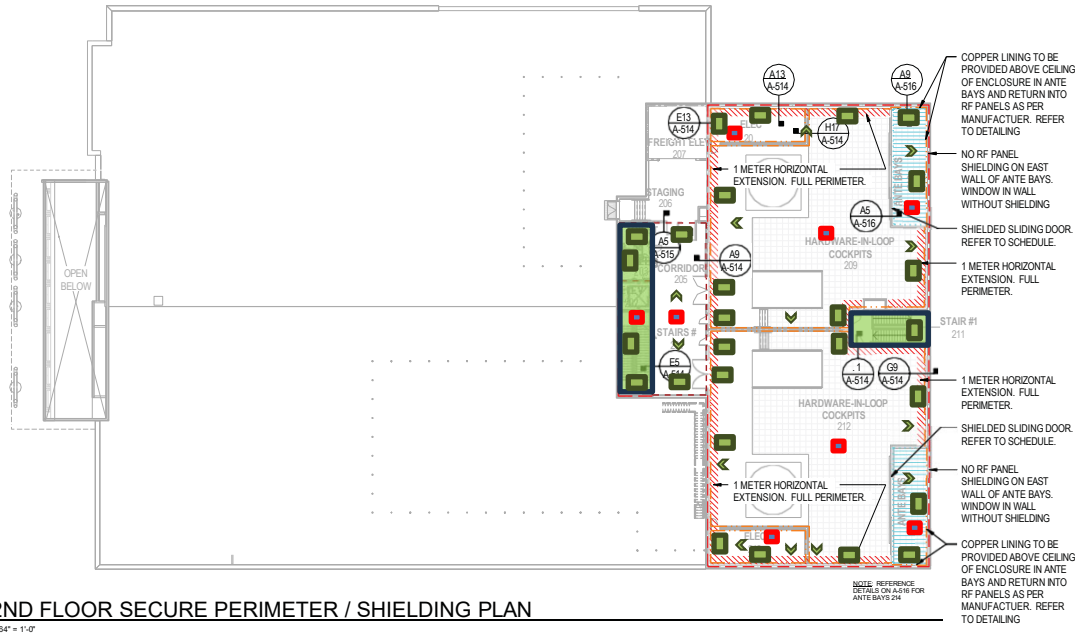

A1 2ND FLOOR SECURE PERIMETER / SHIELDING PLAN

3/64" = 1'-0"

Indicates wall / door test point area

Indicates ceiling /floor test point area

Indicates direction of test points

PLAN NORTH

SHIELDING LEGEND

- SECURED AREA PERIMETER ICD/ICS 705 w/ RF SHIELDING
- SECURED AREA PERIMETER ICD/ICS 705 WALL TYPE A
- RF SHIELDED 11 GA
- COPPER LINING RF SHIELDING
- COPPER LINING RF SHIELDING AT FLOOR - INCLUSIVE BELOW RAISED ACCESS FLOORING - 1 METER MINIMUM.
- RF SHIELDED 11 GA AT FLOOR
- COPPER LINING RF SHIELDING AT ROOF - 1 METER MINIMUM
- RF SHIELDED 11 GA BELOW ROOF

AS-BUILT RECORD DRAWING

THIS RECORD DRAWINGS HAS BEEN PREPARED, IN PART, BASED UPON INFORMATION FURNISHED BY OTHERS. WHILE THIS INFORMATION IS BELIEVED TO BE RELIABLE, THE ARCHITECT/ENGINEER ASSUMES NO RESPONSIBILITY FOR ITS ACCURACY. NO THE RECORD DRAWING OR RECORD SPECIFICATIONS OR FOR ANY ERRORS OR OMISSIONS THAT MAY HAVE BEEN INCORPORATED INTO IT AS A RESULT OF INCORRECT INFORMATION PROVIDED TO THE ARCHITECT/ENGINEER. THOSE RELYING ON THIS RECORD DOCUMENT ARE ADVISED TO OBTAIN INDEPENDENT VERIFICATION OF ITS ACCURACY.

KEY PLAN

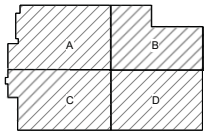

AS-BUILT

US Army &orSs of Engineers ®

MARK	DESCRIPTION	DATE

ISSUE DATE: SEPTEMBER 22, 2021
SOLICITATION NO.: W912PL-20-R-0003
CONTRACT NO.: W912PL-20-C-0030

DESIGNED BY: ES
DRAWN BY: AL
CHECKED BY: MR
SUBMITTED BY: PP
SIZE: ANSI D

US ARMY CORPS OF ENGINEERS
LOS ANGELES DISTRICT
915 WILSHIRE BLVD, SUITE 930, LOS ANGELES, CALIFORNIA 90017

THE KORTE COMPANY
12441 US HIGHWAY 40 HIGHLAND, IL 62249

EDWARDS AIR FORCE BASE, CALIFORNIA
- CONT SIMULATION ENVIRONMENT FACILITY
476162

2ND FLOOR SECURE PERIMETER / SHIELDING PLANS

SHEET ID
A120S

RECORD DRAWINGS AS-BUILT - 2024 04 17