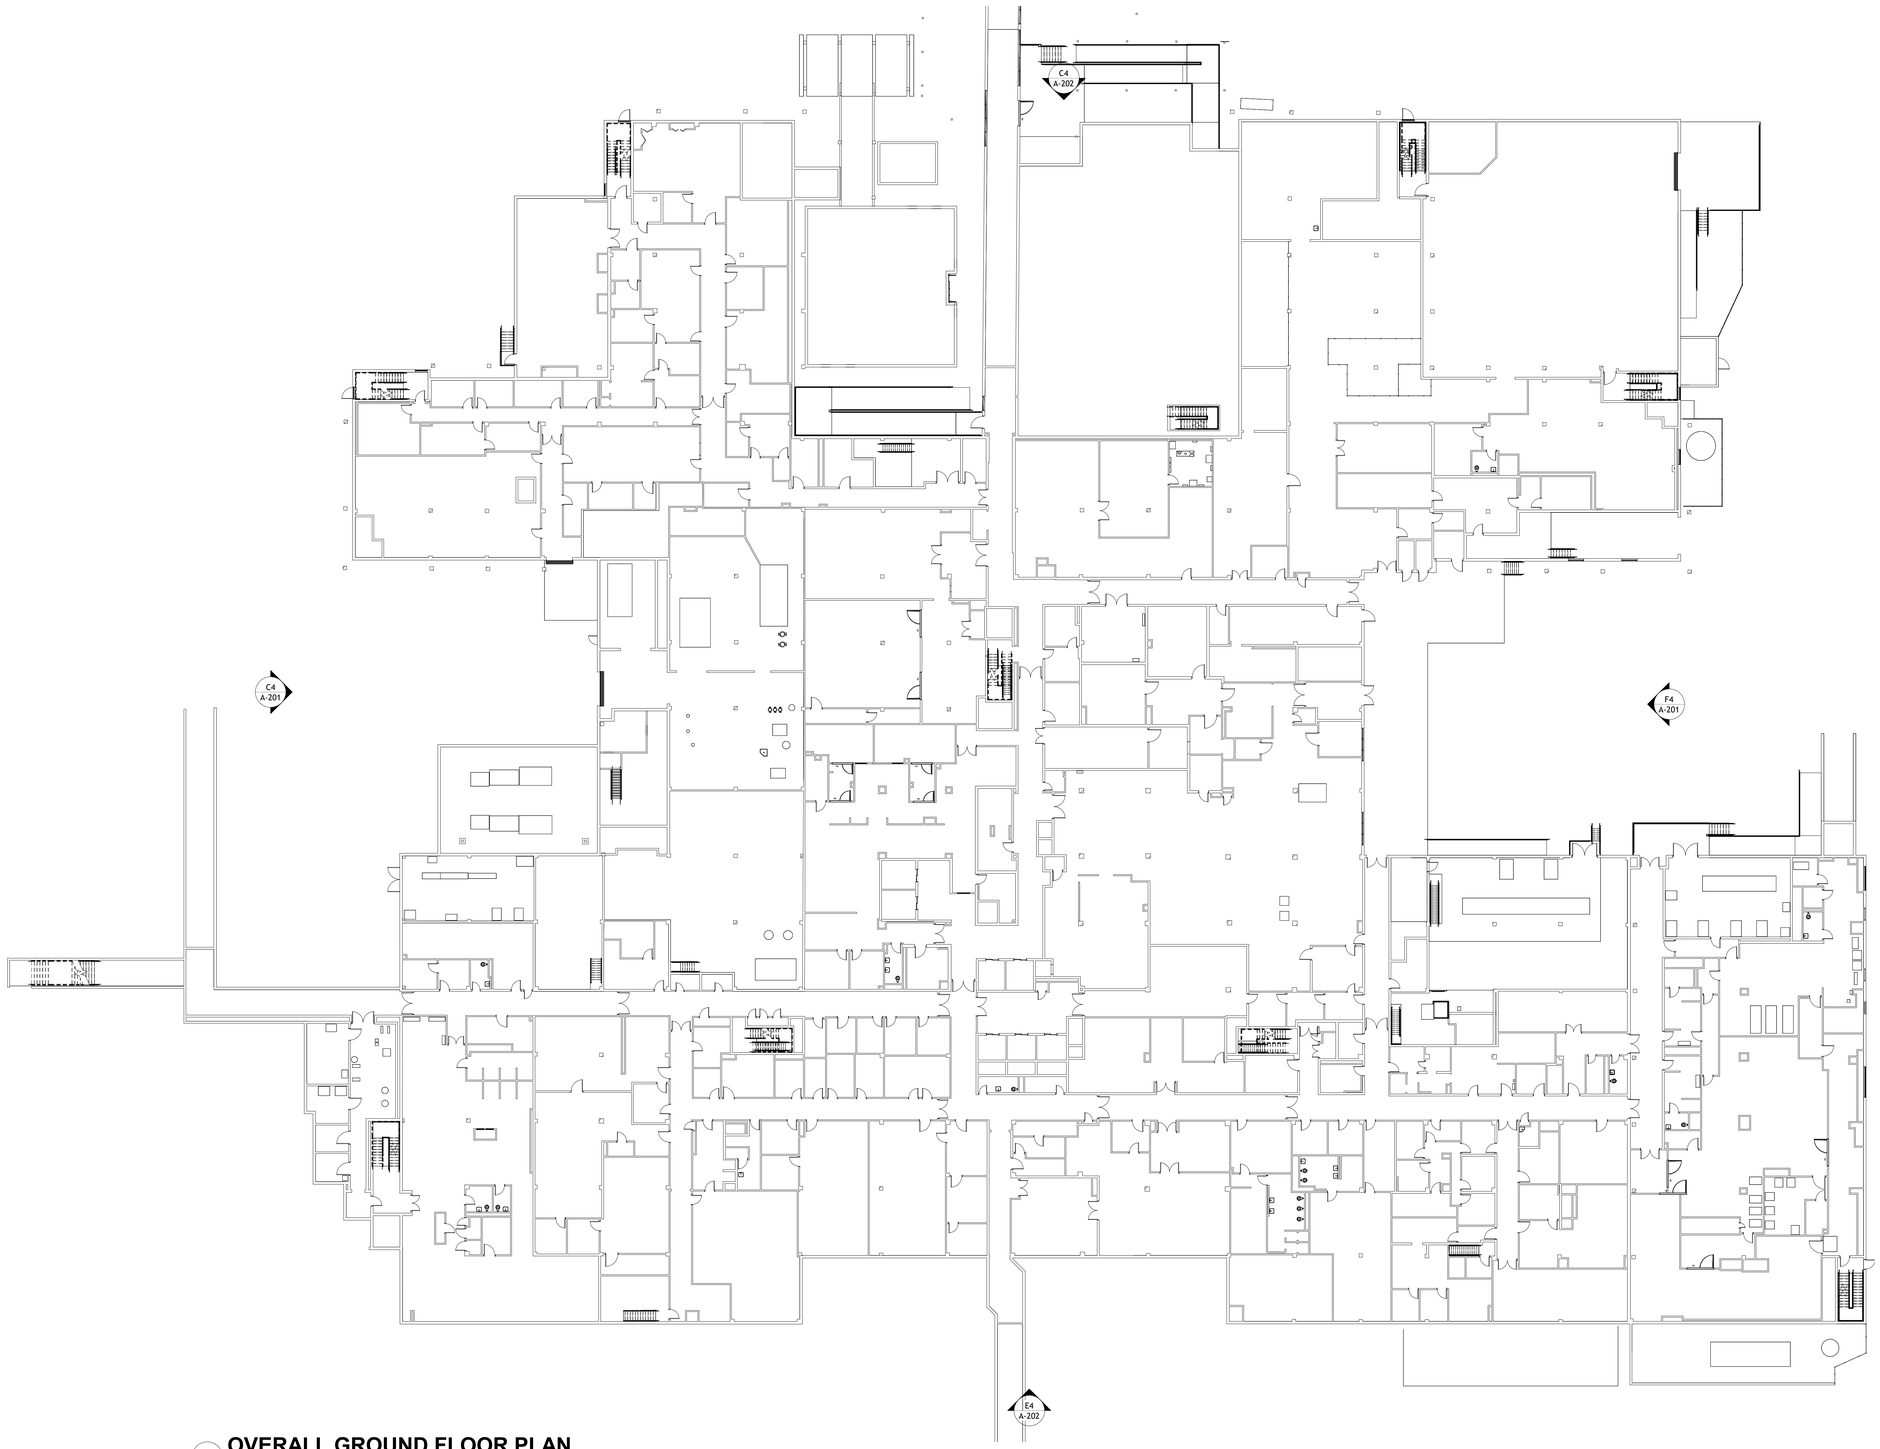

GENERAL NOTE

DUE TO POINT CLOUD DRIFT, THERE MAY BE SOME DEVIATION BETWEEN THE MODEL AND THE POINT CLOUD.

FLOOR PLAN NOTES

A. REFER TO WING FLOOR PLANS FOR ROOM NAMES
B. REFER TO WING FLOOR PLANS FOR DIMENSIONS
C. VERFIY ALL DIMENSIONS IN FIELD PRIOR TO ANY DEMOLITION OF EXISTING CONDITIONS OR NEW CONSTRUCTION

F2 **OVERALL GROUND FLOOR PLAN**
1" = 20'-0"

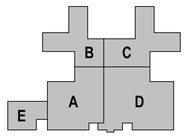

KEY PLAN
NOT TO SCALE

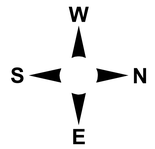

GRAPHIC SCALE
1" = 20'
0 10" 20' 40' 80'

Revisions:	Date:

CONSULTANT
BIM MODELLING:
RESOLUTION LLC
1525 SPARKMAN DR. NW STE A
HUNTSVILLE, AL 35816
(256) 520-4341
JEFF LOWER
RESOLUTION
INTEGRITY | SERVICE | EXCELLENCE

DESIGNER OF RECORD
A/E:
HORSEPOWER GEOSPATIAL
1525 SPARKMAN DR. NW STE A
HUNTSVILLE, AL 35816
(256) 520-4341
JEFF LOWER
Horsepower Geospatial

STAMP

Office of Construction and Facilities Management
VA U.S. Department of Veterans Affairs

Drawing Title: BUILDING 1 OVERALL GROUND FLOOR PLAN
Approved: Approver
Phase: AS-BUILT CONDITIONS
Project Title: UPDATING CAMPUS SITE MAPPING AND FACILITY AS-BUILTS
Location: JAMES A HALEY VETERANS HOSPITAL (TAMPA, FL)
Issue Date: 04/15/2025
Checked: CDS / CEW
Drawn: MDN
Project Number: 673-23-101
Building Number: 1
Drawing Number: A-101

Autodesk Docs://James A Haley_FL_MSA 2023-25/B1_ASBUILT_DOCUMENTATION_R24.rvt
4/9/2025 1:39:38 PM
VA FORM 08 - 6231

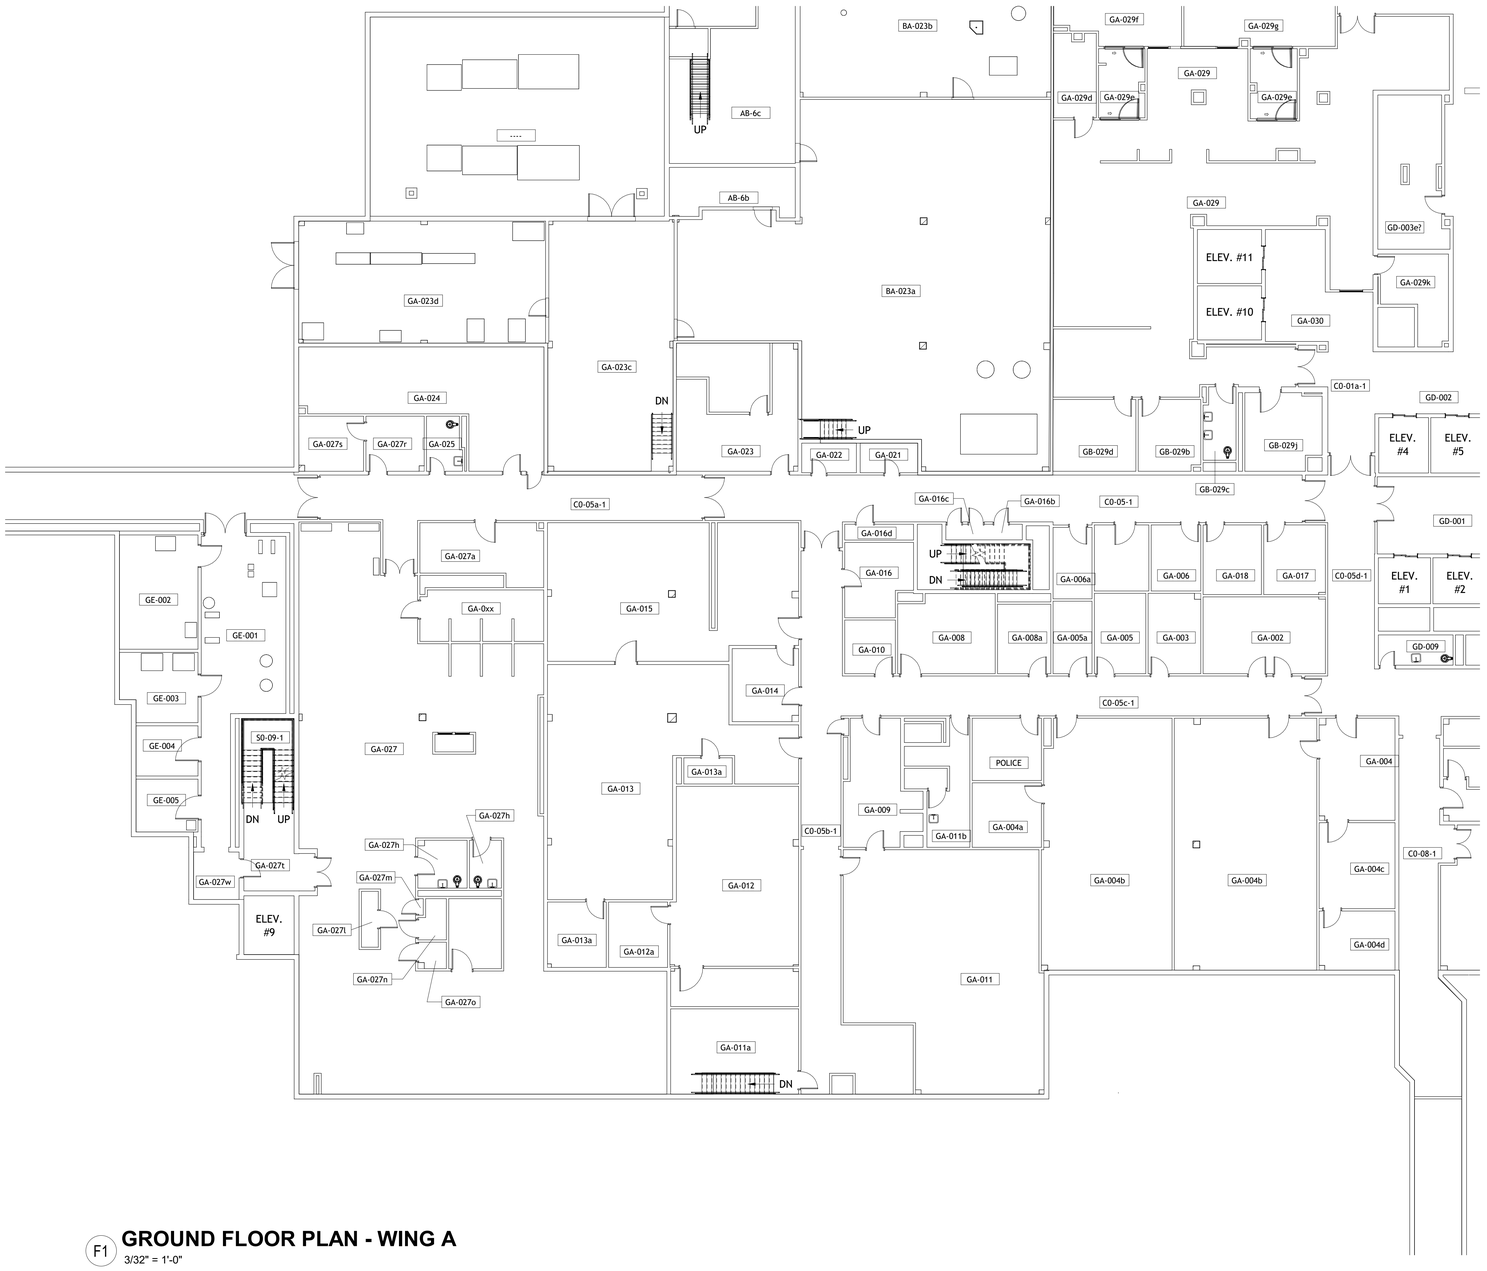

F1 GROUND FLOOR PLAN - WING A

3/32" = 1'-0"

ROOM SCHEDULE		
Number	Name	Area
----	ELECTRICAL	1765 SF
AB-6b	ATS ROOM	164 SF
AB-6c	----	565 SF
BA-023a	A/C & REFRIGERATION/SHEET METAL SHOP	3150 SF
BA-023b	SERVICE ROOM	1673 SF
C0-01a-1	CORRIDOR	258 SF
C0-05-1	CORRIDOR	882 SF
C0-05a-1	CORRIDOR	579 SF
C0-05b-1	CORRIDOR	797 SF
C0-05c-1	CORRIDOR	555 SF
C0-05d-1	CORRIDOR	339 SF
C0-06a-1	CORRIDOR	799 SF
C0-08-1	CORRIDOR	740 SF
GA-0xx	----	186 SF
GA-002	MHBS	283 SF
GA-003	MHBS	127 SF
GA-004	MH ADMIN (SWING)	232 SF
GA-004a	M.A.T. ADMIN	135 SF
GA-004b	EMPLOYEE GYM	975 SF
GA-004b	MH TEAM GROUP ROOM	1082 SF
GA-004c	----	197 SF
GA-004d	----	135 SF
GA-005	MHBS	125 SF
GA-005a	MHBS	85 SF
GA-006	MHBS	99 SF
GA-006a	MHBS	84 SF
GA-008	CONFERENCE ROOM	228 SF
GA-008a	OFFICE	112 SF
GA-009	MENS RESTROOM SHOWERS AND LOCKERS	235 SF
GA-009a	FIRE	3 SF
GA-010	PSA MH	82 SF
GA-011	CONSTRUCTION LAYDOWN	1308 SF
GA-011a	POOL SERVICE ROOM	330 SF
GA-011b	WOMENS RESTROOM SHOWERS AND LOCKERS	145 SF
GA-012	CONFERENCE/TRAINING	677 SF
GA-012a	OFFICE MH INTERN	117 SF
GA-013	MULTI-PURPOSE TRAINING CENTER	1159 SF
GA-013a	CONFERENCE/TRAINING	38 SF
GA-013a	EDUCATION OFFICE	116 SF
GA-014	CHIEF NURSE MH	145 SF
GA-015	EDUCATION EQUIPMENT STORAGE	989 SF
GA-016	ELECTRICAL	142 SF
GA-016b	TELEPHONE	15 SF
GA-016c	SIGNAL	16 SF
GA-016d	IT CLOSET	33 SF
GA-017	MHBS	129 SF
GA-018	MHBS	123 SF
GA-021	ELECTRICAL	51 SF
GA-022	----	49 SF
GA-023	OLD GRAPHIC CONTROL	295 SF
GA-023c	ELECTRICAL	945 SF
GA-023d	ELECTRICAL	908 SF
GA-024	RELEASE OF INFORMATION	624 SF
GA-025	RESTROOM	57 SF
GA-027	PATIENT RECORD FILE ROOM	3683 SF
GA-027a	WAITING	203 SF
GA-027h	WOMENS RESTROOM	70 SF
GA-027h	MENS RESTROOM	46 SF
GA-027l	----	28 SF
GA-027m	FIRE	3 SF
GA-027n	----	31 SF
GA-027o	----	22 SF
GA-027r	DOCTORS WORKROOM	96 SF
GA-027s	DOCTORS WORKROOM	107 SF
GA-027t	LOBBY	68 SF
GA-027w	STORAGE	65 SF
GA-029	----	2467 SF
GA-029d	HAZ STORAGE	105 SF
GA-029e	NON-HAZ ANTE	97 SF
GA-029e	HAZ ANTE	94 SF
GA-029f	STERILE HAZ BUFFER	252 SF
GA-029g	STERILE NON-HAZ BUFFER	323 SF
GA-029k	RESEARCH	143 SF
GA-030	ELEVATOR LOBBY	207 SF
GB-029b	OFFICE	134 SF
GB-029c	RESTROOM	70 SF
GB-029d	OFFICE	180 SF
GB-029j	VAULT	173 SF
GD-001	ELEVATOR LOBBY	460 SF
GD-002	ELEVATOR LOBBY	236 SF
GD-003e?	ELECTRICAL	293 SF
GD-009	WOMENS RESTROOM	68 SF
GD-010	LOGISTICS STORAGE	673 SF
GD-010a	----	100 SF
GD-010c	TELEPHONE	99 SF
GD-010d	----	105 SF
GD-011	FAMILY RESTROOM	71 SF
GE-001	MECHANICAL	574 SF
GE-002	ELECTRICAL	271 SF
GE-003	EMERGENCY ELECTRICAL	155 SF
GE-004	TELECOMMUNICATIONS	94 SF
GE-005	SIGNAL	99 SF
POLICE	GA-007	130 SF
S0-02-1	STAIR #2	170 SF
S0-09-1	STAIR #9	185 SF

GENERAL NOTE

DUE TO POINT CLOUD DRIFT, THERE MAY BE SOME DEVIATION BETWEEN THE MODEL AND THE POINT CLOUD.

FLOOR PLAN NOTES

A. ALL DIMENSIONS ARE TO THE CENTER OF WALLS UNLESS OTHERWISE NOTED
B. VERFIY ALL DIMENSIONS IN FIELD PRIOR TO ANY DEMOLITION OF EXISTING CONDITIONS OR NEW CONSTRUCTION

FLOOR PLAN LEGEND

- TOILETS
- SINK
- MOP SINK
- URINAL
- SHOWER
- SINK WITH COUNTER

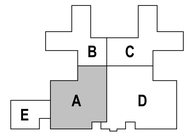

KEY PLAN
NOT TO SCALE

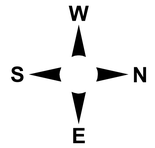

GRAPHIC SCALE

3/32" = 1' - 0" 0 5' 10' 20' 40'

Revisions:	Date:

CONSULTANT
BIM MODELLING:
RESOLUTION LLC
1525 SPARKMAN DR. NW STE A
HUNTSVILLE, AL 35816
(256) 520-4341
JEFF LOWER
RESOLUTION INTEGRITY | SERVICE | EXCELLENCE

DESIGNER OF RECORD
A/E:
HORSEPOWER GEOSPATIAL
1525 SPARKMAN DR. NW STE A
HUNTSVILLE, AL 35816
(256) 520-4341
JEFF LOWER
Horsepower Geospatial

STAMP

Office of Construction and Facilities Management
VA U.S. Department of Veterans Affairs

Drawing Title: BUILDING 1 GROUND FLOOR PLAN - WING A
Approved: Approver
Phase: AS-BUILT CONDITIONS
Project Title: UPDATING CAMPUS SITE MAPPING AND FACILITY AS-BUILTS
Location: JAMES A HALEY VETERANS HOSPITAL (TAMPA, FL)
Issue Date: 04/15/2025
Checked: CDS / CEW
Drawn: MDN
Project Number: 673-23-101
Building Number: 1
Drawing Number: A-101.1

Autodesk Docs://James A Haley_FL_MSA 2023-23/81_ASBUILT_DOCUMENTATION_R24.rvt
4/9/2025 1:39:39 PM
VA FORM 08 - 6231

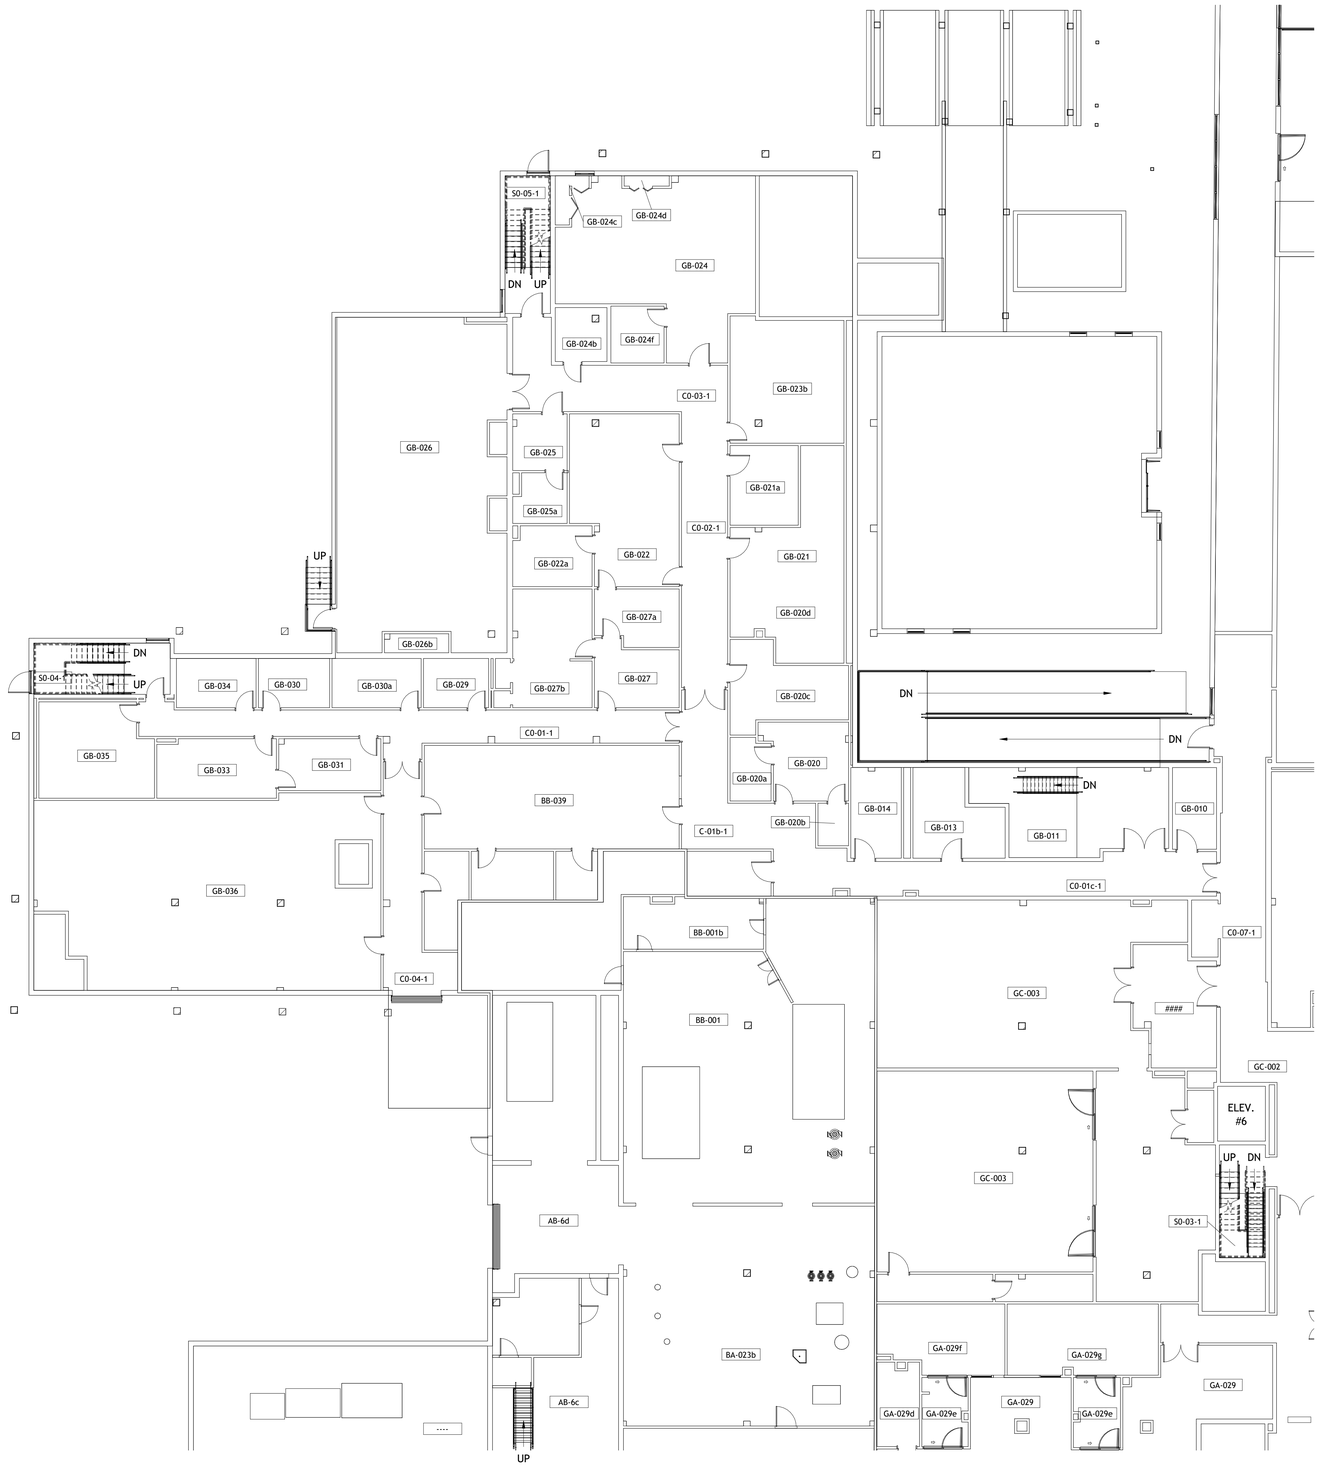

F1 **GROUND FLOOR PLAN - WING B**

3/32" = 1'-0"

ROOM SCHEDULE		
Number	Name	Area
####	########	274 SF
----	ELECTRICAL	1765 SF
AB-6c	----	565 SF
AB-6d	TEMPORARY STORAGE	955 SF
BA-023a	A/C & REFRIGERATION/SHEET METAL SHOP	3150 SF
BA-023b	SERVICE ROOM	1673 SF
BB-001	MECHANICAL	2611 SF
BB-001b	MECHANICAL	212 SF
BB-039	UNIFORM EXCHANGE	798 SF
C0-01-1	CORRIDOR	499 SF
C0-01c-1	CORRIDOR	522 SF
C0-02-1	CORRIDOR	386 SF
C0-03-1	CORRIDOR	357 SF
C0-04-1	CORRIDOR	307 SF
C0-06-1	CORRIDOR	196 SF
C0-06a-1	CORRIDOR	799 SF
C0-07-1	CORRIDOR	409 SF
C0-07a-1	CORRIDOR	185 SF
C-01b-1	CORRIDOR	342 SF
GA-029	----	2467 SF
GA-029d	HAZ STORAGE	105 SF
GA-029e	NON-HAZ ANTE	97 SF
GA-029e	HAZ ANTE	94 SF
GA-029f	STERILE HAZ BUFFER	252 SF
GA-029g	STERILE NON-HAZ BUFFER	323 SF
GB-010	----	109 SF
GB-011	MECHANICAL	458 SF
GB-013	ELECTRICAL	205 SF
GB-014	WOMENS RESTROOM	138 SF
GB-020	UNION OFFICE	186 SF
GB-020a	UNION OFFICE	76 SF
GB-020b	STORAGE	39 SF
GB-020c	IMS	241 SF
GB-020d	IMS	250 SF
GB-021	PC REPAIR	286 SF
GB-021a	OFFICE IMS	164 SF
GB-022	OFFICE IMS	523 SF
GB-022a	----	143 SF
GB-023b	OFFICE IMS	425 SF
GB-024	OFFICE IMS	838 SF
GB-024b	OFFICE IMS	83 SF
GB-024c	SIGNAL	27 SF
GB-024d	POWER	14 SF
GB-024f	OFFICE	92 SF
GB-025	ASST. SYSTEM MANAGER	92 SF
GB-025a	SYSTEMS MANAGER	77 SF
GB-026	COMPUTER ROOM	1627 SF
GB-026b	ELECTRICAL	36 SF
GB-027	IMS	158 SF
GB-027a	IMS	139 SF
GB-027b	IMS CHIEF OFFICE	307 SF
GB-029	IMS	97 SF
GB-030	OFFICE STAFF EMS NIGHT	106 SF
GB-030a	OFFICE STAFF EMS	133 SF
GB-031	N&FS	159 SF
GB-033	N&FS	212 SF
GB-034	OFFICE EMS	118 SF
GB-035	UNION OFFICE	317 SF
GB-036	LINEN ROOM	1855 SF
GC-002	ELEVATOR LOBBY	88 SF
GC-003	SPD AMWS	1310 SF
GC-003	SPD AMWS	2104 SF
GC-006l	----	21 SF
GC-008	PHARMACY OUT PAITIENT	1870 SF
GD-003e?	ELECTRICAL	293 SF
S0-03-1	STAIR #3	157 SF
S0-04-1	STAIR #4	211 SF
S0-05-1	STAIR #5	189 SF

GENERAL NOTE

DUE TO POINT CLOUD DRIFT, THERE MAY BE SOME DEVIATION BETWEEN THE MODEL AND THE POINT CLOUD.

FLOOR PLAN NOTES

A. ALL DIMENSIONS ARE TO THE CENTER OF WALLS UNLESS OTHERWISE NOTED
B. VERFIY ALL DIMENSIONS IN FIELD PRIOR TO ANY DEMOLITION OF EXISTING CONDITIONS OR NEW CONSTRUCTION

FLOOR PLAN LEGEND

- TOILETS
- SINK
- MOP SINK
- URINAL
- SHOWER
- SINK WITH COUNTER

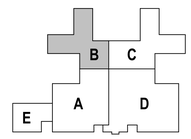

KEY PLAN
NOT TO SCALE

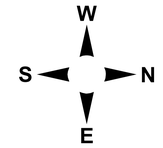

GRAPHIC SCALE

3/32" = 1' - 0" 0 5' 10' 20' 40'

Revisions:	Date:

CONSULTANT
BIM MODELLING:
RESOLUTION LLC
1525 SPARKMAN DR. NW STE A
HUNTSVILLE, AL 35816
(256) 520-4341
JEFF LOWER
RESOLUTION® INTEGRITY | SERVICE | EXCELLENCE

DESIGNER OF RECORD
A/E:
HORSEPOWER GEOSPATIAL
1525 SPARKMAN DR. NW STE A
HUNTSVILLE, AL 35816
(256) 520-4341
JEFF LOWER
Horsepower Geospatial

STAMP

Office of Construction and Facilities Management
VA U.S. Department of Veterans Affairs

Drawing Title: BUILDING 1 GROUND FLOOR PLAN - WING B
Approved: Approver
Phase: AS-BUILT CONDITIONS
Project Title: UPDATING CAMPUS SITE MAPPING AND FACILITY AS-BUILTS
Location: JAMES A HALEY VETERANS HOSPITAL (TAMPA, FL)
Issue Date: 04/15/2025
Checked: CDS / CEW
Drawn: MDN
Project Number: 673-23-101
Building Number: 1
Drawing Number: A-101.2

Autodesk Docs://James A Haley_FL_MSA 2023-29/81_ASBUILT_DOCUMENTATION_R24.rvt
4/9/2025 1:39:41 PM
VA FORM 08 - 6231

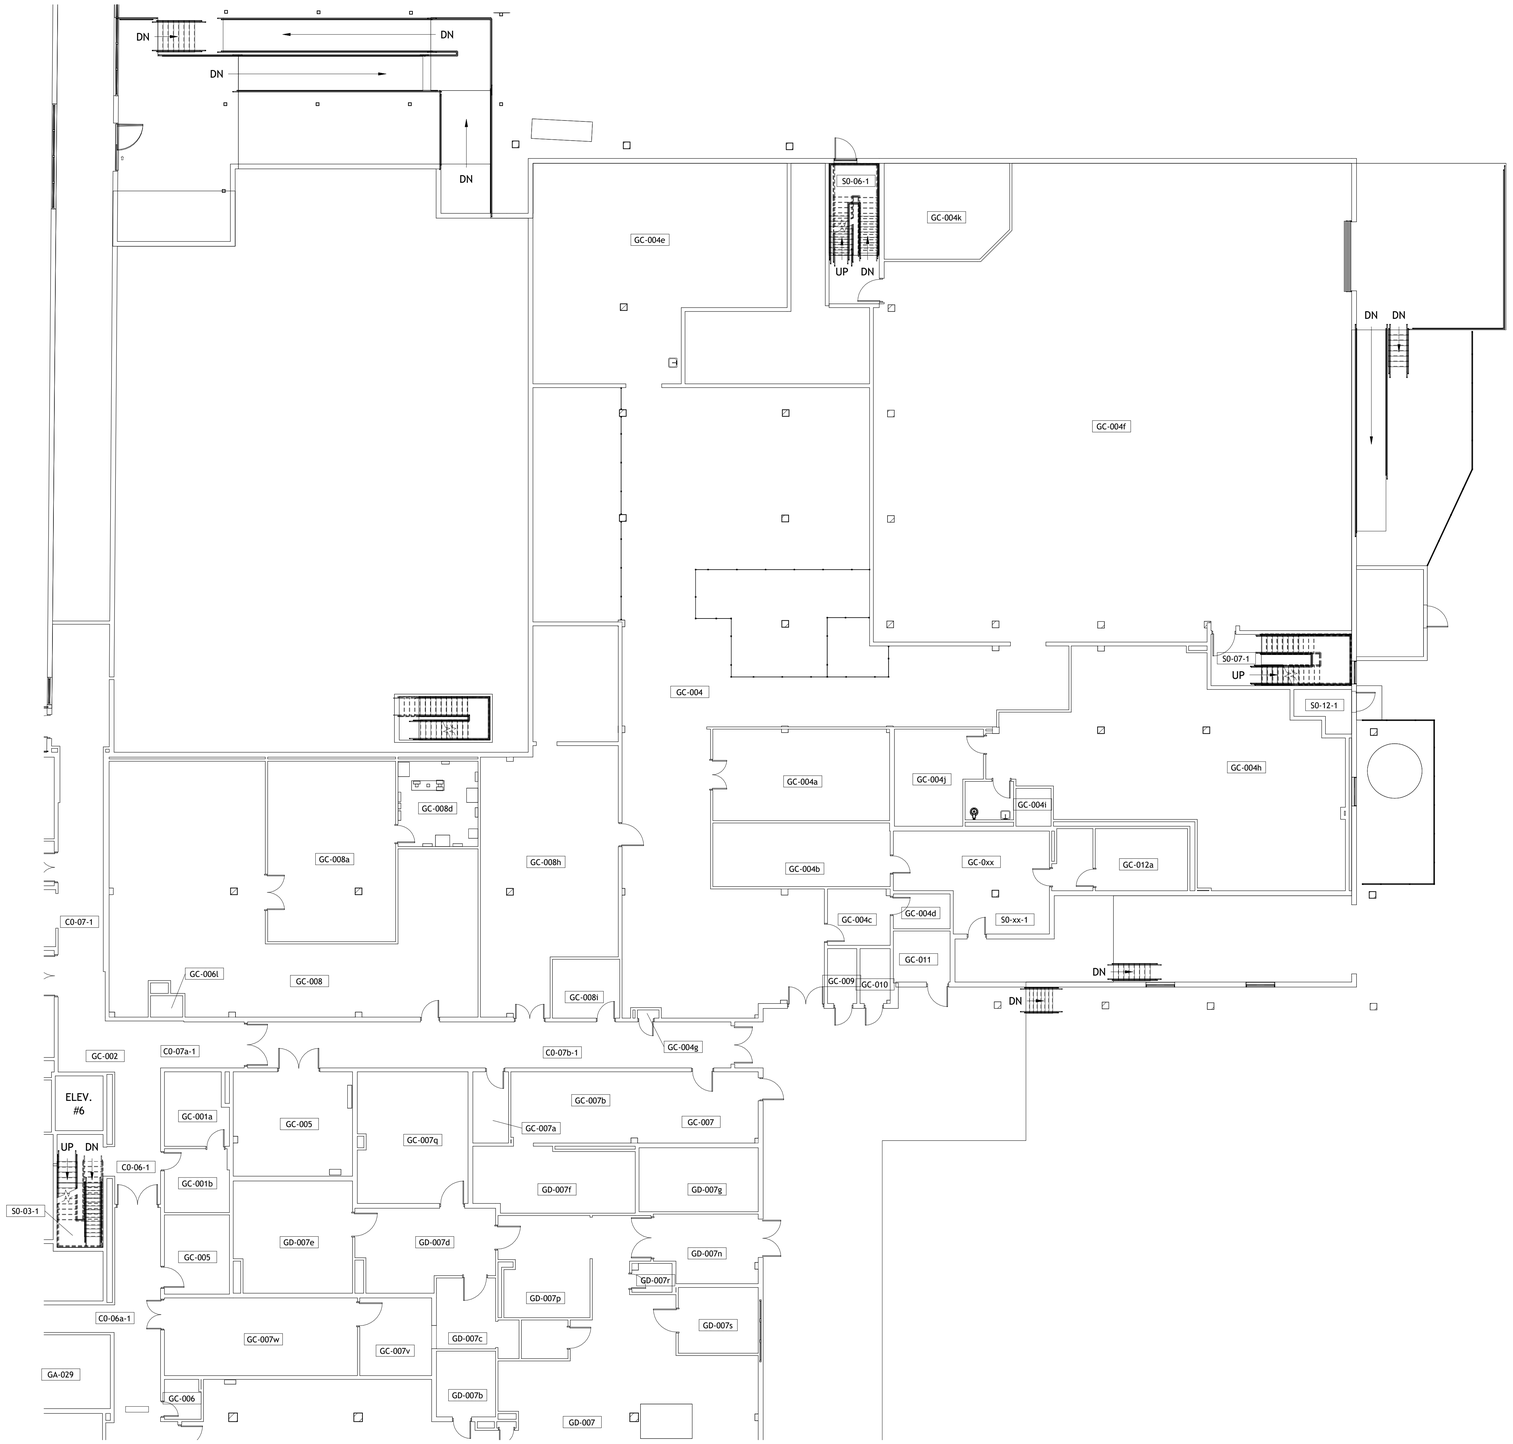

F1 GROUND FLOOR PLAN - WING C

3/32" = 1'-0"

ROOM SCHEDULE		
Number	Name	Area
####	########	274 SF
C0-01c-1	CORRIDOR	522 SF
C0-06-1	CORRIDOR	196 SF
C0-06a-1	CORRIDOR	799 SF
C0-07-1	CORRIDOR	409 SF
C0-07a-1	CORRIDOR	185 SF
C0-07b-1	CORRIDOR	673 SF
GA-029	----	2467 SF
GB-010	----	109 SF
GC-0xx	----	281 SF
GC-001a	DIETETICS OFFICE	138 SF
GC-001b	DIETETICS OFFICE	124 SF
GC-002	ELEVATOR LOBBY	88 SF
GC-003	SPD AMMS	2104 SF
GC-004	WAREHOUSE	4796 SF
GC-004a	PROCESS STORES	488 SF
GC-004b	REFRIGERATION EQUIPMENT	341 SF
GC-004c	OFFICE WAREHOUSE	106 SF
GC-004d	CLOSET	60 SF
GC-004e	EMS SUPPLIES	1449 SF
GC-004f	WAREHOUSE ADDITION	6453 SF
GC-004g	FIRE	5 SF
GC-004h	WORKSTATIONS	1695 SF
GC-004i	RESTROOM	40 SF
GC-004j	BREAK AREA	232 SF
GC-004k	PHARMACY STORAGE	351 SF
GC-005	DIETETICS OFFICE	156 SF
GC-005	ELECTRICAL	376 SF
GC-006	H.A.C.	43 SF
GC-006l	----	21 SF
GC-007	PATIENT LAUNDRY	266 SF
GC-007a	ELECTRICAL	77 SF
GC-007b	KITCHEN STORAGE	266 SF
GC-007q	FREEZER	437 SF
GC-007v	REFRIGERATOR	169 SF
GC-007w	FREEZER	453 SF
GC-008	PHARMACY OUT PAITIENT	1870 SF
GC-008a	OFFICE PHARMACY	697 SF
GC-008d	ELECTRICAL	207 SF
GC-008h	MAIL ROOM	1289 SF
GC-008i	MAIL SUPERVISOR	120 SF
GC-009	MEDICAL GASES	49 SF
GC-010	MEDICAL GASES	50 SF
GC-011	----	87 SF
GC-012a	----	174 SF
GD-003e?	ELECTRICAL	293 SF
GD-007	MAIN KITCHEN	5589 SF
GD-007b	COOKS REFRIGERATOR	118 SF
GD-007c	VEGETABLE REFRIGERATOR	153 SF
GD-007d	MEAT REFRIGERATOR	317 SF
GD-007e	FROZEN FOOD HOLDING	395 SF
GD-007f	INGREDIENT CONTROL	309 SF
GD-007g	DAIRY & EGG REFRIGERATION	230 SF
GD-007n	KITCHEN ENTRY	205 SF
GD-007p	GENERAL STORAGE	272 SF
GD-007r	----	34 SF
GD-007s	REFRIGERATOR	159 SF
S0-03-1	STAIR #3	157 SF
S0-06-1	STAIR #6	213 SF
S0-07-1	STAIR #7	218 SF
S0-12-1	STAIR #12	61 SF
S0-xx-1	STAIR #1	125 SF

GENERAL NOTE

DUE TO POINT CLOUD DRIFT, THERE MAY BE SOME DEVIATION BETWEEN THE MODEL AND THE POINT CLOUD.

FLOOR PLAN NOTES

A. ALL DIMENSIONS ARE TO THE CENTER OF WALLS UNLESS OTHERWISE NOTED
B. VERFIY ALL DIMENSIONS IN FIELD PRIOR TO ANY DEMOLITION OF EXISTING CONDITIONS OR NEW CONSTRUCTION

FLOOR PLAN LEGEND

- TOILETS
- SINK
- MOP SINK
- URINAL
- SHOWER
- SINK WITH COUNTER

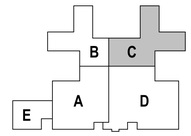

KEY PLAN
NOT TO SCALE

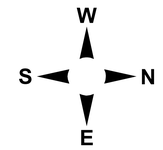

GRAPHIC SCALE

3/32" = 1' - 0" 0 5' 10' 20' 40'

Revisions:	Date:

CONSULTANT

BIM MODELLING:
RESOLUTION LLC
1525 SPARKMAN DR. NW STE A
HUNTSVILLE, AL 35816
(256) 520-4341
JEFF LOWER

RESOLUTION
INTEGRITY | SERVICE | EXCELLENCE

DESIGNER OF RECORD

A/E:
HORSEPOWER GEOSPATIAL
1525 SPARKMAN DR. NW STE A
HUNTSVILLE, AL 35816
(256) 520-4341
JEFF LOWER

Horsepower Geospatial

STAMP

Office of Construction and Facilities Management

VA U.S. Department of Veterans Affairs

Drawing Title: BUILDING 1 GROUND FLOOR PLAN - WING C
Phase: AS-BUILT CONDITIONS
Project Title: UPDATING CAMPUS SITE MAPPING AND FACILITY AS-BUILTS
Project Number: 673-23-101
Building Number: 1
Approved: Approver
Location: JAMES A HALEY VETERANS HOSPITAL (TAMPA, FL)
Issue Date: 04/15/2025
Checked: CDS / CEW
Drawn: MDN
Drawing Number: A-101.3

Autodesk Docs://James A Haley_FL_MSA 2023-25/B1_ASBUILT_DOCUMENTATION_R24.rvt
4/8/2025 1:39:43 PM

ROOM SCHEDULE		
Number	Name	Area
----	ELECTRICAL	1520 SF
C0-06a-1	CORRIDOR	799 SF
C0-08-1	CORRIDOR	740 SF
C0-09a-1	CORRIDOR	553 SF
C0-10-1	CORRIDOR	132 SF
C0-11a-1	CORRIDOR	23 SF
C0-12-1	CORRIDOR	441 SF
C0-14-1	CORRIDOR	880 SF
C0-15-1	CORRIDOR	311 SF
C0-17-1	CORRIDOR	168 SF
C0-21-1	CORRIDOR	971 SF
GA-004	MH ADMIN (SWING)	232 SF
GA-004c	----	197 SF

ROOM SCHEDULE		
Number	Name	Area
GA-004d	----	135 SF
GA-029	----	2467 SF
GA-029k	RESEARCH	143 SF
GC-006	H.A.C.	43 SF
GC-007v	REFRIGERATOR	169 SF
GC-007w	FREEZER	453 SF
GD-0??	----	61 SF
GD-0xx	ELECTRICAL	189 SF
GD-001	ELEVATOR LOBBY	460 SF
GD-002	ELEVATOR LOBBY	236 SF
GD-003e?	ELECTRICAL	293 SF
GD-007	MAIN KITCHEN	5589 SF
GD-007a	CART WASH	27 SF

ROOM SCHEDULE		
Number	Name	Area
GD-007b	COOKS REFRIGERATOR	118 SF
GD-007c	VEGETABLE REFRIGERATOR	153 SF
GD-007j	FOOD PRODUCTION OFFICE	237 SF
GD-007m	DISHWASHER	1153 SF
GD-007o	----	26 SF
GD-007s	REFRIGERATOR	159 SF
GD-008	CANTEEN VENDING	622 SF
GD-009	WOMENS RESTROOM	68 SF
GD-010	LOGISTICS STORAGE	673 SF
GD-010a	----	100 SF
GD-010b	FIRE	4 SF
GD-010c	TELEPHONE	99 SF
GD-010d	----	105 SF

ROOM SCHEDULE		
Number	Name	Area
GD-011	FAMILY RESTROOM	71 SF
GD-013	WOMENS LOUNGE	329 SF
GD-013a	WOMENS LOCKERS	299 SF
GD-013b	WOMENS LOCKERS	700 SF
GD-013c	WOMENS RESTROOM AND SHOWERS	279 SF
GD-014	----	121 SF
GD-014a	AMWS	122 SF
GD-015	MENS LOUNGE	228 SF
GD-015a	MENS LOCKERS	936 SF
GD-015b	MENS RESTROOM AND SHOWERS	214 SF
GD-017	SAFETY	115 SF
GD-017a	SAFETY	122 SF

ROOM SCHEDULE		
Number	Name	Area
GD-017b	SAFETY	120 SF
GD-017c	SAFETY	152 SF
GD-017d	SAFETY	102 SF
GD-017e	SAFETY	109 SF
GD-017f	SAFETY	73 SF
GD-018	H.A.C.	45 SF
GD-018a	FIRE	5 SF
GD-020	LAB SPECTOMETER	180 SF
GD-020a	LAB SPECTOMETER	444 SF
GD-022	BIOMED SHOP	703 SF
GD-022a	BIOMED SHOP	146 SF
GD-023	----	56 SF
GD-023a	ELECTRONICS SHOP	187 SF

ROOM SCHEDULE		
Number	Name	Area
GD-023b	ELECTRONICS SHOP	91 SF
GD-023c	ELECTRONICS SHOP	90 SF
GD-023d	ELECTRONICS SHOP	256 SF
GD-023e	ELECTRONICS SHOP	171 SF
GD-024	BIOMED SHOP	766 SF
GD-025	H.A.C.	46 SF
GD-026	MORGUE	256 SF
GD-026a	MORGUE	183 SF
GD-027	MORGUE	555 SF
GD-029	MENS RESTROOM	70 SF
GD-030	WOMENS RESTROOM	70 SF
GD-031	MORGUE	93 SF
GD-031a	----	56 SF
GD-032	CREDIT UNION	228 SF
GD-033	CREDIT UNION	94 SF
GD-033a	CREDIT UNION	35 SF
GD-033b	CREDIT UNION	63 SF
GD-033c	CREDIT UNION	66 SF
GD-034	MENS RESTROOM	121 SF
GD-035	WOMENS RESTROOM	92 SF
GD-036	MECHANICAL	126 SF
GD-036a	BARBER SHOP	164 SF
GD-036b	MEZZANINE	337 SF
GD-037	OFFICE N&FS	110 SF
GD-037a	OFFICE N&FS	135 SF
GD-037b	DIETETIC CLASSROOM	276 SF
GD-037c	OFFICE N&FS	113 SF
GD-038	CONSTRUCTION LAYDOWN	134 SF
GD-038a	----	578 SF
GD-038c	----	99 SF
GD-038d	----	206 SF
GD-038f	----	71 SF
GD-038g	----	112 SF
GD-039	ELECTRICAL	41 SF
GD-039a	FIRE	2 SF
GD-039b	TELEPHONE	20 SF
GD-039c	SIGNAL	6 SF
GD-040	ELECTRICAL	1048 SF
GD-041	ANTE ROOM	123 SF
GD-042	LOCKER ROOM	216 SF
GD-042b	RESTROOM	58 SF
GD-043	LOCKER ROOM	210 SF
GD-043b	RESTROOM	42 SF
GD-045	ANTE ROOM	143 SF
GD-046	DECON ANTE ROOM	68 SF
GD-047	SOILED RECEIVING/DECON AREA	1443 SF
GD-047a	DECON TOILET	60 SF
GD-047b	H.A.C.	43 SF
GD-047c	MECH.	75 SF
GD-049	MANUAL WASH	145 SF
GD-050	CART STORAGE	711 SF
GD-051	PREP. ASSEMBLY STERILIZTION	2161 SF
GD-051a	STERILIZERS	99 SF
GD-051b	H.A.C.	67 SF
GD-052	ETO STERILIZERS/AERATOR ROOM	300 SF
GD-053	STERILIZER UNLOADING	224 SF
GD-054	STERILE STORAGE	1603 SF
S0-01-1	STAIR #1	156 SF
S0-08-1	STAIR #8	58 SF
S0-22-1	STAIR #22	176 SF

GENERAL NOTE

DUE TO POINT CLOUD DRIFT, THERE MAY BE SOME DEVIATION BETWEEN THE MODEL AND THE POINT CLOUD.

FLOOR PLAN NOTES

A. ALL DIMENSIONS ARE TO THE CENTER OF WALLS UNLESS OTHERWISE NOTED
B. VERFIY ALL DIMENSIONS IN FIELD PRIOR TO ANY DEMOLITION OF EXISTING CONDITIONS OR NEW CONSTRUCTION

FLOOR PLAN LEGEND

- TOILETS
- SINK
- MOP SINK
- URINAL
- SHOWER
- SINK WITH COUNTER

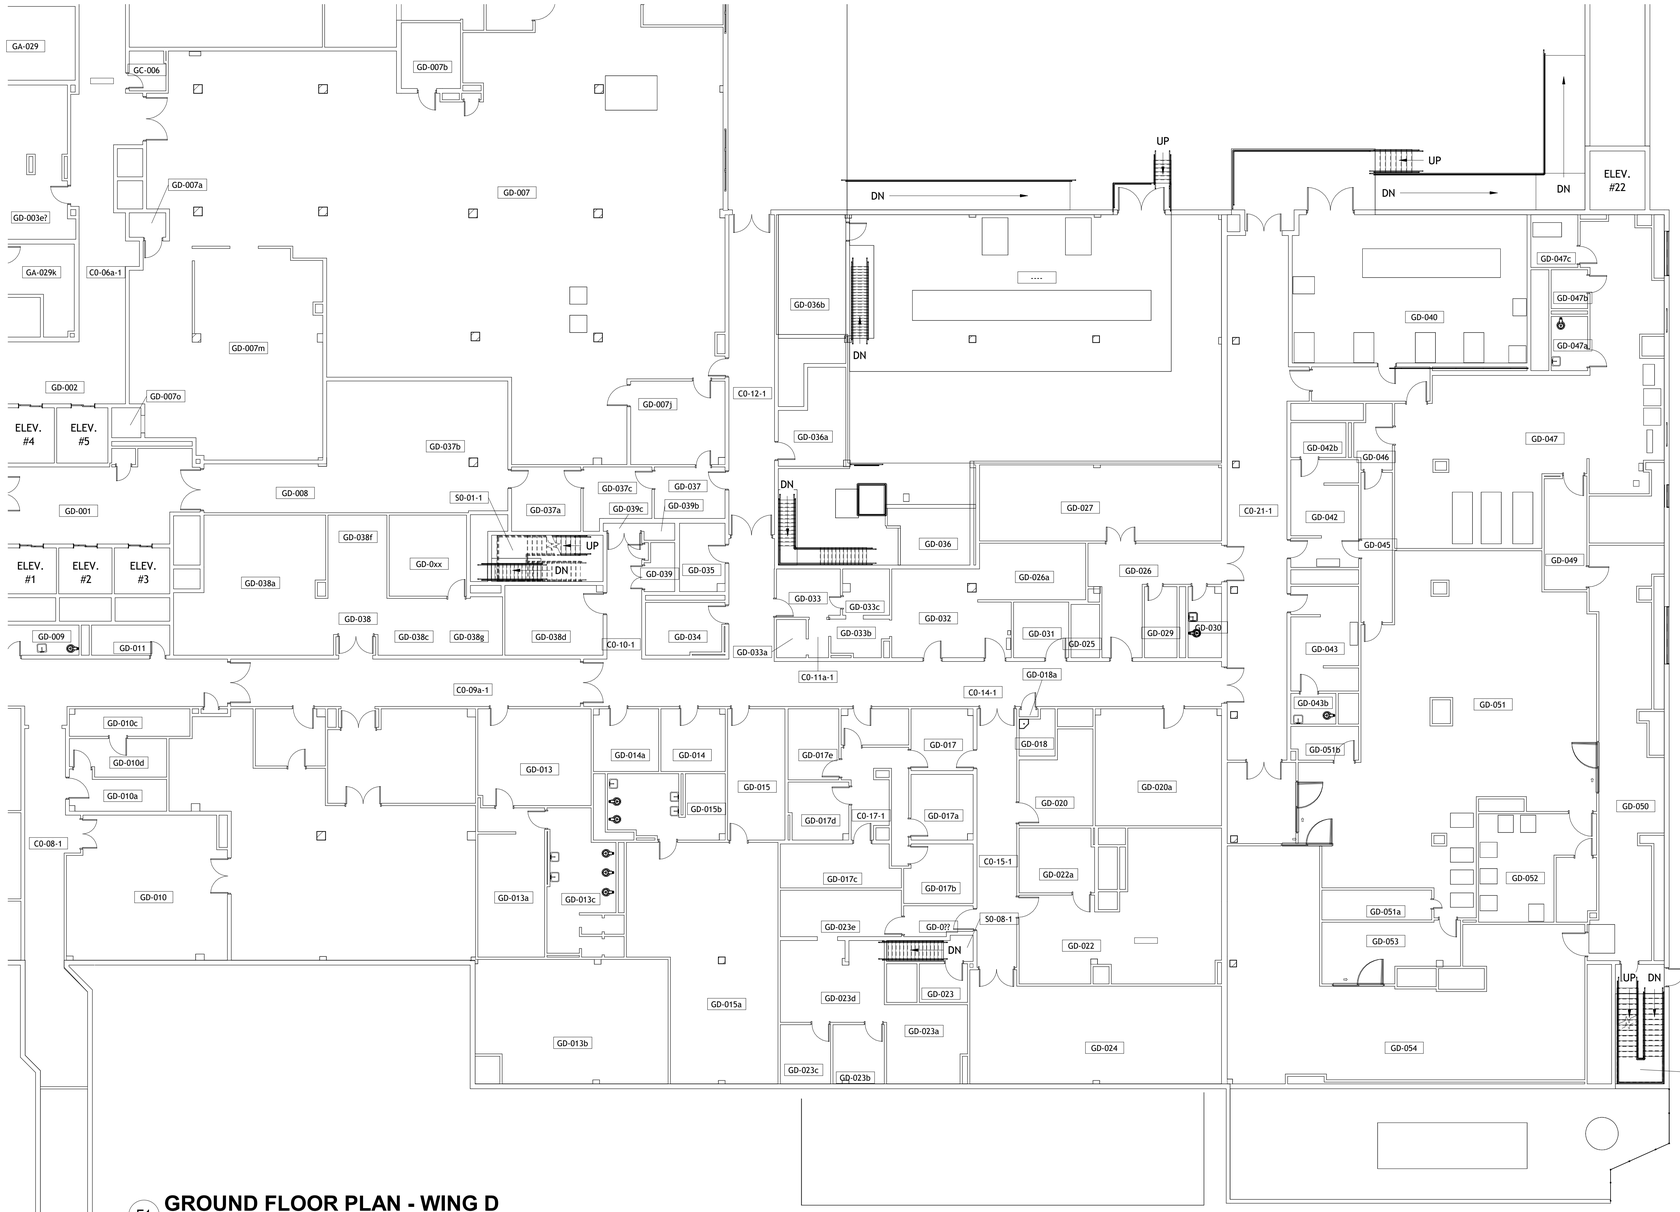

F1 **GROUND FLOOR PLAN - WING D**
3/32" = 1'-0"

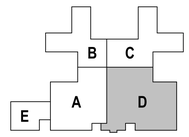

KEY PLAN
NOT TO SCALE

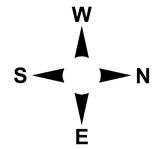

GRAPHIC SCALE

3/32" = 1' - 0" 0 5' 10' 20' 40'

Revisions:	Date:

CONSULTANT

BIM MODELLING:
RESOLUTION LLC
1525 SPARKMAN DR. NW STE A
HUNTSVILLE, AL 35816
(256) 520-4341
JEFF LOWER

RESOLUTION® INTEGRITY | SERVICE | EXCELLENCE

DESIGNER OF RECORD

A/E:
HORSEPOWER GEOSPATIAL
1525 SPARKMAN DR. NW STE A
HUNTSVILLE, AL 35816
(256) 520-4341
JEFF LOWER

Horsepower Geospatial

STAMP

Office of Construction and Facilities Management

VA U.S. Department of Veterans Affairs

Drawing Title: BUILDING 1 GROUND FLOOR PLAN - WING D

Phase: AS-BUILT CONDITIONS

Approved: Approver

Project Title: UPDATING CAMPUS SITE MAPPING AND FACILITY AS-BUILTS

Location: JAMES A HALEY VETERANS HOSPITAL (TAMPA, FL)

Project Number: 673-23-101

Building Number: 1

Drawing Number: A-101.4

Issue Date: 04/15/2025 | Checked: CDS / CEW | Drawn: MDN

Autodesk Docs://James A Haley_FL_MSA 2023-25/B1_ASBUILT_DOCUMENTATION_R24.rvt 4/9/2025 1:39:45 PM

VA FORM 08 - 6231