RETURN TRACINGS TO PLAN LIBRARY

FILE FOLDER NO. 24

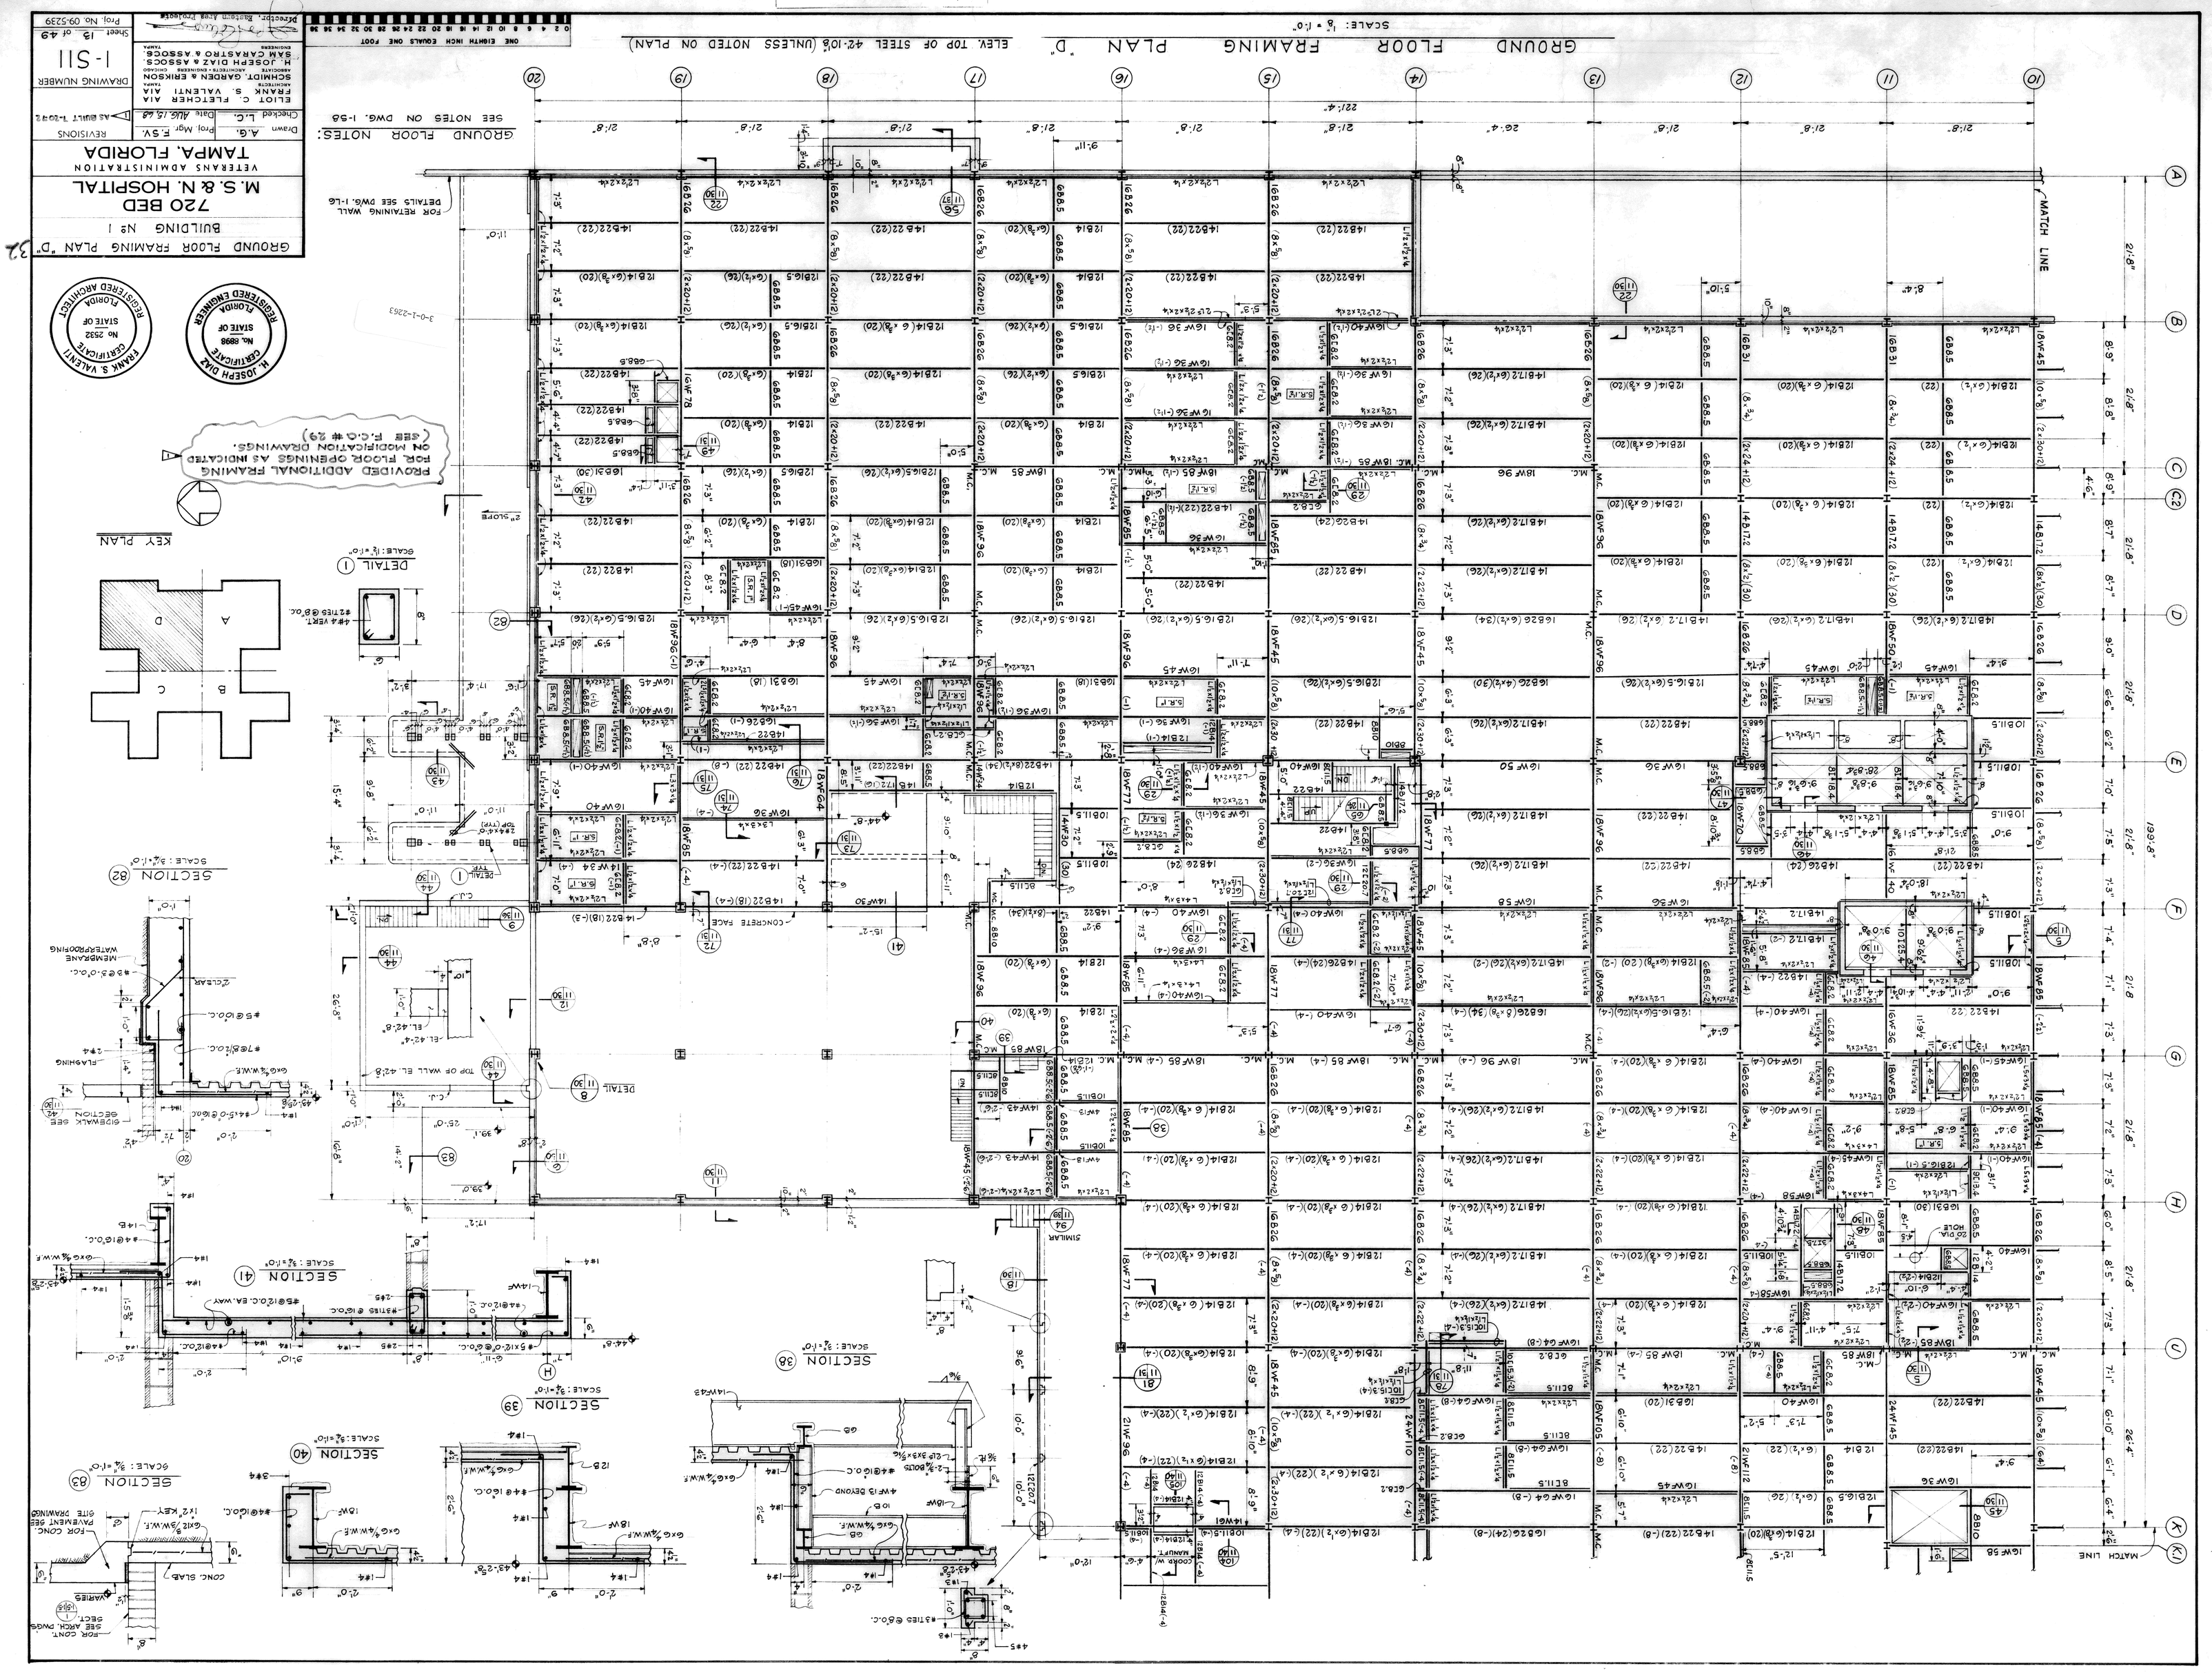

GROUND FLOOR FRAMING PLAN "D"

BUILDING Nº 1

720 BED

M. S. & N. HOSPITAL

VETERANS ADMINISTRATION

TAMPA, FLORIDA

Drawn A.G.	Prof. Mgr. F.S.V.
Checked L.C.	Date AUG. 15 68

REVISIONS

1 AS BUILT T-20 #2

ELIOT C. FLETCHER AIA
ARCHITECT
FRANK S. VALENTI AIA
ARCHITECT
SCHMIDT, GARDEN & ERIKSON
ARCHITECTS - ENGINEERS CHICAGO
ASSOCIATES
H. JOSEPH DIAZ & ASSOCS.
ENGINEERS
SAM CARASTRO & ASSOCS.
TAMPA

DRAWING NUMBER

I-S11

Sheet 13 of 49

Proj. No. 09-5299

Director, Eastern Area Projects

ONE EIGHTH INCH EQUALS ONE FOOT

H. JOSEPH DIAZ CERTIFICATE No. 8898 STATE OF FLORIDA REGISTERED ENGINEER

FRANK S. VALENTI CERTIFICATE No. 2532 STATE OF FLORIDA REGISTERED ARCHITECT

3-0-1-2263

32