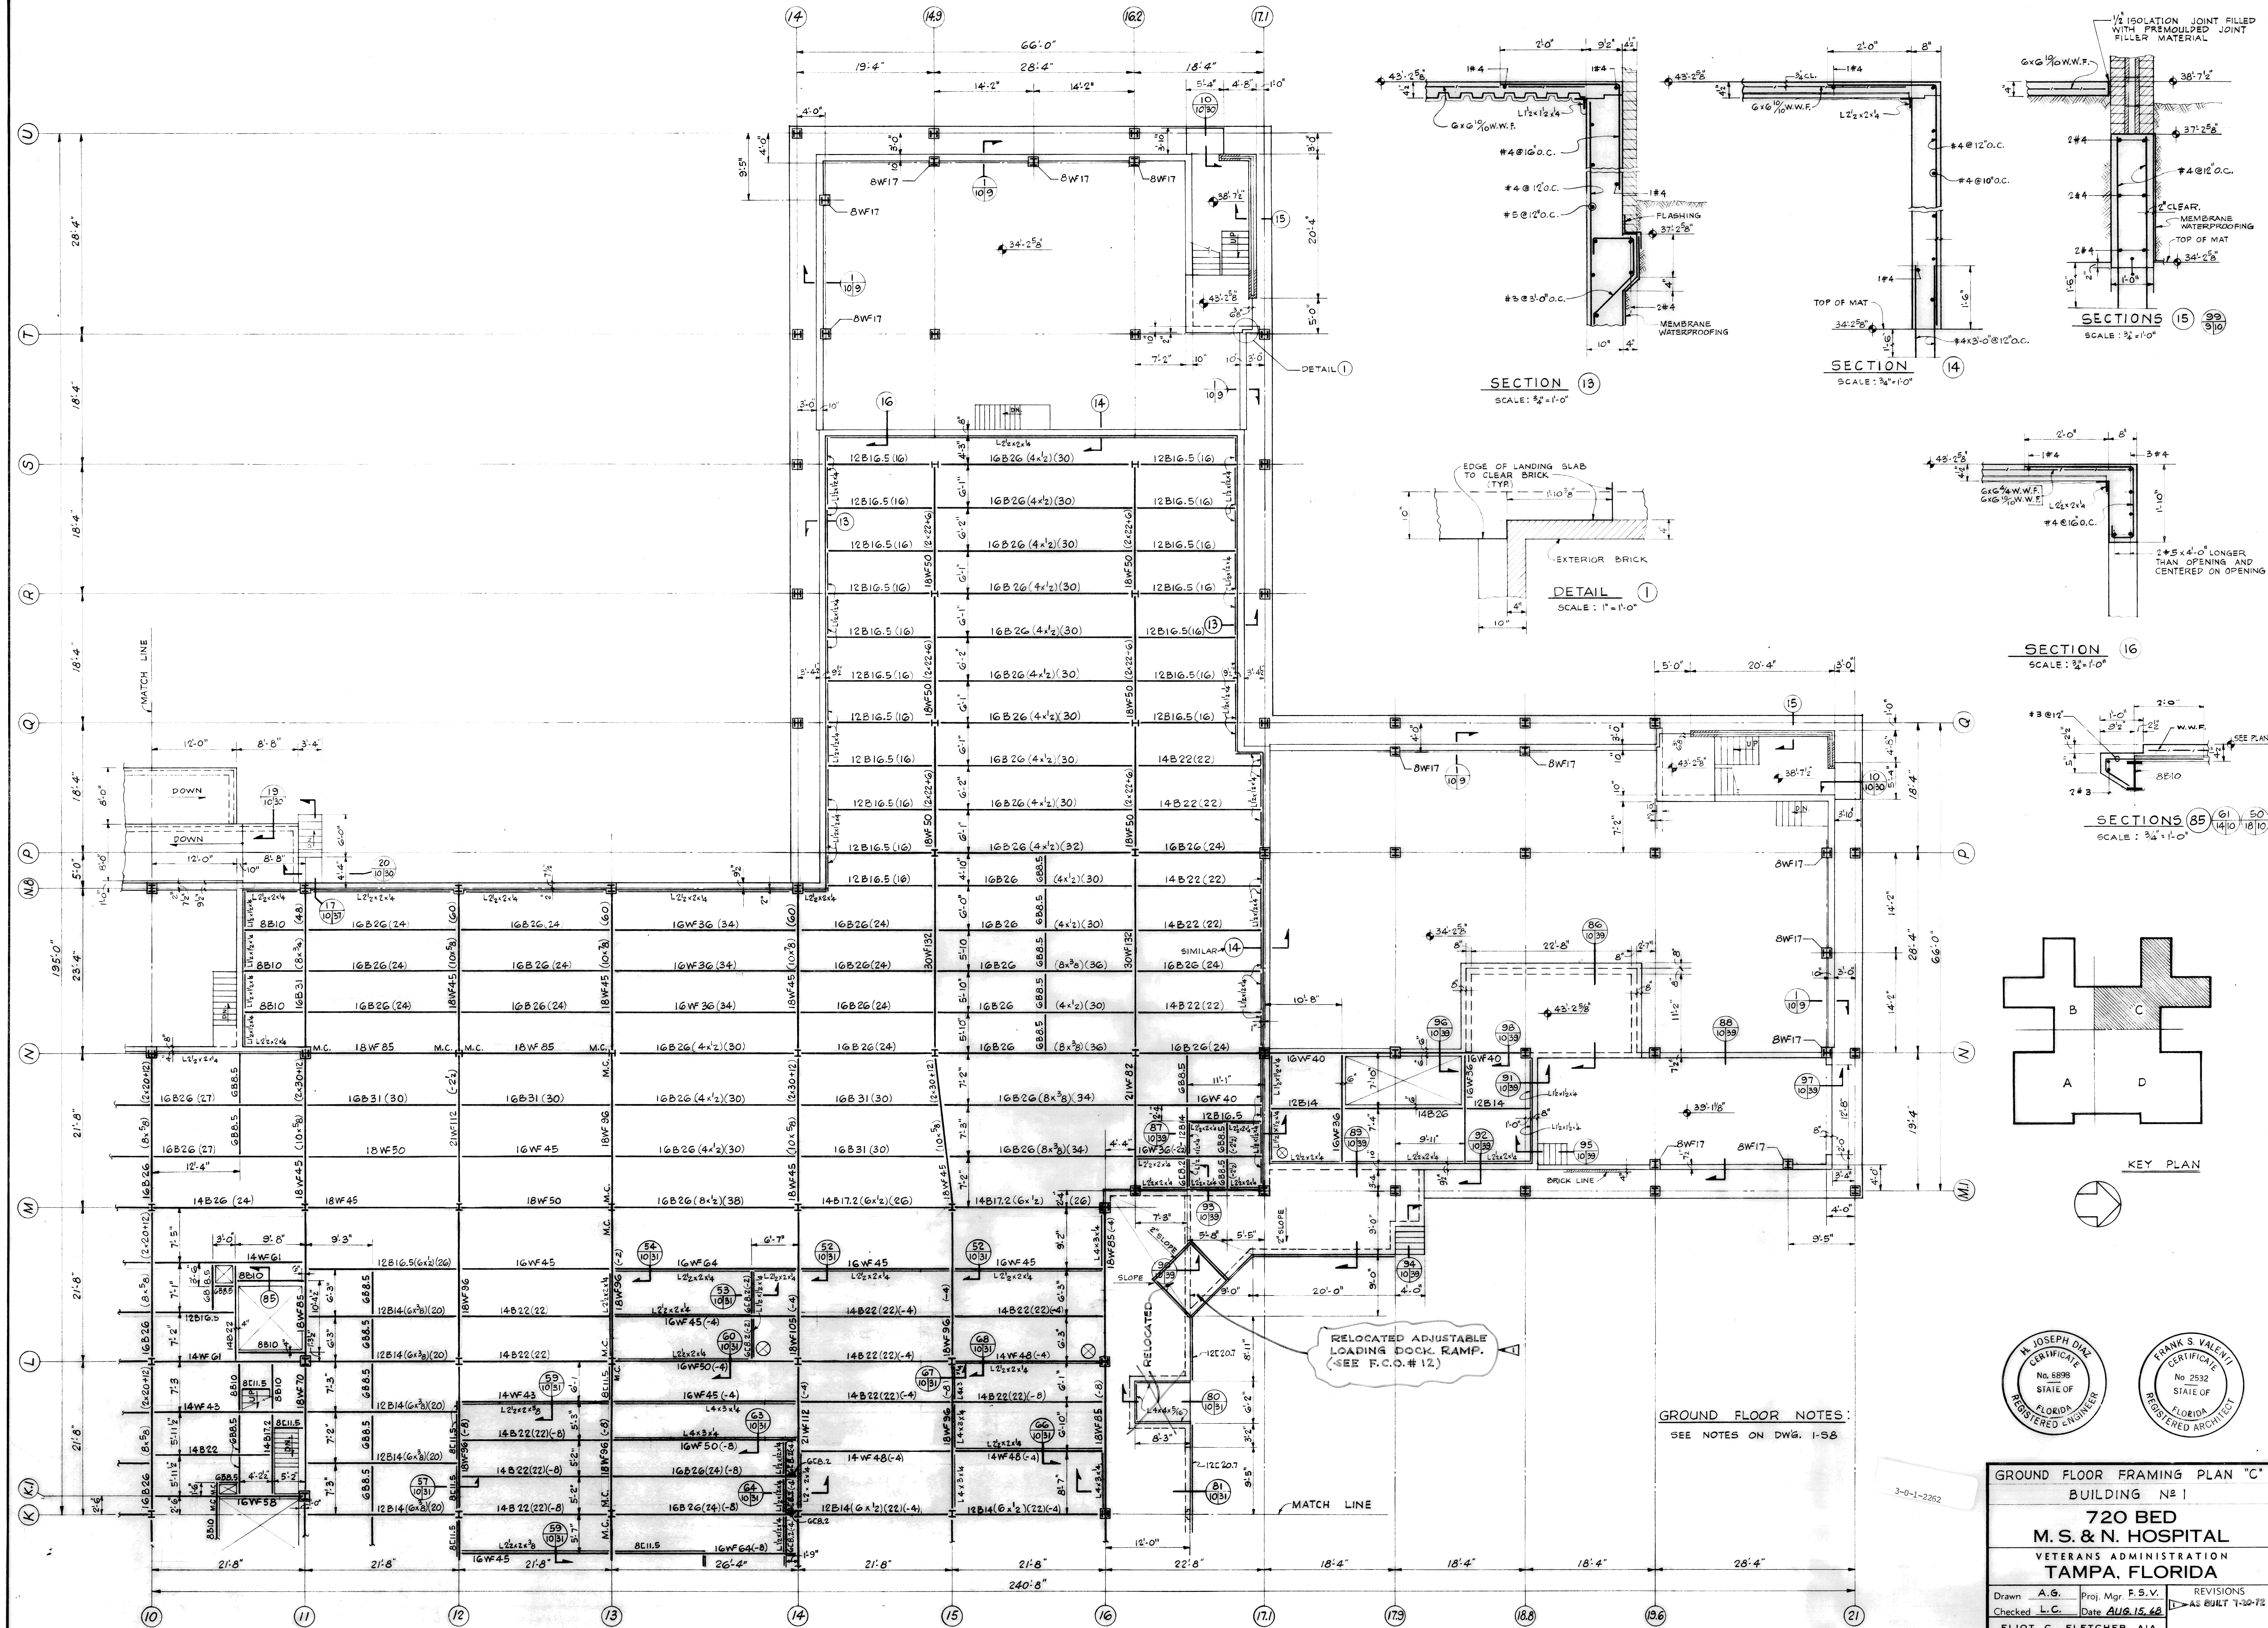

GROUND FLOOR FRAMING PLAN "C"

SCALE 1/8" = 1'-0"

ELEV. TOP OF STEEL 42'-10 1/8" (UNLESS NOTED ON PLAN)

ONE EIGHTH INCH EQUALS ONE FOOT

3-0-1-2262

33

GROUND FLOOR FRAMING PLAN "C"
BUILDING № 1

720 BED
M. S. & N. HOSPITAL

VETERANS ADMINISTRATION
TAMPA, FLORIDA

Drawn A.G. Proj. Mgr. F.S.V.
Checked L.C. Date AUG. 15, 68

REVISIONS
1 AS BUILT 7-20-72

ELIOT C. FLETCHER AIA
FRANK S. VALENTI AIA
ARCHITECTS TAMPA
SCHMIDT, GARDEN & ERIKSON
ASSOCIATE ARCHITECTS • ENGINEERS CHICAGO
H. JOSEPH DIAZ & ASSOCS.
SAM CARASTRO & ASSOCS.
ENGINEERS TAMPA

Director, Eastern Area Projects

DRAWING NUMBER
1-S10

Sheet 12 of 49
Proj. No. 09-5239

RETURN TRACINGS TO PLAN LIBRARY

FILE FOLDER NO. 2