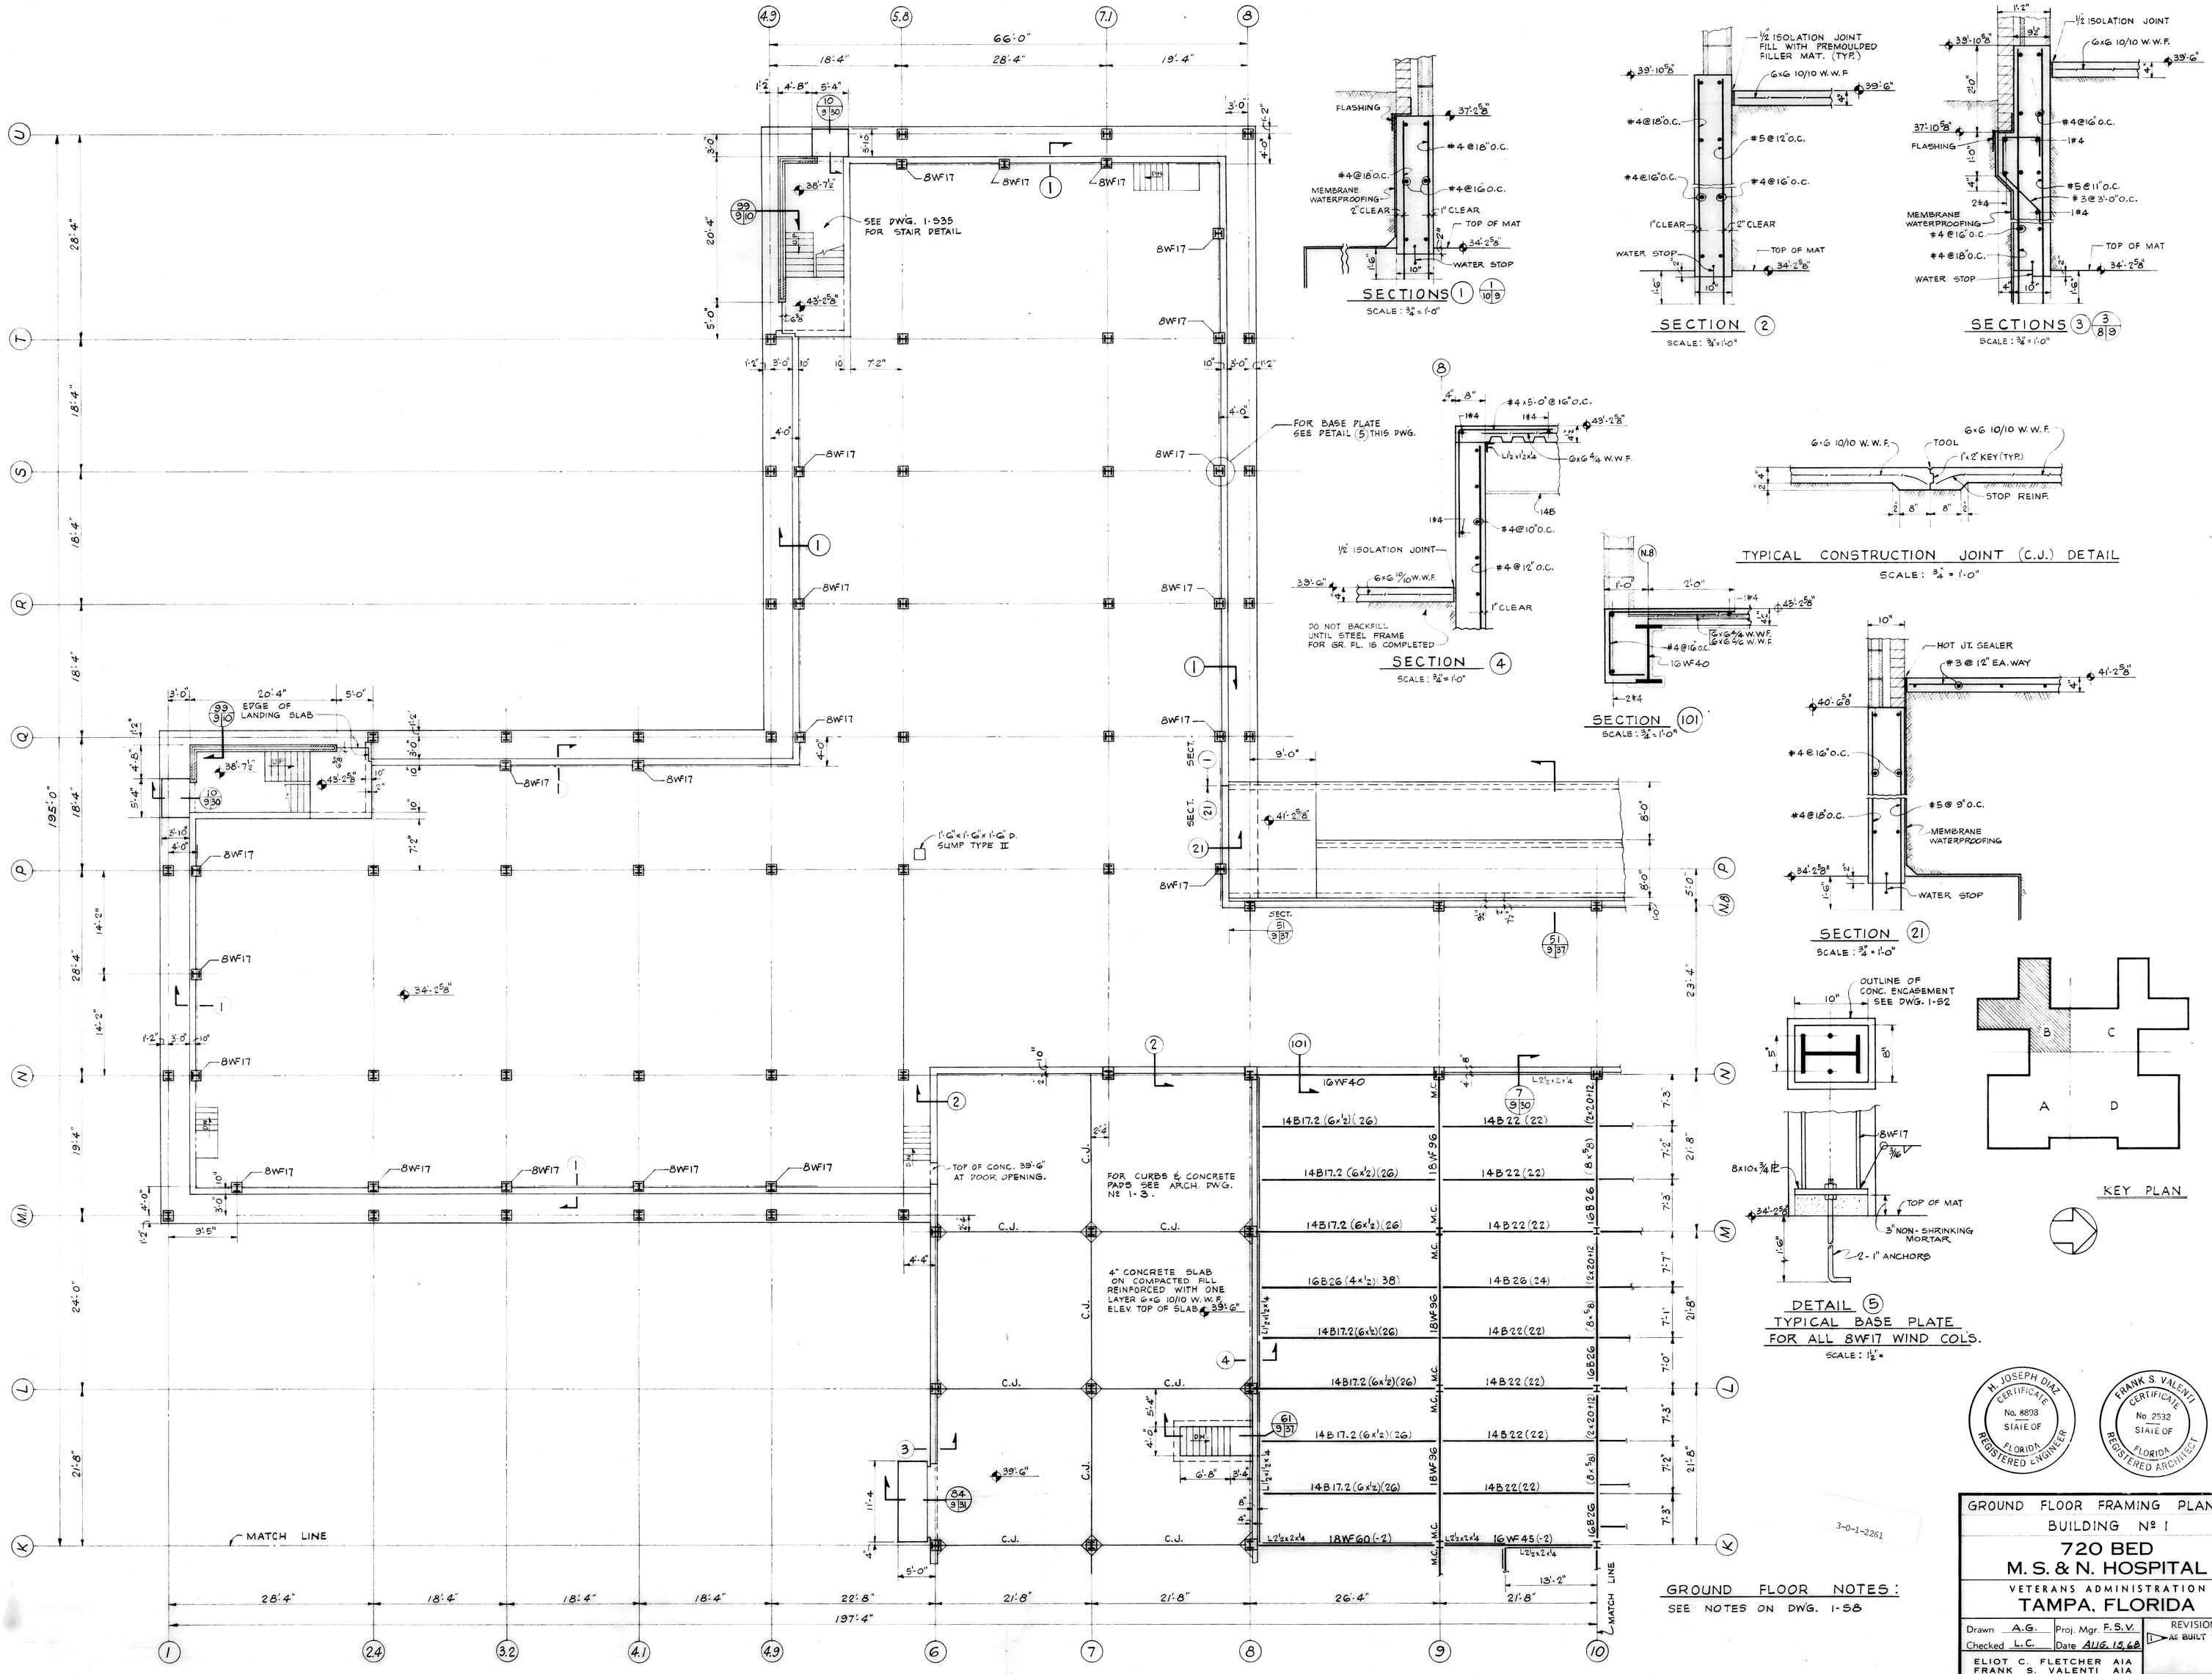

GROUND FLOOR FRAMING PLAN "B"

SCALE 1/8"=1'-0"

ELEV. TOP OF STEEL 42'-10⅛" (UNLESS NOTED ON PLAN)

SECTIONS (1) 1/10/9

SCALE: 3/4"=1'-0"

SECTION (2)

SCALE: 3/4"=1'-0"

SECTIONS (3) 3/8/9

SCALE: 3/4"=1'-0"

SECTION (4)

SCALE: 3/4"=1'-0"

TYPICAL CONSTRUCTION JOINT (C.J.) DETAIL

SCALE: 3/4"=1'-0"

SECTION (101)

SCALE: 3/4"=1'-0"

SECTION (21)

SCALE: 3/4"=1'-0"

DETAIL (5) TYPICAL BASE PLATE FOR ALL 8WF17 WIND COLS.

SCALE: 1½"=1"

KEY PLAN

GROUND FLOOR NOTES:

SEE NOTES ON DWG. 1-S8

H. JOSEPH DIAZ CERTIFICATE No. 8898 STATE OF FLORIDA REGISTERED ENGINEER

FRANK S. VALENTI CERTIFICATE No 2532 STATE OF FLORIDA REGISTERED ARCHITECT

GROUND FLOOR FRAMING PLAN "B"

BUILDING Nº 1

720 BED M. S. & N. HOSPITAL

VETERANS ADMINISTRATION

TAMPA, FLORIDA

Drawn A.G. Proj. Mgr. F.S.V.

Checked L.C. Date AUG. 15,68

REVISIONS

1 AS BUILT 7-20-72

ELIOT C. FLETCHER AIA ARCHITECT

FRANK S. VALENTI AIA ARCHITECT

SCHMIDT, GARDEN & ERIKSON ASSOCIATE ARCHITECTS-ENGINEERS CHICAGO

H. JOSEPH DIAZ & ASSOCS. ENGINEERS TAMPA

SAM CARASTRO & ASSOCS. ENGINEERS TAMPA

Director of Eastern Area Projects

DRAWING NUMBER

1-S9

Sheet 11 of 49

Proj. No. 09-5239

ONE EIGHTH INCH EQUALS ONE FOOT

0 2 4 6 8 10 12 14 16 18 20 22 24 26 28 30 32 34 36 38

3-0-1-2261

RETURN TRACINGS TO PLAN LIBRARY

FILE FOLDER NO. 21