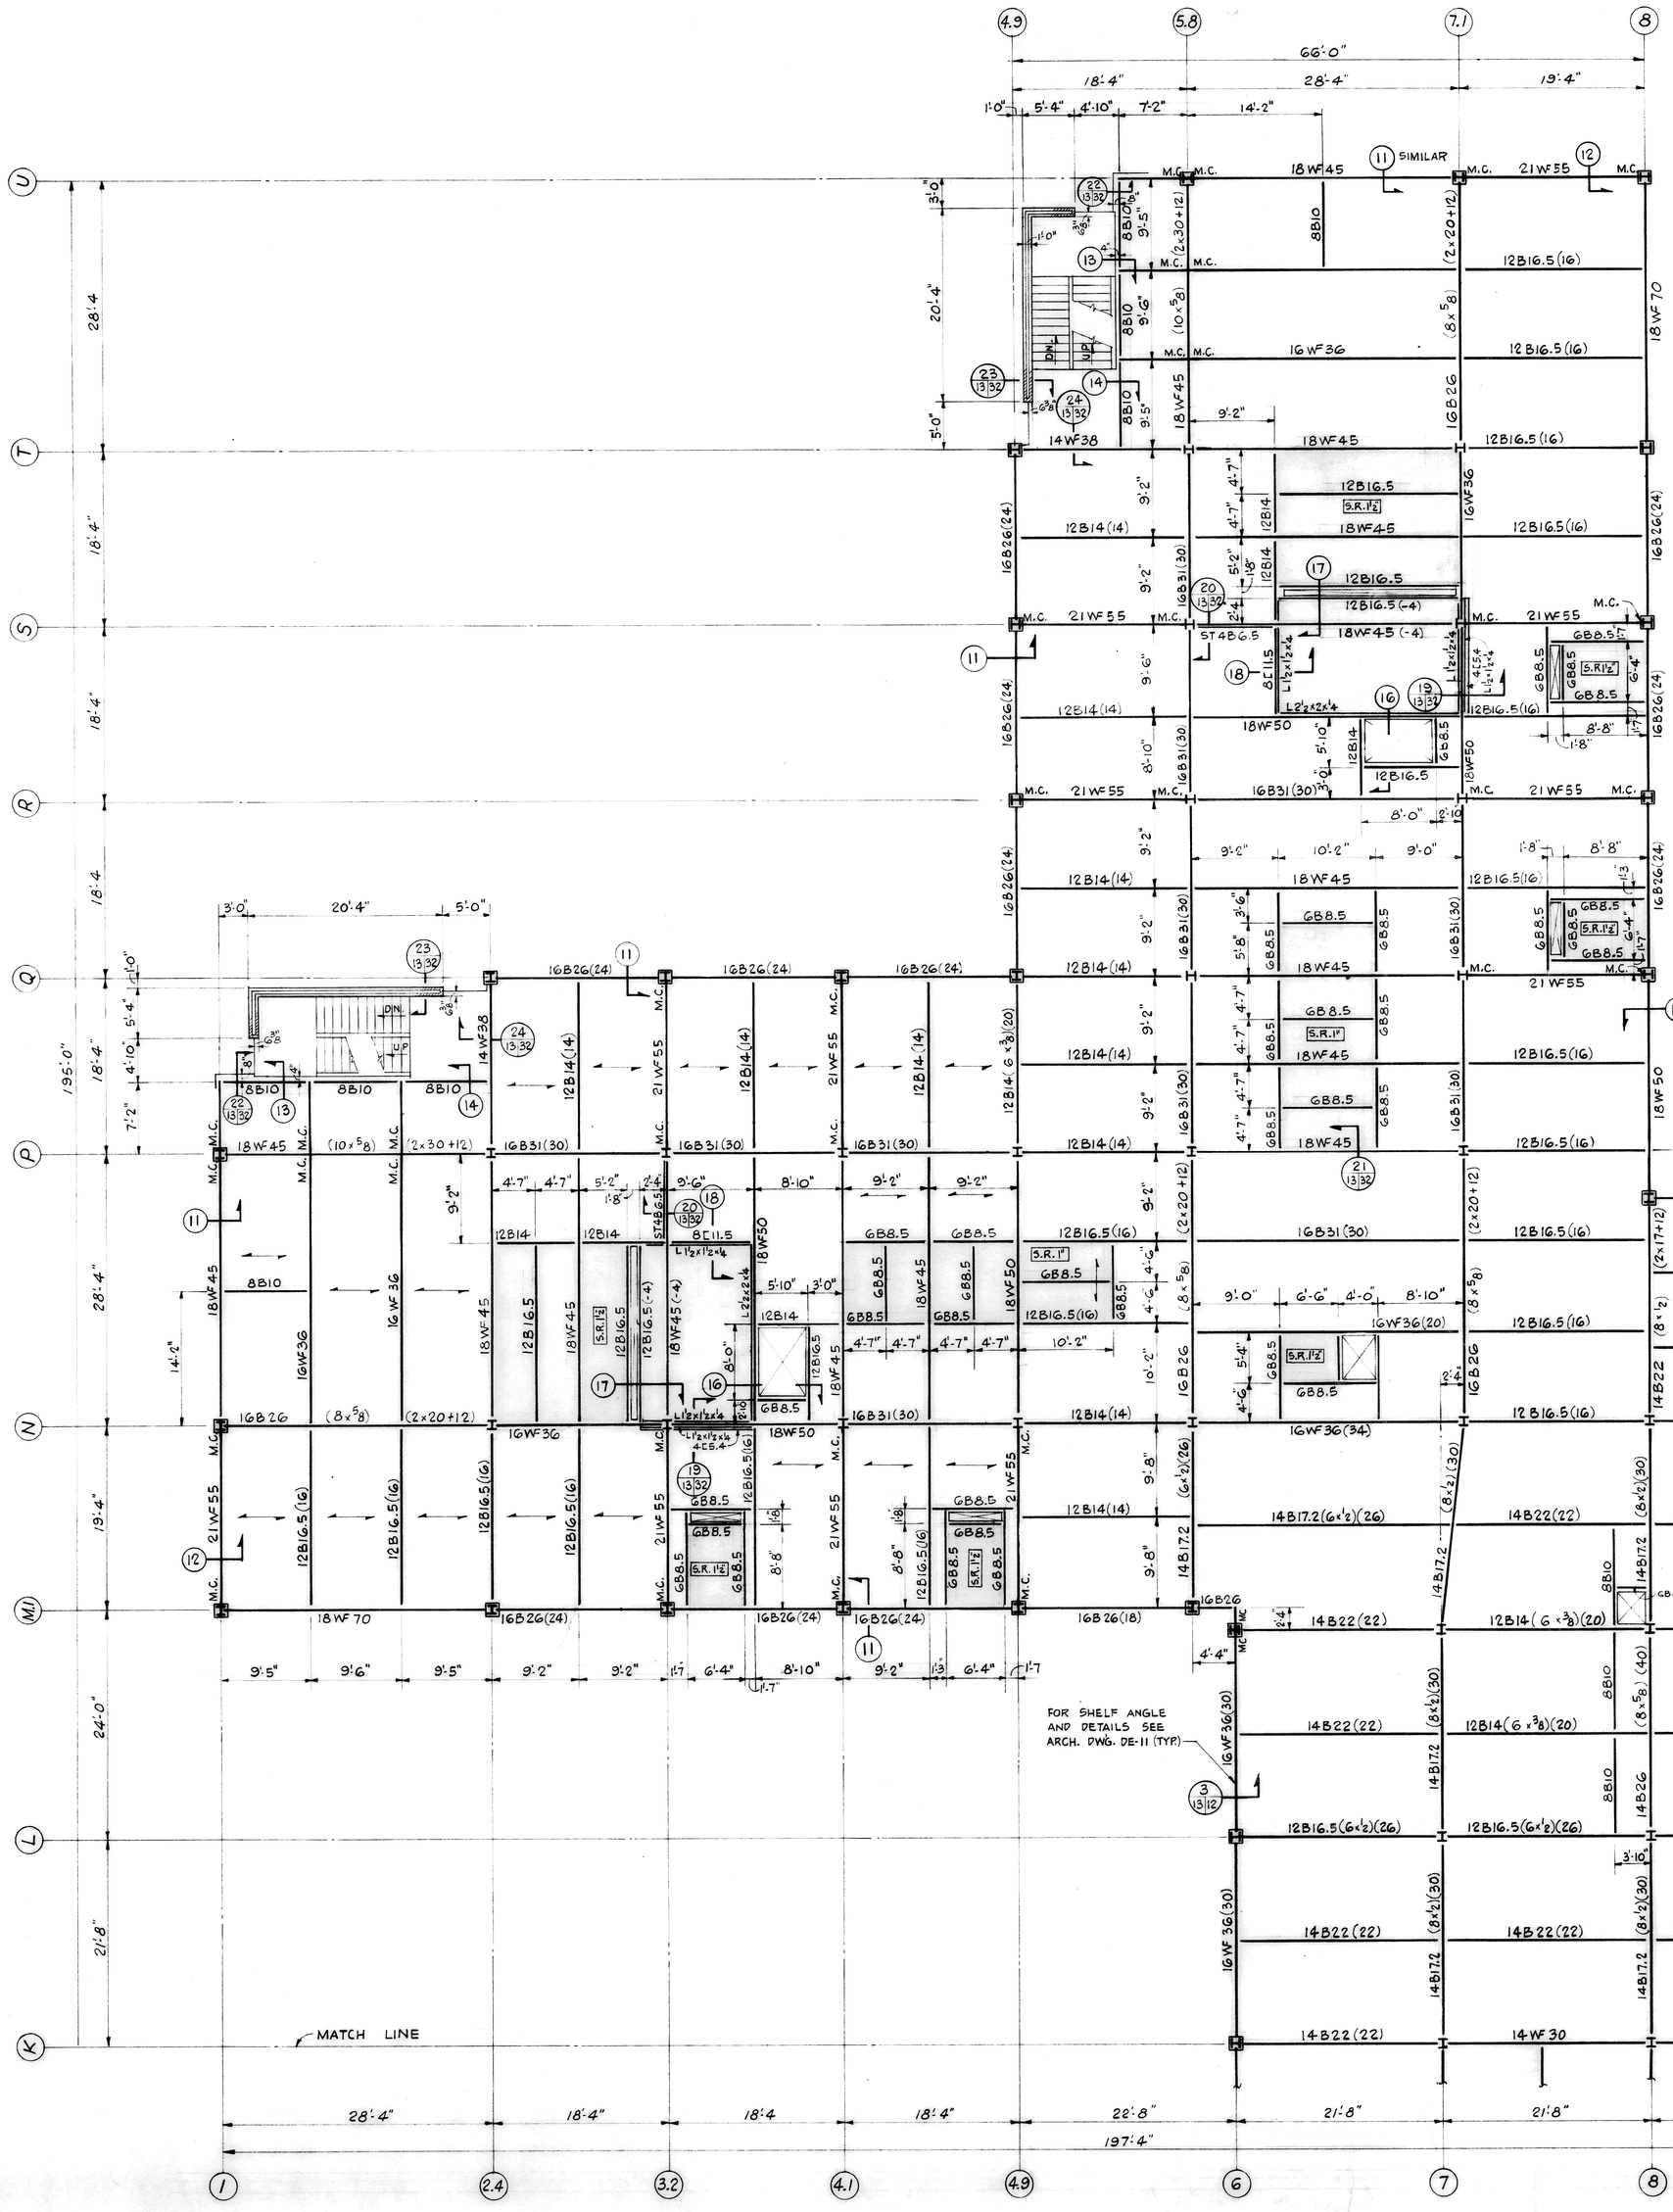

FIRST FLOOR FRAMING PLAN "B"

SCALE: 1/8" = 1'-0"

ELEV. TOP OF STEEL 56'-7½" (UNLESS NOTED ON PLAN)

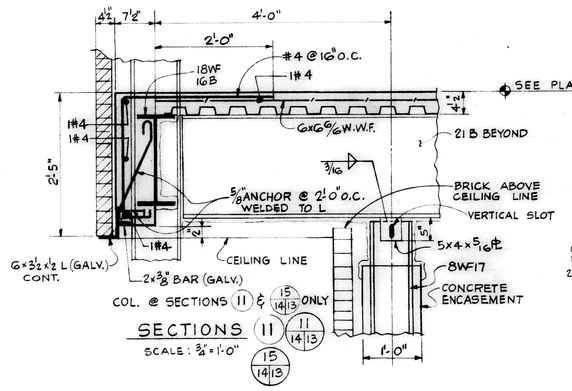

SECTIONS 11 (11 14/13) (15 14/13)

SCALE: ¾" = 1'-0"

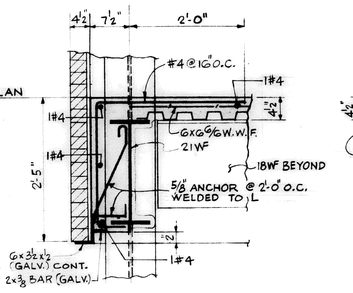

SECTIONS 12 (12 14/13)

SCALE: ¾" = 1'-0"

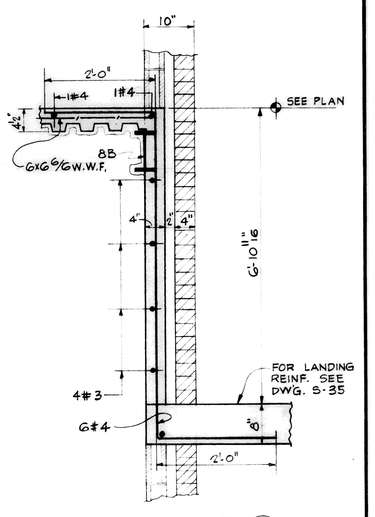

SECTIONS 13 (13 14/13) (20 17/13) (20 18/13)

SCALE: ¾" = 1'-0"

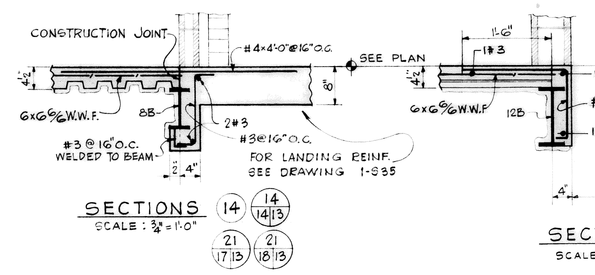

SECTIONS 14 (14 14/13) (21 17/13) (21 18/13)

SCALE: ¾" = 1'-0"

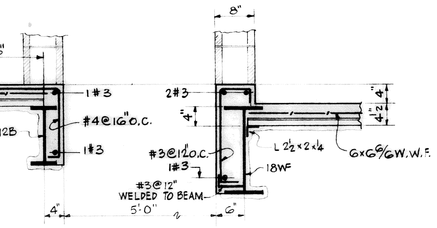

SECTIONS 16 (16 14/13) (22 17/13) (22 18/13)

SCALE: ¾" = 1'-0"

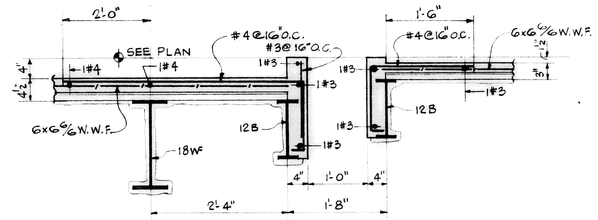

SECTIONS 17 (17 14/13) (23 17/13)

SCALE: ¾" = 1'-0"

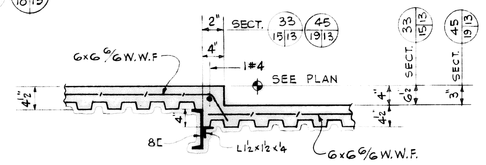

SECTIONS 18 (18 14/13) (33 15/13) (24 17/13) (24 18/13) (45 19/13)

SCALE: ¾" = 1'-0"

LIVE LOADS

OFFICE AREAS	80 PSF
CLINICAL RECORDS	125 PSF
DAY ROOM	60 PSF
DINING ROOM	100 PSF
BEDROOM	40 PSF
LIBRARY	60 PSF
SOCIAL ACTIVITIES ROOM	60 PSF
MANUAL ARTS THERAPY	75 PSF
OCCUPATIONAL THERAPY	75 PSF
LABORATORY SPACE	100 PSF
FILM STORAGE	200 PSF
X-RAY ROOMS	100 PSF
CORRIDORS	80 PSF
ELEVATOR LOBBIES	100 PSF
STAIRS	100 PSF

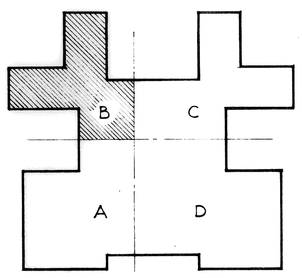

KEY PLAN

FIRST FLOOR NOTES:

SEE NOTES ON DWG. 1-S12

H. JOSEPH DIAZ CERTIFICATE No. 8898 STATE OF FLORIDA REGISTERED ENGINEER

FRANK S. VALENTI CERTIFICATE No. 2532 STATE OF FLORIDA REGISTERED ARCHITECT

1ST. FLOOR FRAMING PLAN "B"

BUILDING Nº 1

720 BED

M. S. & N. HOSPITAL

VETERANS ADMINISTRATION

TAMPA, FLORIDA

Drawn A.G. | Proj. Mgr. F.S.V.

Checked L.C. | Date AUG. 15, 68

REVISIONS

1 AS BUILT 7-30-72

ELIOT C. FLETCHER AIA
FRANK S. VALENTI AIA
ARCHITECTS TAMPA
SCHMIDT, GARDEN & ERIKSON
ASSOCIATE ARCHITECTS + ENGINEERS CHICAGO
H. JOSEPH DIAZ & ASSOCS.
SAM CARASTRO & ASSOCS.
ENGINEERS TAMPA

DRAWING NUMBER

1-S13

Sheet 15 of 49

Proj. No. 09-5239

ONE EIGHTH INCH EQUALS ONE FOOT

0 2 4 6 8 10 12 14 16 18 20 22 24 26 28 30 32 34 36 38

3-0-1-2265

RETURN TRACINGS TO PLAN LIBRARY

FILE FOLDER NO. 2A