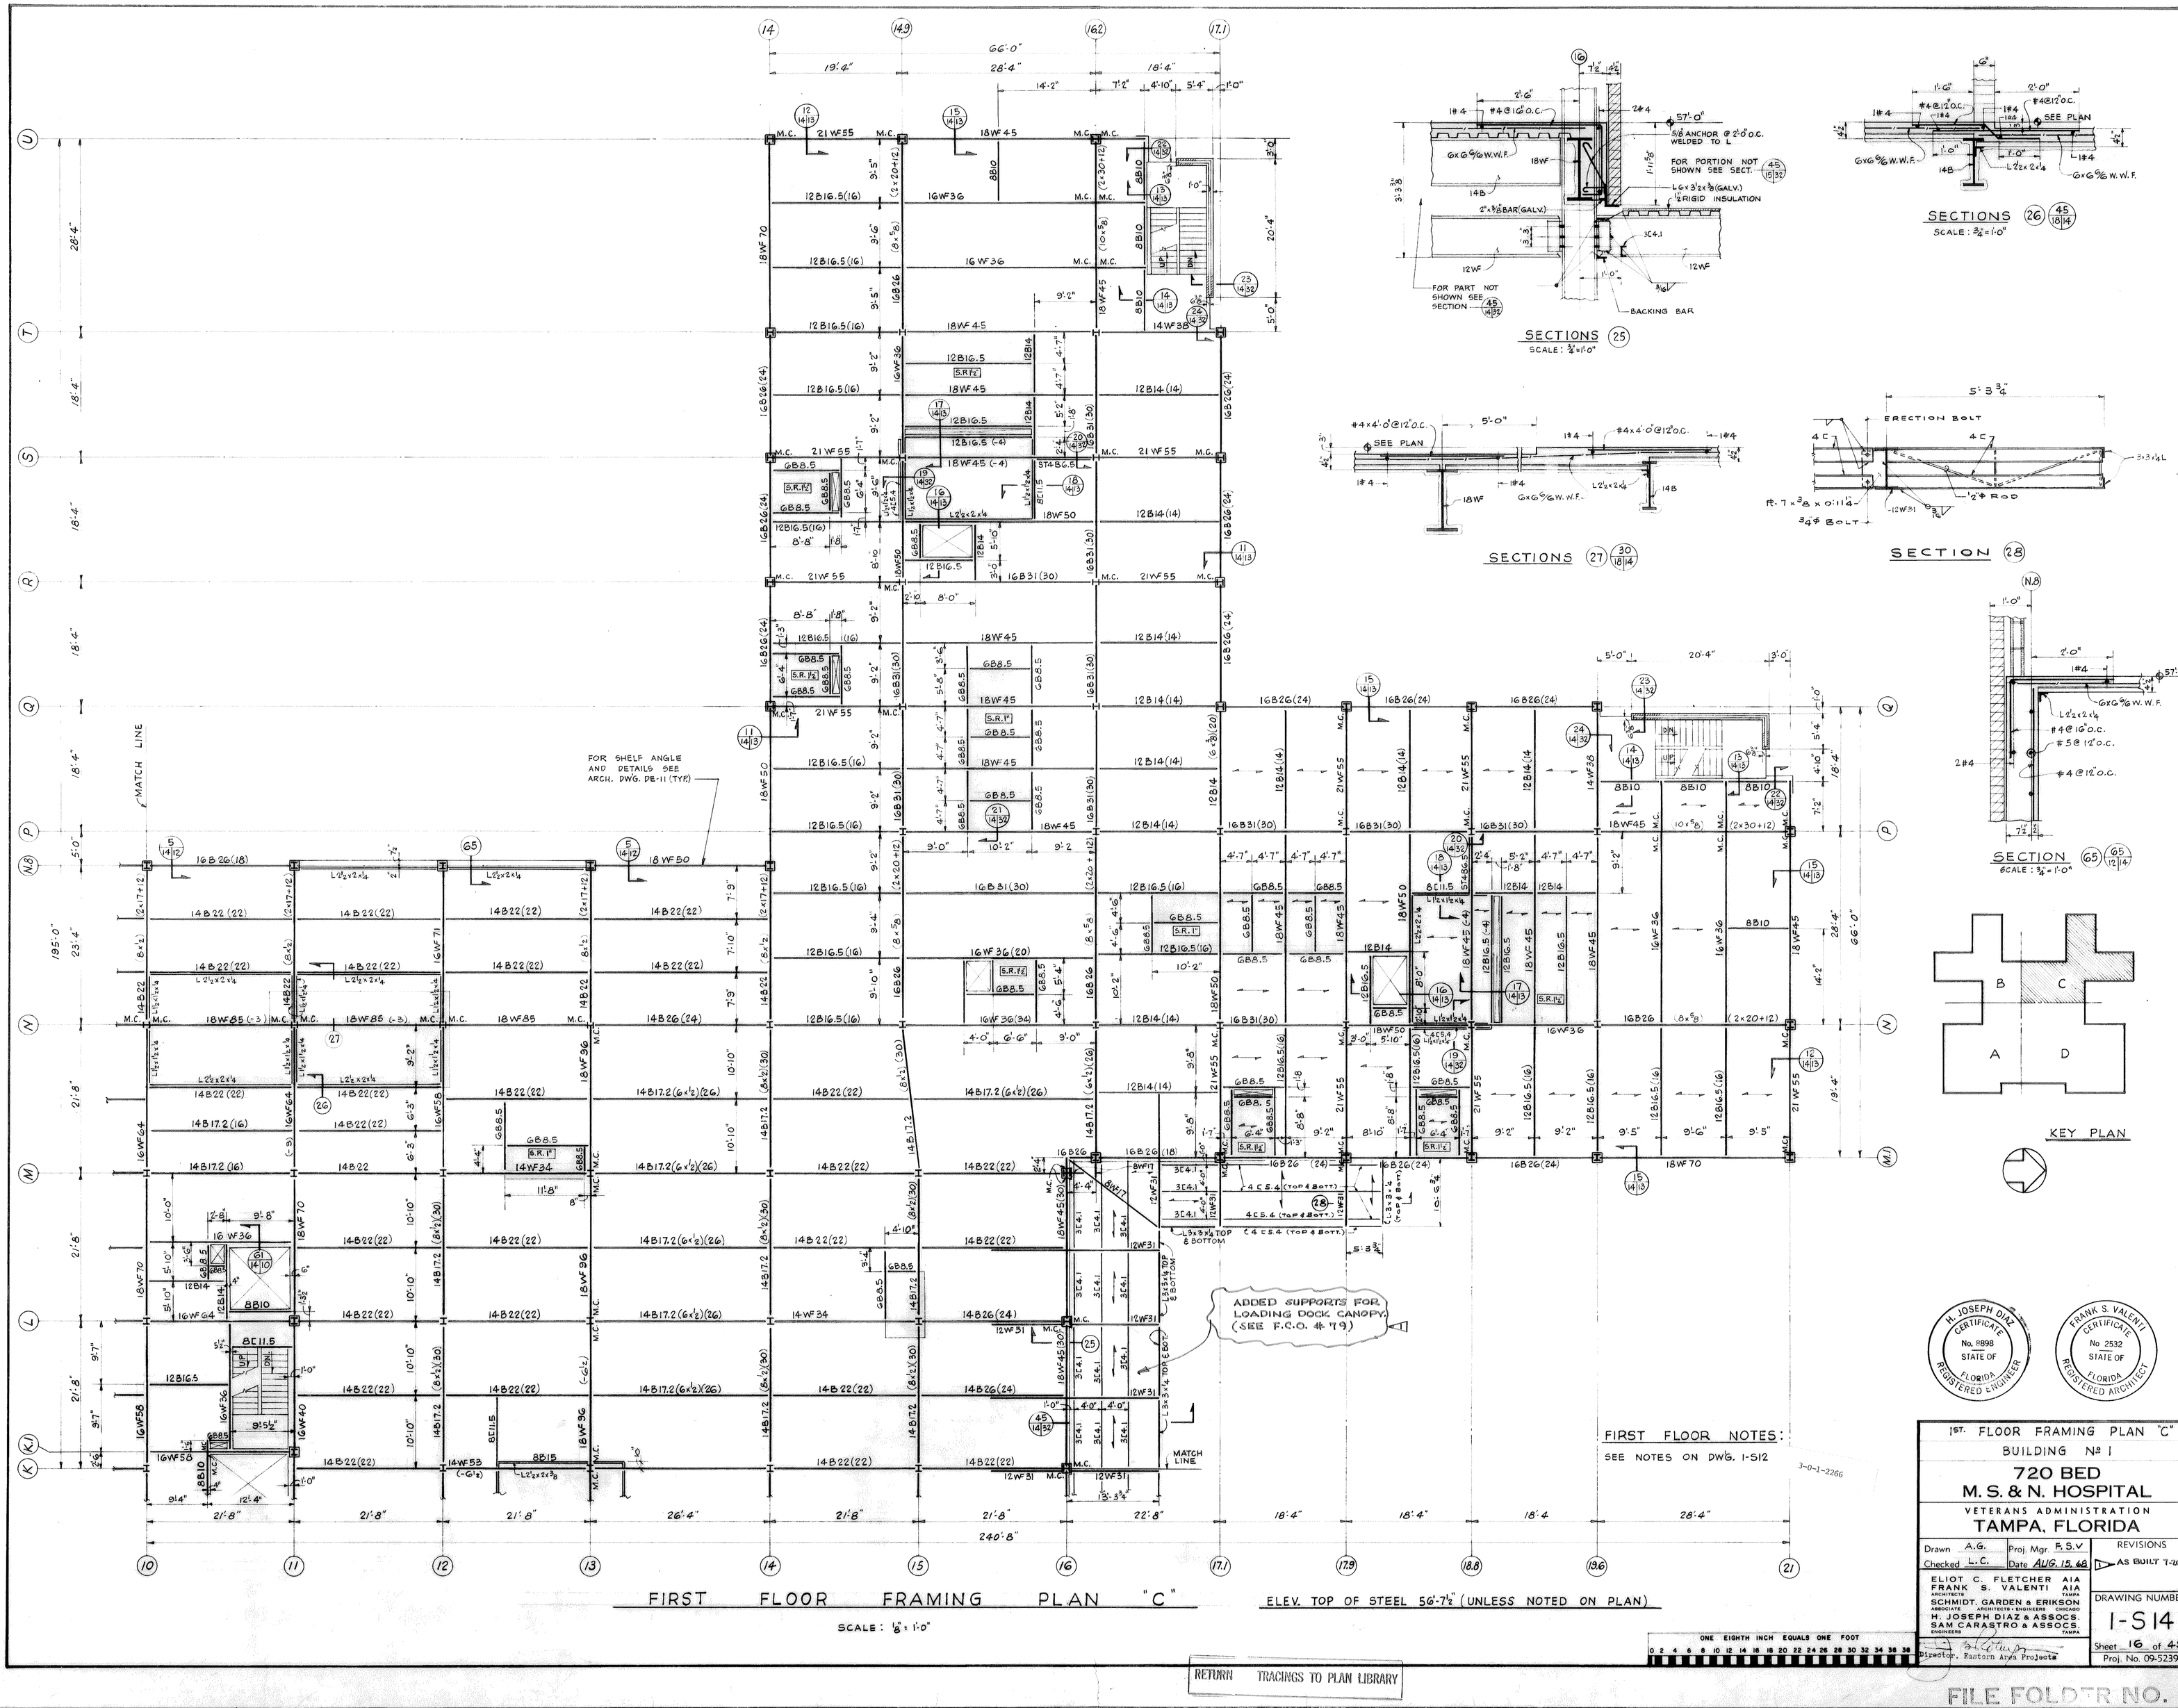

SECTIONS (25)
SCALE: ¾"=1'-0"

SECTIONS (26) (45/18/14)
SCALE: ¾"=1'-0"

SECTIONS (27) (30/18/14)

SECTION (28)

SECTION (65) (65/12/14)
SCALE: ¾"=1'-0"

KEY PLAN

FIRST FLOOR FRAMING PLAN "C"
SCALE: 1/8"=1'-0"

H. JOSEPH DIAZ CERTIFICATE No. 8898 STATE OF FLORIDA REGISTERED ENGINEER

FRANK S. VALENTI CERTIFICATE No 2532 STATE OF FLORIDA REGISTERED ARCHITECT

1ST. FLOOR FRAMING PLAN "C" 27
BUILDING Nº 1
720 BED
M. S. & N. HOSPITAL
VETERANS ADMINISTRATION
TAMPA, FLORIDA

Drawn A.G. | Proj. Mgr F.S.V. | Checked L.C. | Date AUG. 15, 68

REVISIONS
1 AS BUILT 7-20-72

ELIOT C. FLETCHER AIA
FRANK S. VALENTI AIA
ARCHITECTS TAMPA
SCHMIDT, GARDEN & ERIKSON
ASSOCIATE ARCHITECTS + ENGINEERS CHICAGO
H. JOSEPH DIAZ & ASSOCS.
SAM CARASTRO & ASSOCS.
ENGINEERS TAMPA

DRAWING NUMBER
1-S14
Sheet 16 of 49
Proj. No. 09-5239

Director, Eastern Area Projects

3-0-1-2266

RETURN TRACINGS TO PLAN LIBRARY

FILE FOLDER NO. 2A