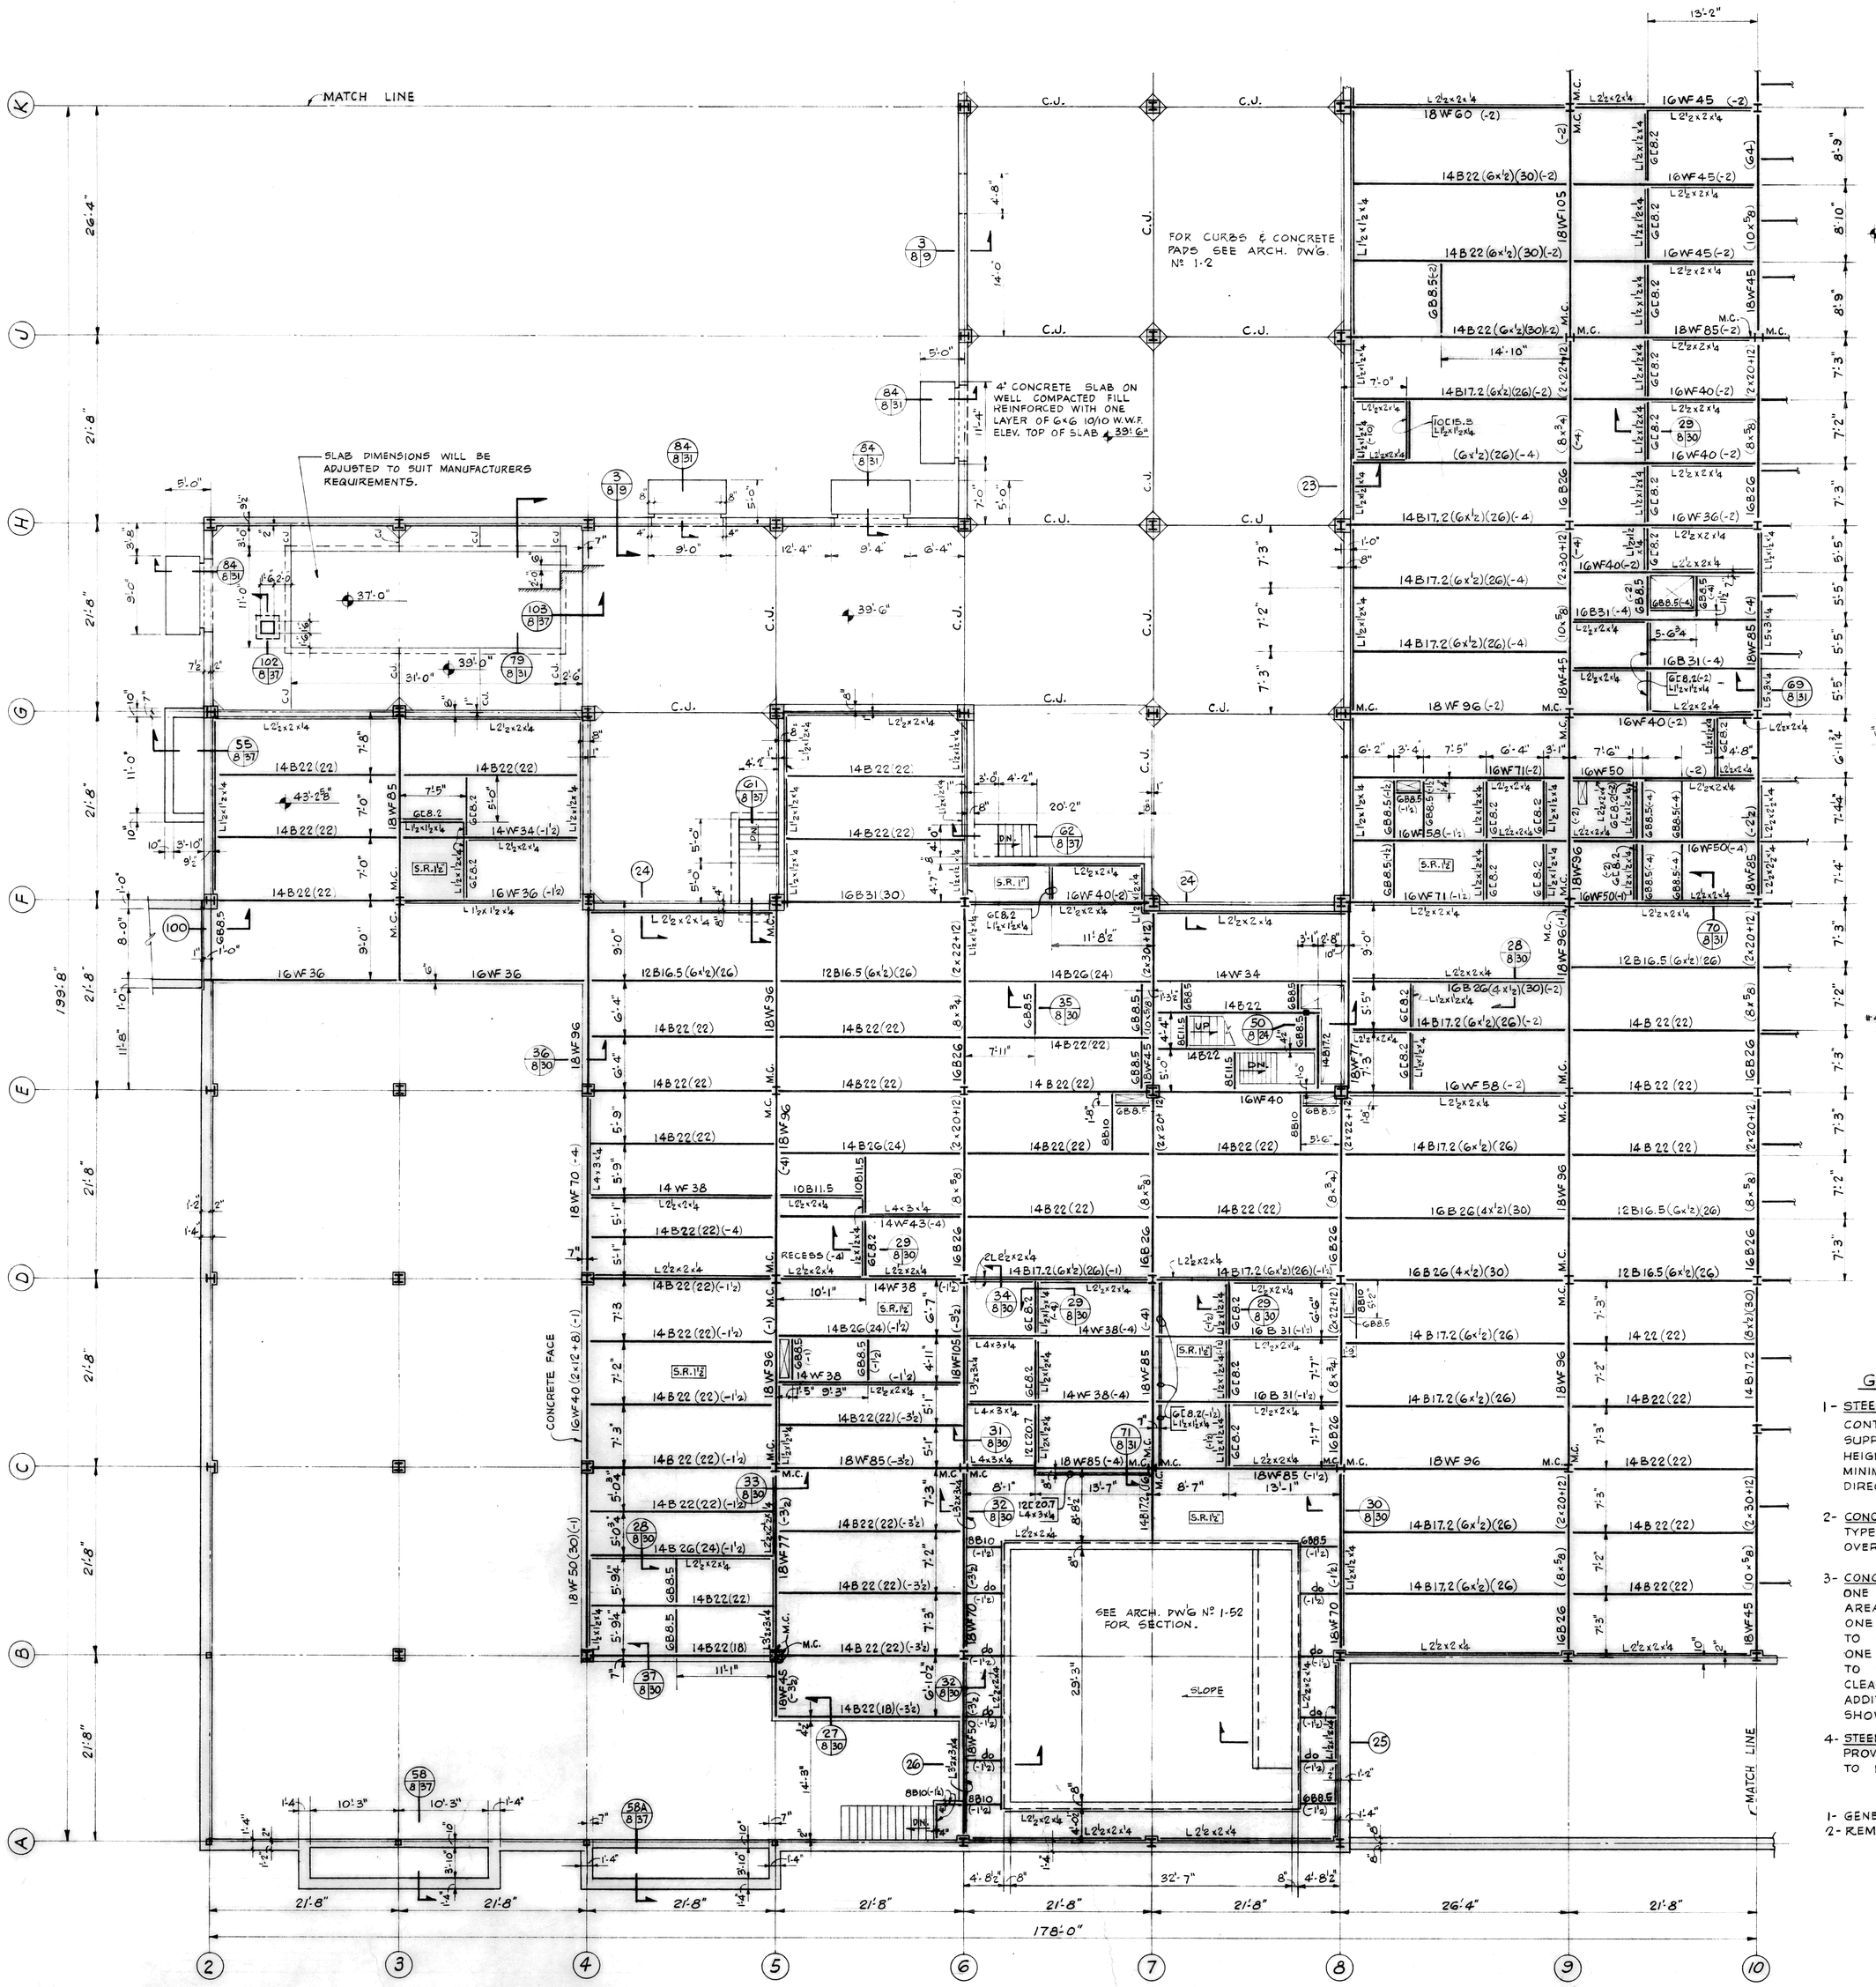

GROUND FLOOR FRAMING PLAN "A" 1/8

SCALE 1/8" = 1'-0"

ELEV. TOP OF STEEL 42'-10 1/8" (UNLESS NOTED ON PLAN)

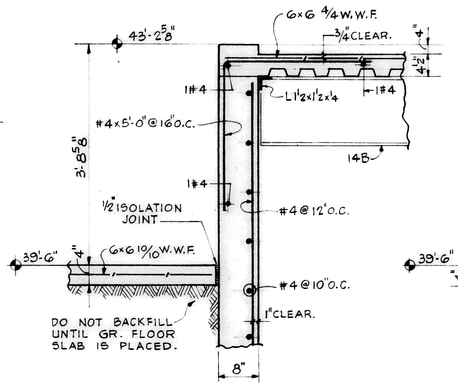

SECTION 23

SCALE: 3/4" = 1'-0"

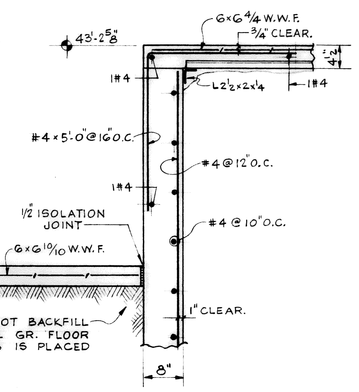

SECTION 24

SCALE: 3/4" = 1'-0"

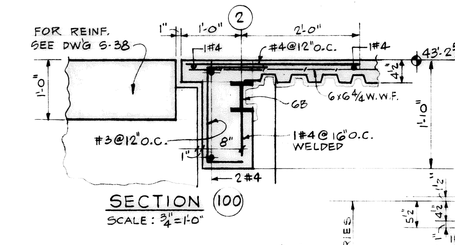

SECTION 100

SCALE: 3/4" = 1'-0"

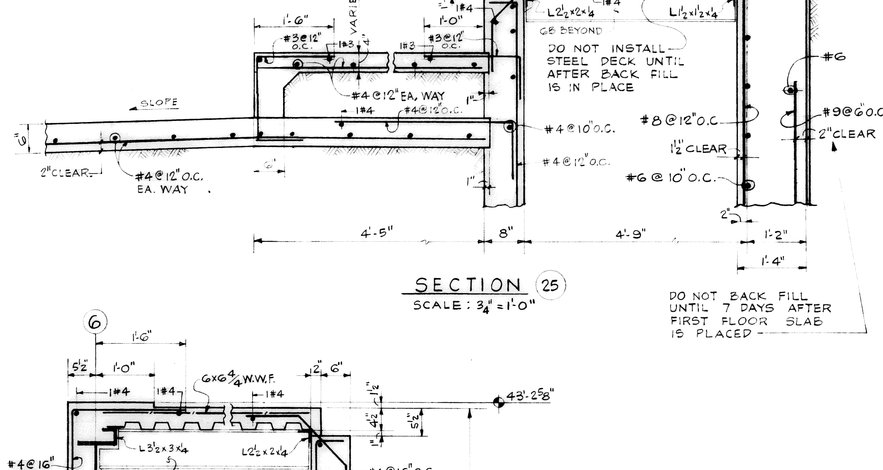

SECTION 25

SCALE: 3/4" = 1'-0"

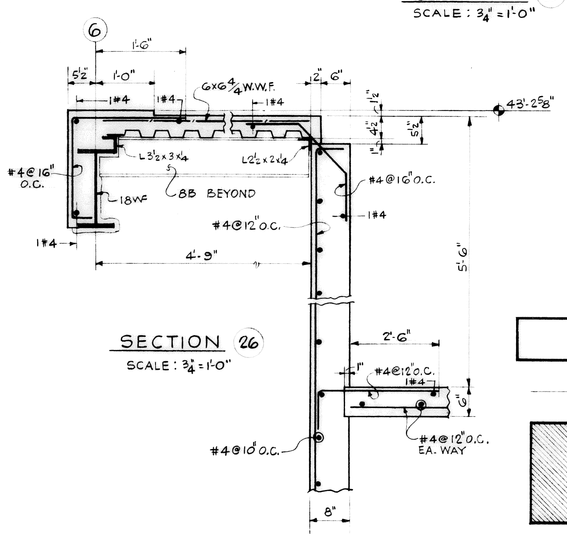

SECTION 26

SCALE: 3/4" = 1'-0"

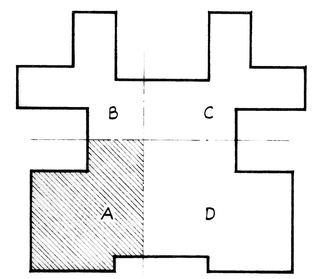

KEY PLAN

GROUND FLOOR NOTES:

1- STEEL DECKING UNITS — COMPOSITE TYPE:
CONTINUOUS OVER A MINIMUM OF TWO INTERMEDIATE SUPPORTS (THREE SPANS). UNLESS SHOWN OTHERWISE
HEIGHT OF CORRUGATIONS = 1 1/2 INCHES
MINIMUM SECTION MODULUS = 0.27 IN³ PER FT. (20 GAUGE)
DIRECTION OF SPAN SHALL BE EAST - WEST.

2- CONCRETE DECK SLAB - COMPOSITE
TYPE "C" CONCRETE, 3 INCHES MINIMUM THICKNESS OVER HIGH CORRUGATION OF STEEL DECKING.

3- CONCRETE DECK STEEL REINFORCEMENT
ONE LAYER OF 6"x6" - 4/4 GAUGE W.W.F. REQUIRED ENTIRE AREA OF GROUND FLOOR.
ONE LAYER OF 6"x6" - 10/10 GAUGE W.W.F. FROM LINE "N" TO WEST OF LINE "S".
ONE LAYER OF 6"x6" - 6/6 GAUGE W.W.F. FROM LINE "M" TO LINE "N".
CLEAR COVER FROM TOP OF FINISHED CONCRETE SLAB = 3/4"
ADDITIONAL REINFORCING STEEL WHERE REQUIRED IS SHOWN ON SECTIONS.

4- STEEL DECKING SHORING REQUIREMENTS.
PROVIDE ONE CONTINUOUS MID-SPAN SUPPORT, SHORED TO FLOOR BELOW, FOR ALL CLEAR SPANS EXCEEDING 8'-0".

LIVE LOADS

1- GENERAL MEDICAL & SUBSISTENCE STORAGE - 250 PSF.
2- REMAINING AREA — 150 PSF

GENERAL NOTE (ALL "S" DRAWINGS): SPRAYED FIREPROOFING SHALL BE APPLIED IN ACCORDANCE WITH SPECIFICATION REQUIREMENTS. REQUIRED FIREPROOFING IS NOT SHOWN ON PORTIONS OF CERTAIN DETAILS IN THESE DRAWINGS FOR REASON OF CLARITY.

H. JOSEPH DIAZ CERTIFICATE No. 8898 STATE OF FLORIDA REGISTERED ENGINEER

FRANK S. VALENTI CERTIFICATE No. 2532 STATE OF FLORIDA REGISTERED ARCHITECT

3-0-1-2260

GROUND FLOOR FRAMING PLAN "A"
BUILDING Nº 1

720 BED
M. S. & N. HOSPITAL

VETERANS ADMINISTRATION
TAMPA, FLORIDA

Drawn A.G.	Proj. Mgr F.S.V.	REVISIONS
Checked L.C.	Date AUG. 15, 68	1 AS BUILT 7-20-72

ELIOT C. FLETCHER AIA
FRANK S. VALENTI AIA
ARCHITECTS TAMPA
SCHMIDT, GARDEN & ERIKSON
ASSOCIATE ARCHITECTS + ENGINEERS CHICAGO
H. JOSEPH DIAZ & ASSOCS.
SAM CARASTRO & ASSOCS.
ENGINEERS TAMPA

DRAWING NUMBER
1-S8

Sheet 10 of 49
Proj. No. 09-5239

Director, Eastern Area Projects

ONE EIGHTH INCH EQUALS ONE FOOT
0 2 4 6 8 10 12 14 16 18 20 22 24 26 28 30 32 34 36 38

RETURN TRACINGS TO PLAN LIBRARY

FILE FOLDER NO. 2A